


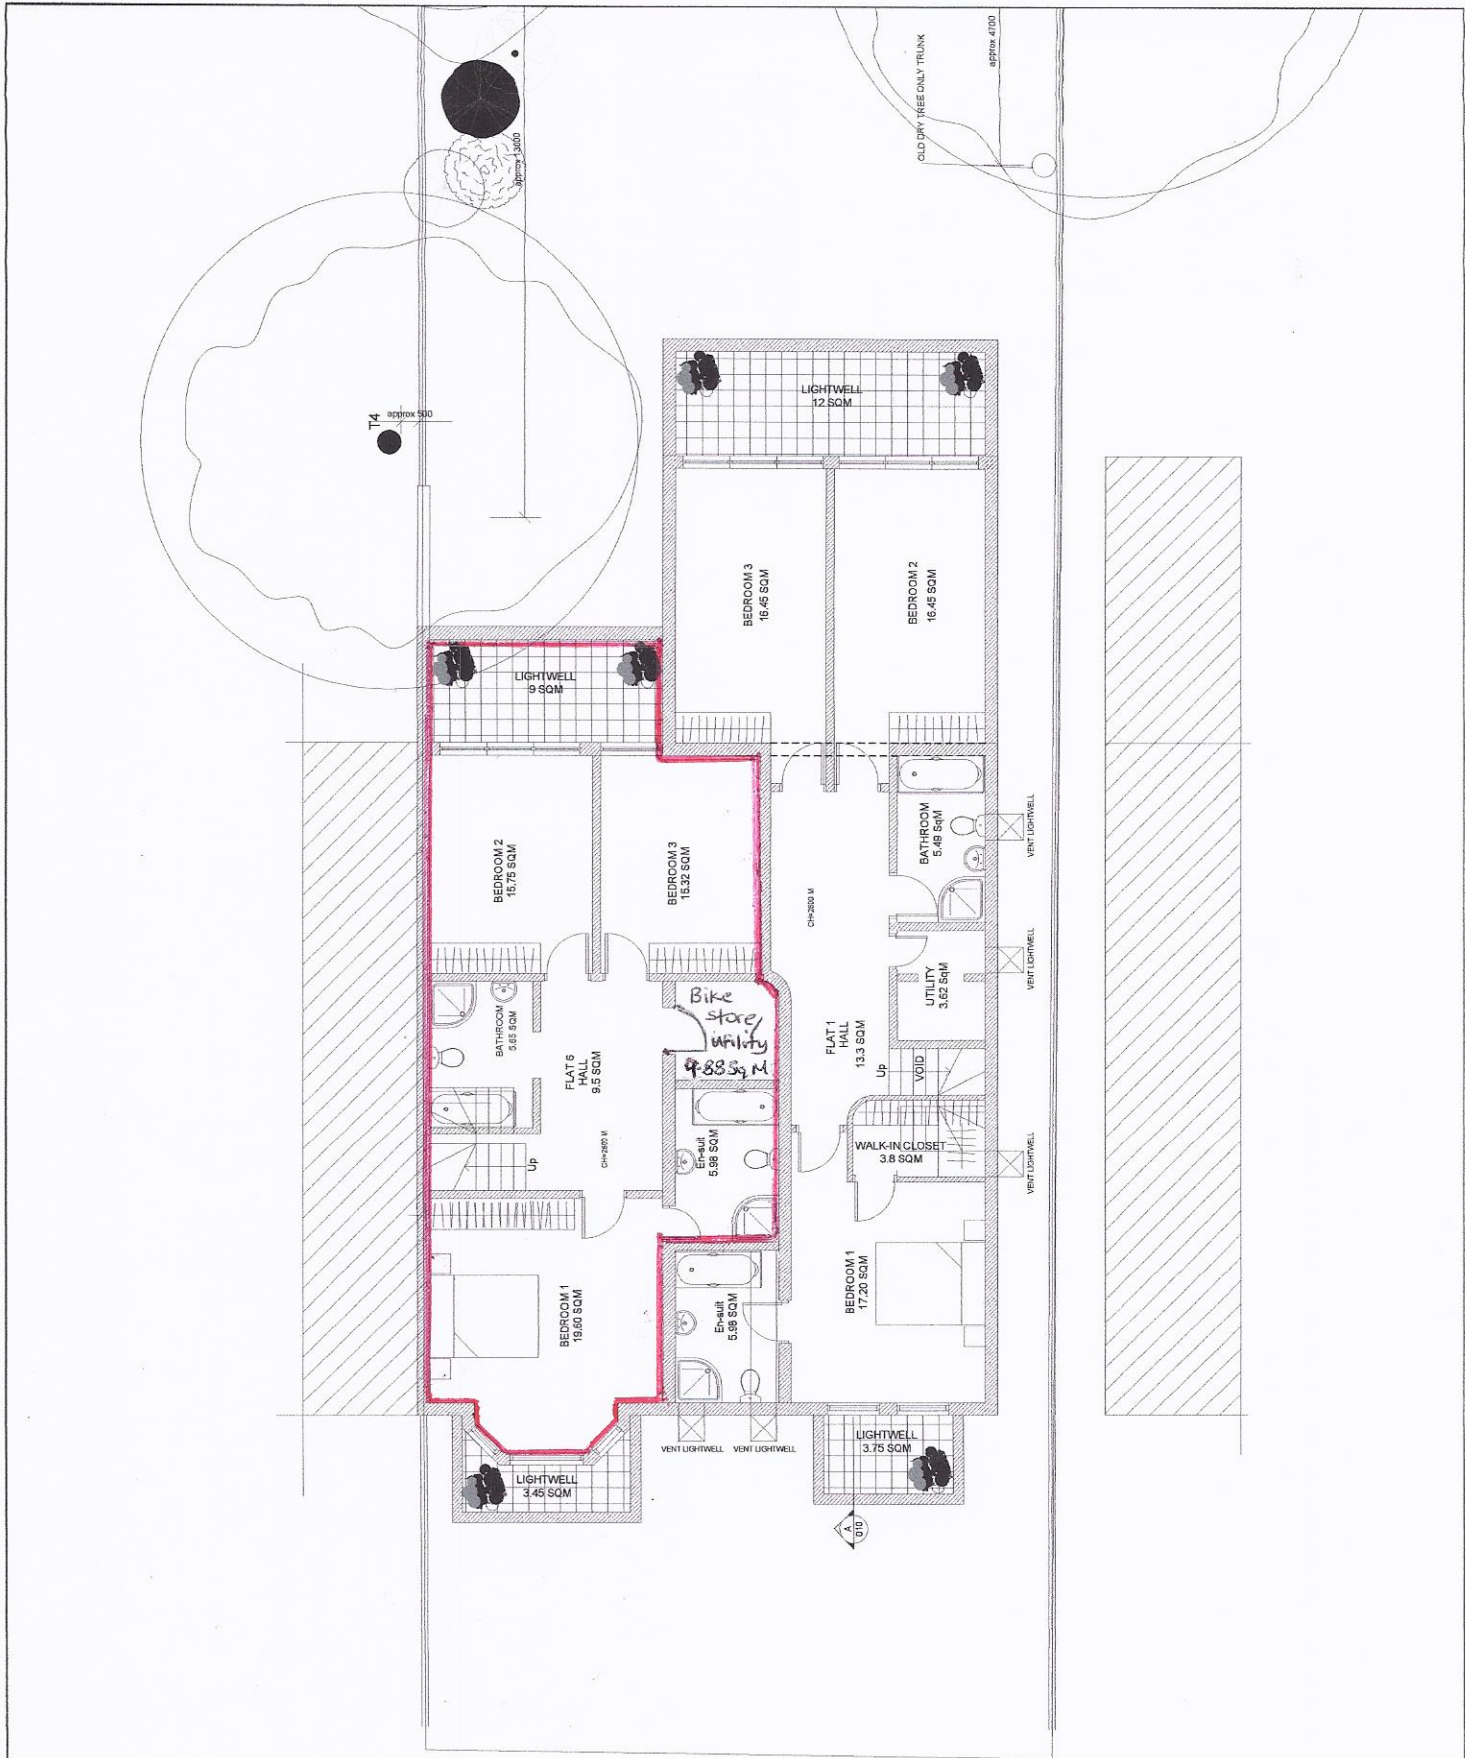
Front path ground levels at the above site & immediately adjacent to the site on the public highway have not altered as a result of the development and remain the same as before

CANFIELD GARDENS

PROPOSED GROUND FLOOR


- Car-free unit

 <p>MY PLACE MY SPACE Property Developer 145-157 St John Street, EC1V 4PW London T: 077 868 02 831</p>	CLIENT: Ms Patel	PROJECT: 86 CANFIELD GARDENS		ISSUED FOR: PRELIMINARY:
	JOB N.:	DRAWN by:	CHECKED by:	PLANNING APPLICATION
	DATE: 15-09-16	SCALE: 1: 100 @ A3	REVISION:	TENDER:
	TITLE: FLAT 1 & 6 PROPOSED GROUND FLOOR PLAN			AS BUILT:



PROPOSED BASEMENT FLOOR

- car free unit

 <p>MY PLACE MY SPACE Property Developer 145-157 St John Street, EC1V 4PW London T: 077 868 02 831</p>	<p>CLIENT: Ms Patel</p>	<p>PROJECT: 86 CANFIELD GARDENS</p>	<p>ISSUED FOR: PRELIMINARY: PLANNING APPLICATION</p>
	<p>JOB N: -</p>	<p>DRAWN by: DG</p>	<p>CHECKED by: HP</p>
<p>DATE: 15-09-16</p>	<p>SCALE: 1: 100 @ A3</p>	<p>REVISION: -</p>	
<p>TITLE: FLAT 1 & 6 PROPOSED BASEMENT FLOOR PLAN</p>			