

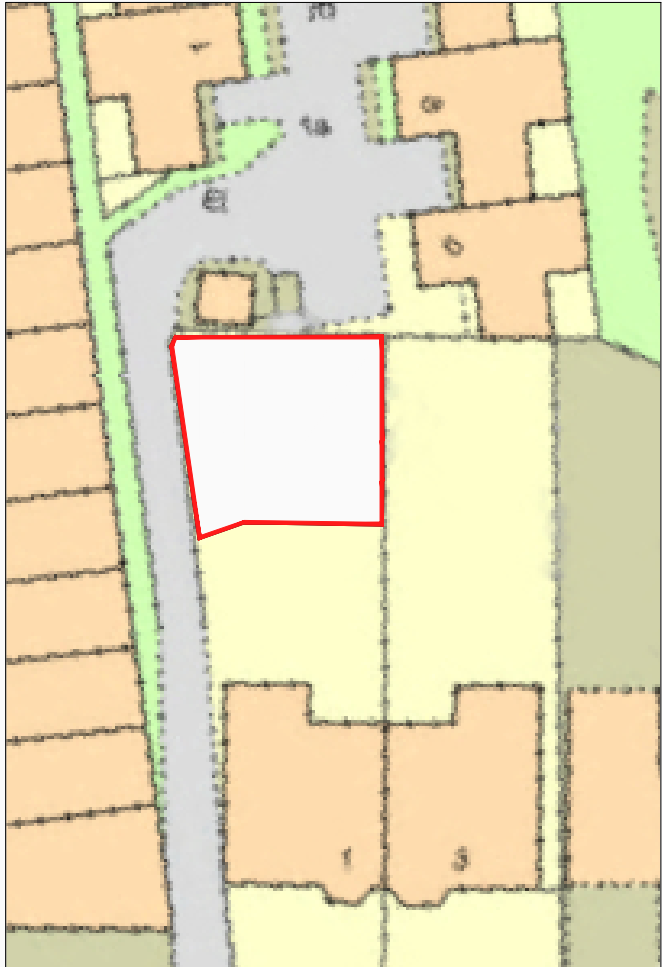
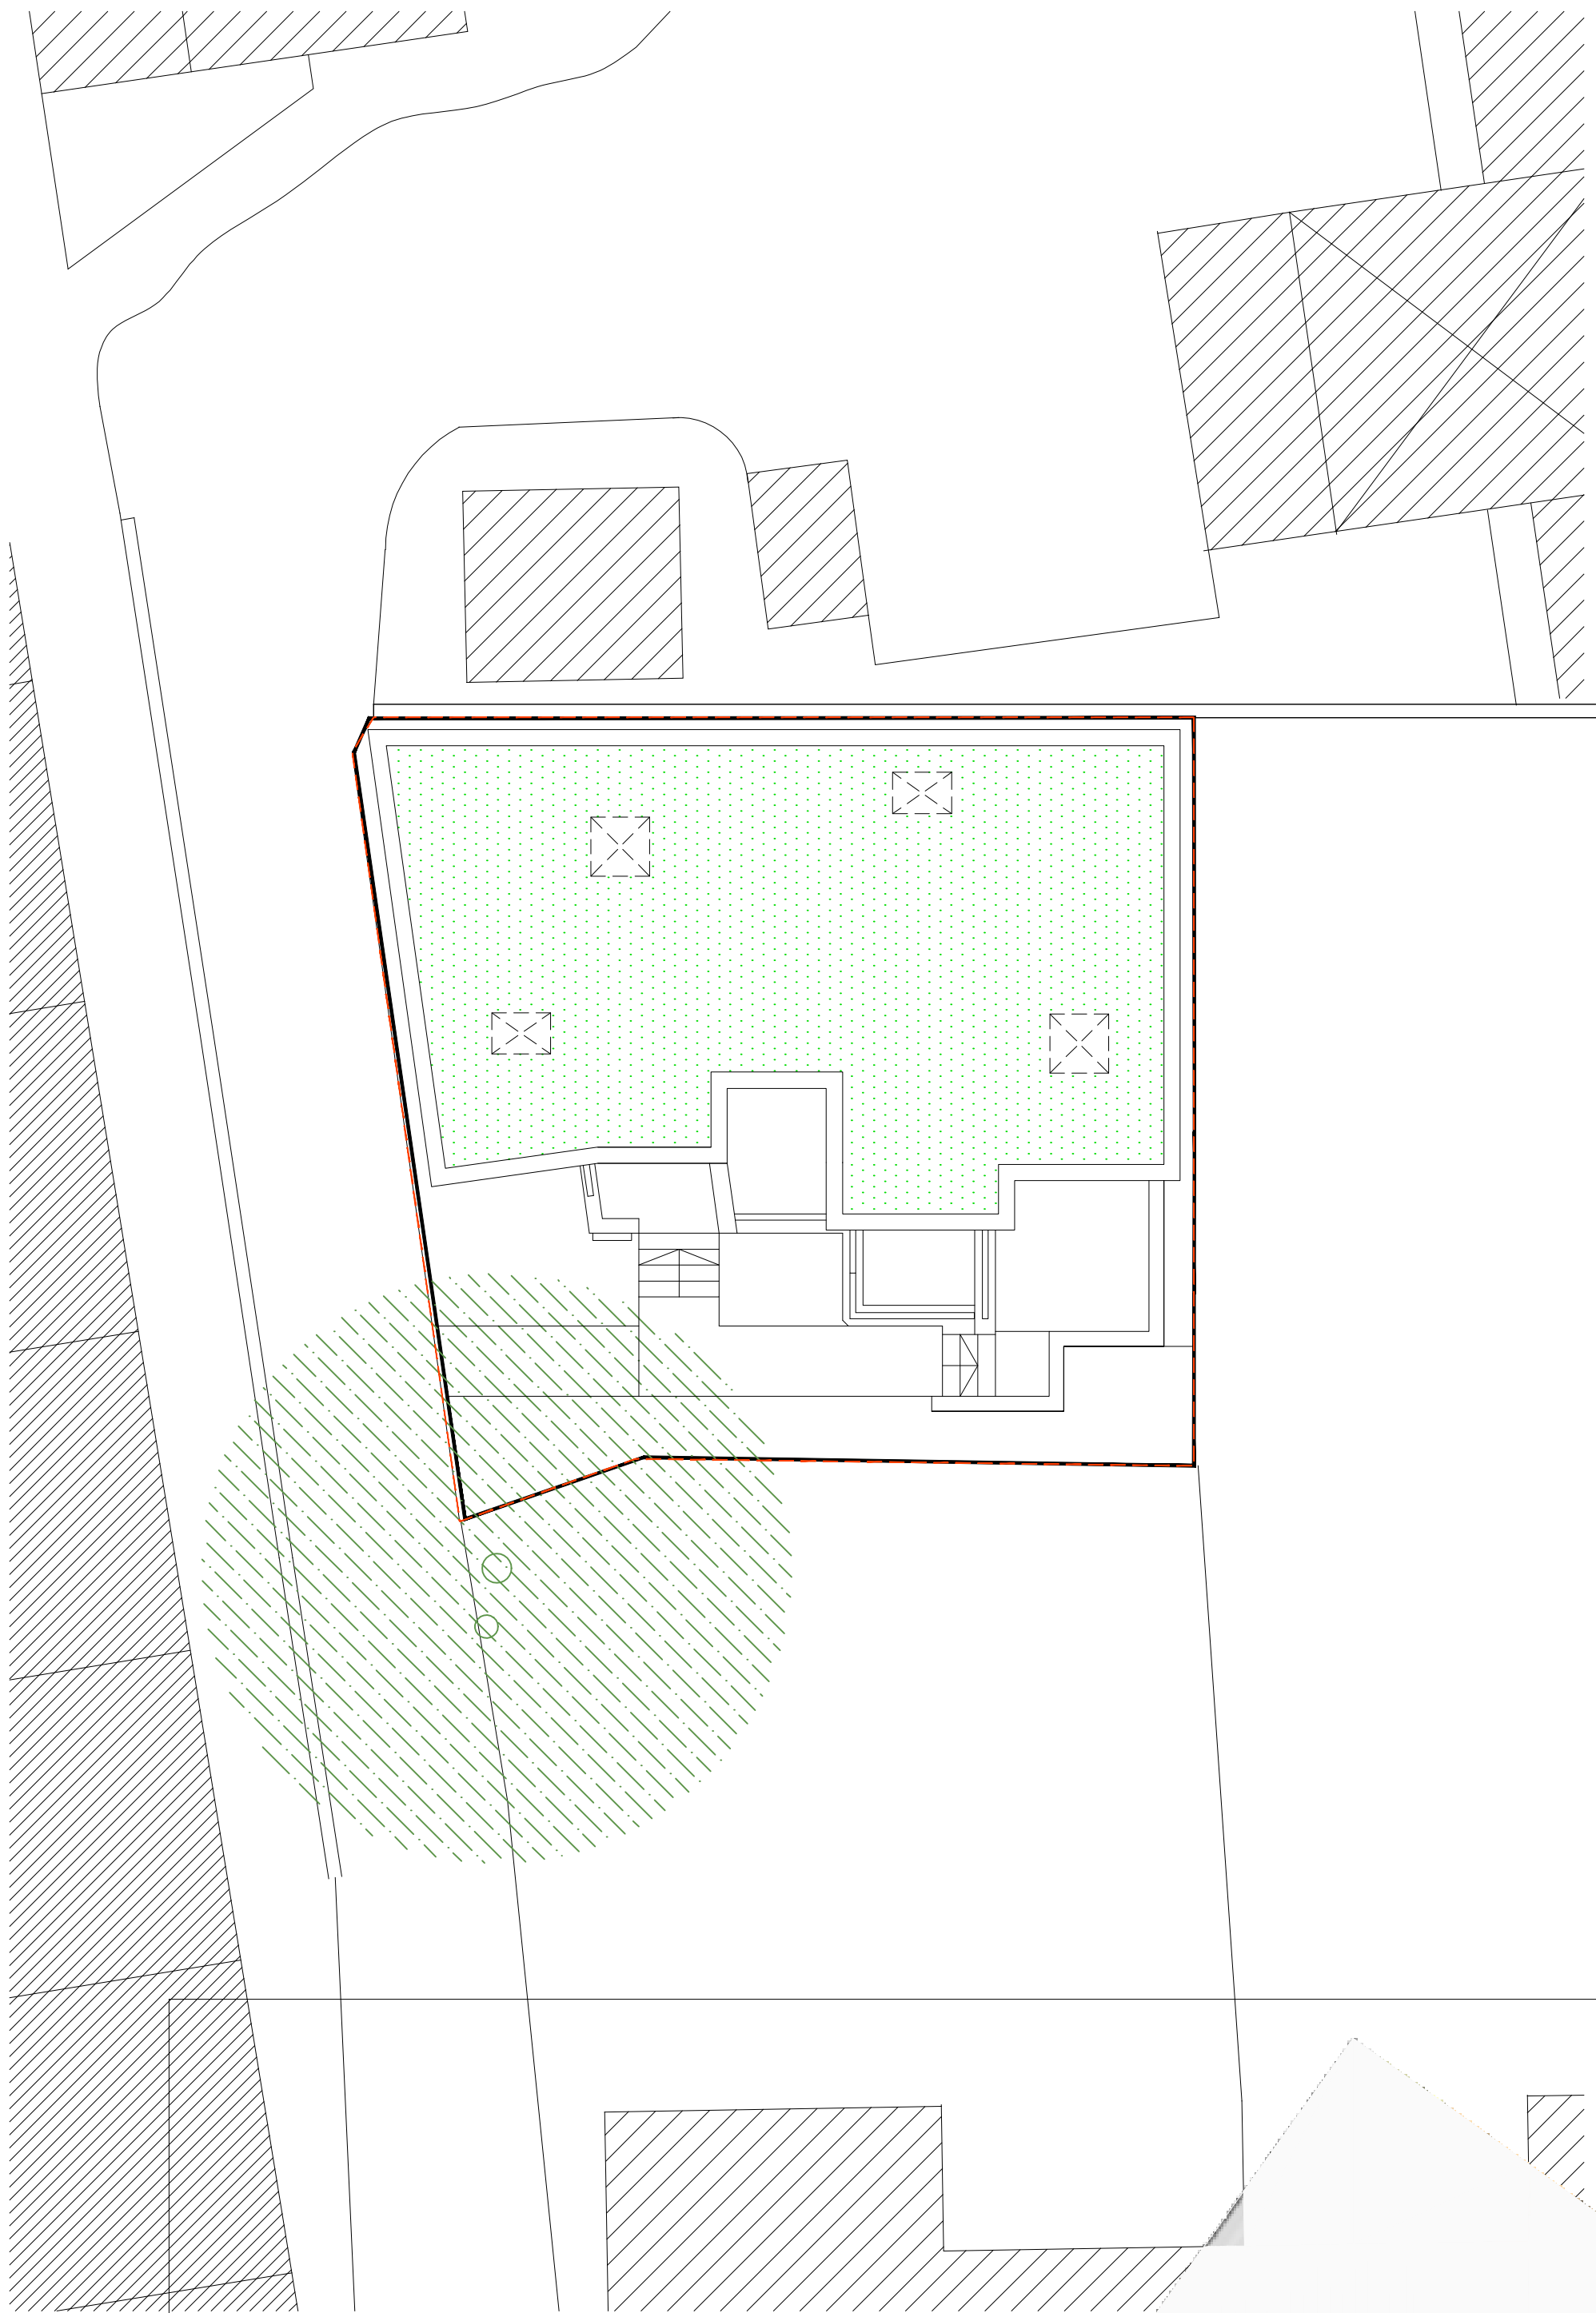


SITE PLAN

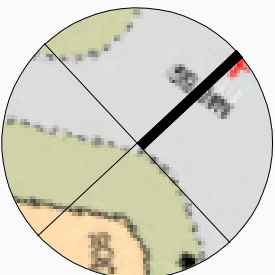

LOCATION PLAN 1:500

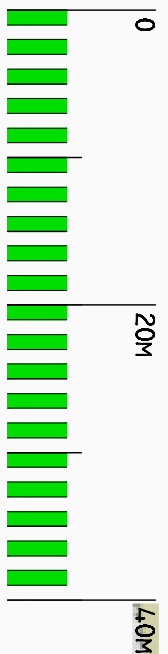

REV.	A	Second landscape scheme added	20-11-18 14-2-17		
ISSUE STATUS		PROJECT	PROPOSED NEW HOUSES, REAR OF 1 FROGNAL, LONDON.		
AS BUILT		DRAWING	PROPOSED & EXISTING SITE PLANS / LOCATION PLANS AND PHOTOS		
		DRAWING No.	ED/FR/01 - B		DRAWN BY
		DATE	SEP 12		SCALE
					1:100, 1:500