


LOWER GROUND FLOOR PLAN

- KEY TO ACCOMMODATION:
- 1. - HALL
 - 2. - BALCONY
 - 3. - BEDROOM
 - 4. - LIVING AREA
 - 5. - COURTYARD
 - 6. - BEDROOM
 - 7. - STORAGE
 - 8. - BATH/SHOWER ROOM
 - 9. - KITCHEN
 - 10. - VOID

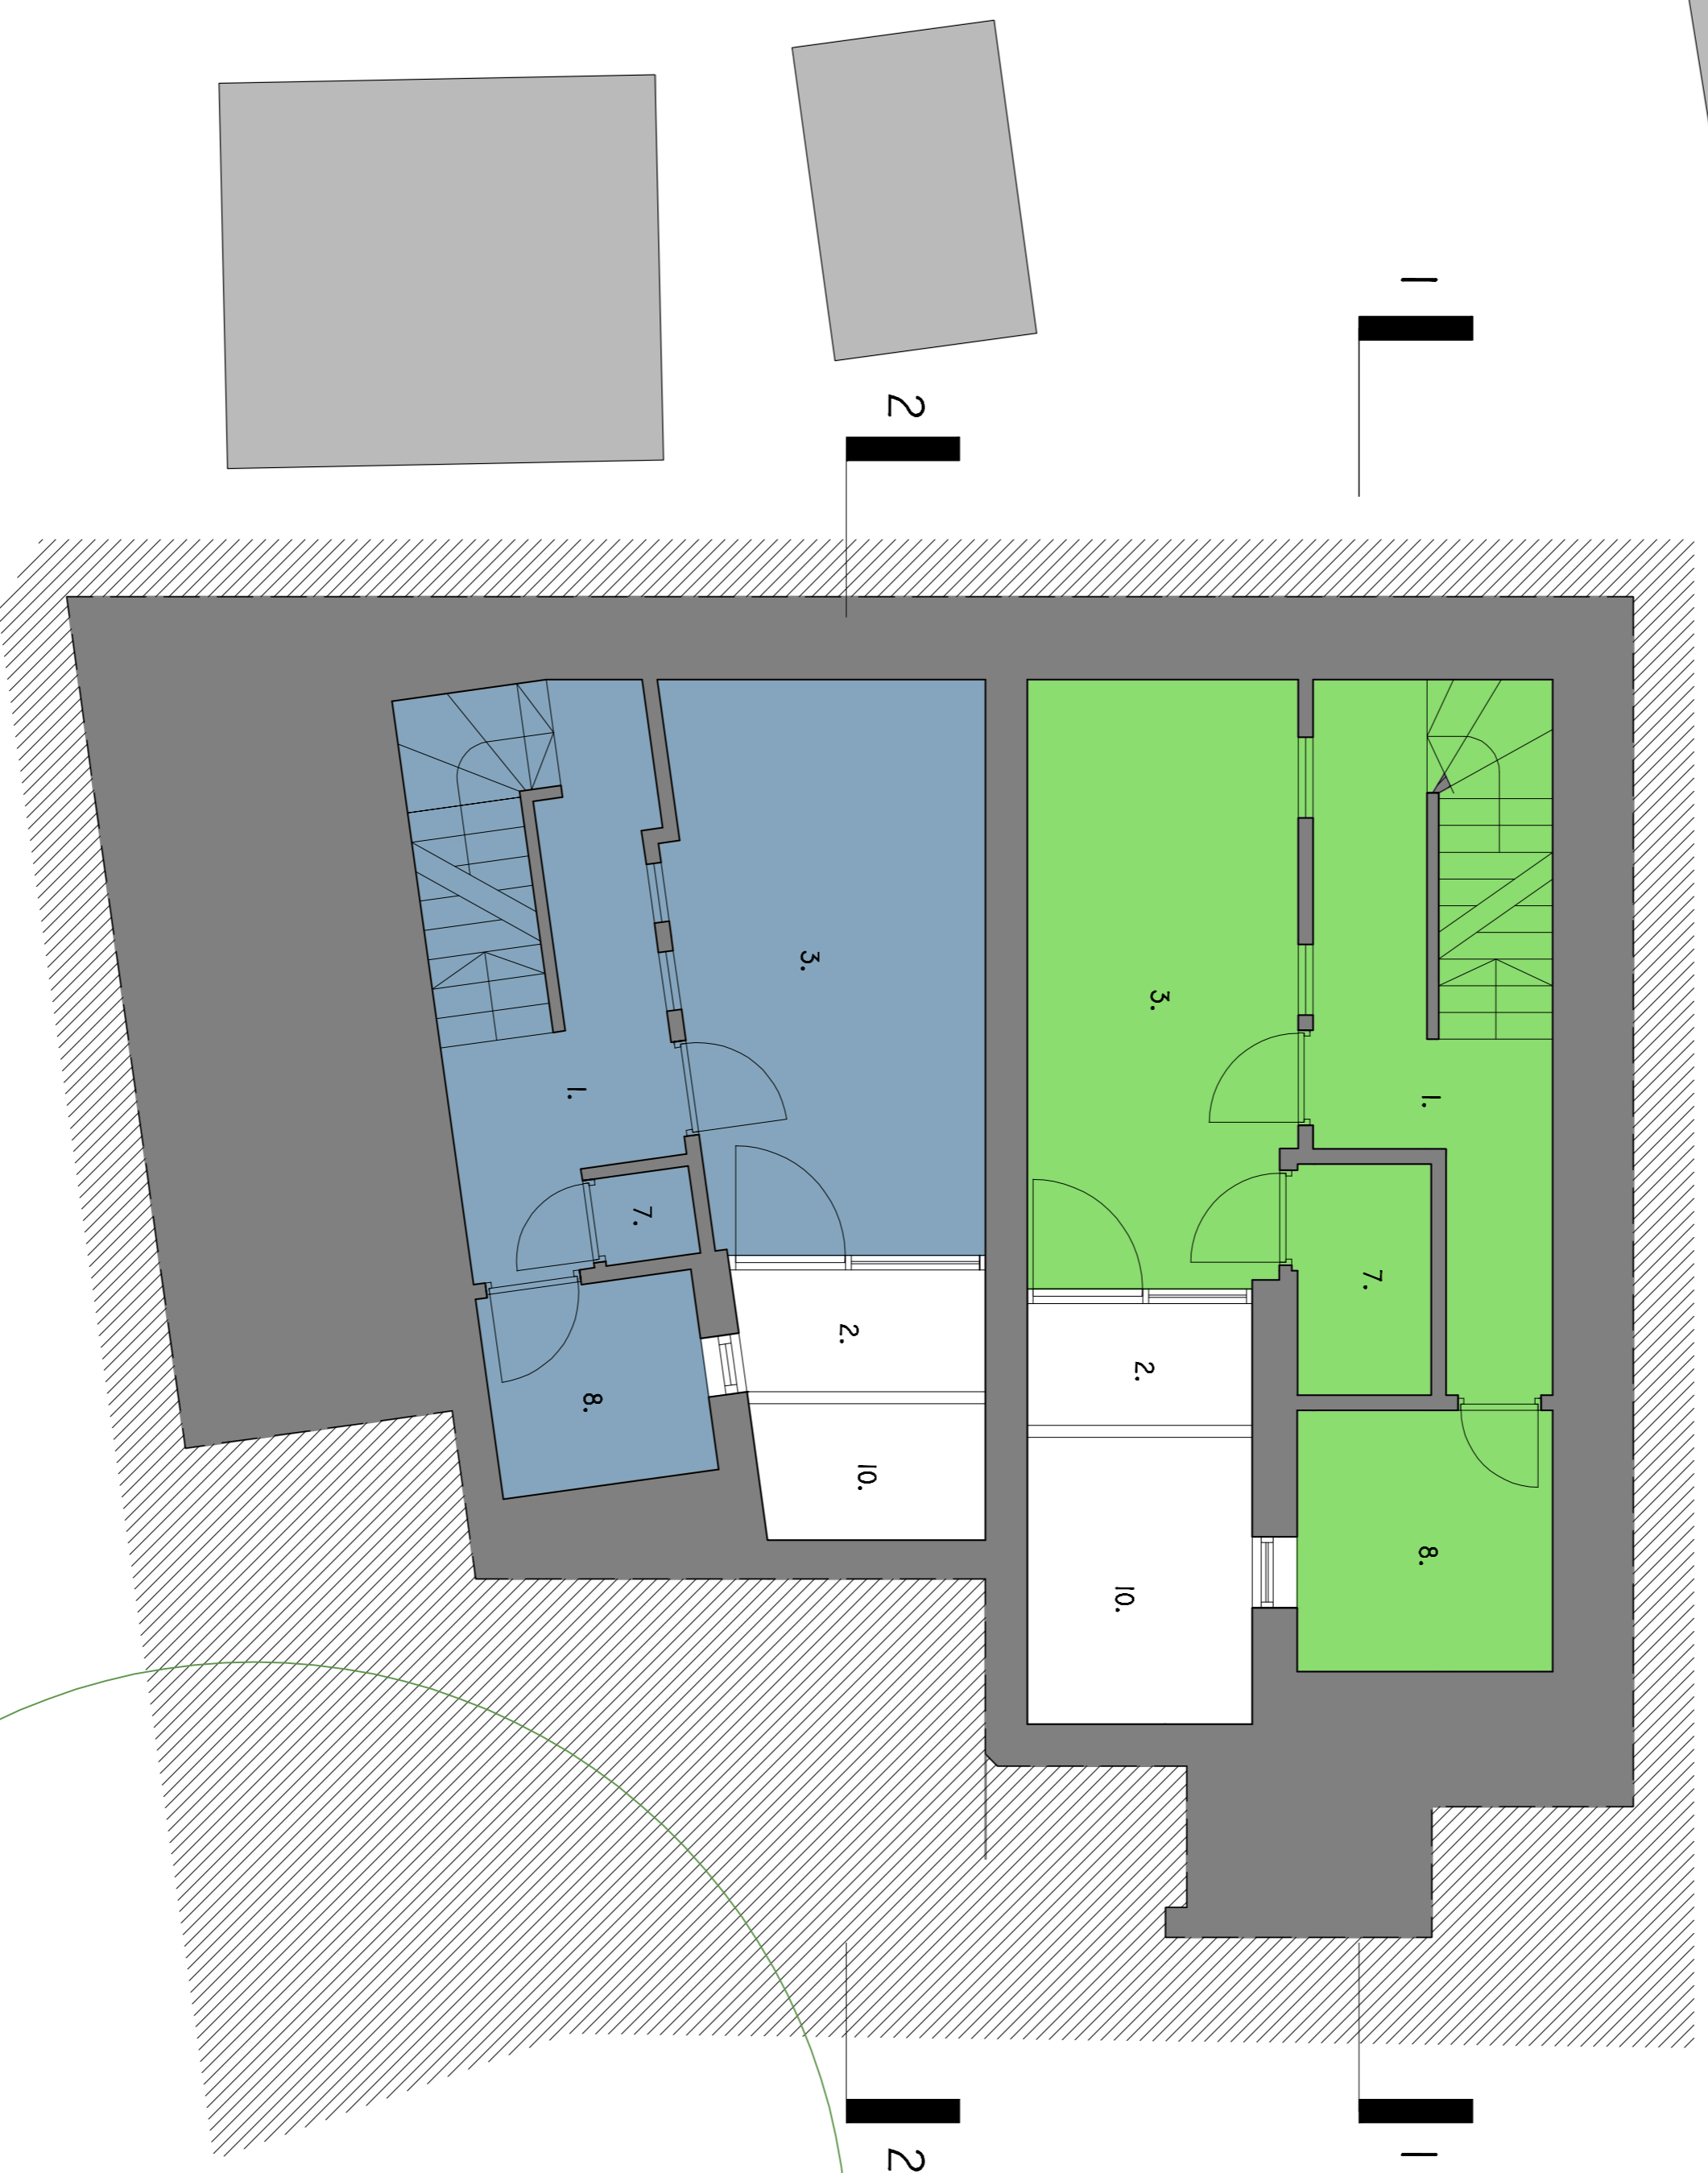

REV.	A	Amendments relating to CPD detailing standards added	23/11/12
ISSUE STATUS	C	AS BUILT	14/2/17
AS BUILT		PROJECT	PROPOSED NEW HOUSES, REAR OF 1 FRODOVA, LONDON.
		DRAWING	AS BUILT - PROPOSED LOWER GROUND FLOOR PLAN
		DRAWING No.	ED/19/202 - C
		DATE	SEP 12
		DRAWN BY	SCALE
		NO	1/50
		83 Abchurch Lane Road London EC4N 3AH Tel: 0203 340 2029 info@architectsroom.com	