




SECTION I-1

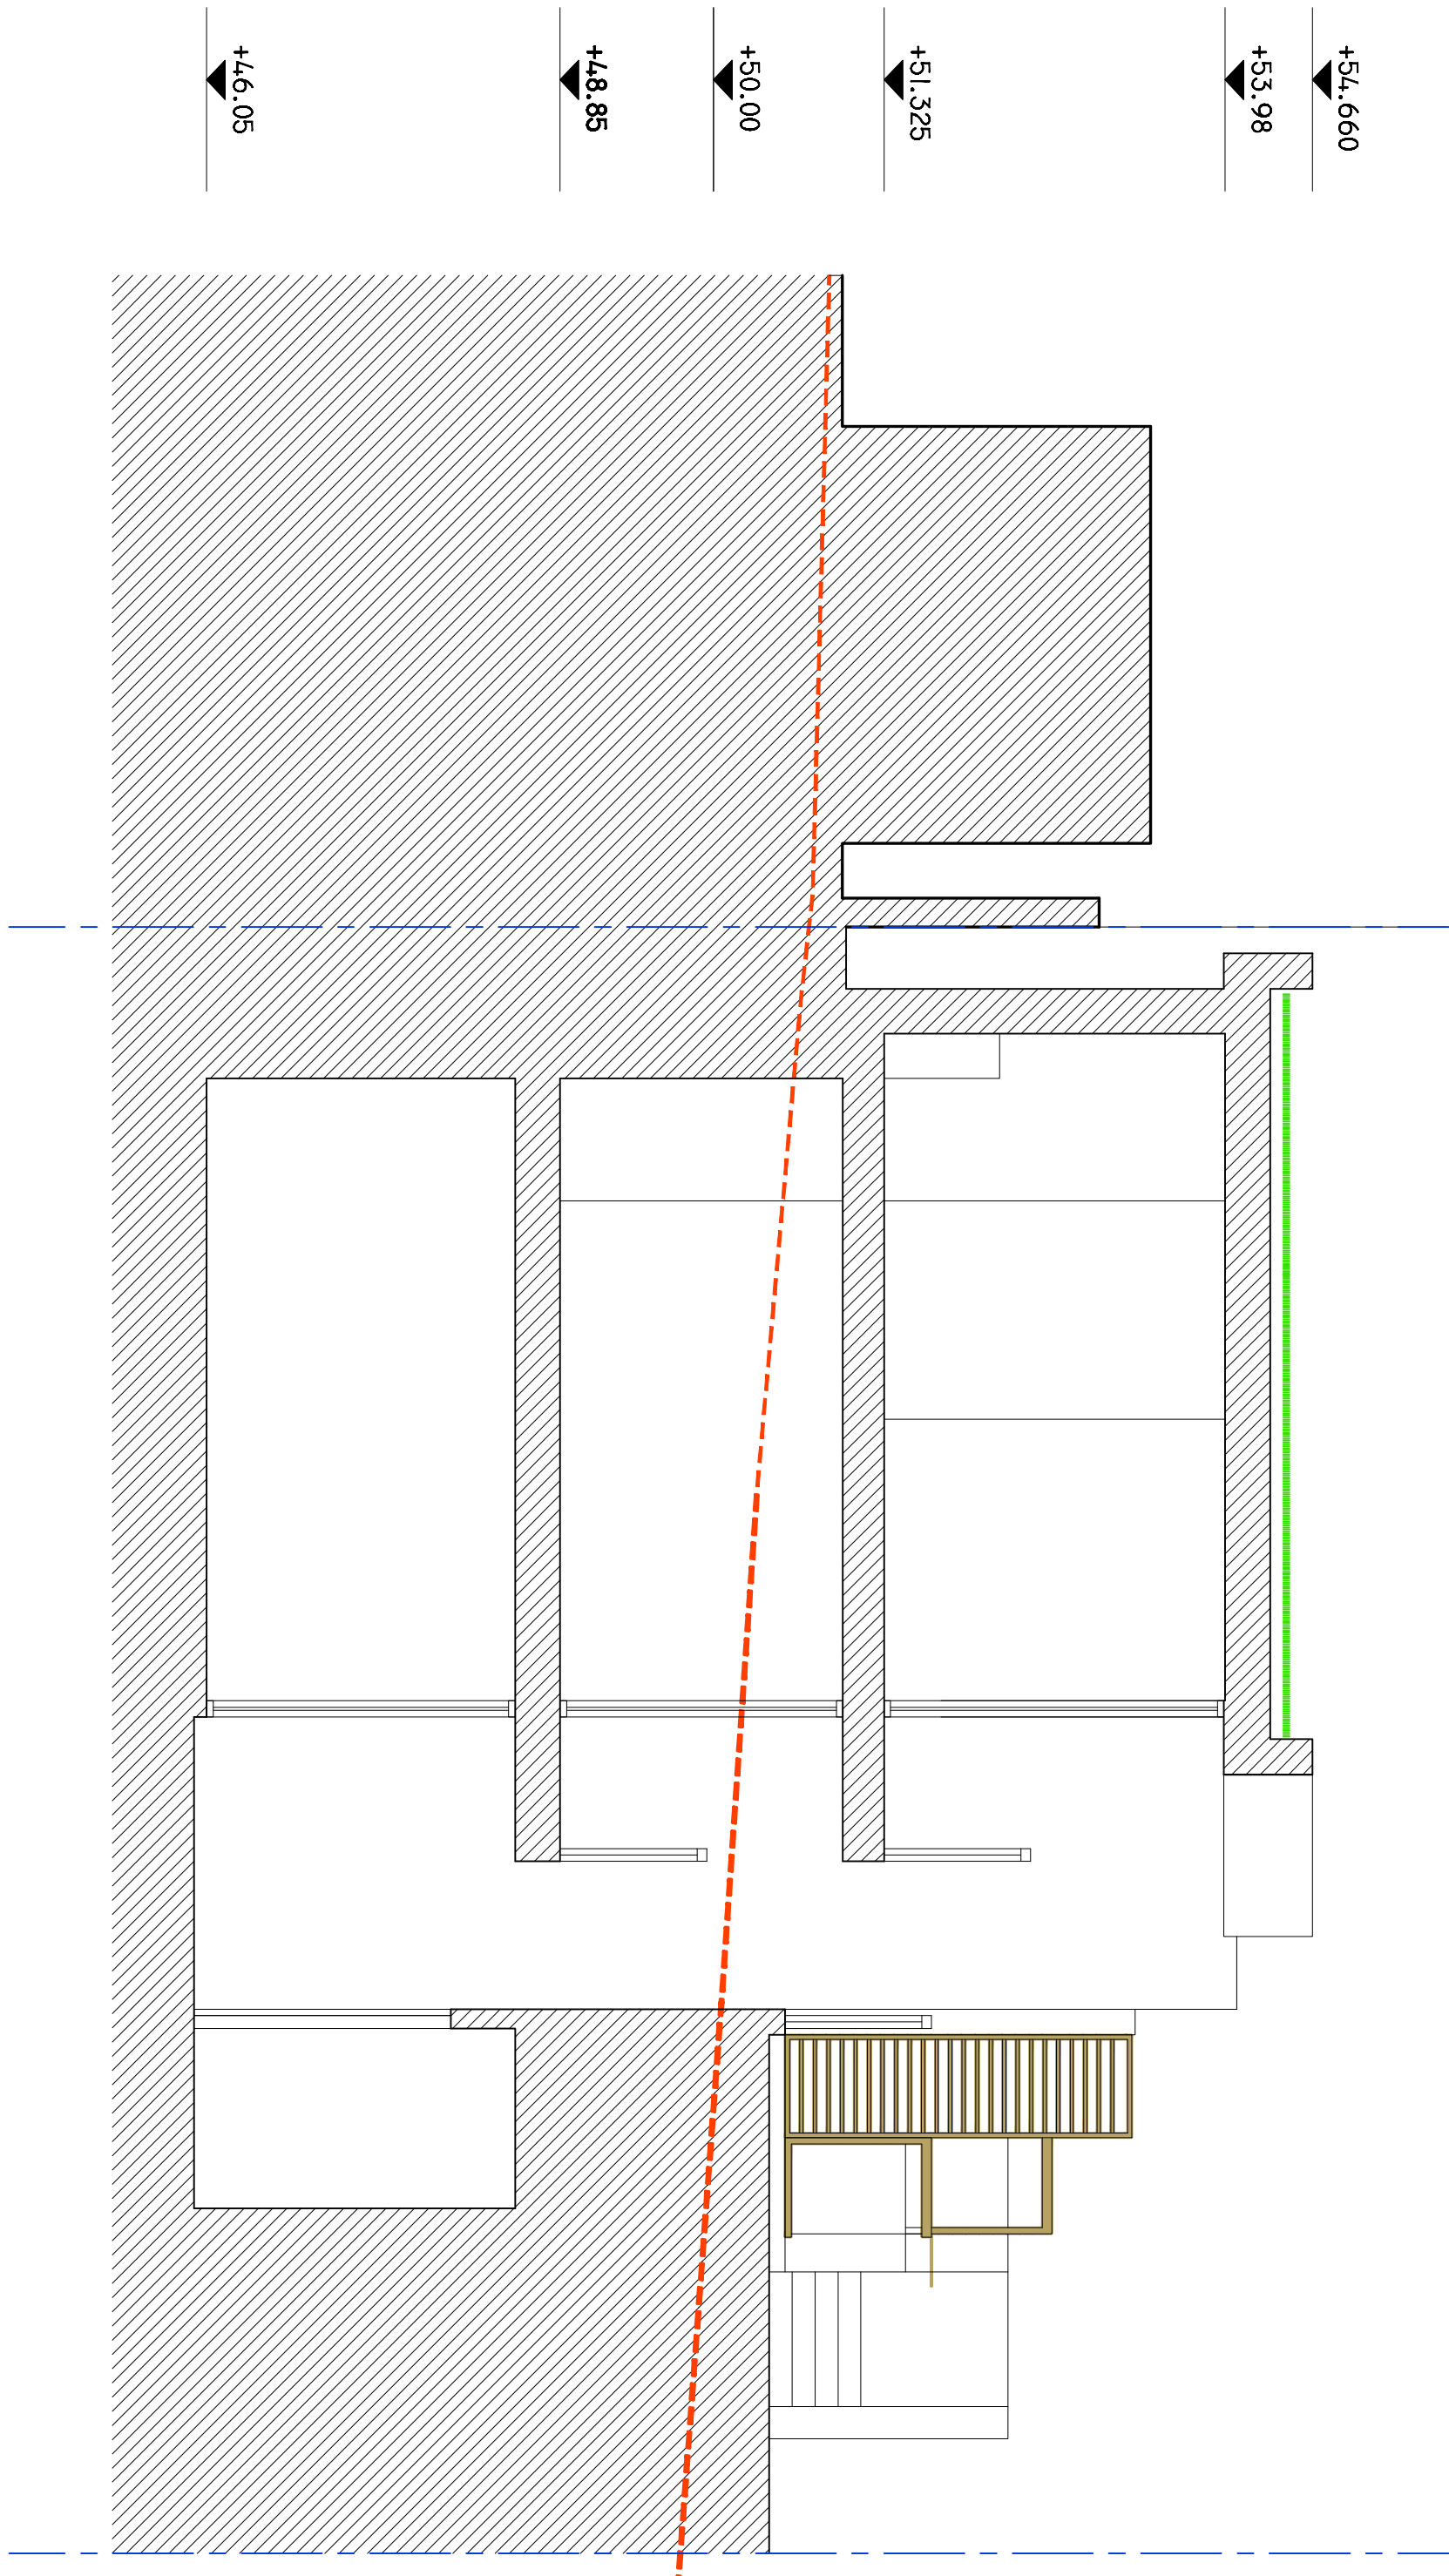

SECTION 2-2

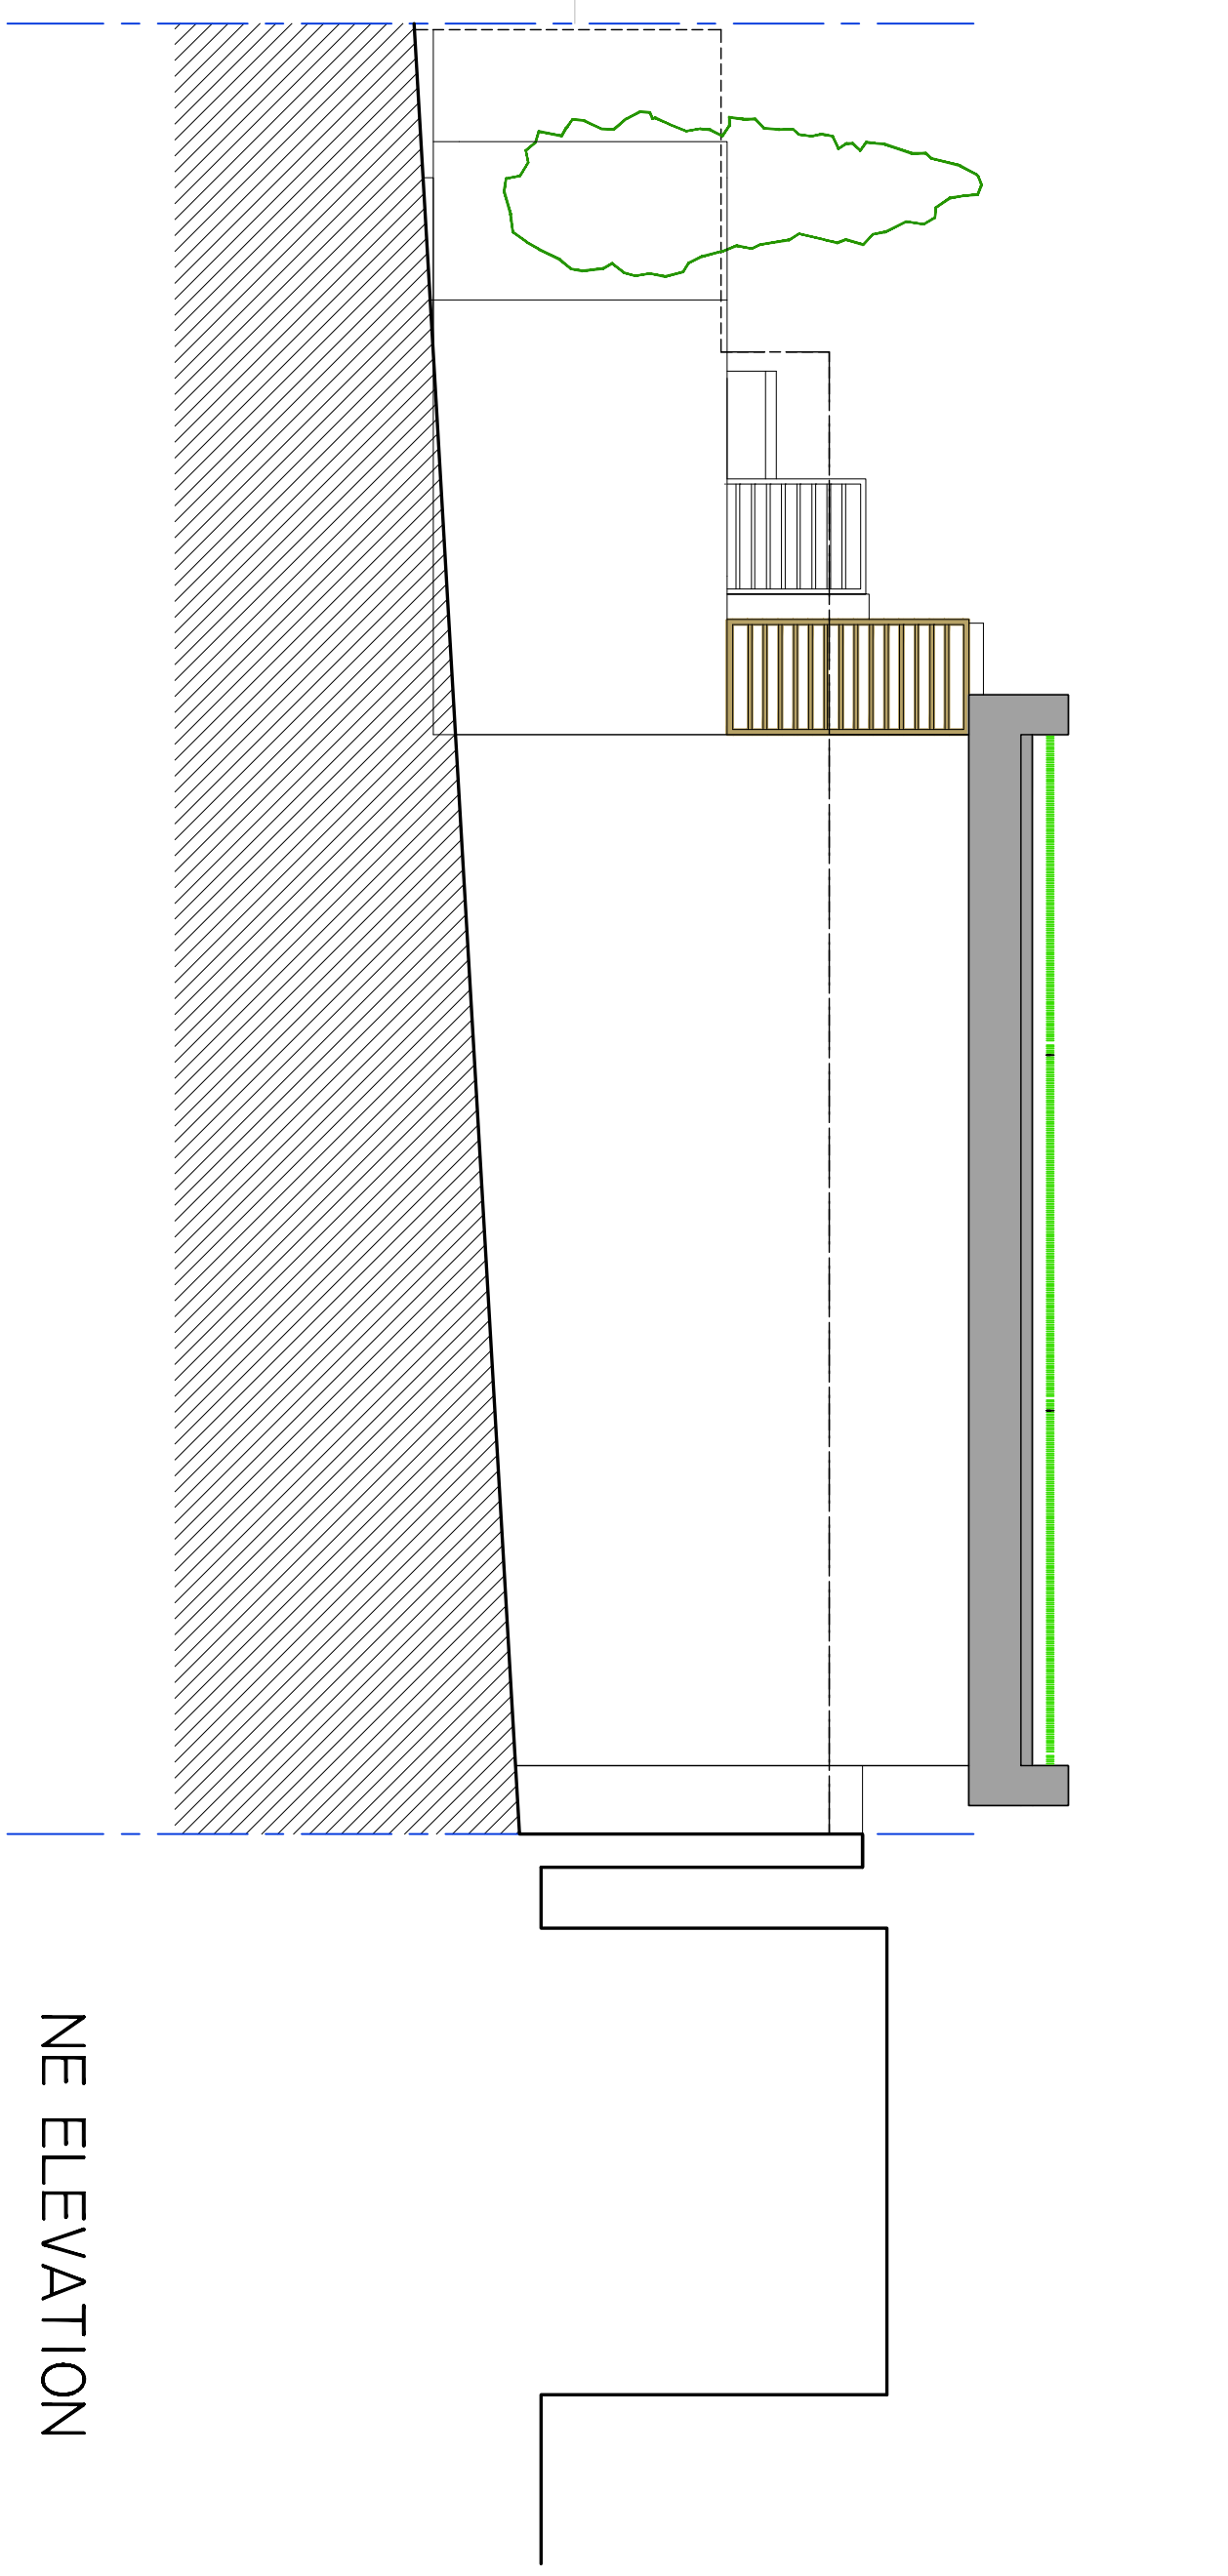

NE ELEVATION

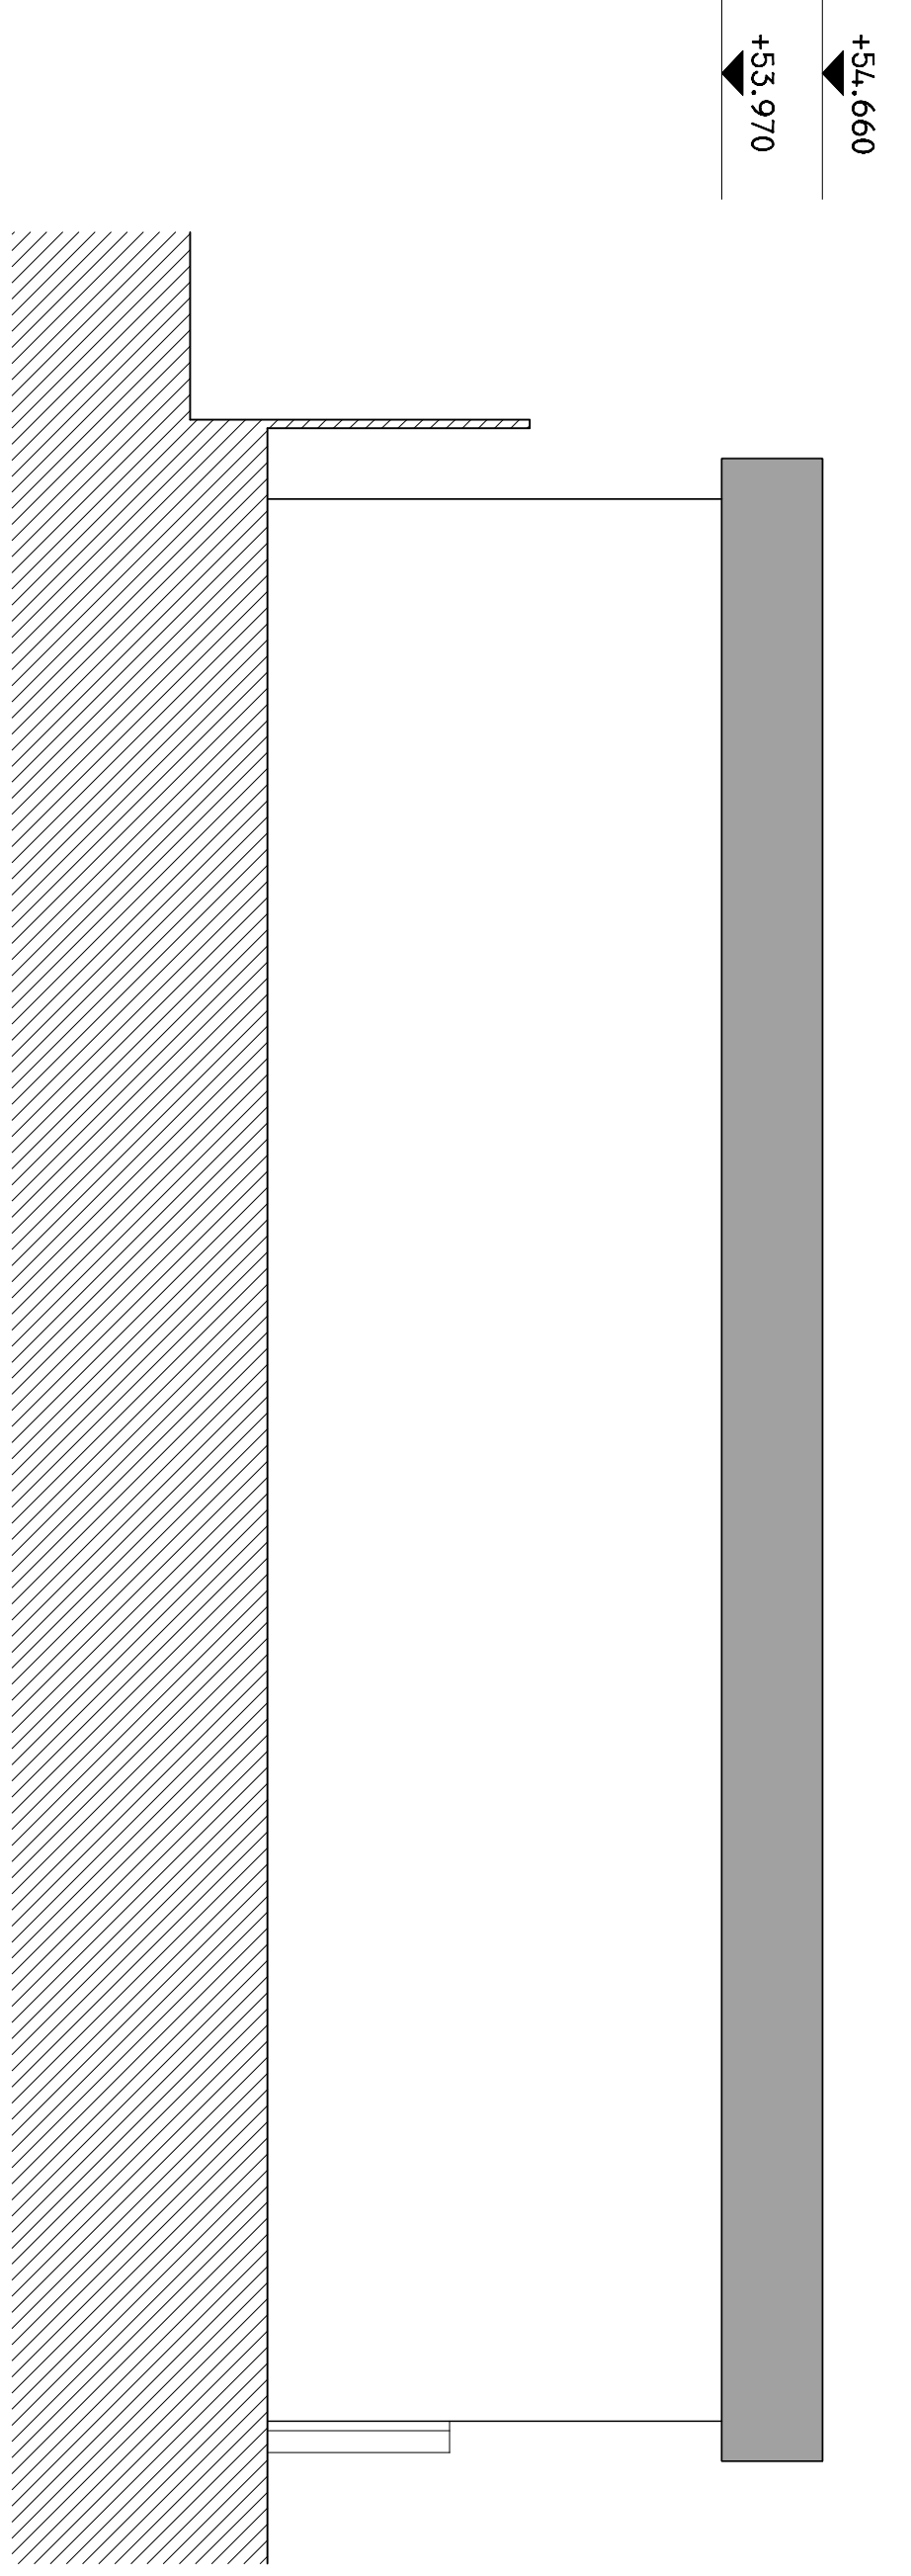

NW ELEVATION

REV.	A	Annotation relating to CPD deignifing standards added	23-11-12
	b		23-10-13
	0	addition of basement level	14-2-17
ISSUE STATUS		PROJECT	PROPOSED NEW HOUSES, REAR OF 1 FRODUAL, LONDON.
AS BUILT		DRAWING	AS BUILT - CROSS SECTIONS I-1 & 2-2 & ELEVATIONS (NE & NW)
		DRAWING No.	ED/199/401 - 0
		DATE	SEP 12
		DRAWN BY	SCALE
			1:50