


SW ELEVATION

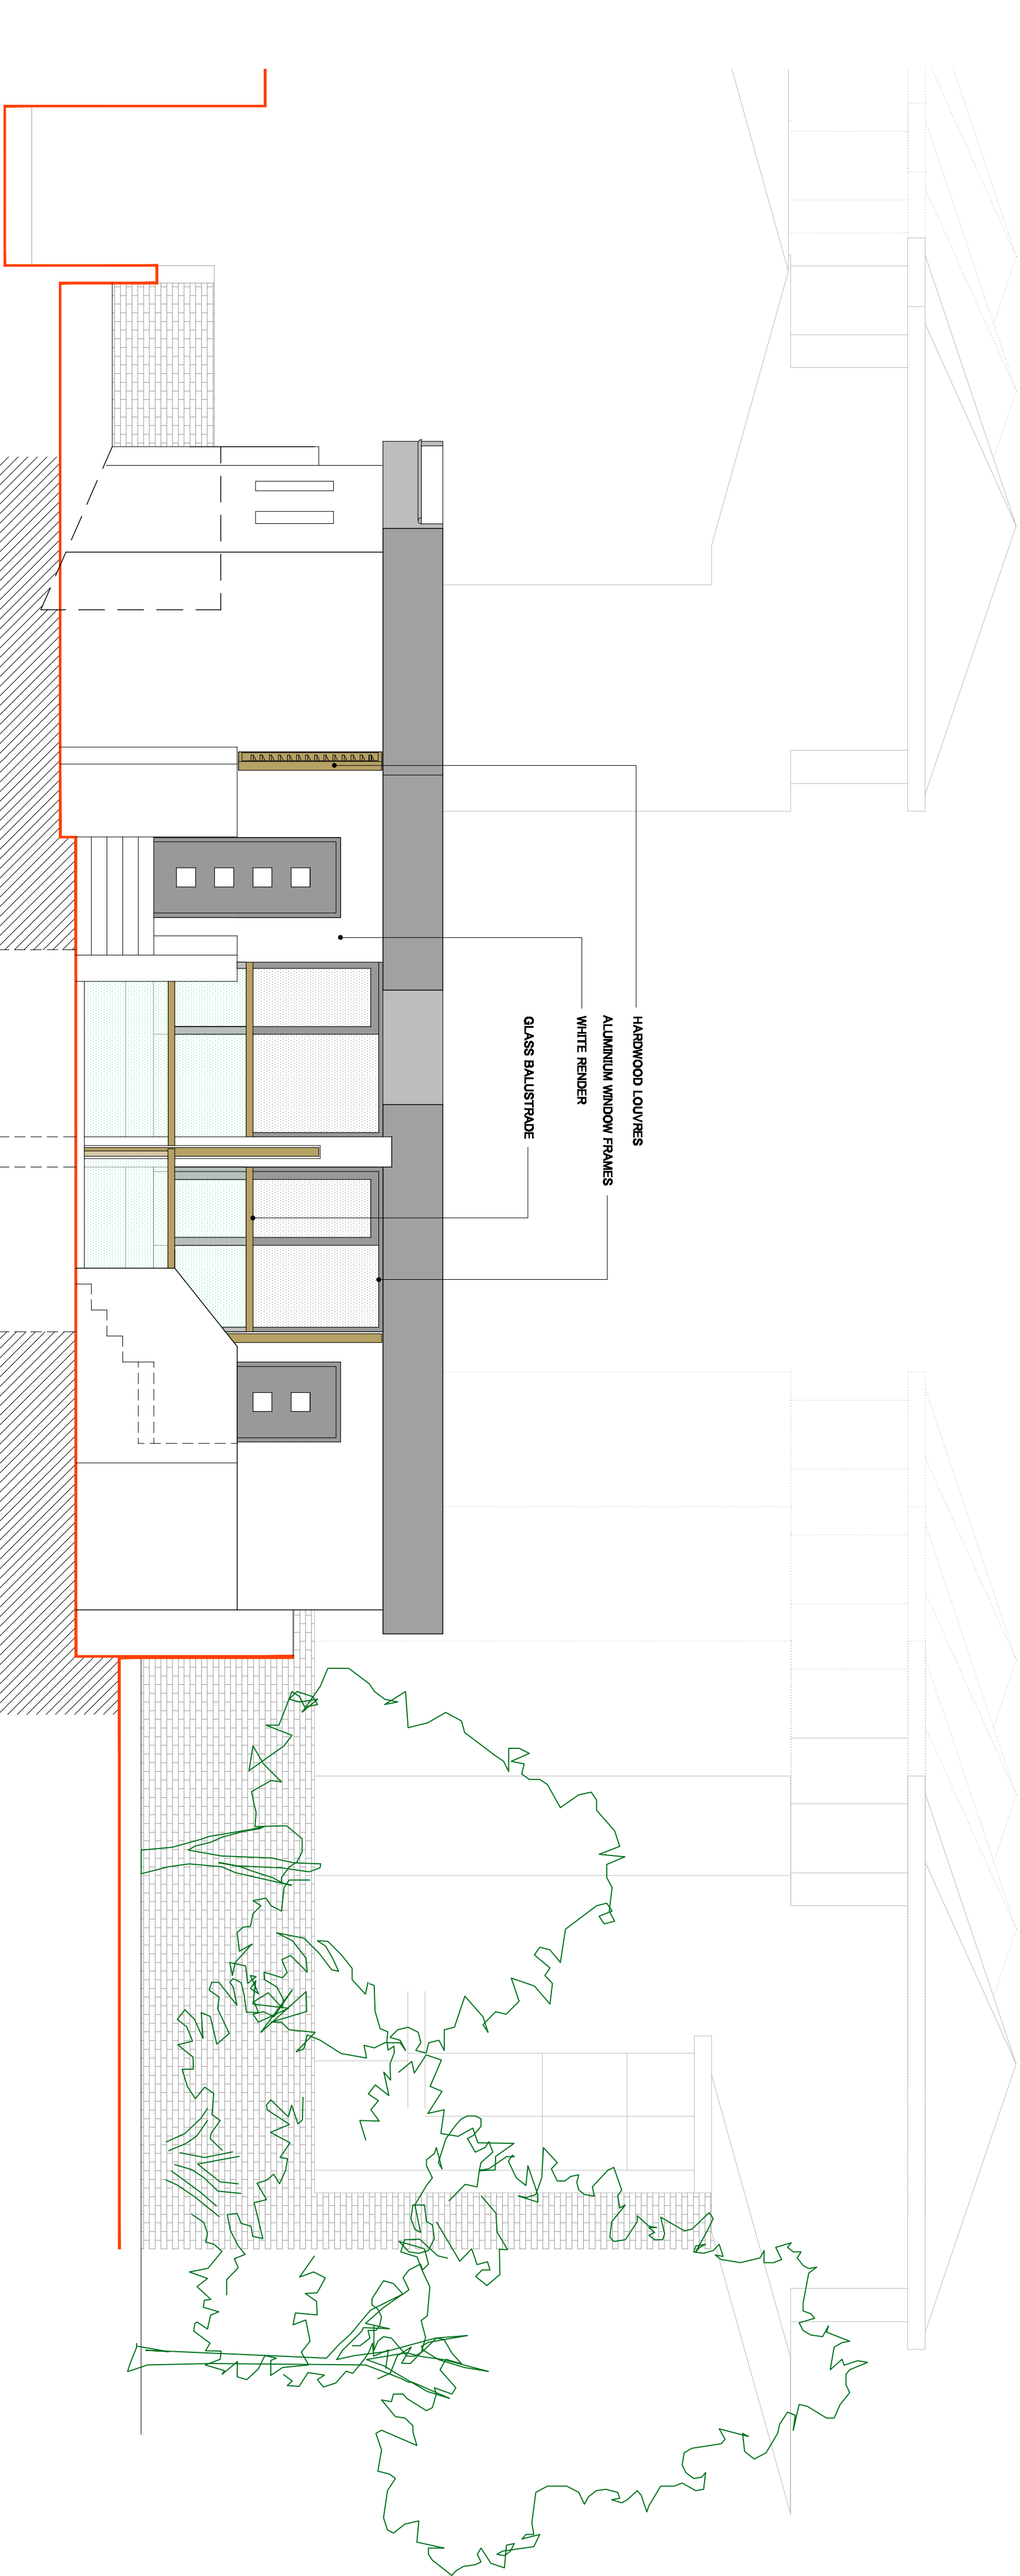

SE ELEVATION

| REV. | 2nd cycle shown added   |   |   | PROJECT     | PROPOSED NEW HOUSES, REAR OF 1 PRINCIPAL, LONDON. |  |  |          | 28-11-12<br>28-10-13<br>14-02-13 |
|------|---|---|---|-------------|---|--|--|----------|----------------------------------|
|      | A   | B | C |             |   |  |  |          |                                  |
|      | Additional annotation relating to parking along south west boundary |   |   |             |   |  |  |          |                                  |
|      | 2nd cycle shown added   |   |   |             |   |  |  |          |                                  |
| D    | AS BUILT  |   |   | DRAWING     | AS BUILT ELEVATIONS (SE & SW)                     |  |  |          |                                  |
|      |   |   |   | DRAWING No. | ED/TFP/402 - D                                    |  |  | DRAWN BY |                                  |
|      |   |   |   | DATE        | MAY 12  |  |  | SCALE    |                                  |
|      |   |   |   |             |   |  |  | 1:50     |                                  |

AS BUILT