




SECTION A-A  
As-built

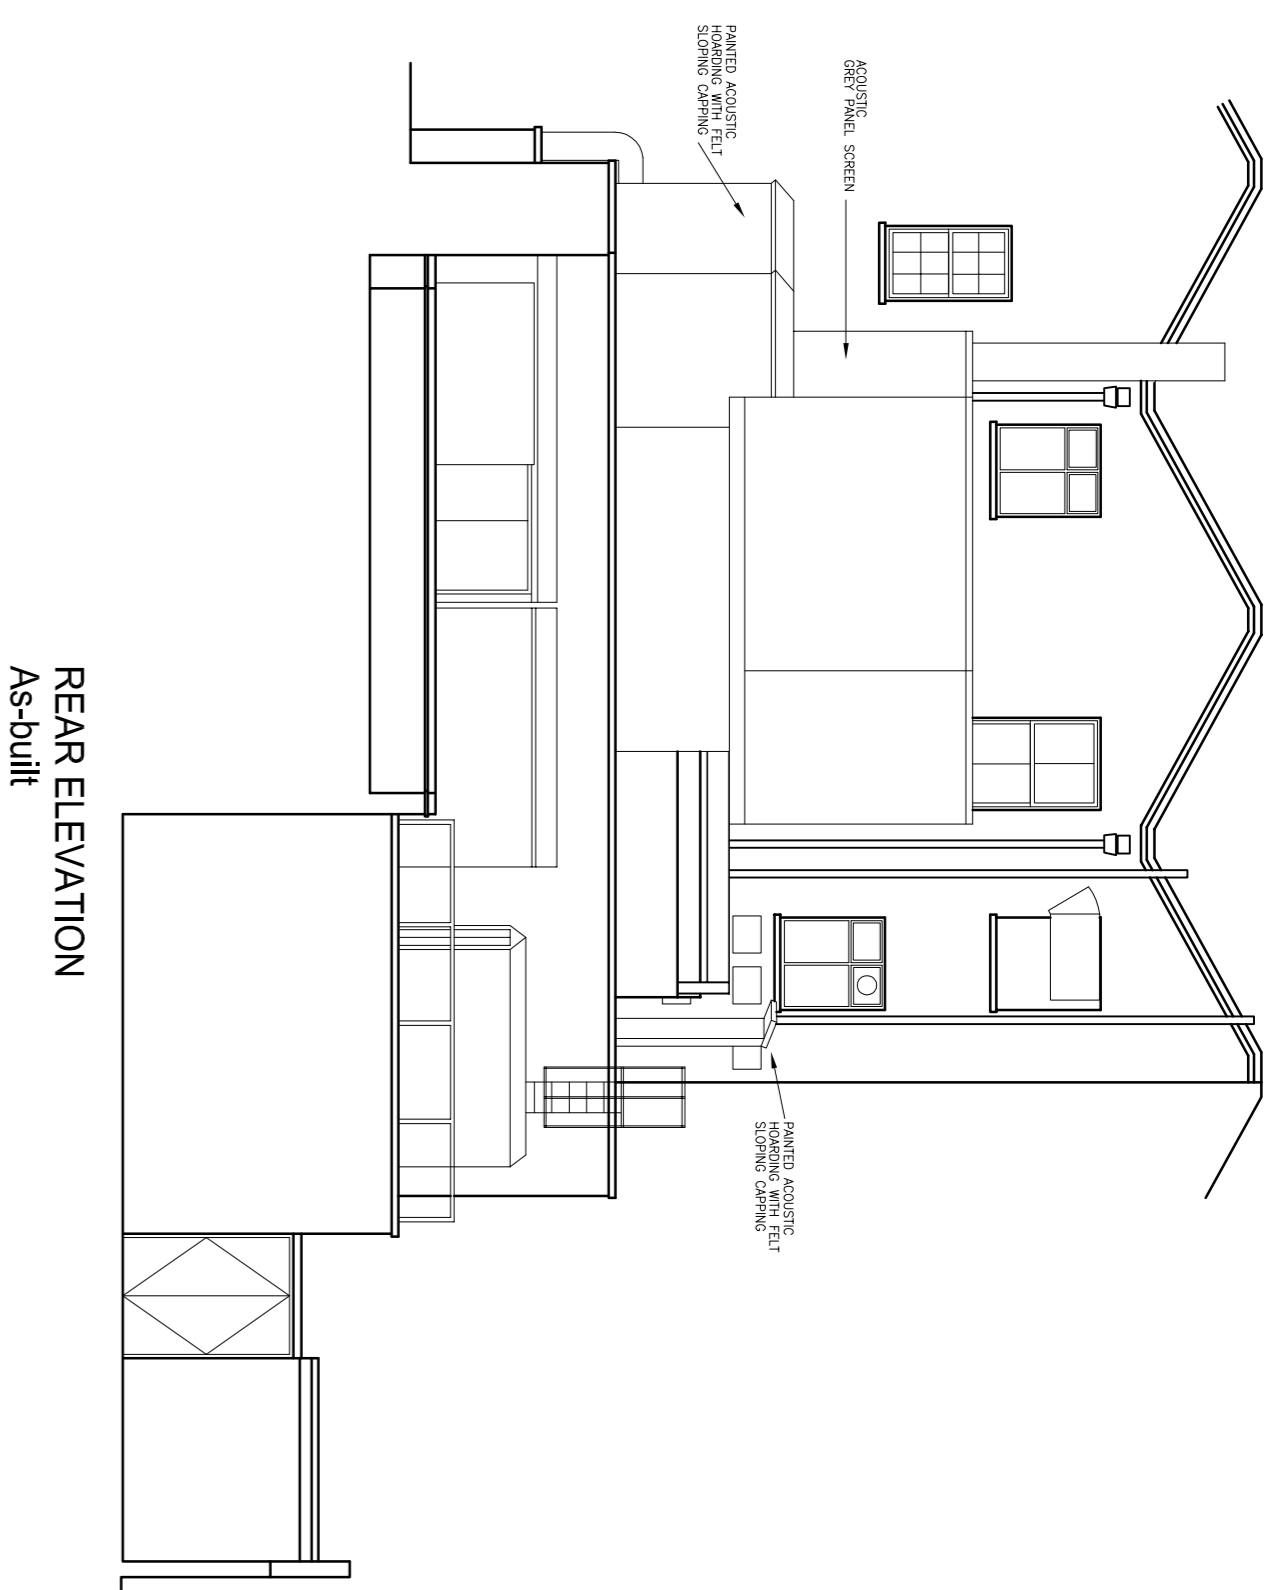


REAR ELEVATION  
As-built

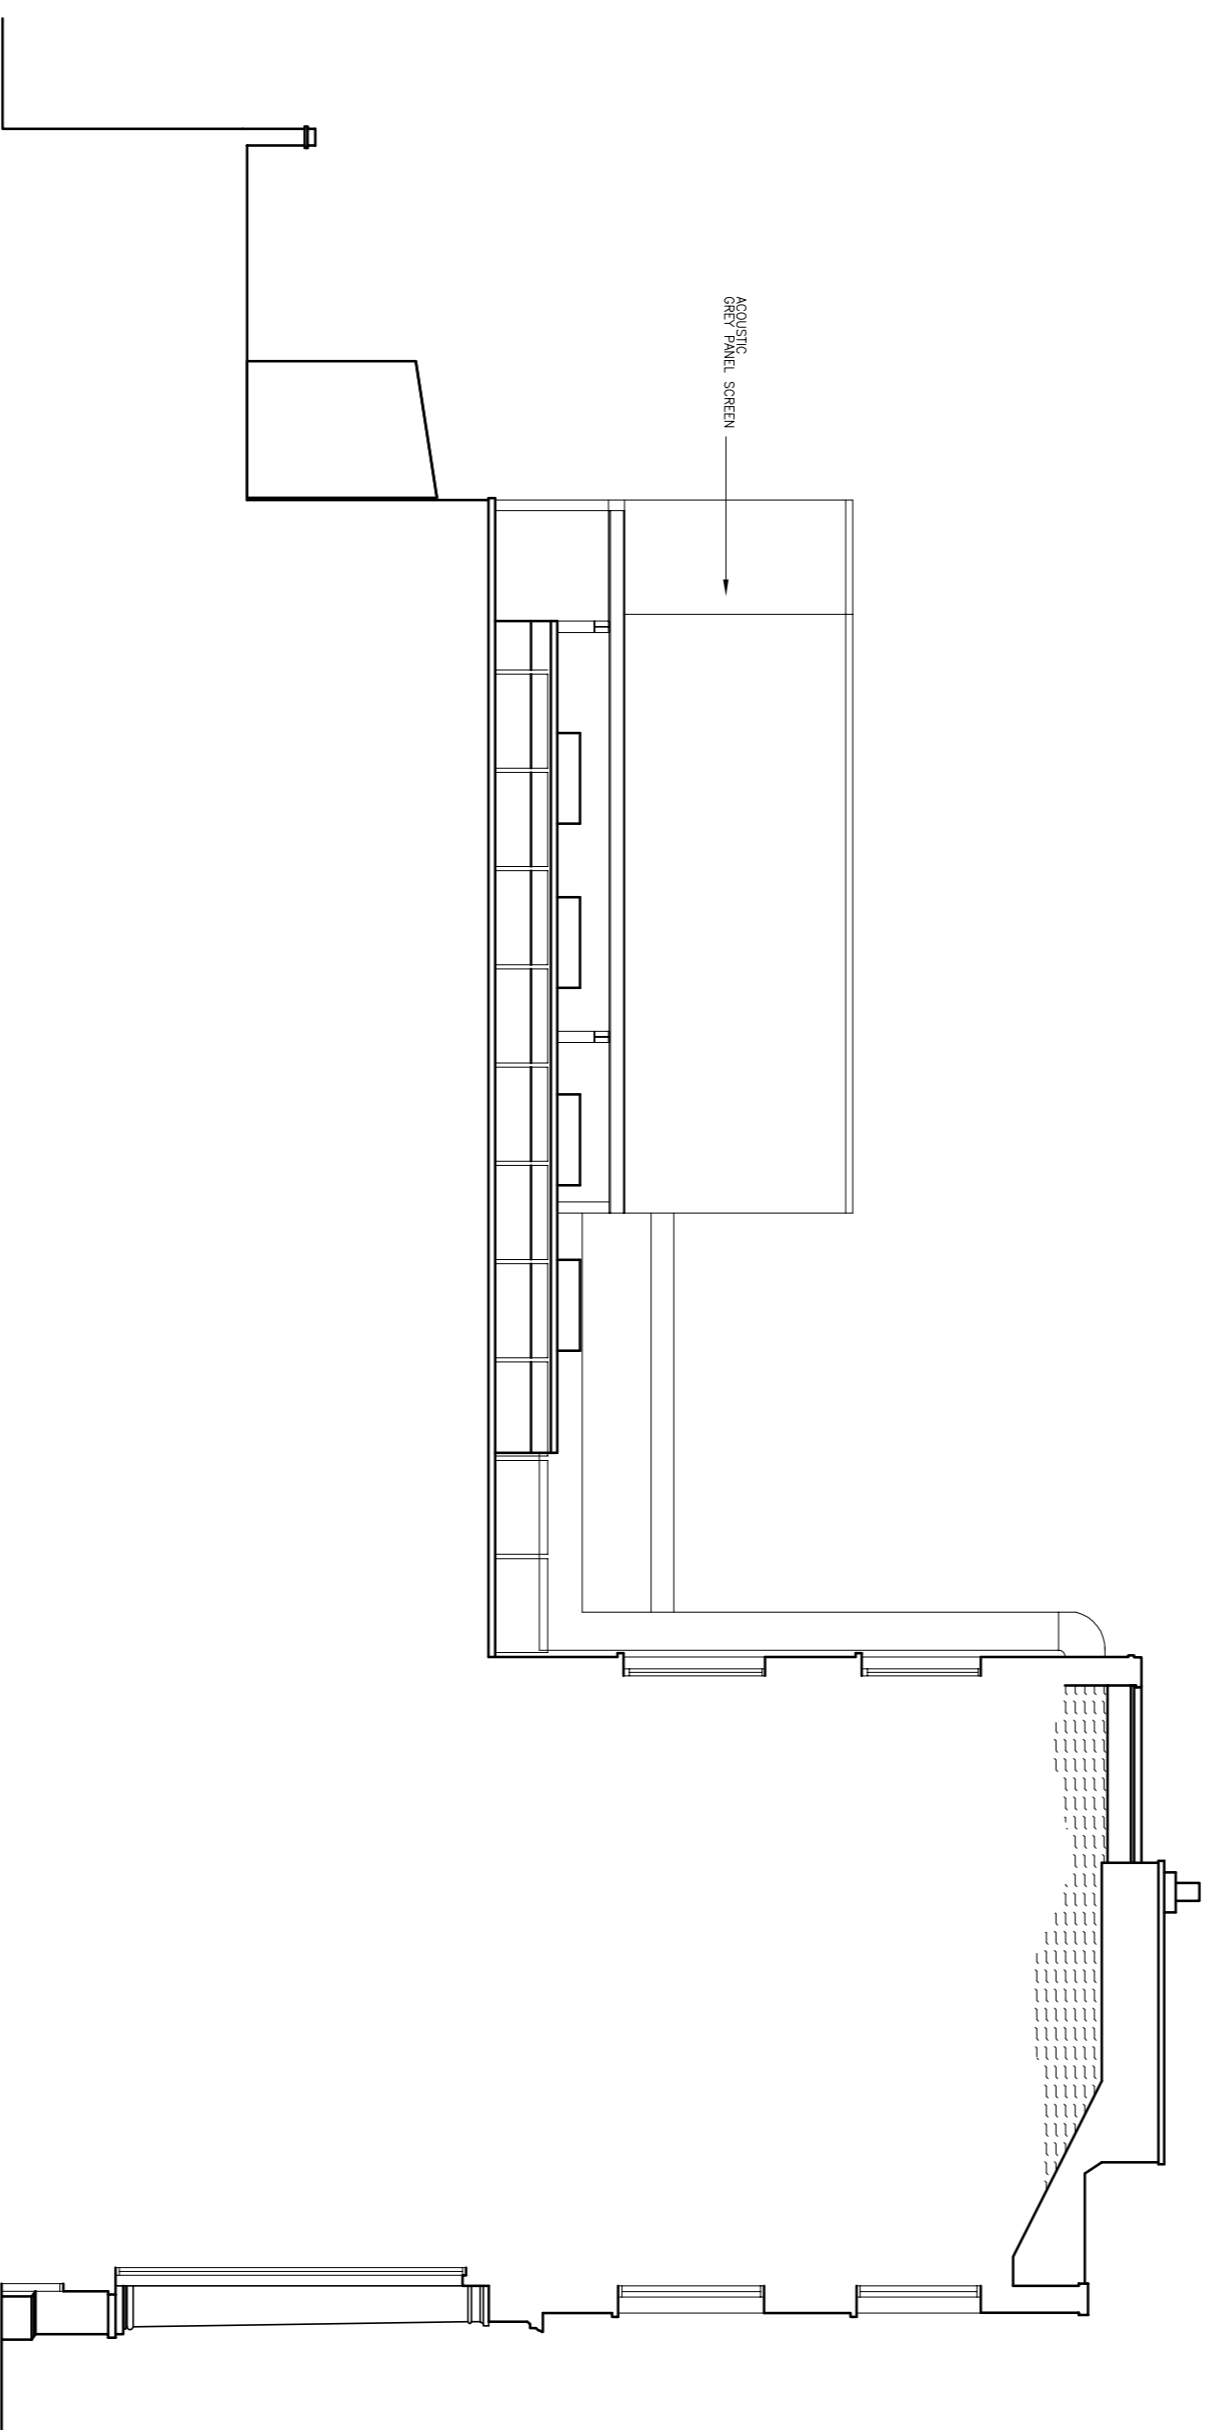

SIDE ELEVATION  
As-built

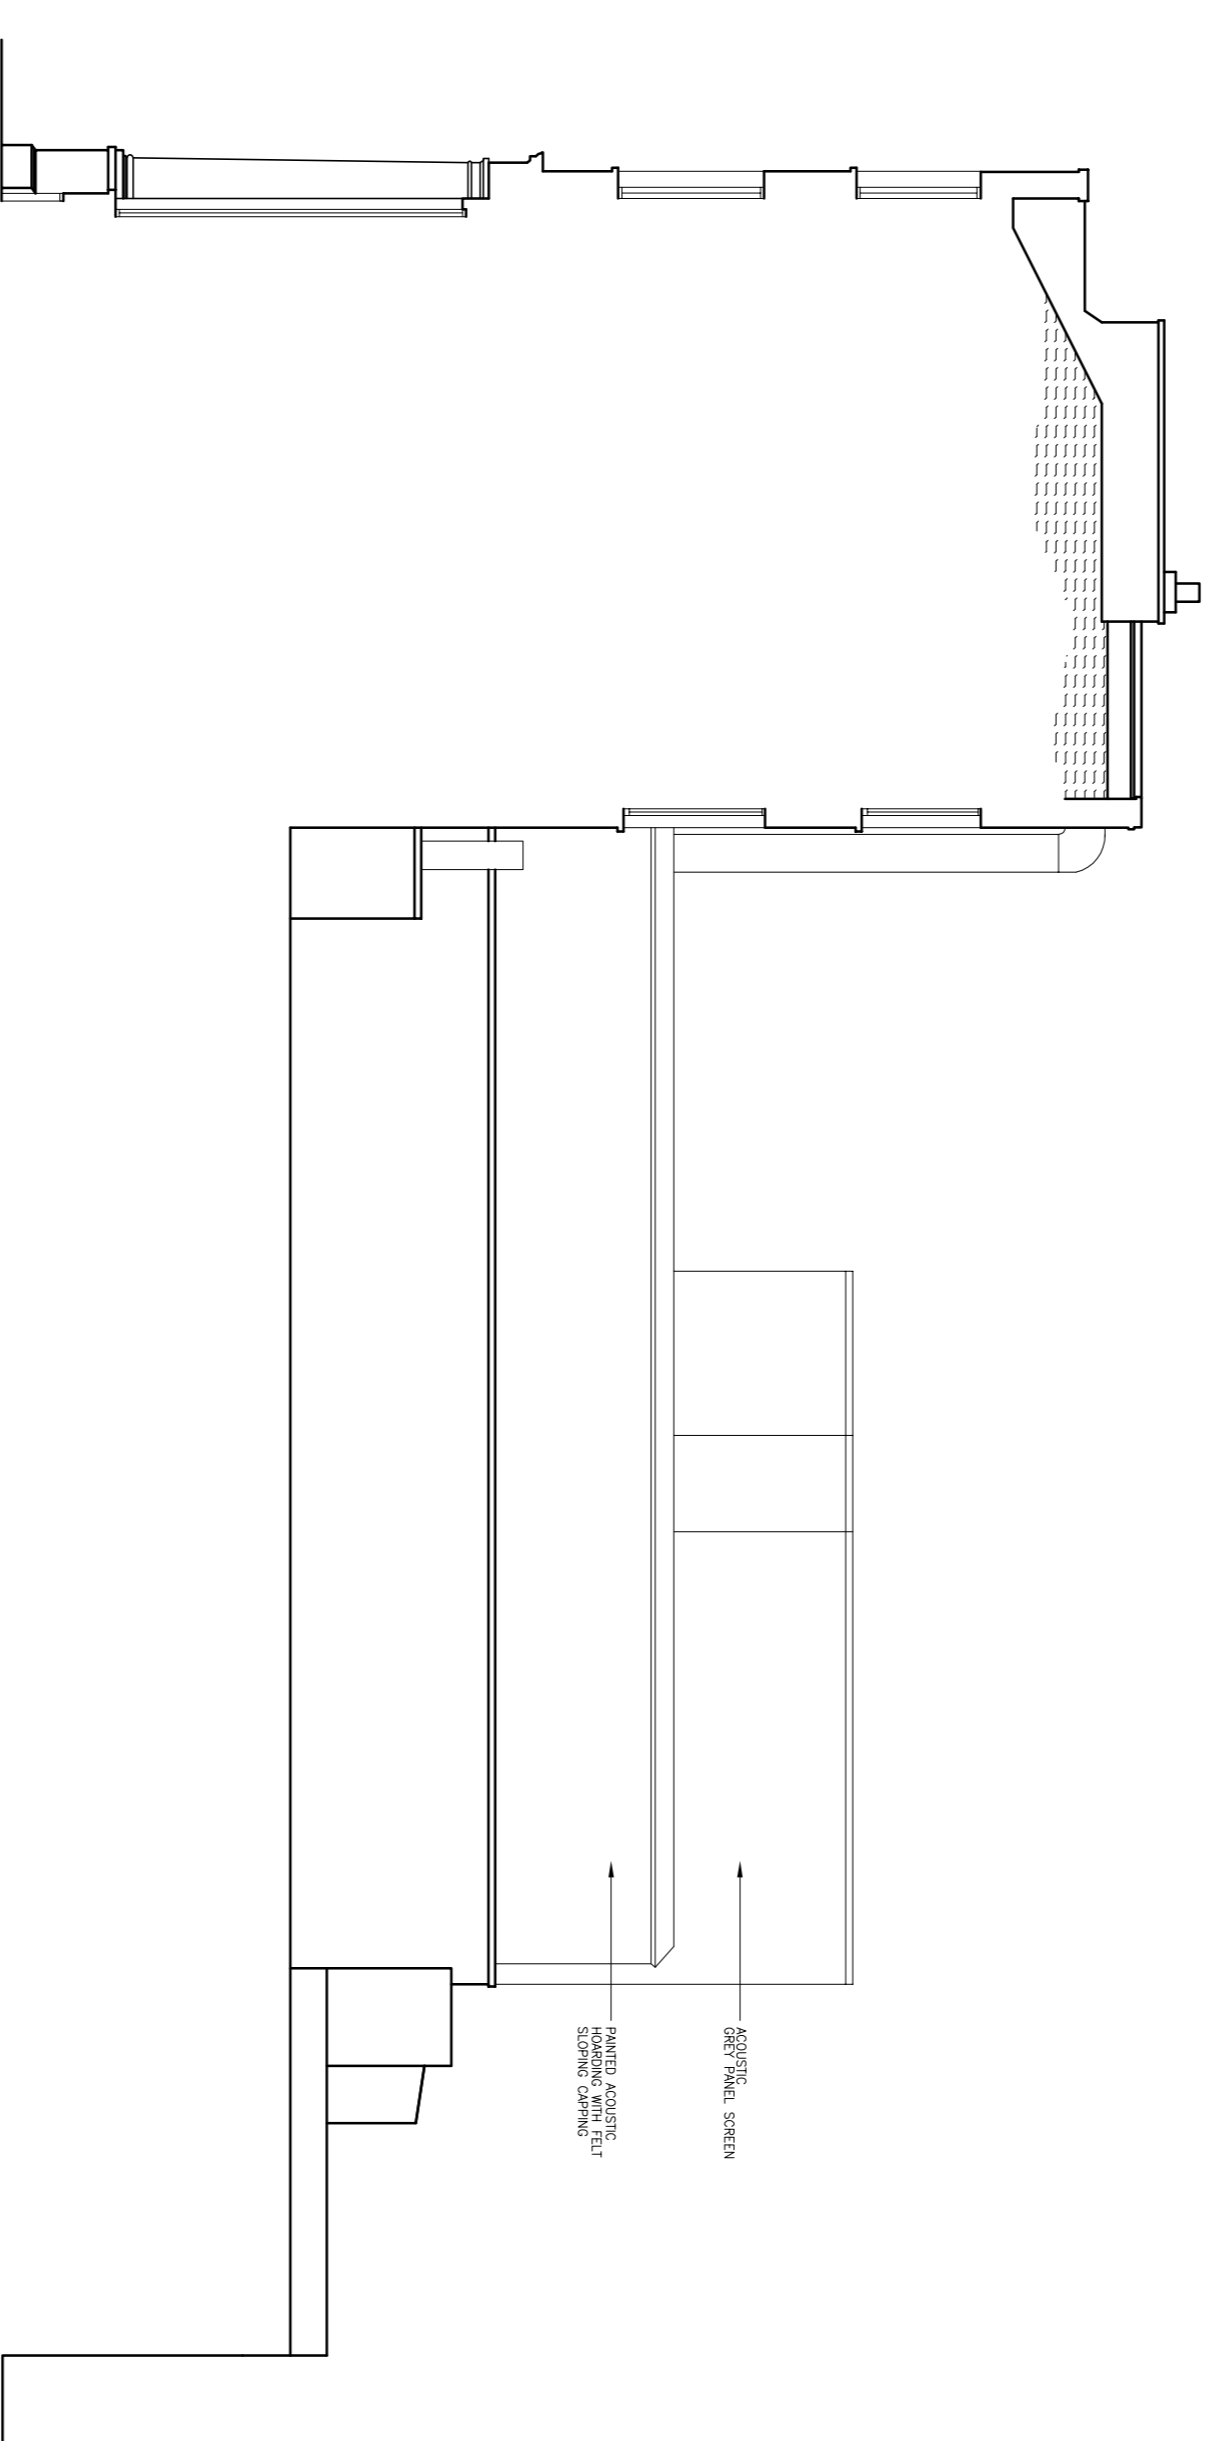

SIDE ELEVATION  
As-built

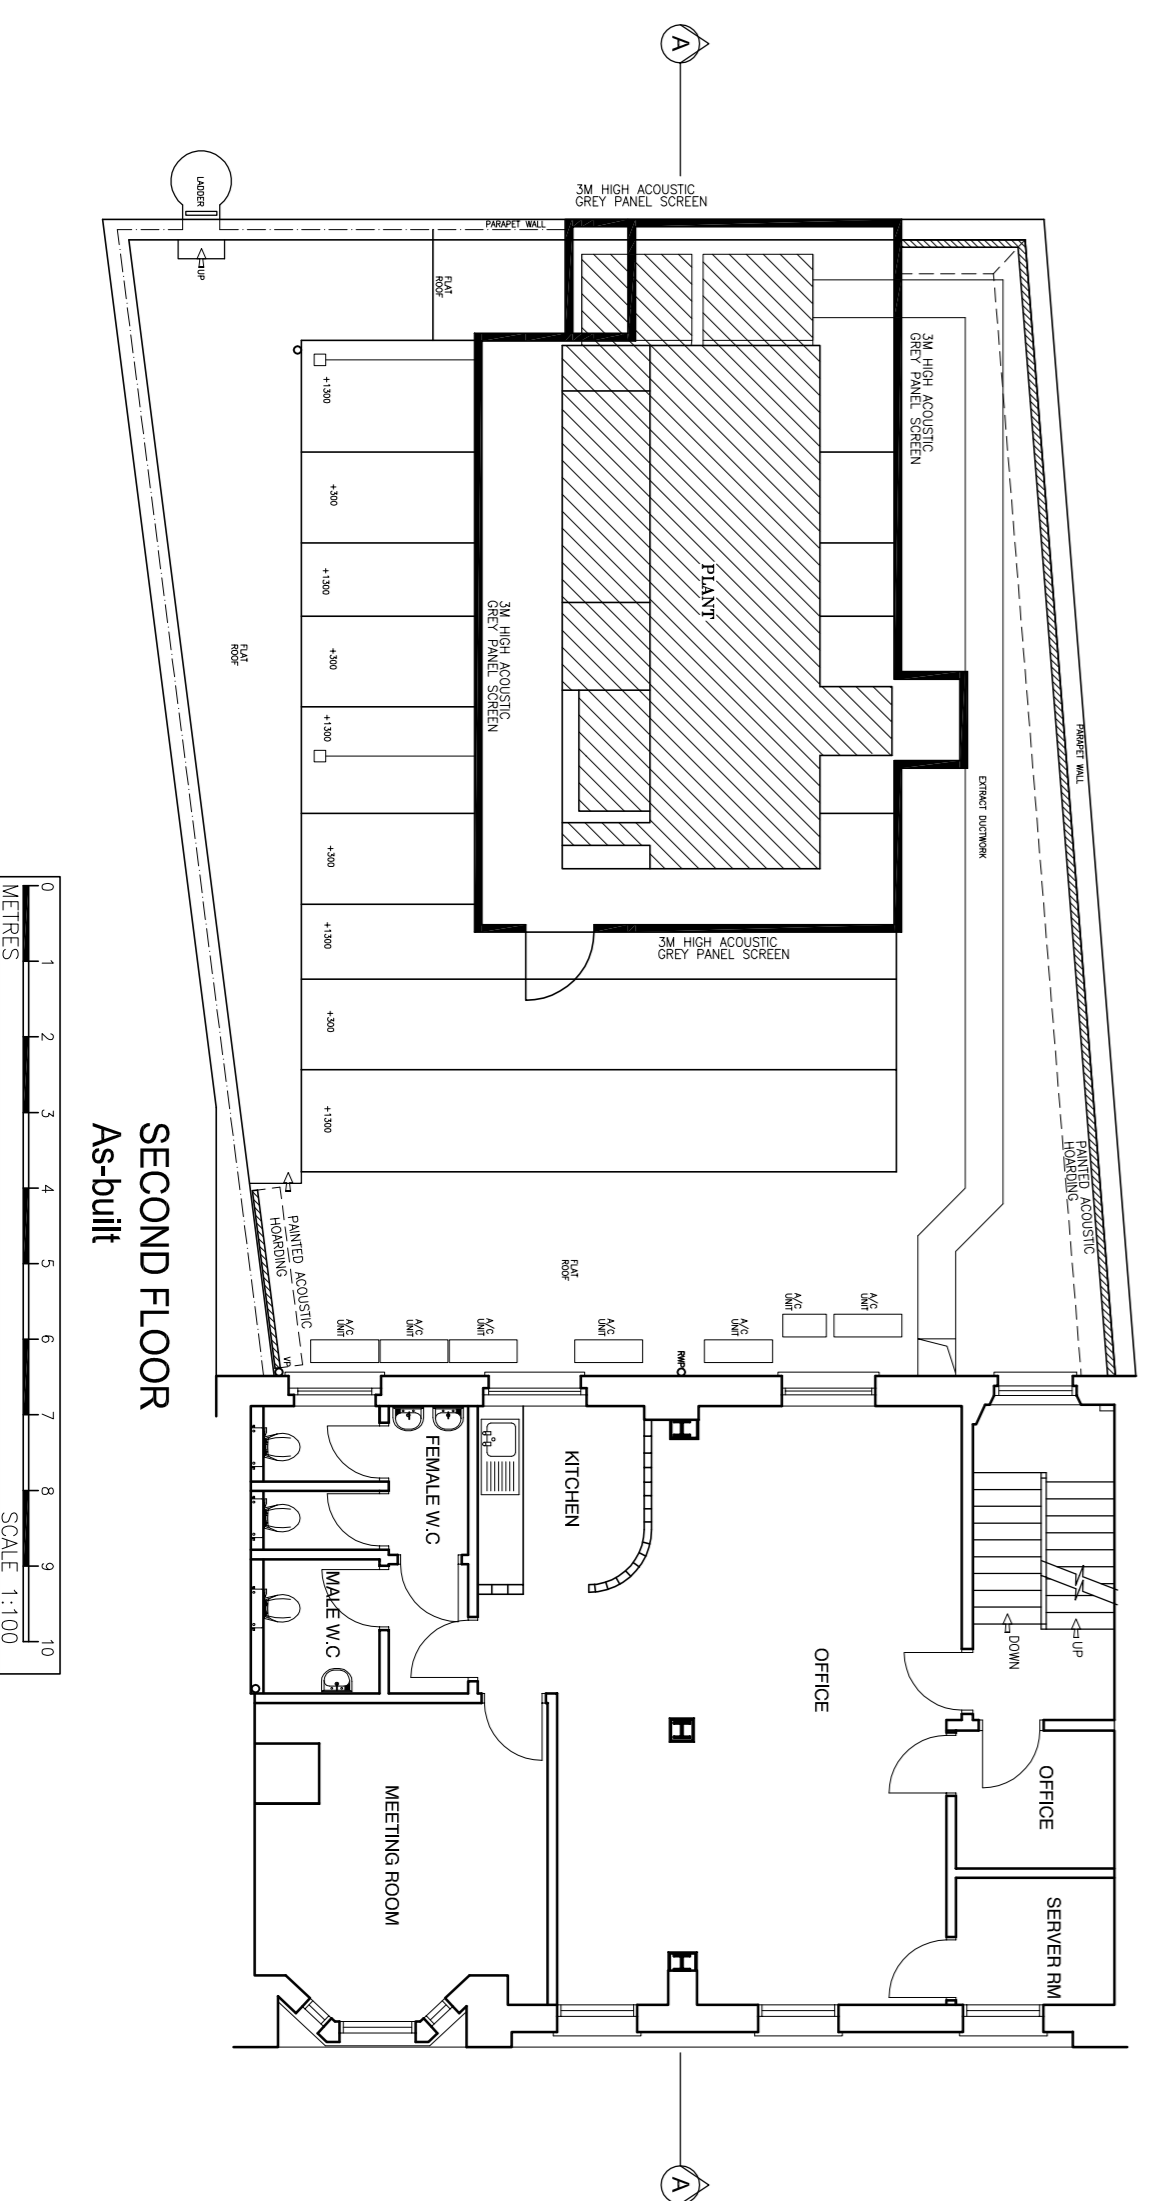

SECOND FLOOR  
As-built

No.	Rev.	Date

Project: **JAZZ CAFE  
5 PARKWAY  
LONDON, NW1 7PG**

Description:  
**AS-BUILT CURRENT ELEVATIONS  
& 2ND FLOOR ROOF PLAN**

Dimensions indicated must be checked on site before manufacture by contractor, any discrepancy should be reported immediately.

DRN.	NJR	DRG No.	DATE
		JC/16/104 <td>NOV 2016</td>	NOV 2016

SCALE: **1:100 @ A1**

**N.J.ROUSE**  
Architectural Design  
& Surveying Services

16 Terryson Road, Hutton, Brentwood, Essex CM13 2SU  
tel: 01277 417735 e: [nl@njrouse.co.uk](mailto:nl@njrouse.co.uk)  
m: 07958 790207 [www.njrouse.co.uk](http://www.njrouse.co.uk)