



8-11MS GROUND FLOOR - RISER LOCATIONS PRE APPLICATION 2015/3203/P & 2015/4344/L


8-11MS GROUND FLOOR - AS INSTALLED RISER LOCATIONS

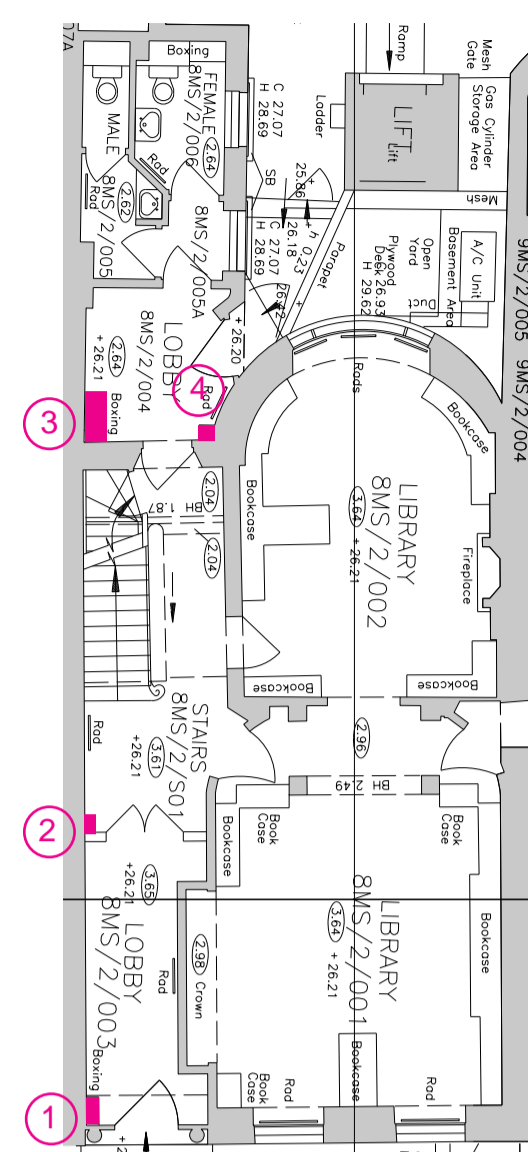

8MS Ground Floor

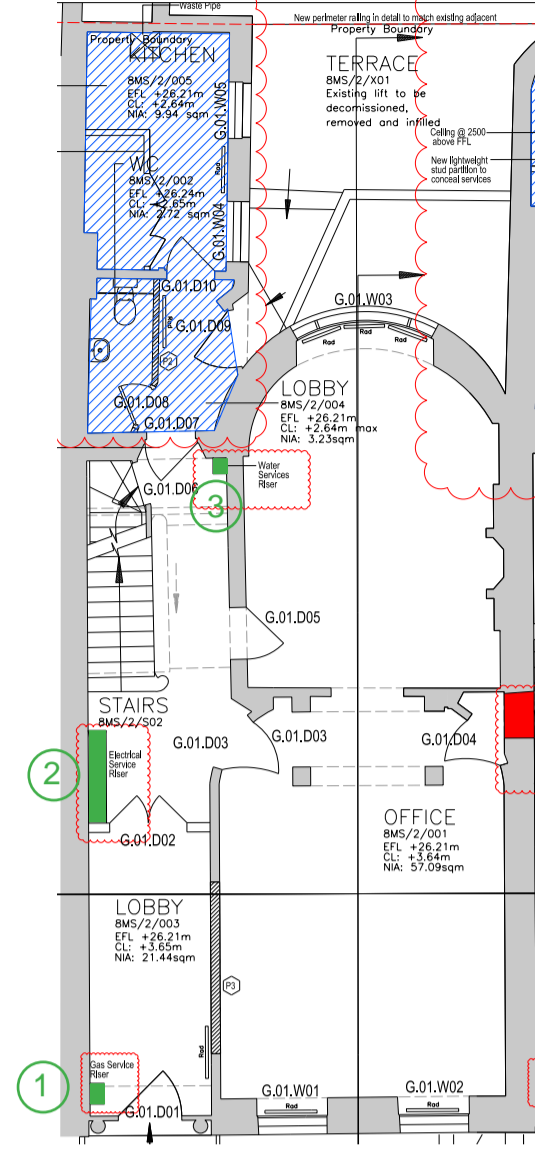

8MS Ground Floor
(Typical strategy)

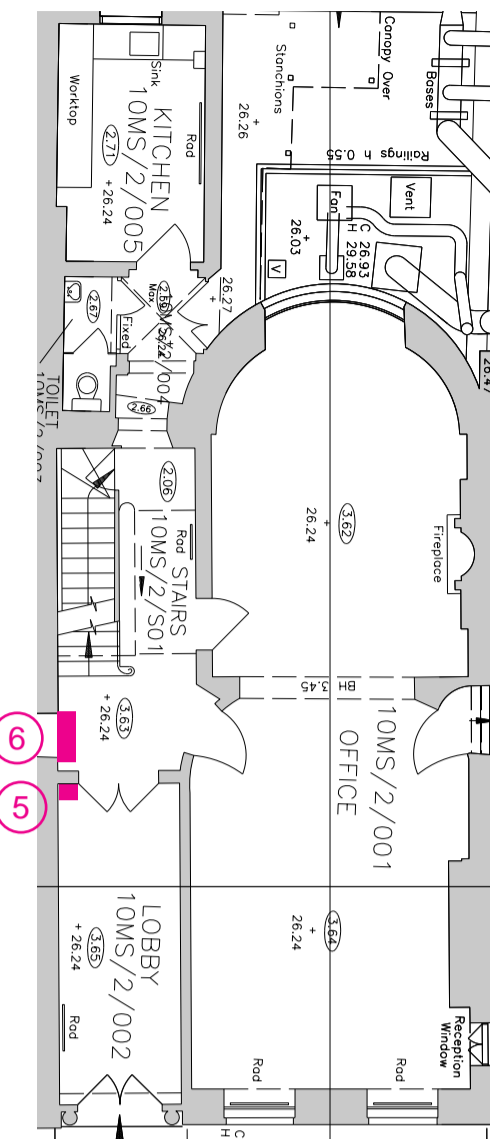

10MS Ground Floor



1 8MS/2/003 - Lobby



2 8MS/2/S01 - Lobby



3 8MS/2/004 - Lobby
(Riser carefully removed)



4 8MS/2/004 - Lobby
(Riser carefully removed)




5 10MS/2/002 - Lobby




6 10MS/2/S01 - Hallway



1 8MS/2/003 - Lobby

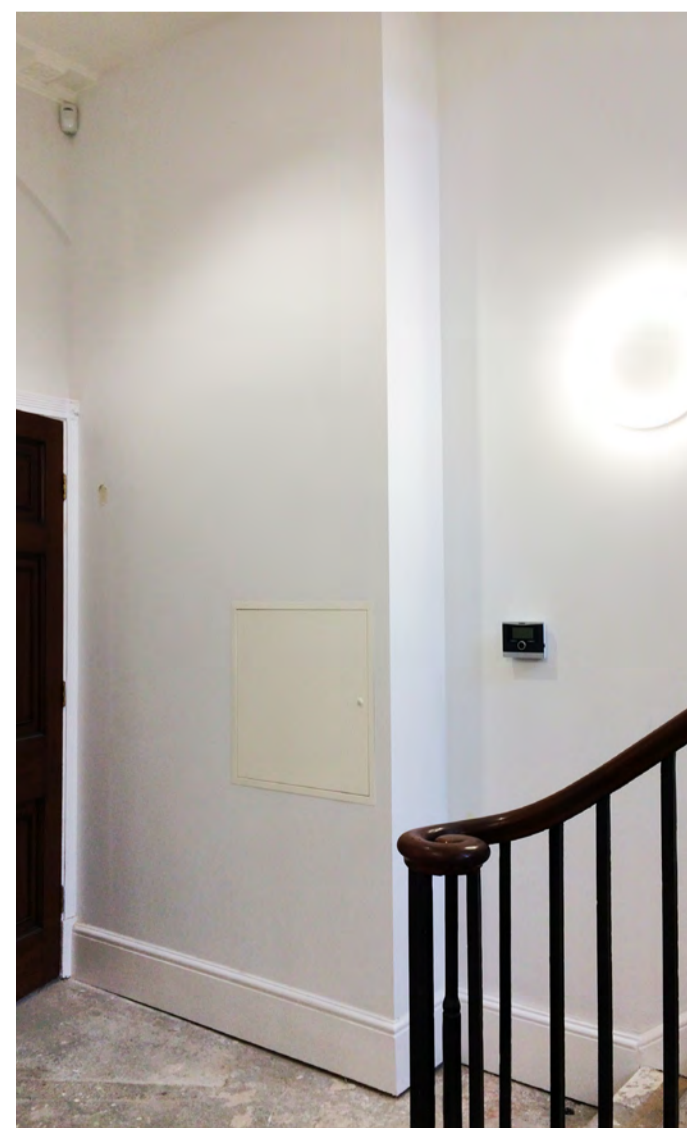

2 8MS/2/S01 - Lobby

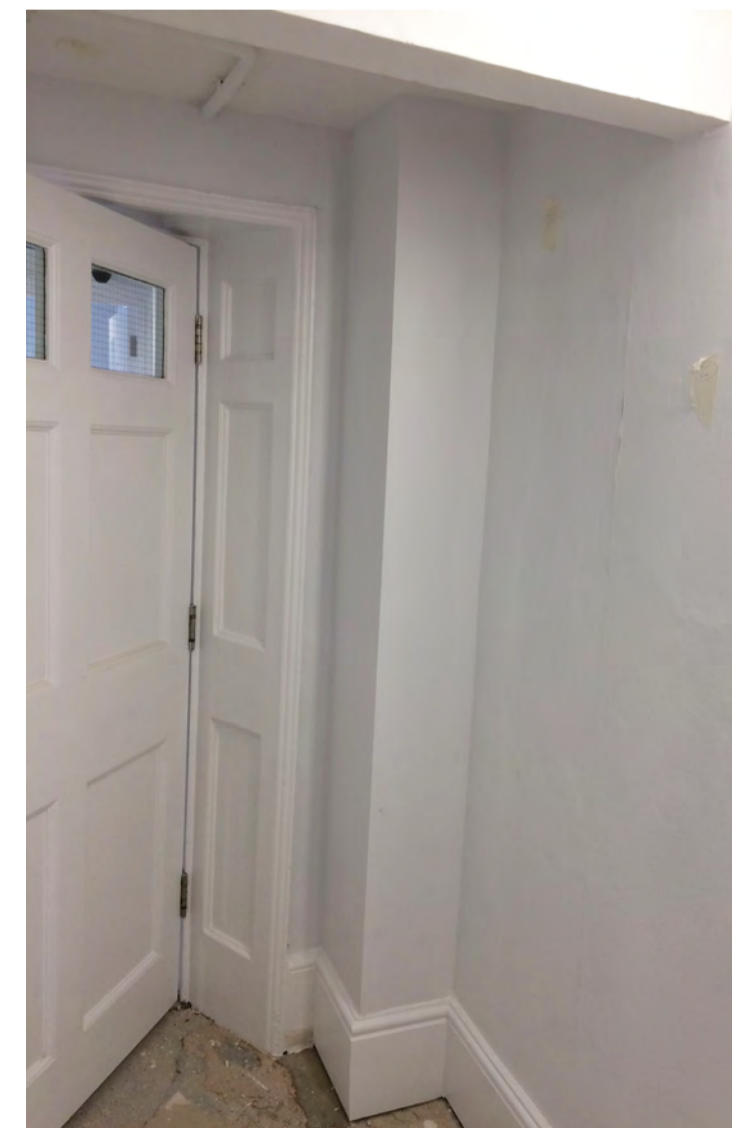

3 8MS/2/S01 - Lobby



3 10MS/2/S01 - Hallway
(Services consolidated into single concealed riser location)


BUILDING DESIGN PARTNERSHIP LTD SHALL HAVE NO RESPONSIBILITY FOR ANY USE OF THIS DOCUMENT OTHER THAN THAT WHICH IT WAS PREPARED AND ISSUED.
ALL DIMENSIONS SHOULD BE CHECKED ON SITE.
DO NOT SCALE FROM THIS DRAWING.
ANY DRAWING ERRORS OR DIVERGENCES SHOULD BE BROUGHT TO THE ATTENTION OF BUILDING DESIGN PARTNERSHIP LTD AT THE ADDRESS SHOWN BELOW.

NOTES

EXISTING BUILDING SURVEY INFORMATION BY PLOWMAN CRAVEN, TO BE READ IN CONJUNCTION WITH ALL RELEVANT PROJECT INFORMATION.

REFER TO SERVICES ENGINEERS DRAWINGS FOR DETAILS OF PROPOSED PLANT INC, RISERS, DUCTS, FLUES, EXTRACT GRILLES, LOUVRES, ETC, AND ASSOCIATED BUILDERS WORK.

KEY:

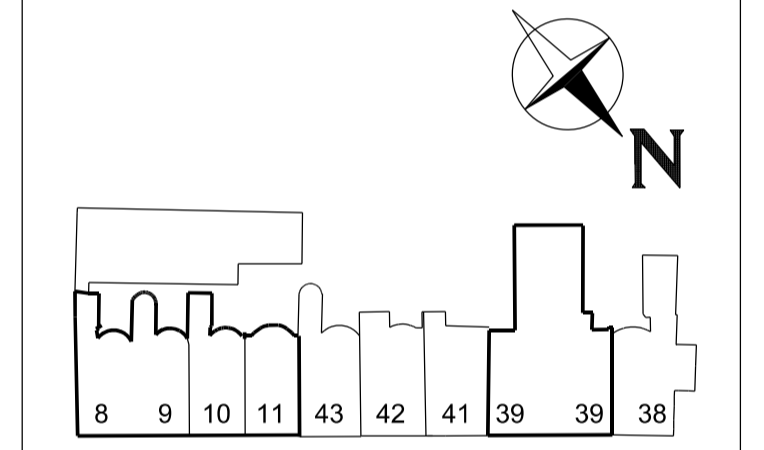

REVISION	DESCRIPTION	DRAWN	CHECKED	DATE



16 Brewhouse Yard
Clerkenwell
London EC1V 4LJ
United Kingdom
T +44 (0)20 7812 8000
F +44 (0)20 7812 8399
www.bdp.com

PROJECT TITLE
British Museum
Perimeter Properties Refurbishment


PROJECT NUMBER
P2002323

DRAWING TITLE 8-11 Montague Street Existing / As installed Typical Riser Locations Ground Floor Level	SCALE
DATE 03/11/2016	REVISION

DRAWING NO.
161031_BDPK001

8-11MS FIRST FLOOR - RISER LOCATIONS PRE APPLICATION 2015/3203/P & 2015/4344/L

8-11MS FIRST FLOOR - AS INSTALLED RISER LOCATIONS

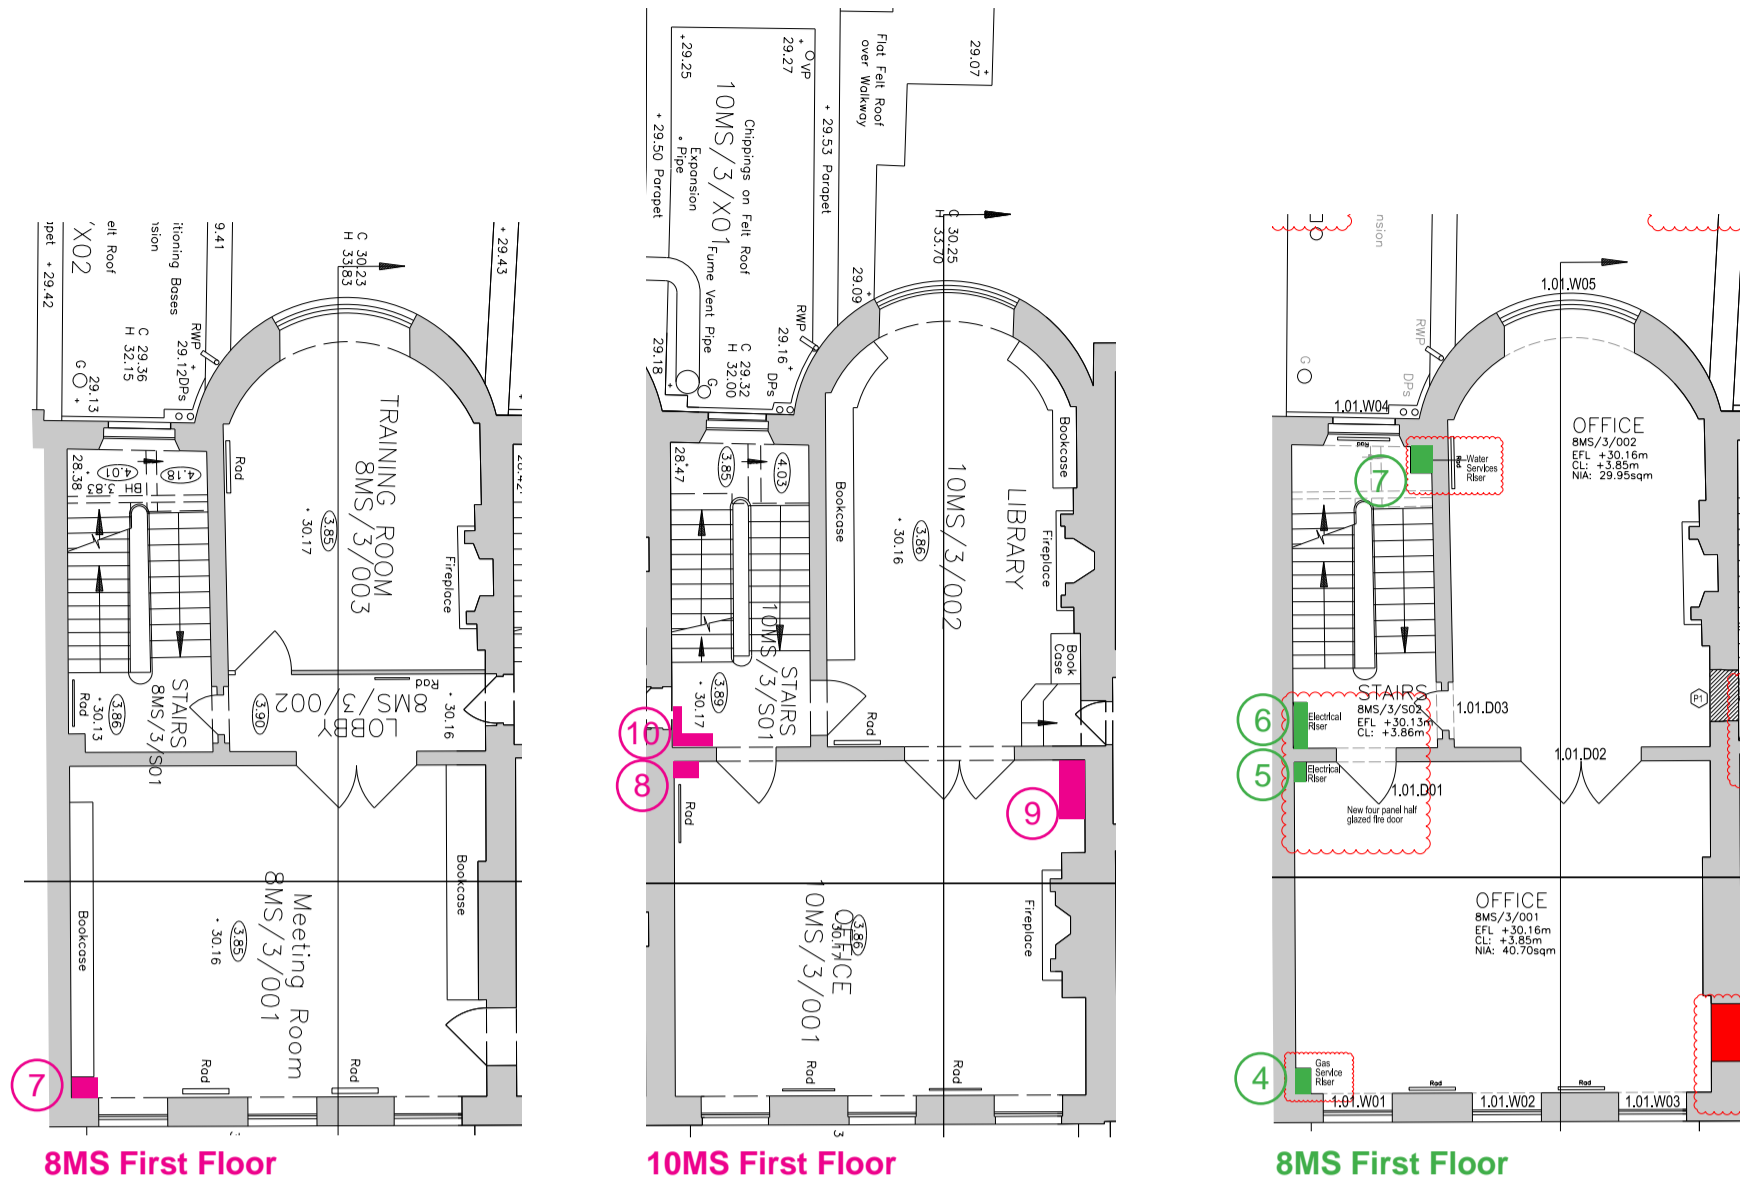

8MS First Floor

10MS First Floor

8MS First Floor



8MS/3/001 - Office



10MS/3/001 - Office



10MS/3/001 - Office
(Riser carefully removed)



10MS/3/S01 - Stair



8MS/3/001 - Office



8MS/3/001 - Office



8MS/3/S02 - Stair



8MS/3/S02 - Stair


BUILDING DESIGN PARTNERSHIP LTD SHALL HAVE NO RESPONSIBILITY FOR ANY USE MADE OF THIS DOCUMENT OTHER THAN FOR THAT WHICH IT WAS PREPARED AND ISSUED.
ALL DIMENSIONS SHOULD BE CHECKED ON SITE.
DO NOT SCALE FROM THIS DRAWING.
ANY DRAWING ERRORS OR DIVERGENCES SHOULD BE BROUGHT TO THE ATTENTION OF BUILDING DESIGN PARTNERSHIP LTD AT THE ADDRESS SHOWN BELOW.

NOTES

EXISTING BUILDING SURVEY INFORMATION BY PLOWMAN CRAVEN, TO BE READ IN CONJUNCTION WITH ALL RELEVANT PROJECT INFORMATION.

REFER TO SERVICES ENGINEERS DRAWINGS FOR DETAILS OF PROPOSED PLANT INC, RISERS, DUCTS, FLUES, EXTRACT GRILLES, LOUVRES, ETC. AND ASSOCIATED BUILDERS WORK.

KEY:

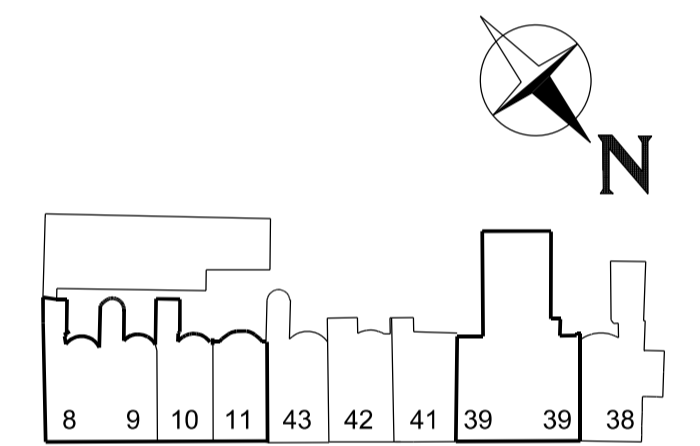

REVISION	DESCRIPTION	DRAWN	CHECKED	DATE



BDP.

16 Brewhouse Yard
Clerkenwell
London EC1V 4LJ
United Kingdom
T +44 (0)20 7812 8000
F +44 (0)20 7812 8399
www.bdp.com

PROJECT TITLE
British Museum
Perimeter Properties Refurbishment


PROJECT NUMBER
P2002323

DRAWING TITLE	SCALE	DATE
8-11 Montague Street Existing / As installed Typical Riser Locations First Floor Level		03/11/2016

DRAWING NO.	REVISION
161031_BDPSK002	

8-11MS SECOND FLOOR - RISER LOCATIONS PRE APPLICATIONS 2015/3203/P & 2015/4344/L

8-11MS SECOND FLOOR - AS INSTALLED RISER LOCATIONS

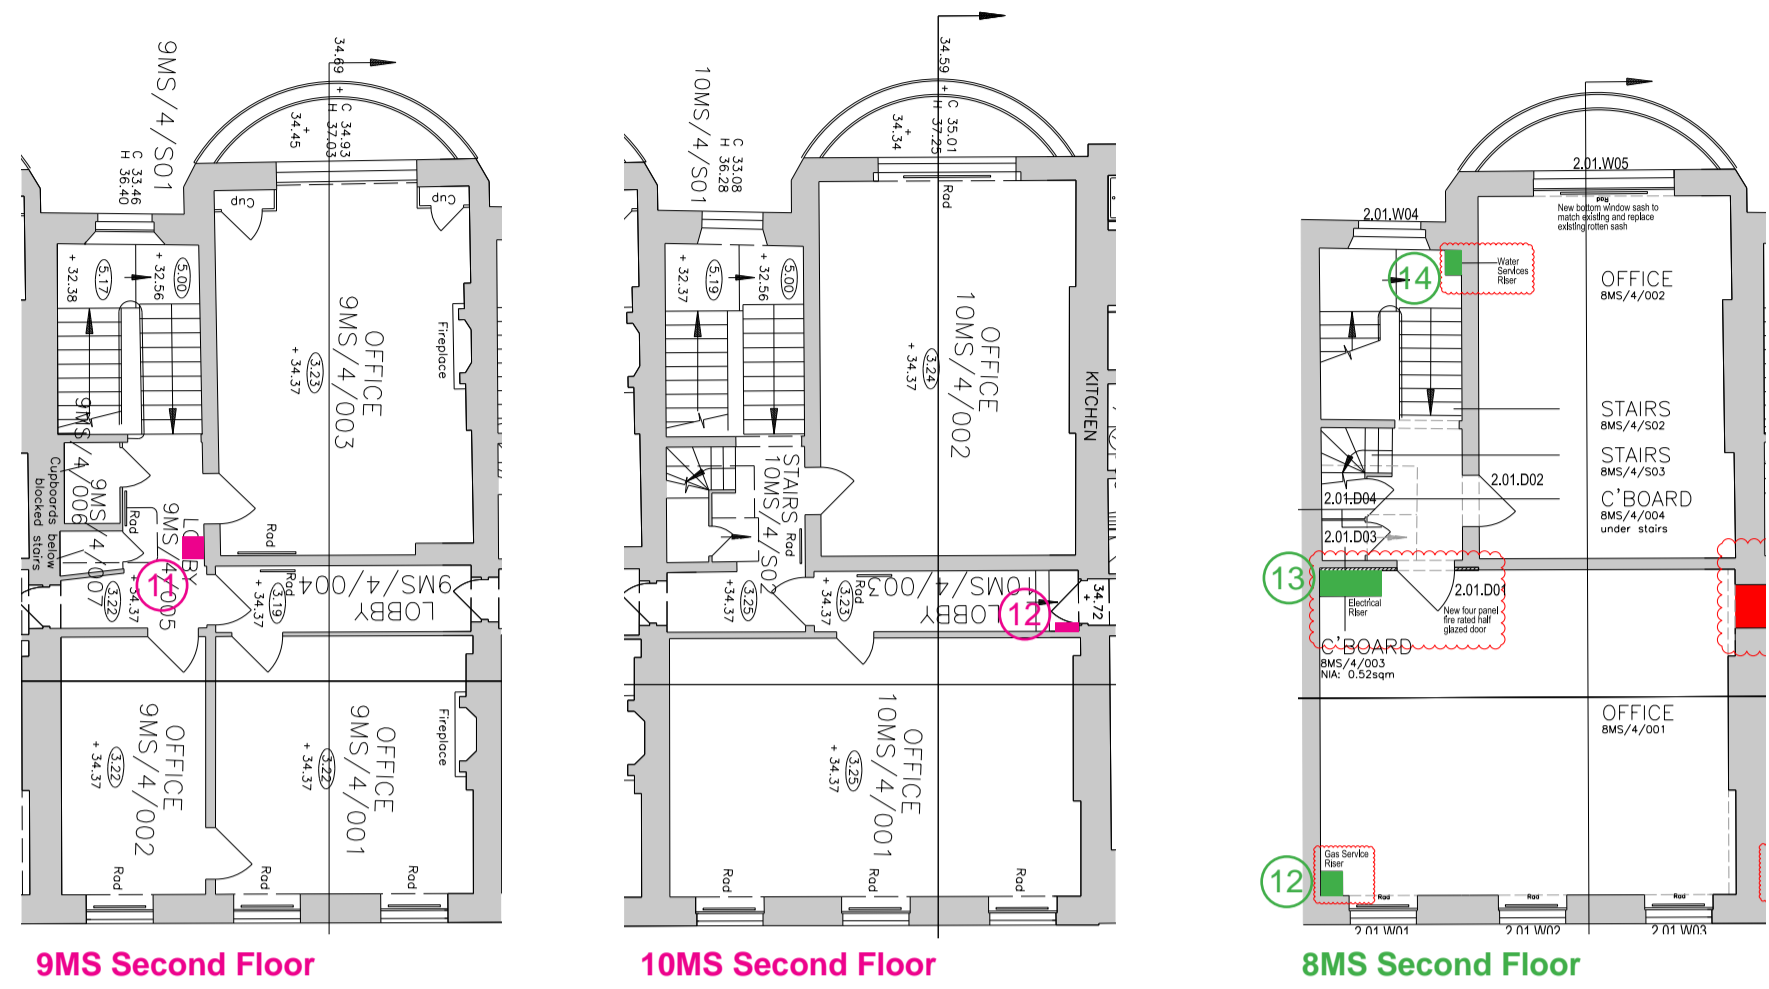


9MS Second Floor

10MS Second Floor

8MS Second Floor

8-11MS THIRD FLOOR - RISER LOCATIONS PRE APPLICATION 2015/3202/P & 2015/4344/L

8-11MS THIRD FLOOR - AS INSTALLED RISER LOCATIONS

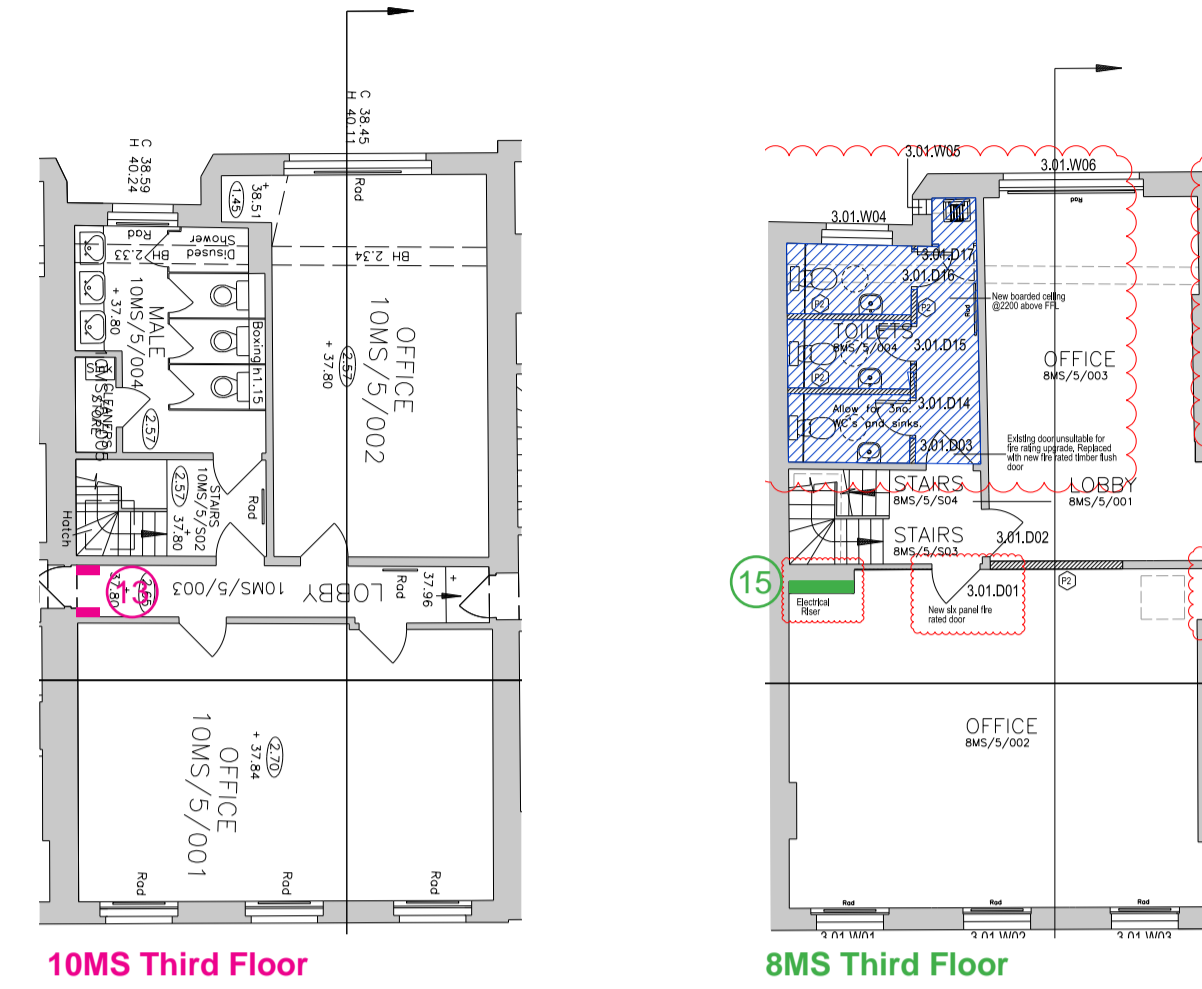

10MS Third Floor

8MS Third Floor



11 9MS/4/005 - Lobby



12 10MS/4/003 - Lobby



13 10MS/4/003 - Lobby



13 10MS/5/003 - Lobby



12 8MS/4/001 - Office



13 8MS/4/001 - Office



14 8MS/4/S02 - Lobby



15 8MS/5/002 - Office


BUILDING DESIGN PARTNERSHIP LTD SHALL HAVE NO RESPONSIBILITY FOR ANY USE MADE OF THIS DOCUMENT OTHER THAN FOR THAT WHICH IT WAS PREPARED AND ISSUED.
ALL DIMENSIONS SHOULD BE CHECKED ON SITE.
DO NOT SCALE FROM THIS DRAWING.
ANY DRAWING ERRORS OR DIVERGENCES SHOULD BE BROUGHT TO THE ATTENTION OF BUILDING DESIGN PARTNERSHIP LTD AT THE ADDRESS SHOWN BELOW.

NOTES

EXISTING BUILDING SURVEY INFORMATION BY PLOWMAN CRAVEN, TO BE READ IN CONJUNCTION WITH ALL RELEVANT PROJECT INFORMATION.

REFER TO SERVICES ENGINEERS DRAWINGS FOR DETAILS OF PROPOSED PLANT INC, RISERS, DUCTS, FLUES, EXTRACT GRILLES, LOUVRES, ETC, AND ASSOCIATED BUILDERS WORK.

KEY:

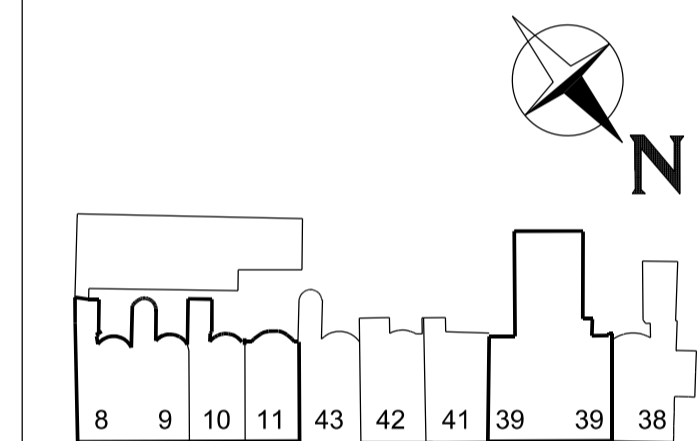

REVISION / DESCRIPTION DRAWN CHECKED DATE

CLIENT LOGO



16 Brewhouse Yard
Clerkenwell
London EC1V 4LJ
United Kingdom
T +44 (0)20 7812 8000
F +44 (0)20 7812 8399
www.bdp.com

PROJECT TITLE
British Museum
Perimeter Properties Refurbishment

PROJECT NUMBER
P2002323

DRAWING TITLE
8-11 Montague Street
Existing / As installed Typical Riser Locations
Second / Third Floor Level

DATE
03/11/2016

REVISION

161031_BDPSK003