


39RS SECOND FLOOR - TYPICAL ARRANGEMENT PRE APPLICATIONS 2015/3203/P & 2015/4344/L

39RS TYPICAL FLOOR - AS INSTALLED RISER LOCATIONS

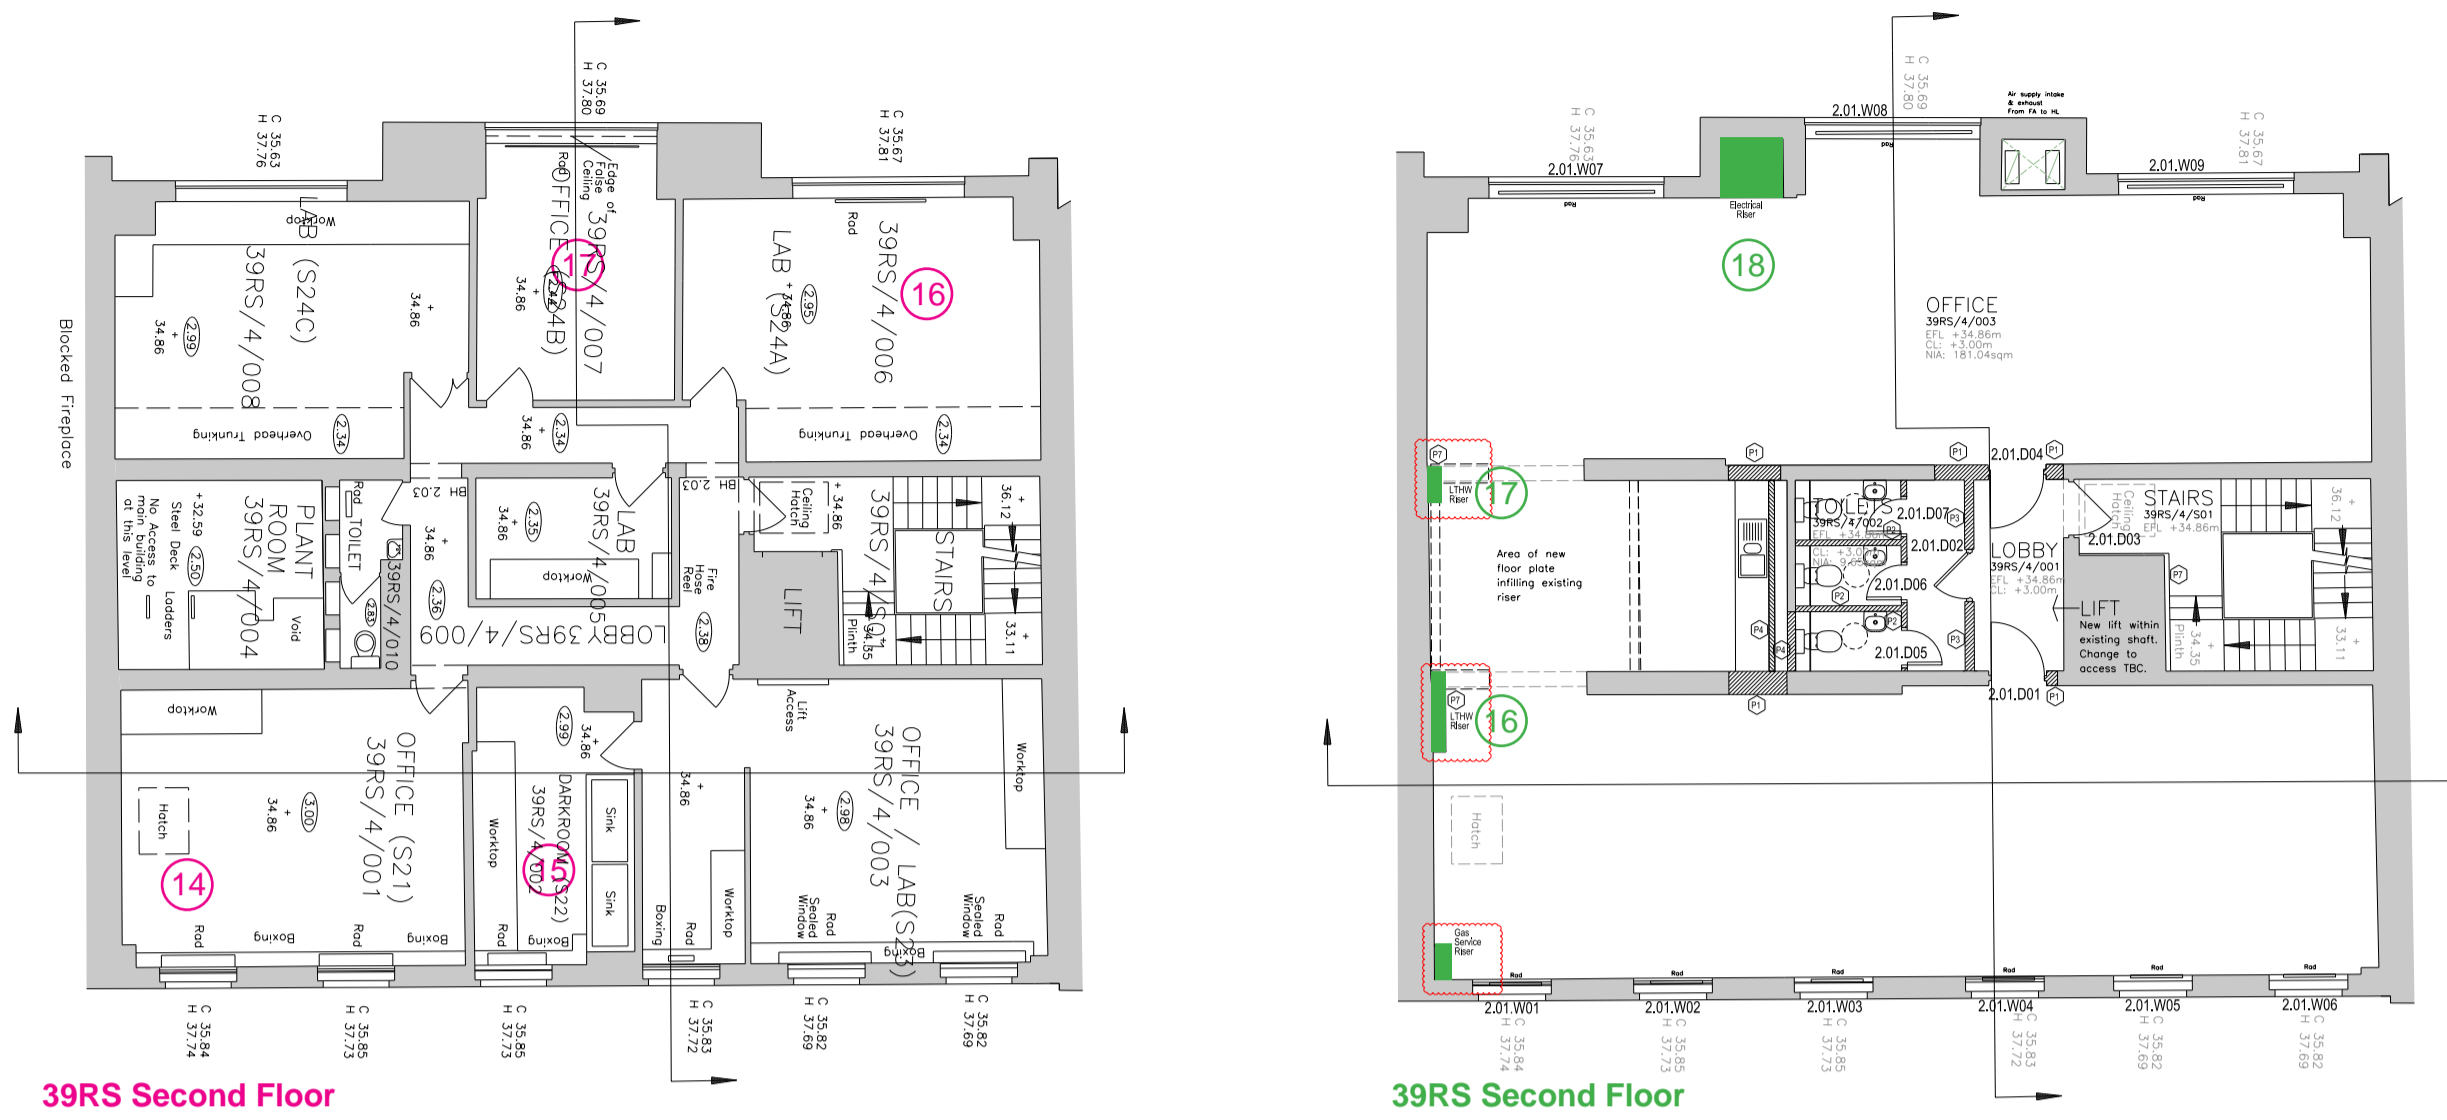

39RS Second Floor

39RS Second Floor



14 39RS/4/001 - Office



15 39RS/4/002 - Dark Room



16 39RS/4/006 - Laboratory



17 39RS/4/007 - Office



16 39RS/4/003 - Office



17 39RS/4/003 - Office



18 39RS/4/003 - Office

- Strategy for low level perimeter trunking and radiator arrangement as present in the existing condition has been replicated albeit with new fittings and updated services
- Laboratory services and wall level surface mounted fittings carefully removed
- New service risers concealed behind consolidated risers arranged around the perimeter of the property


BUILDING DESIGN PARTNERSHIP LTD SHALL HAVE NO RESPONSIBILITY FOR ANY USE MADE OF THIS DOCUMENT OTHER THAN FOR THAT WHICH IT WAS PREPARED AND ISSUED.  
ALL DIMENSIONS SHOULD BE CHECKED ON SITE.  
DO NOT SCALE FROM THIS DRAWING.  
ANY DRAWING ERRORS OR DIVERGENCES SHOULD BE BROUGHT TO THE ATTENTION OF BUILDING DESIGN PARTNERSHIP LTD AT THE ADDRESS SHOWN BELOW.

NOTES

EXISTING BUILDING SURVEY INFORMATION BY PLOWMAN CRAVEN, TO BE READ IN CONJUNCTION WITH ALL RELEVANT PROJECT INFORMATION.

REFER TO SERVICES ENGINEERS DRAWINGS FOR DETAILS OF PROPOSED PLANT INC, RISERS, DUCTS, FLUES, EXTRACT GRILLES, LOUVRES, ETC. AND ASSOCIATED BUILDERS WORK.

KEY:

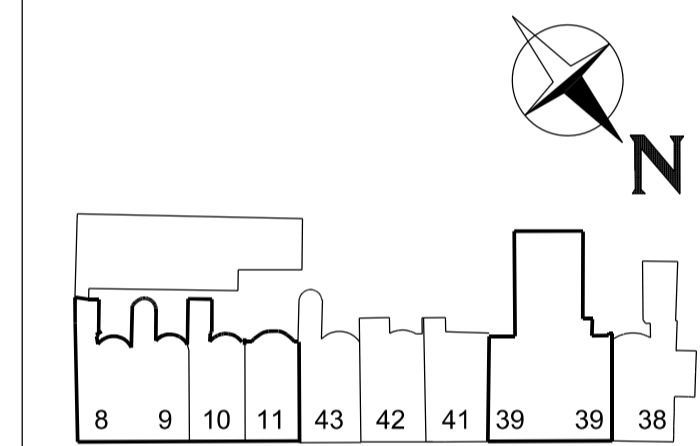

REVISION	DESCRIPTION	DRAWN	CHECKED	DATE

CLIENT LOGO



**BDP.**

16 Brewhouse Yard  
Clerkenwell  
London EC1V 4LJ  
United Kingdom  
T +44 (0)20 7812 8000  
F +44 (0)20 7812 8399  
www.bdp.com

PROJECT TITLE  
British Museum  
Perimeter Properties Refurbishment

PROJECT NUMBER  
P2002323

DRAWING TITLE	SCALE	DATE
39 Russell Square Existing / As installed typical Riser Locations Typical Floor Level		03/11/2016

DRAWING NO.  
161031\_BDPSK004

REVISION

11MS\_Dado Trunking pre applications 2015/3203/P & 2015/4344/L



11MS/5/002 - Office



11MS/5/003 - Office

10MS\_Dado Trunking pre applications 2015/3202/P & 2015/4344/L



10MS/5/002 - Office



11MS/4/003 - Office



11MS/3/001 - Office




10MS/4/002 - Office



10MS/3/001 - Office



11MS/5/002 - Office

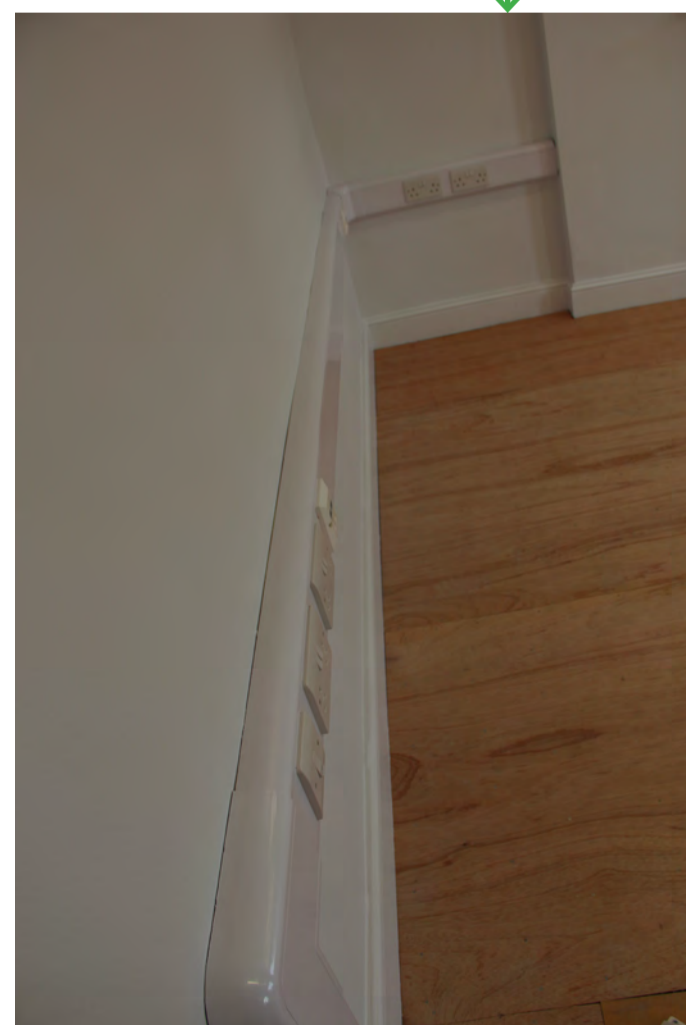

11MS/3/001 - Office



11MS/4/002 - Office



11MS/3/001 - Office

BUILDING DESIGN PARTNERSHIP LTD SHALL HAVE NO RESPONSIBILITY FOR ANY USE OF THIS DOCUMENT OTHER THAN THAT FOR WHICH IT WAS PREPARED AND ISSUED.  
 ALL DIMENSIONS SHOULD BE CHECKED ON SITE.  
 DO NOT SCALE FROM THIS DRAWING.  
 ANY DRAWING ERRORS OR DIVERGENCES SHOULD BE BROUGHT TO THE ATTENTION OF BUILDING DESIGN PARTNERSHIP LTD AT THE ADDRESS SHOWN BELOW.

**NOTES**

EXISTING BUILDING SURVEY INFORMATION BY PLOWMAN CRAVEN, TO BE READ IN CONJUNCTION WITH ALL RELEVANT PROJECT INFORMATION.

REFER TO SERVICES ENGINEERS DRAWINGS FOR DETAILS OF PROPOSED PLANT INC. RISERS, DUCTS, FLUES, EXTRACT GRILLES, LOUVRES, ETC. AND ASSOCIATED BUILDERS WORK.

KEY:

REVISION	DESCRIPTION	DRAWN	CHECKED	DATE



**BDP.**

16 Brewhouse Yard  
 Clerkenwell  
 London EC1V 4LJ  
 United Kingdom  
 T +44 (0)20 7812 8000  
 F +44 (0)20 7812 8399  
 www.bdp.com

PROJECT TITLE British Museum Perimeter Properties Refurbishment	
PROJECT NUMBER P2002323	
DRAWING TITLE 8-11 Montague Street Existing / As installed Electrical Distribution	SCALE
DRAWING NO. 161031_BDPSK005	DATE 03/11/2016
	REVISION

BUILDING DESIGN PARTNERSHIP LTD SHALL HAVE NO RESPONSIBILITY FOR ANY USE OF THIS DOCUMENT OTHER THAN THAT FOR WHICH IT WAS PREPARED AND ISSUED.  
 ALL DIMENSIONS SHOULD BE CHECKED ON SITE.  
 DO NOT SCALE FROM THIS DRAWING.  
 ANY DRAWING ERRORS OR DIVERGENCES SHOULD BE BROUGHT TO THE ATTENTION OF BUILDING DESIGN PARTNERSHIP LTD AT THE ADDRESS SHOWN BELOW.

**NOTES**

EXISTING BUILDING SURVEY INFORMATION BY PLOWMAN CRAVEN, TO BE READ IN CONJUNCTION WITH ALL RELEVANT PROJECT INFORMATION.  
 REFER TO SERVICES ENGINEERS DRAWINGS FOR DETAILS OF PROPOSED PLANT INC, RISERS, DUCTS, FLUES, EXTRACT GRILLES, LOUVRES, ETC. AND ASSOCIATED BUILDERS WORK.  
 KEY:


Typical Basement Services pre applications 2015/3203/P & 2015/4344/L



Typical Basement services as constructed



- Large surface mounted services and ducts associated with laboratory functions carefully removed.  
 -New services are minor in relation, electrical services are consolidated in perimeter dado trunking.

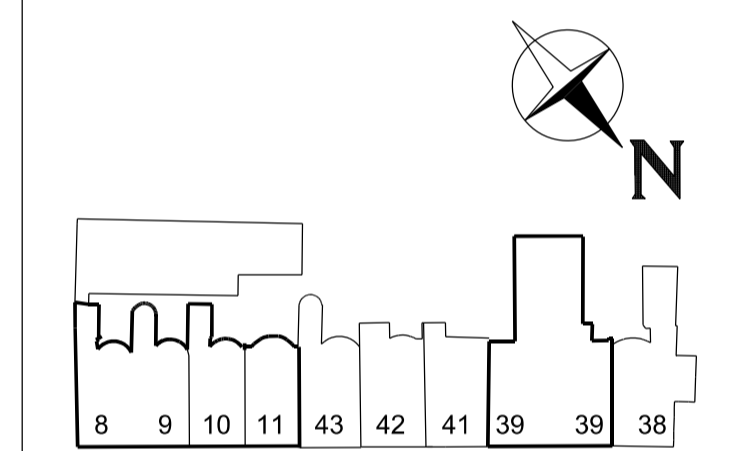

REVISION DESCRIPTION	DRAWN	CHECKED	DATE



**BDP.**

16 Brewhouse Yard  
 Clerkenwell  
 London EC1V 4LJ  
 United Kingdom  
 T +44 (0)20 7812 8000  
 F +44 (0)20 7812 8399  
 www.bdp.com

PROJECT TITLE British Museum Perimeter Properties Refurbishment	
PROJECT NUMBER P2002323	
DRAWING TITLE 11 Montague Street Existing / As installed Basement services	SCALE
DRAWING No. 161031_BDPSK006	DATE 03/11/2016
	REVISION

Typical External Services pre applications 2015/3203/P & 2015/4344/L



Typical rear elevation / lightwell as constructed

- Bulky services and redundant flues have been carefully removed enabling reinstatement of rear lightwell volumes and cleaner elevations.
- New services are minor in relation and situated behind parapet walls or on perimeter walls away from the main rear elevation.




BUILDING DESIGN PARTNERSHIP LTD SHALL HAVE NO RESPONSIBILITY FOR ANY USE MADE OF THIS DOCUMENT OTHER THAN FOR THAT WHICH IT WAS PREPARED AND ISSUED.  
ALL DIMENSIONS SHOULD BE CHECKED ON SITE.  
DO NOT SCALE FROM THIS DRAWING.  
ANY DRAWING ERRORS OR DIVERGENCES SHOULD BE BROUGHT TO THE ATTENTION OF BUILDING DESIGN PARTNERSHIP LTD AT THE ADDRESS SHOWN BELOW.

**NOTES**

EXISTING BUILDING SURVEY INFORMATION BY PLOWMAN CRAVEN, TO BE READ IN CONJUNCTION WITH ALL RELEVANT PROJECT INFORMATION.

REFER TO SERVICES ENGINEERS DRAWINGS FOR DETAILS OF PROPOSED PLANT INC, RISERS, DUCTS, FLUES, EXTRACT GRILLES, LOUVRES, ETC. AND ASSOCIATED BUILDERS WORK.

KEY:

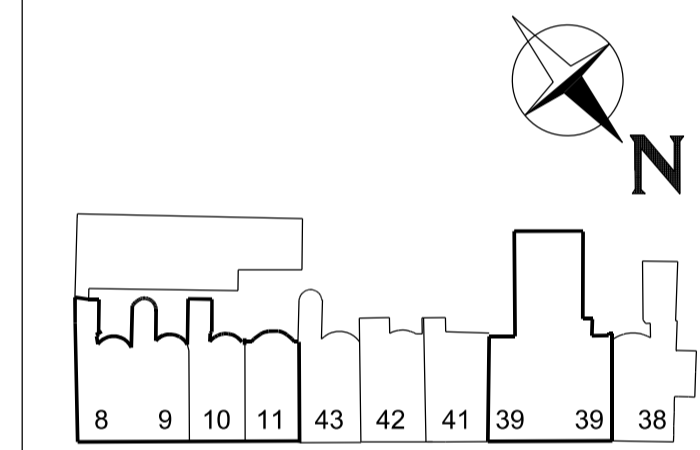

REVISION / DESCRIPTION	DRAWN	CHECKED	DATE

CLIENT LOGO



**BDP.**

16 Brewhouse Yard  
Clerkenwell  
London EC1V 4LJ  
United Kingdom  
T +44 (0)20 7812 8000  
F +44 (0)20 7812 8399  
www.bdp.com

PROJECT TITLE  
British Museum  
Perimeter Properties Refurbishment

PROJECT NUMBER  
P2002323

DRAWING TITLE  
8-11 Montague Street  
Typical rear elevation / lightwells

SCALE  
DATE  
03/11/2016

DRAWING NO.  
161031\_BDPSK007

REVISION