

EXISTING CHIMNEY'S AND PARTY WALL TO BE EXTENDED


This drawing is partly based on information supplied by third parties and as such no guarantee can be made as to its accuracy. The features illustrated are therefore approximate and must be subject to a detailed topographic and/or measured building survey, statutory services enquiries and confirmation of legal boundaries.

Do not scale from this drawing: use figured dimensions only taken from elements as prescribed on the drawing. Figured dimensions when taken from existing elements are from the finished surface. Discrepancies must be reported prior to commencement of any work or fabrication of elements. If in doubt, refer to the contract administrator.

License is hereby granted for the intended user to employ the information contained within this drawing for purposes connected with the related project only. Copyright of this drawing remains solely the property of CeeToo Architects Limited unless otherwise assigned in writing. Breach of the terms of this licence results in the immediate termination of the licence, the medium and any resulting copies must be returned to CeeToo immediately.



ELEVATION TO KENTISH TOWN ROAD: AS PROPOSED

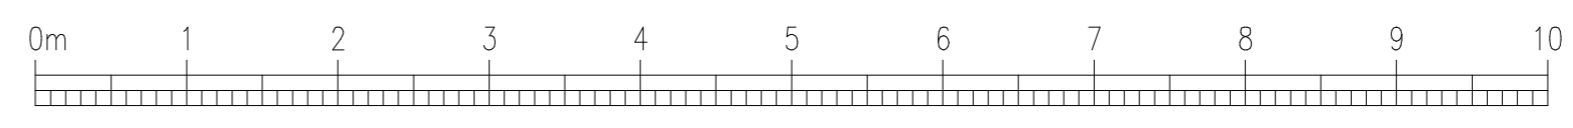

B REDRAWN TO ALIGN WITH DRAWING No. C2.1242.GAD.012_Rev. 0 INCLUDING MODIFICATIONS (SHOWN CLOUDED) TO ELEVATION AS REQUESTED BY PLANNING AUTHORITY & REDRAWN; WINDOWS AMENDED 03.03.17 03.08.16	
Project: 1242 180 Kentish Town Road London NW5 2AE	
Client: Quadrant Design & Construction Ltd	
CONVERSION TO RESIDENTIAL Development of 180 Kentish Town Road for Proposed General Arrangement	
Drawing Status: AS CONSTRUCTED AND TO BE CONSTRUCTED	Date: 13.03.16
Drawing Scale: 1:50 (at A2) (1:100 at A4)	Revision: B
C2.1242.GAD.01	

