

PROPOSED RAILING DETAIL SCALE 1:25

# FRONT ELEVATION

**Revision notes:**

Rev:	Date:	Notes:
A	20.01.2017	ANNOTATION CHANGES (SHOPFRONT / FRONT ELEVATION NOT PART OF APPLICATION)
B	06.03.2017	METAL GRILLE COVER REPLACED WITH DOMED SKYLIGHTS

**Drawn by:**  
GC

**Project:**  
Flat 1, 245 Royal College Street, London NW1 9LT  
Full Planning Application Ref: PP-05241164

**Date:**  
21 June 2016

**Client:**  
Ganeshwaran Velautham  
40 Copse Wood Way, London HA6 2UA


**Drawing Title:**  
Existing and Proposed Front Elevation  
DWG-05

**Scale @ A3:**  
1:100 or as indicated


**Revision:**  
B

**BONNYSTREET PLANNING LIMITED**

WWW.TOWNPLANNING.LONDON

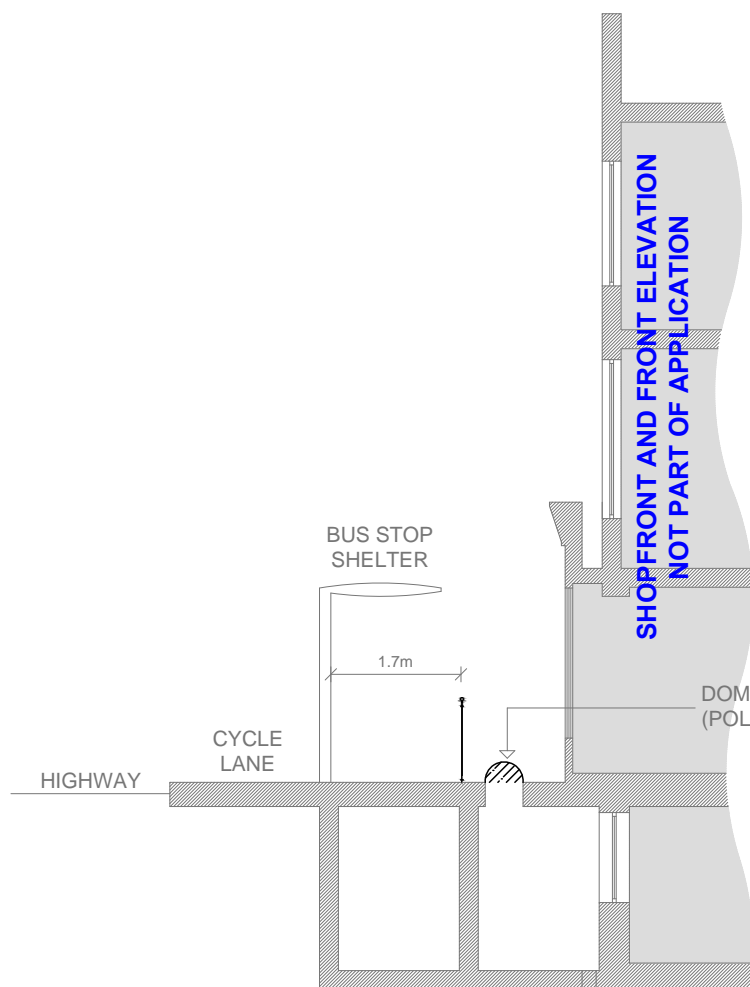


PREVIOUSLY APPROVED  
LIGHTWELL CONFIGURATION

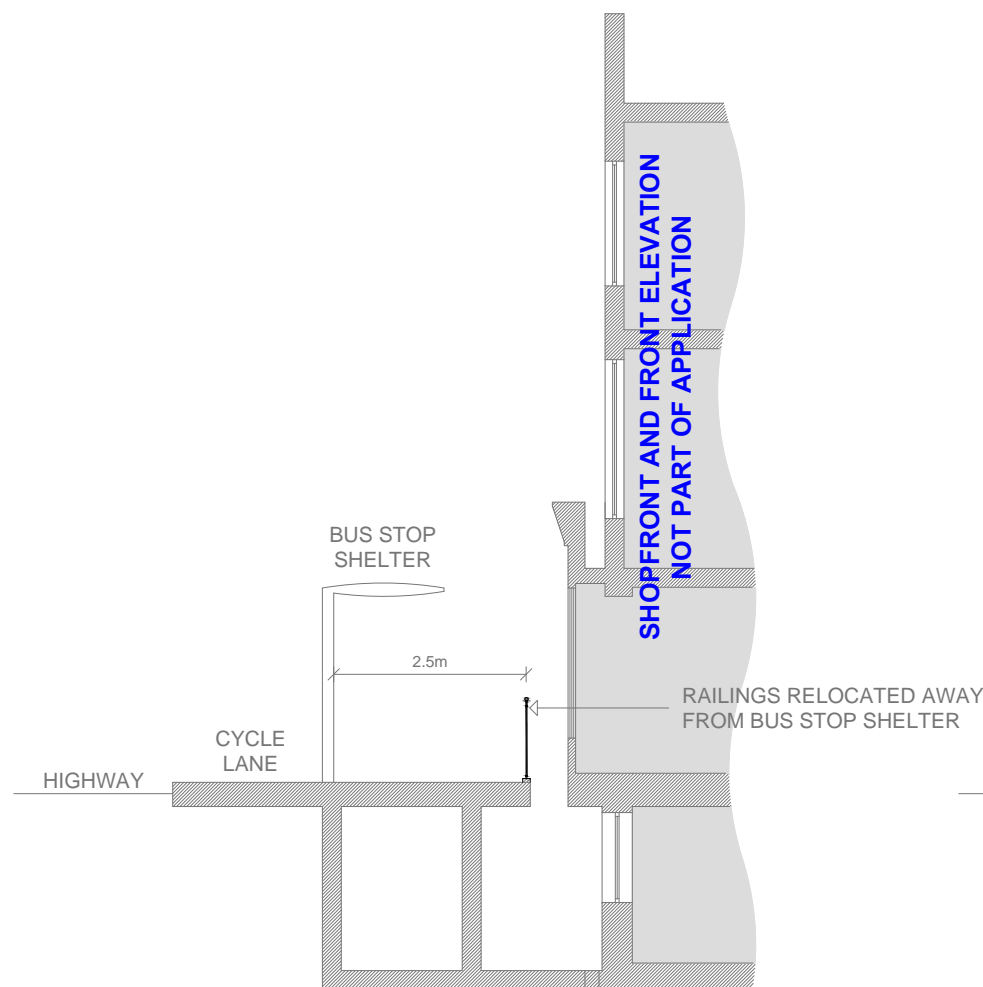

EXISTING (AS BUILT)  
LIGHTWELL CONFIGURATION

OPEN, UNCOVERED LIGHTWELL IS UNAUTHORIZED

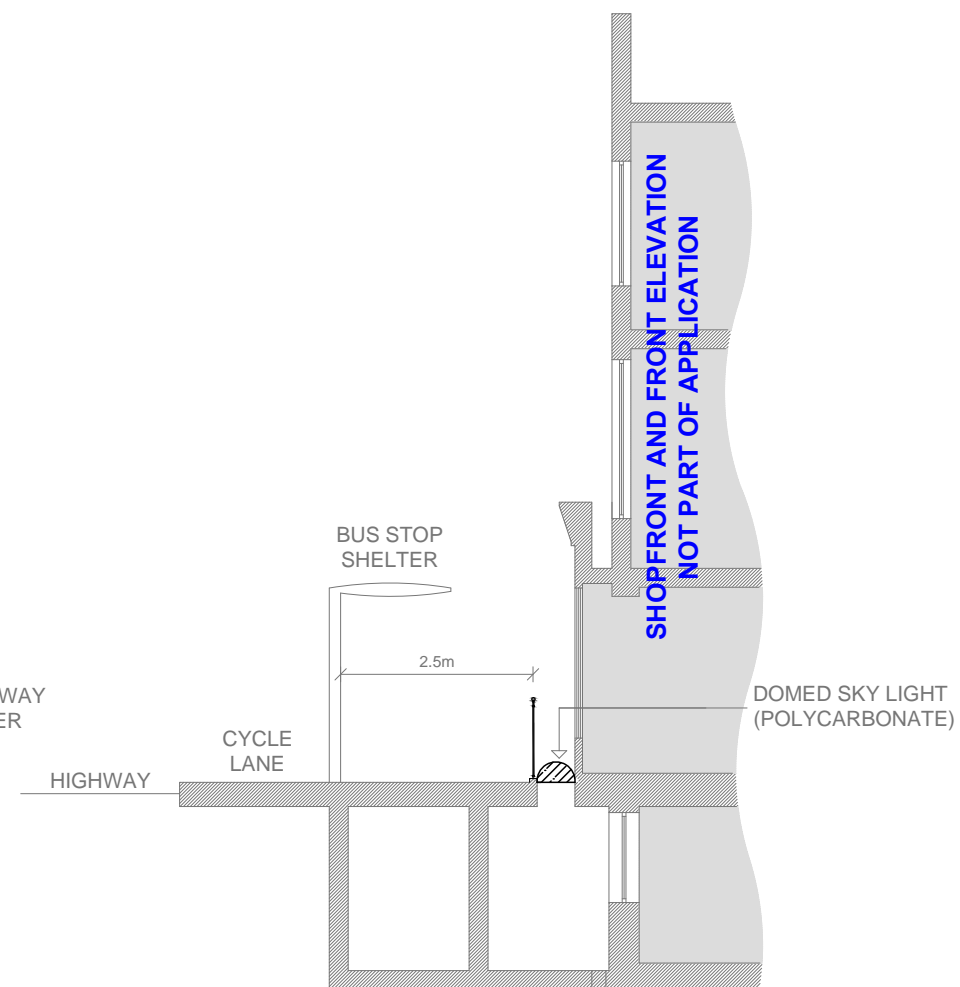

PROPOSED  
LIGHTWELL CONFIGURATION

## SECTION

### Revision notes:

Rev:	Date:	Notes:
A	20.01.2017	ANNOTATION CHANGES (SHOPFRONT / FRONT ELEVATION NOT PART OF APPLICATION)
B	06.03.2017	METAL GRILLE COVER REPLACED WITH DOMED SKYLIGHTS

**Drawn by:**  
GC

**Project:**  
Flat 1, 245 Royal College Street, London NW1 9LT  
Full Planning Application Ref: PP-05241164

**Date:**  
21 June 2016

**Scale @ A3:**  
1:100

**Client:**  
Ganeshwaran Velautham  
40 Copse Wood Way, London HA6 2UA


**Drawing Title:**  
Existing and Proposed Section  
DWG-01

**Revision:**  
B


BONNYSTREET PLANNING LIMITED

WWW.TOWNPLANNING.LONDON


0m 1m 2m 3m 4m 5m

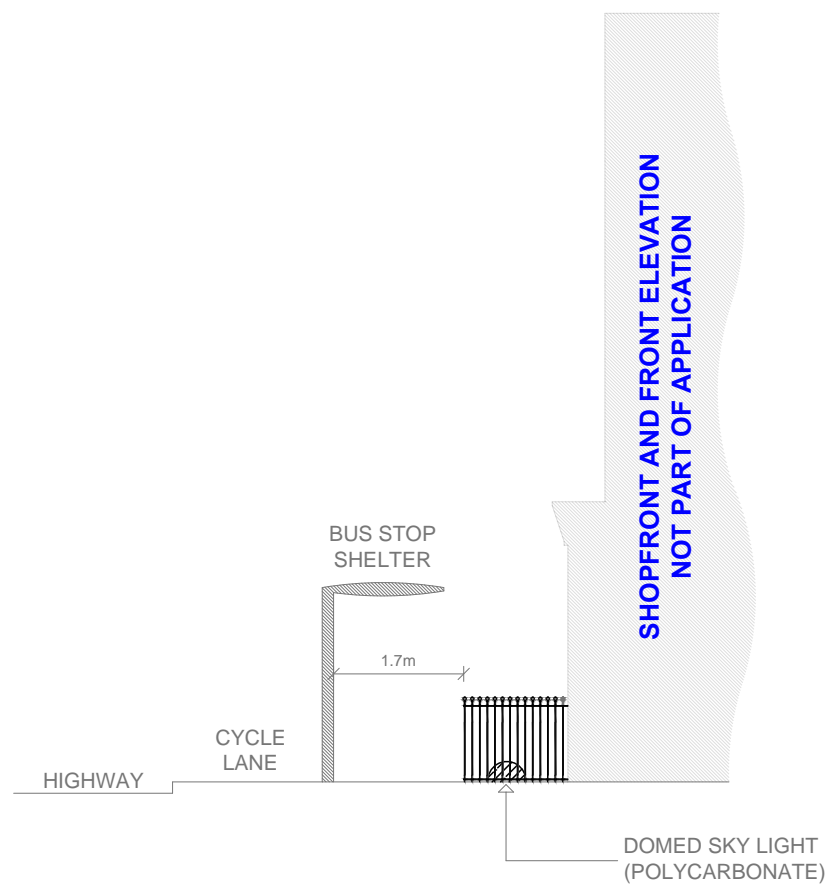

PREVIOUSLY APPROVED LIGHTWELL CONFIGURATION

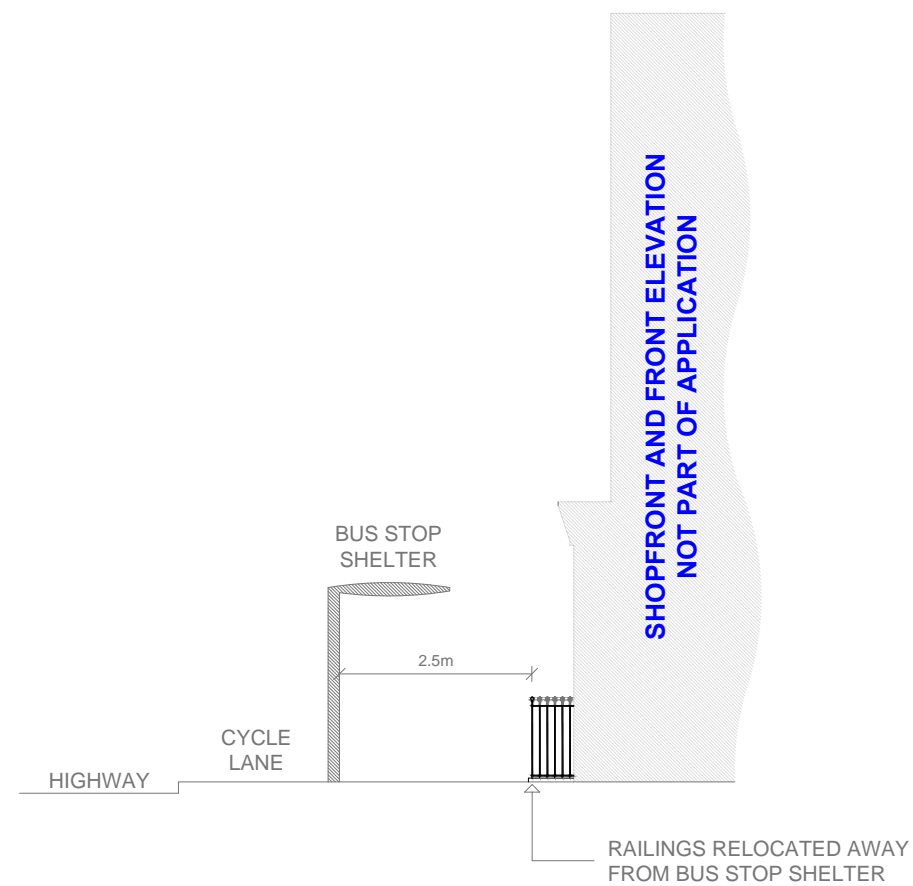

EXISTING (AS BUILT) LIGHTWELL CONFIGURATION

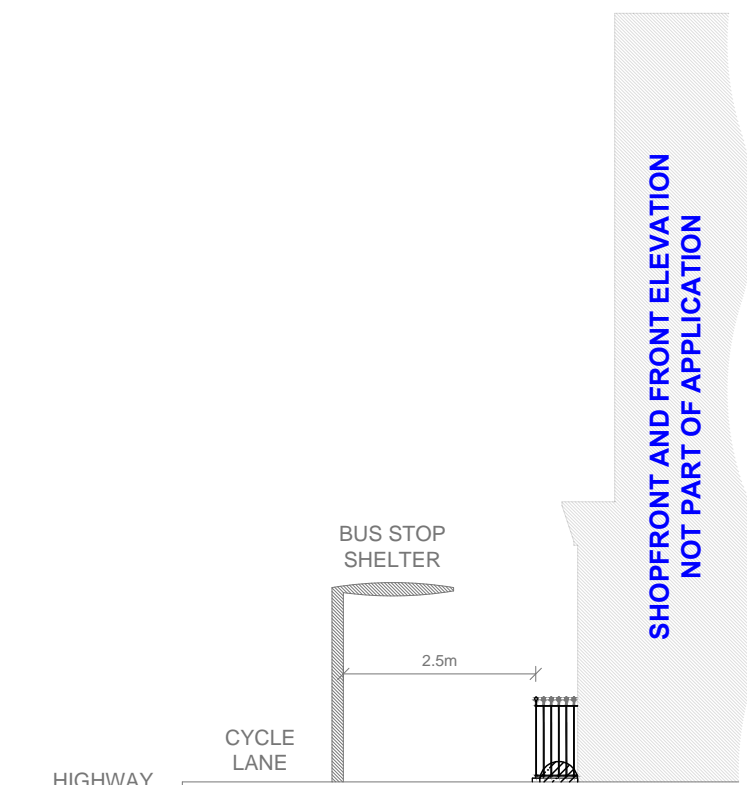

PROPOSED LIGHTWELL CONFIGURATION

## SIDE ELEVATION

**Revision notes:**

Rev:	Date:	Notes:
A	20.01.2017	ANNOTATION CHANGES (SHOPFRONT / FRONT ELEVATION NOT PART OF APPLICATION)
B	06.03.2017	METAL GRILLE COVER REPLACED WITH DOMED SKYLIGHTS

**Drawn by:**  
GC

**Project:**  
Flat 1, 245 Royal College Street, London NW1 9LT  
Full Planning Application Ref: PP-05241164

**Date:**  
21 June 2016

**Client:**  
Ganeshwaran Velautham  
40 Copse Wood Way, London HA6 2UA


**Drawing Title:**  
Existing and Proposed Side Elevation  
DWG-02

**Scale @ A3:**  
1:100


**Revision:**  
B

BONNYSTREET PLANNING LIMITED


WWW.TOWNPLANNING.LONDON

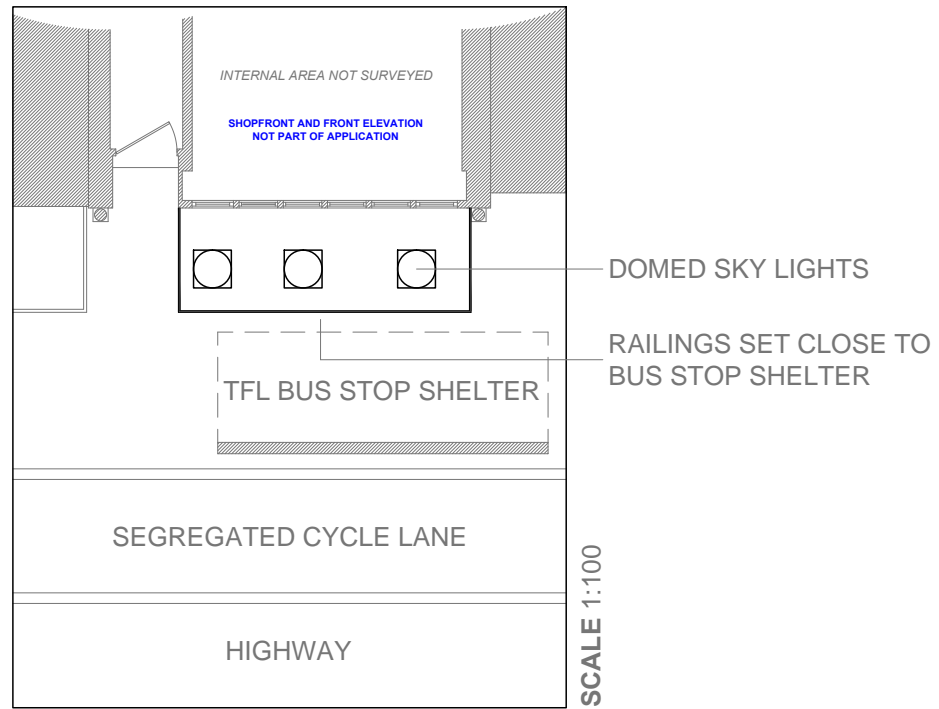

PREVIOUSLY APPROVED LIGHTWELL CONFIGURATION

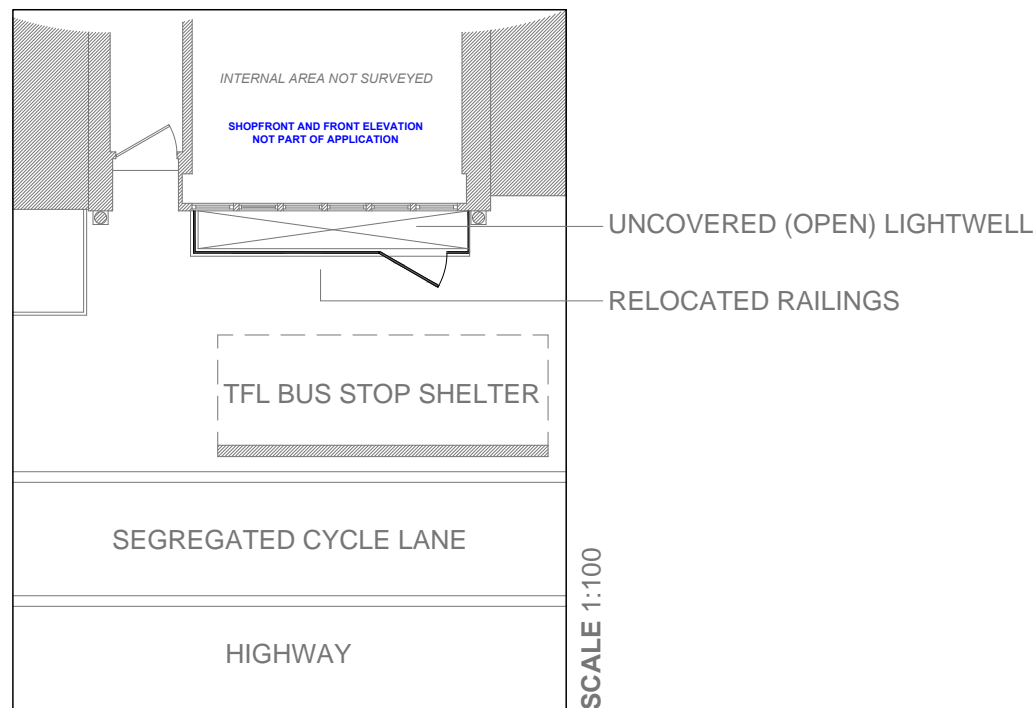

EXISTING (AS BUILT) LIGHTWELL CONFIGURATION

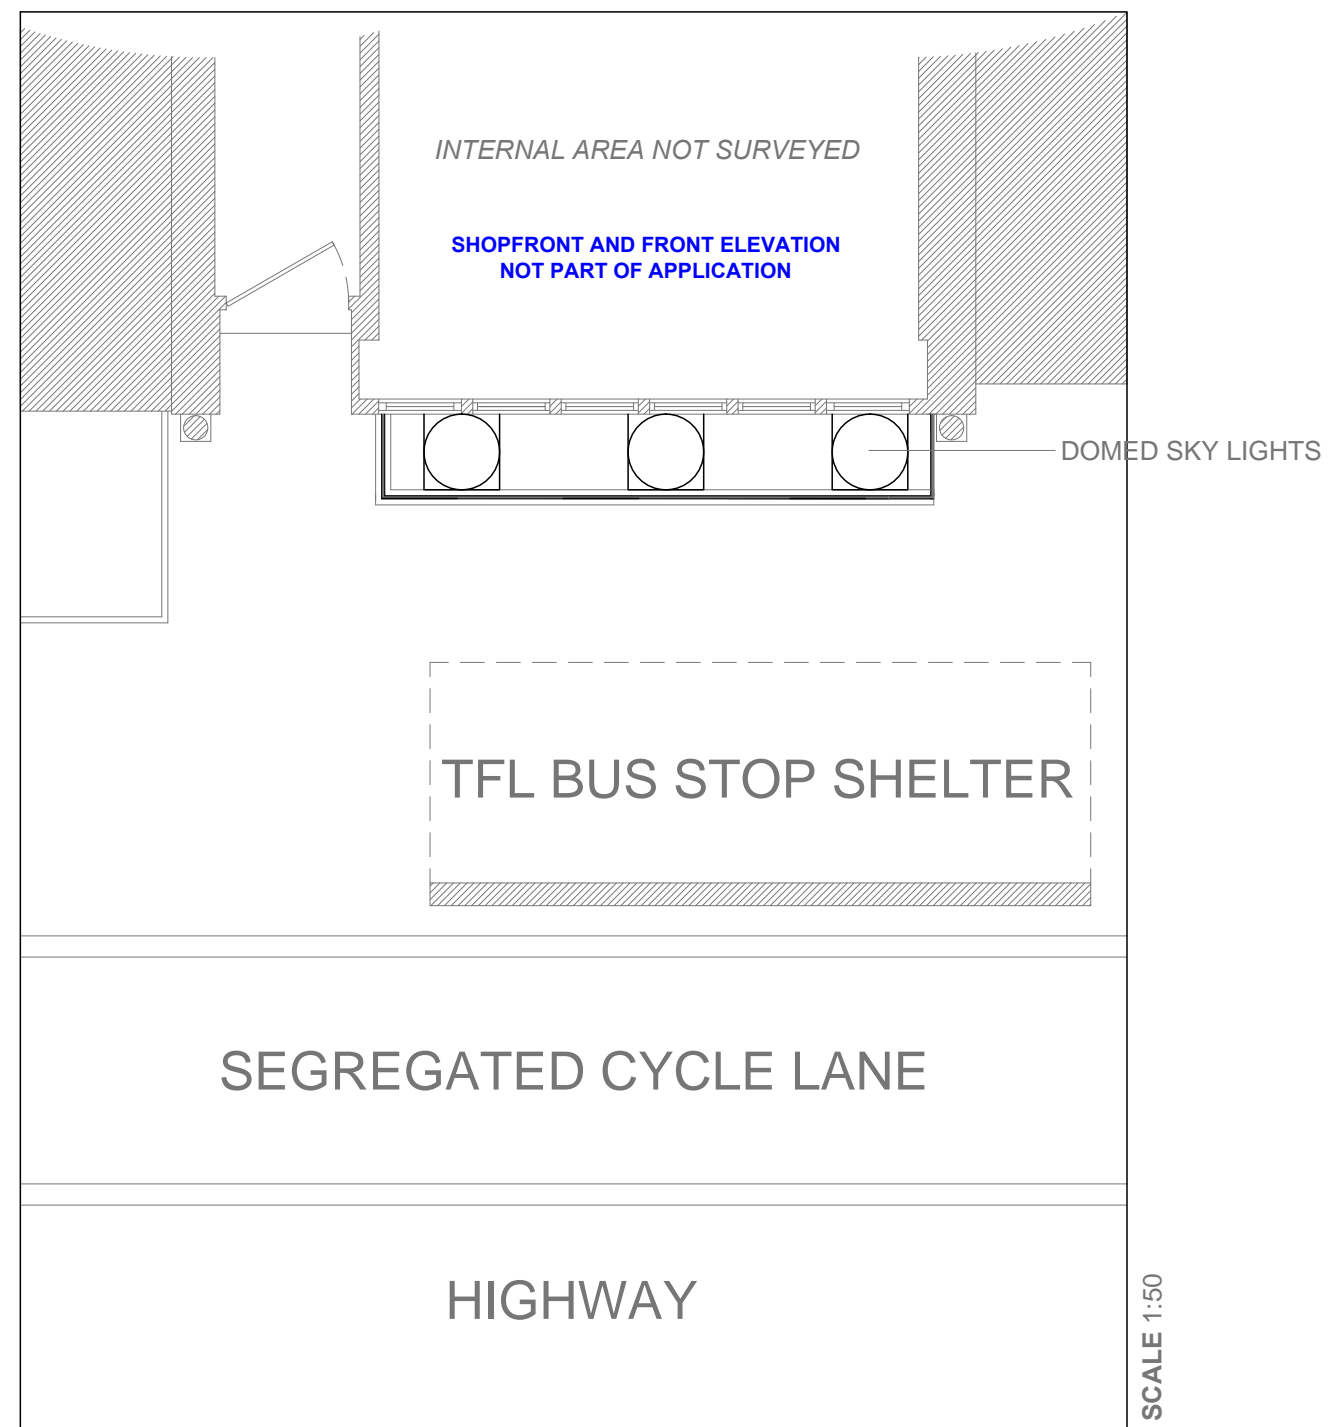

PROPOSED LIGHTWELL CONFIGURATION

# GROUND FLOOR PLAN


Revision notes:		
Rev:	Date:	Notes:
A	20.01.2017	ANNOTATION CHANGES (SHOPFRONT / FRONT ELEVATION NOT PART OF APPLICATION)
B	06.03.2017	METAL GRILLE COVER REPLACED WITH DOMED SKYLIGHTS

<b>Drawn by:</b> GC	<b>Project:</b> Flat 1, 245 Royal College Street, London NW1 9LT Full Planning Application Ref: PP-05241164
<b>Client:</b> Ganeshwaran Velautham 40 Copse Wood Way, London HA6 2UA	<b>Drawing Title:</b> Existing and Proposed Ground Floor Plan DWG-03

<b>Date:</b> 21 June 2016	<b>Scale @ A3:</b> as indicated
<b>Revision:</b> B	

**BONNYSTREET PLANNING LIMITED**


WWW.TOWNPLANNING.LONDON

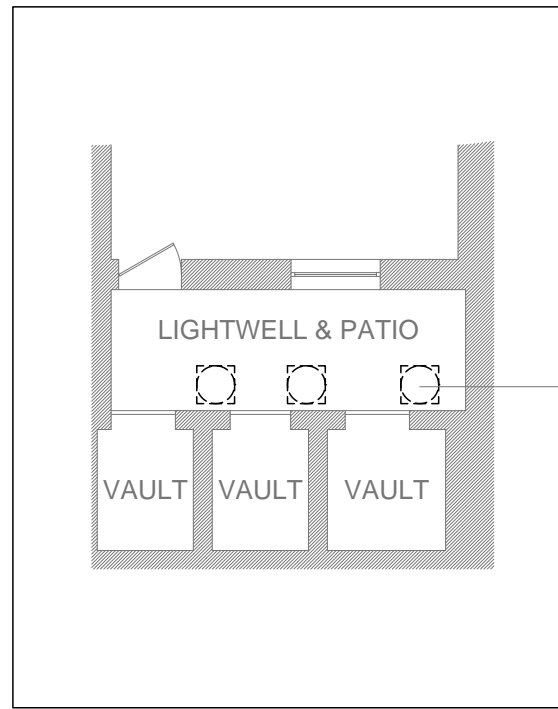

DOMED SKY LIGHTS ABOVE

SCALE 1:100


PREVIOUSLY APPROVED LIGHTWELL CONFIGURATION

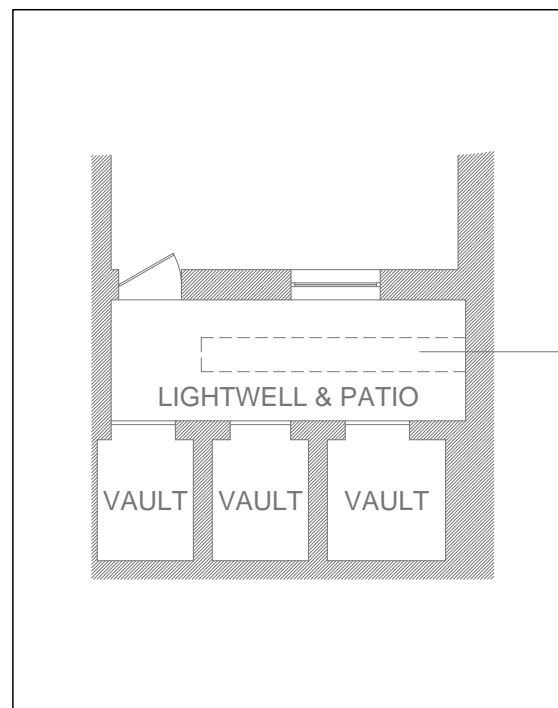

UNCOVERED OPENING ABOVE

SCALE 1:100

EXISTING (AS BUILT) LIGHTWELL CONFIGURATION

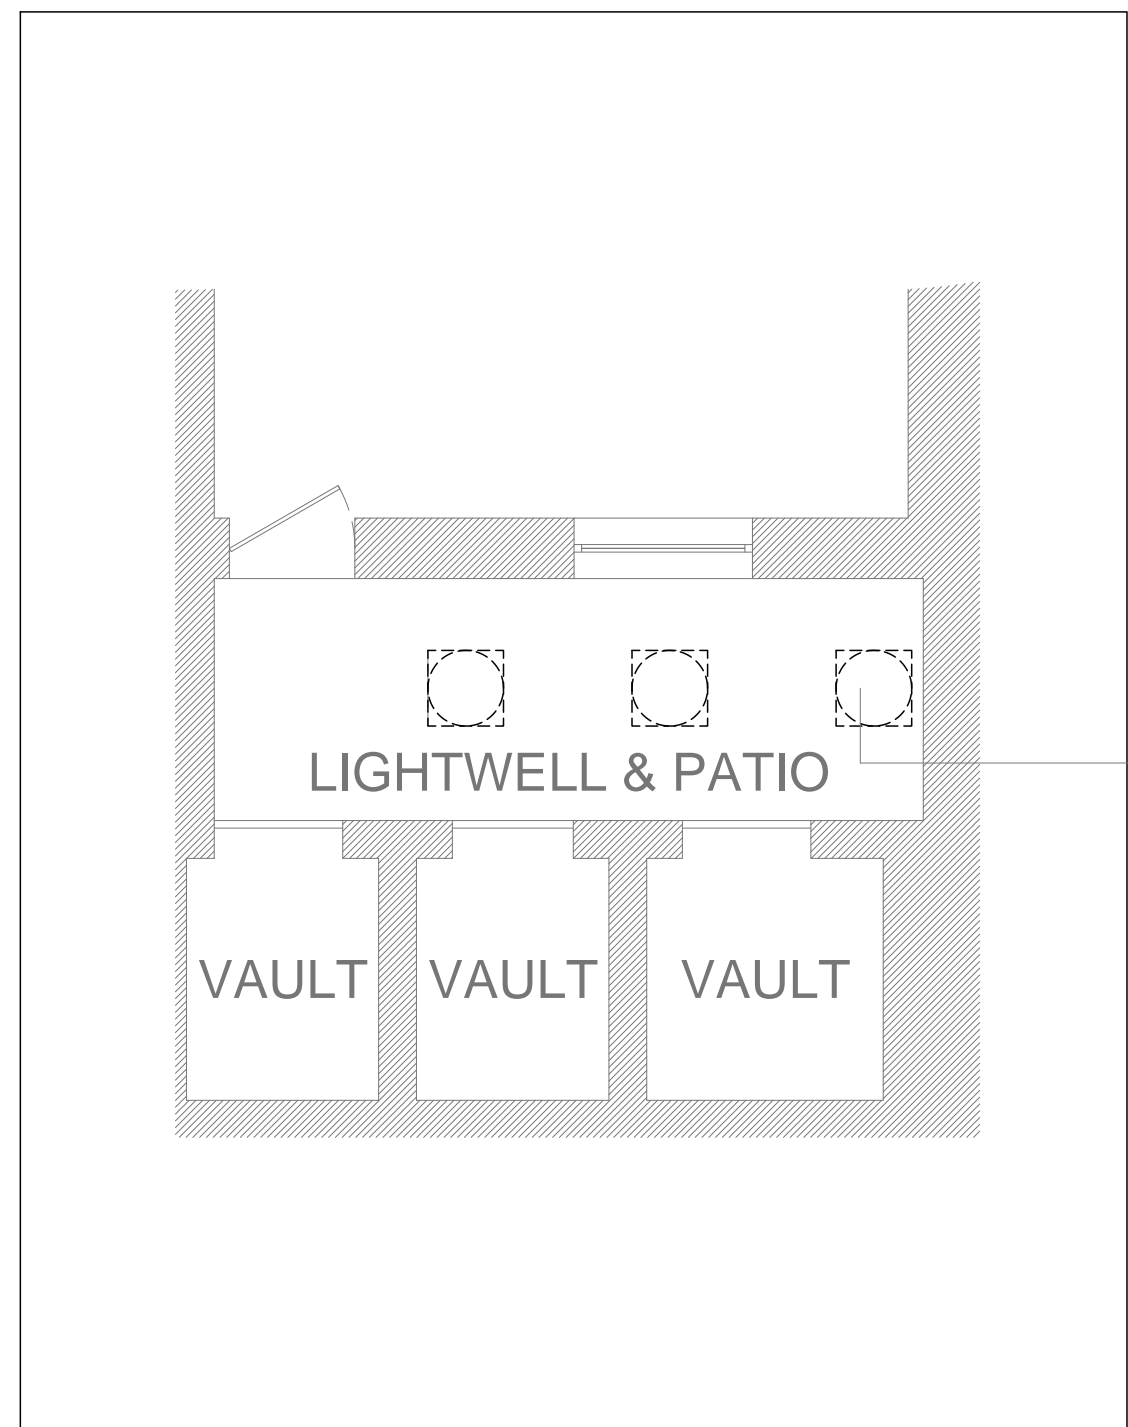

DOMED SKY LIGHTS ABOVE

SCALE 1:50

PROPOSED LIGHTWELL CONFIGURATION

# BASEMENT PLAN

Revision notes:		
Rev:	Date:	Notes:
A	20.01.2017	ANNOTATION CHANGES (SHOPFRONT / FRONT ELEVATION NOT PART OF APPLICATION)
B	06.03.2017	METAL GRILLE COVER REPLACED WITH DOMED SKYLIGHTS

**Drawn by:**  
GC

**Project:**  
Flat 1, 245 Royal College Street, London NW1 9LT  
Full Planning Application Ref: PP-05241164

**Date:**  
21 June 2016

**Client:**  
Ganeshwaran Velautham  
40 Copse Wood Way, London HA6 2UA

**Drawing Title:**  
Existing and Proposed Basement Plan  
DWG-04

**Scale @ A3:**  
as indicated

**Revision:**  
B

**BONNYSTREET PLANNING LIMITED**

WWW.TOWNPLANNING.LONDON

0m (1:100) 1m 2m 3m 4m 5m 0m (1:50) 1m

2m 3m 4m 5m