
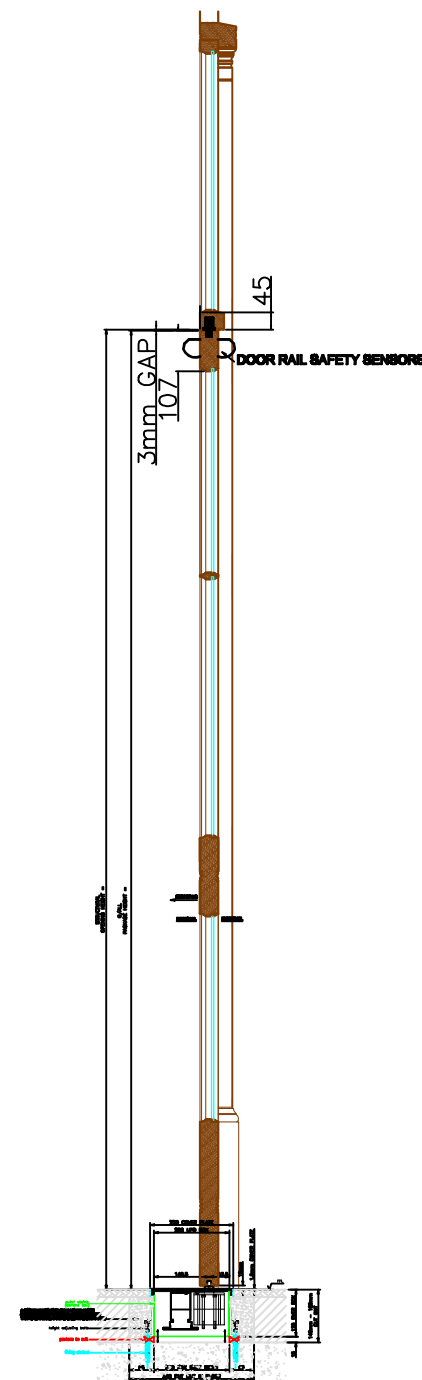


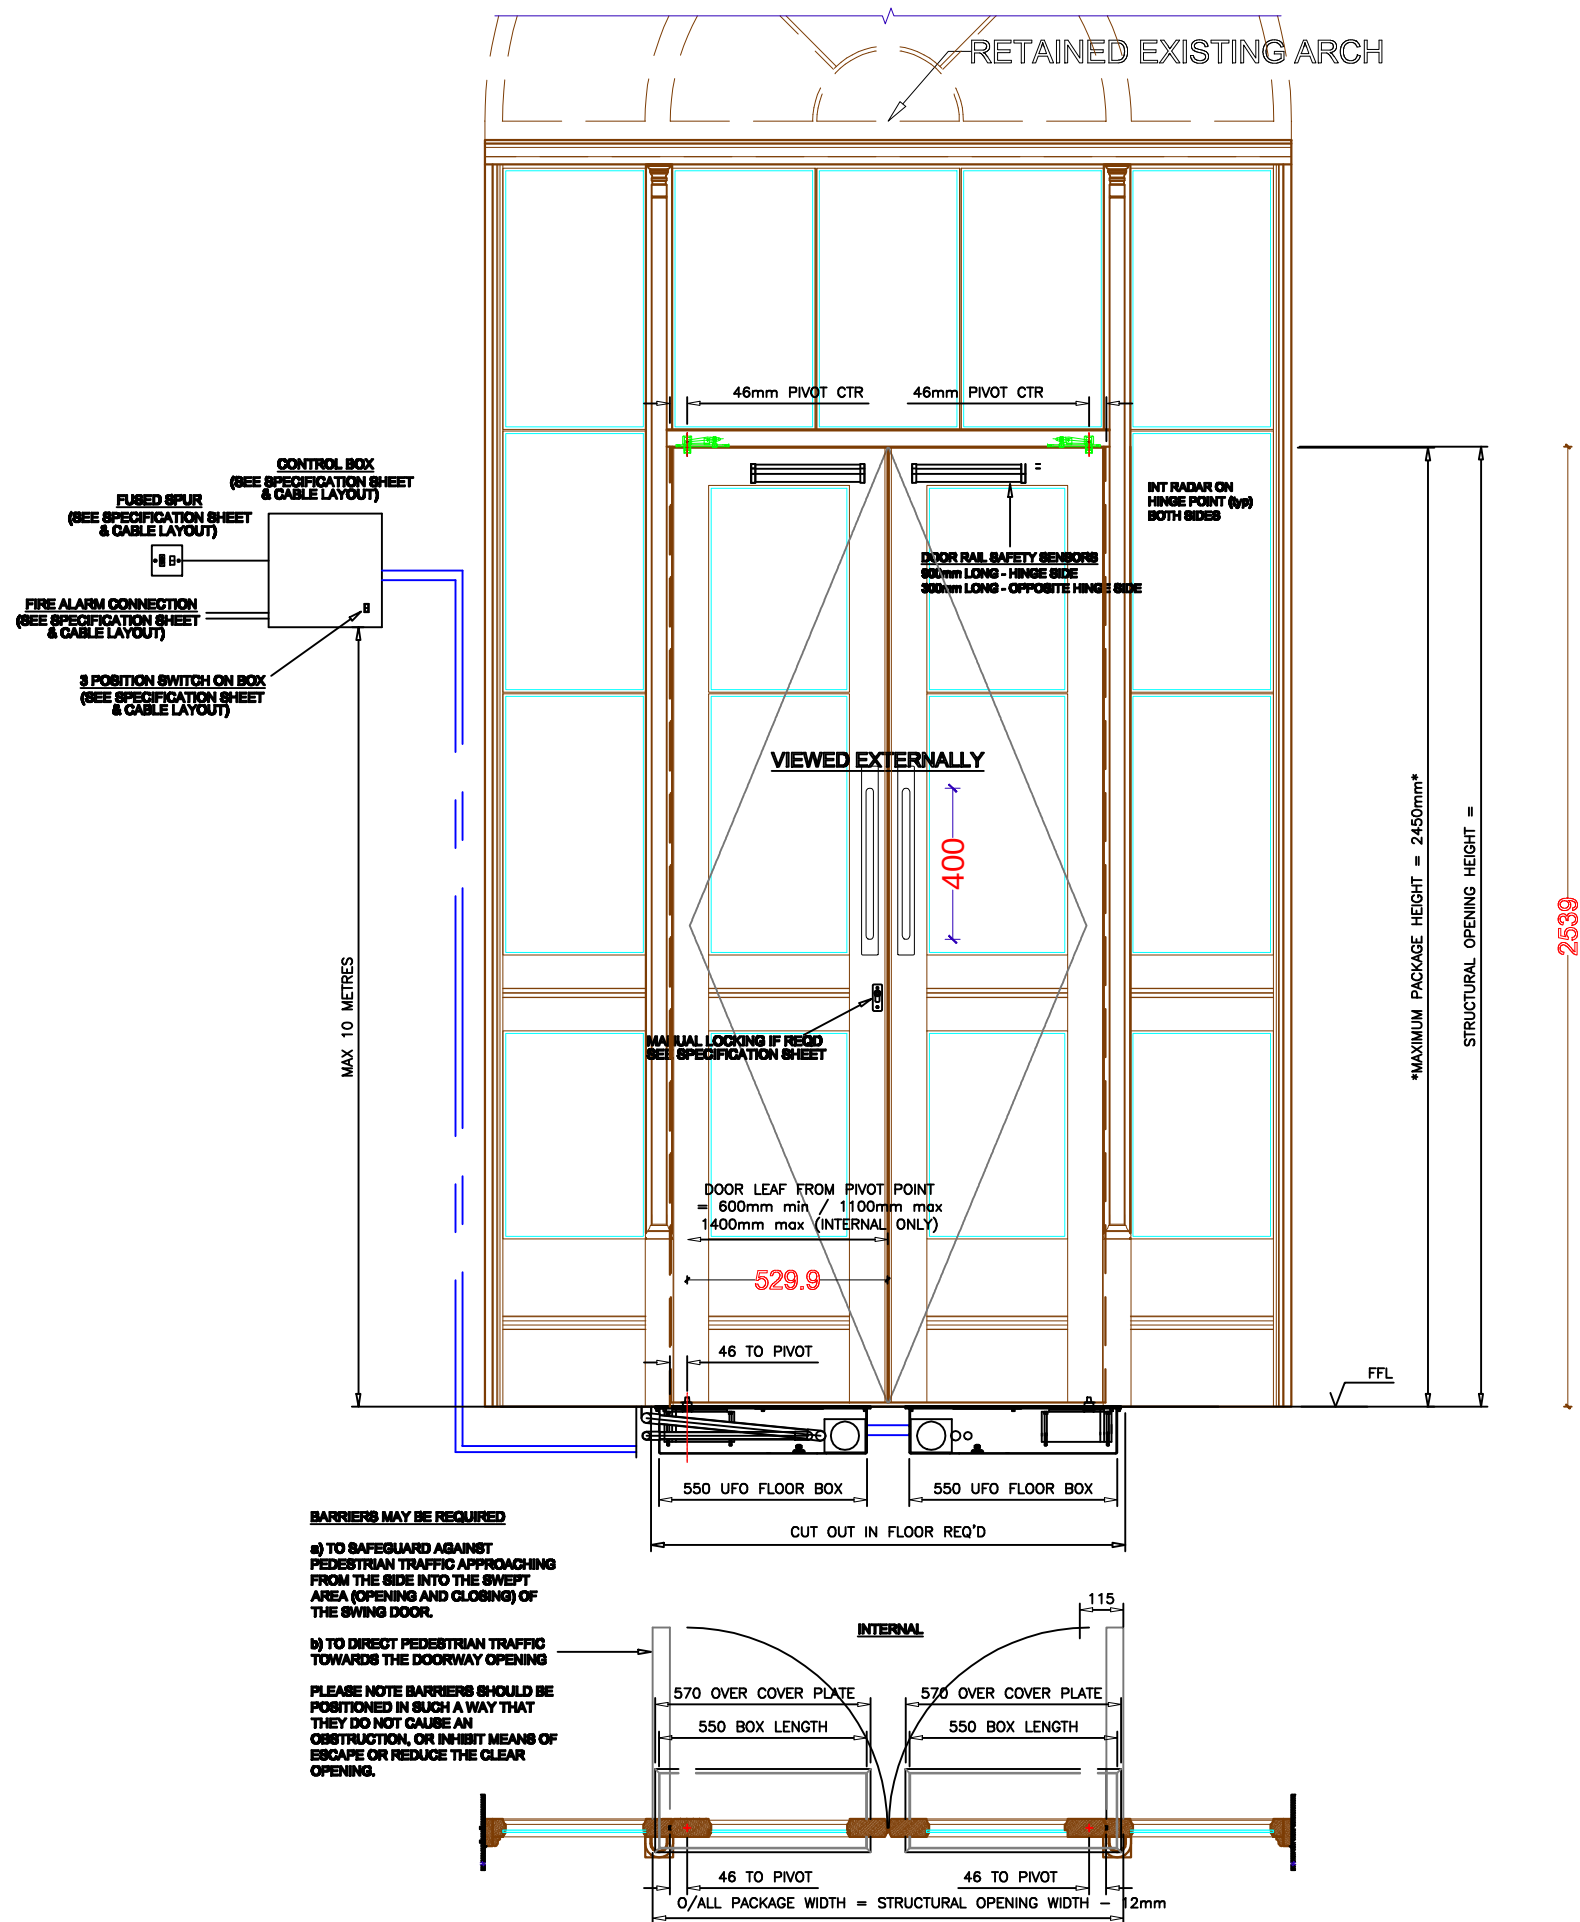

NOTES:									
DIMENSIONS ARE NOT TO BE SCALED OFF THIS DRAWING.									
THIS DESIGN IS COPYRIGHT AND MUST NOT BE REPRODUCED WITHOUT THE WRITTEN CONSENT OF BEAMFAST LIMITED.									
PROJECT NO.		272				DATE		14.06.2016	
PROJECT TITLE		WILKINS TERRACE						14.12.2016	
COMPANY		BALFOUR BEATTY						13.01.2017	
AB : As Built		C : Construction		A : Approval				A	A
Drawing No.				Paper Size	Scale		LATEST REV	1	2
BF - 272 - 002 - C0012A - 4				A3	1:1 1:2				/
Revisions									
No.	Description					Date		By	
1	ADJUSTMENTS TO THE MODIFIED DETAILS					14.06.2016		A.C.	
2	ADJUSTMENTS TO THE MODIFIED DETAILS					14.12.2016		G.V	
3	ADJUSTMENTS TO THE MODIFIED DETAILS					03.01.2017		G.V	
4	CHANGES TO IRONMONGERY					08.03.2017		G.V	
DRAWING REFERENCE									
NO.		DESCRIPTION				REFERENCE			
A - 000 - (001) - X 000 SERIES		001 - WORKTOPS DRAWINGS				X = P (Plans) E (Elevations) S (Sections) D (Details) M (3D model) C (P+S+ S+D etc.)			
A - 000 - (002) - X 000 SERIES		002 - DOORS DRAWINGS							
A - 000 - (003) - X 000 SERIES		003 - WINDOWS DRAWINGS							
A - 000 - (004) - X 000 SERIES		004 - CUPBOARDS DRAWINGS							
A - 000 - (005) - X 000 SERIES		005 - WALL LINING DRAWINGS							
A - 000 - (006) - X 000 SERIES		006 - CABINET DRAWINGS							
A - 000 - (007) - X 000 SERIES		007 - ARTWORK DRAWINGS							
A - 000 - (008) - X 000 SERIES		008 - SHELF UNITS DRAWINGS							
Door Details:									
Single Door									
Double Door							√		
Leaf And A Half									
FD 60 Solid Core Door									
Flamebreak									
Halspan									
Moralt									
Non FD Door									
PLY Facing on Door									
Oak Veneer facings									
Hardwood glazing beading and frame (minimum density of 640 Kg/M3)							√		
Hardwood lipping on all four sides (minimum density of 640 Kg/M3)							√		
Softwood frame									
FSC Certified							√		
Finishing Details:									
Rosewood Stain									
External based lacquer									
Clear lacquer finish									
Dulux Weather Shield System									
Primer Only							√		
Other Finish									
Vision Panel:									
15mm Pyrodur Glass									
7mm Pyrodur Clear									
6mm Laminated Glass							√		
Intumescent strip:									
Type 617 - Lorient Polyproducts Ltd. (FD60/ FD30)									
PVC encased Palusol 100 - Mann McGowan Ltd (FD30)									
Pyrostrip 500P - Mann McGowan Ltd (FD60)									
Plain									
Brushed									
Fin									
PVC encapsulated - Colour									
Brown									
White									
Other Colour									
Architrave:									
Opening side size:									
Stop side size:									
Remove Existing Door									
Reveal Lining									
Threshold Timber									
Threshold S/S									
6mm									
12mm									

Project: 272		WILKINS TERRACE	
Project phase/location : NORTH CLOISTERS			
Title DE/30. ELEVATION FROM OUTSIDE			
Drawing No BF - 272 - 002 - C0012a.4			
Client Details UNIVERSITY COLLEGE LONDON			
Revision 4		Issue Status A	
Date 08.03.20017		Checked by JSN	
Drawn by G.V		Scale 1:20	
Drawing ref.		Page size A3	
File location S:\DRAWINGS\PROJECTS\272 WILKINS TERRACE\			