


AS APPROVED

TO BE READ IN CONJUNCTION WITH STRUCTURAL ENGINEER'S DRAWINGS.
REPORT ALL DISCREPANCIES PRIOR TO PROCEEDING.

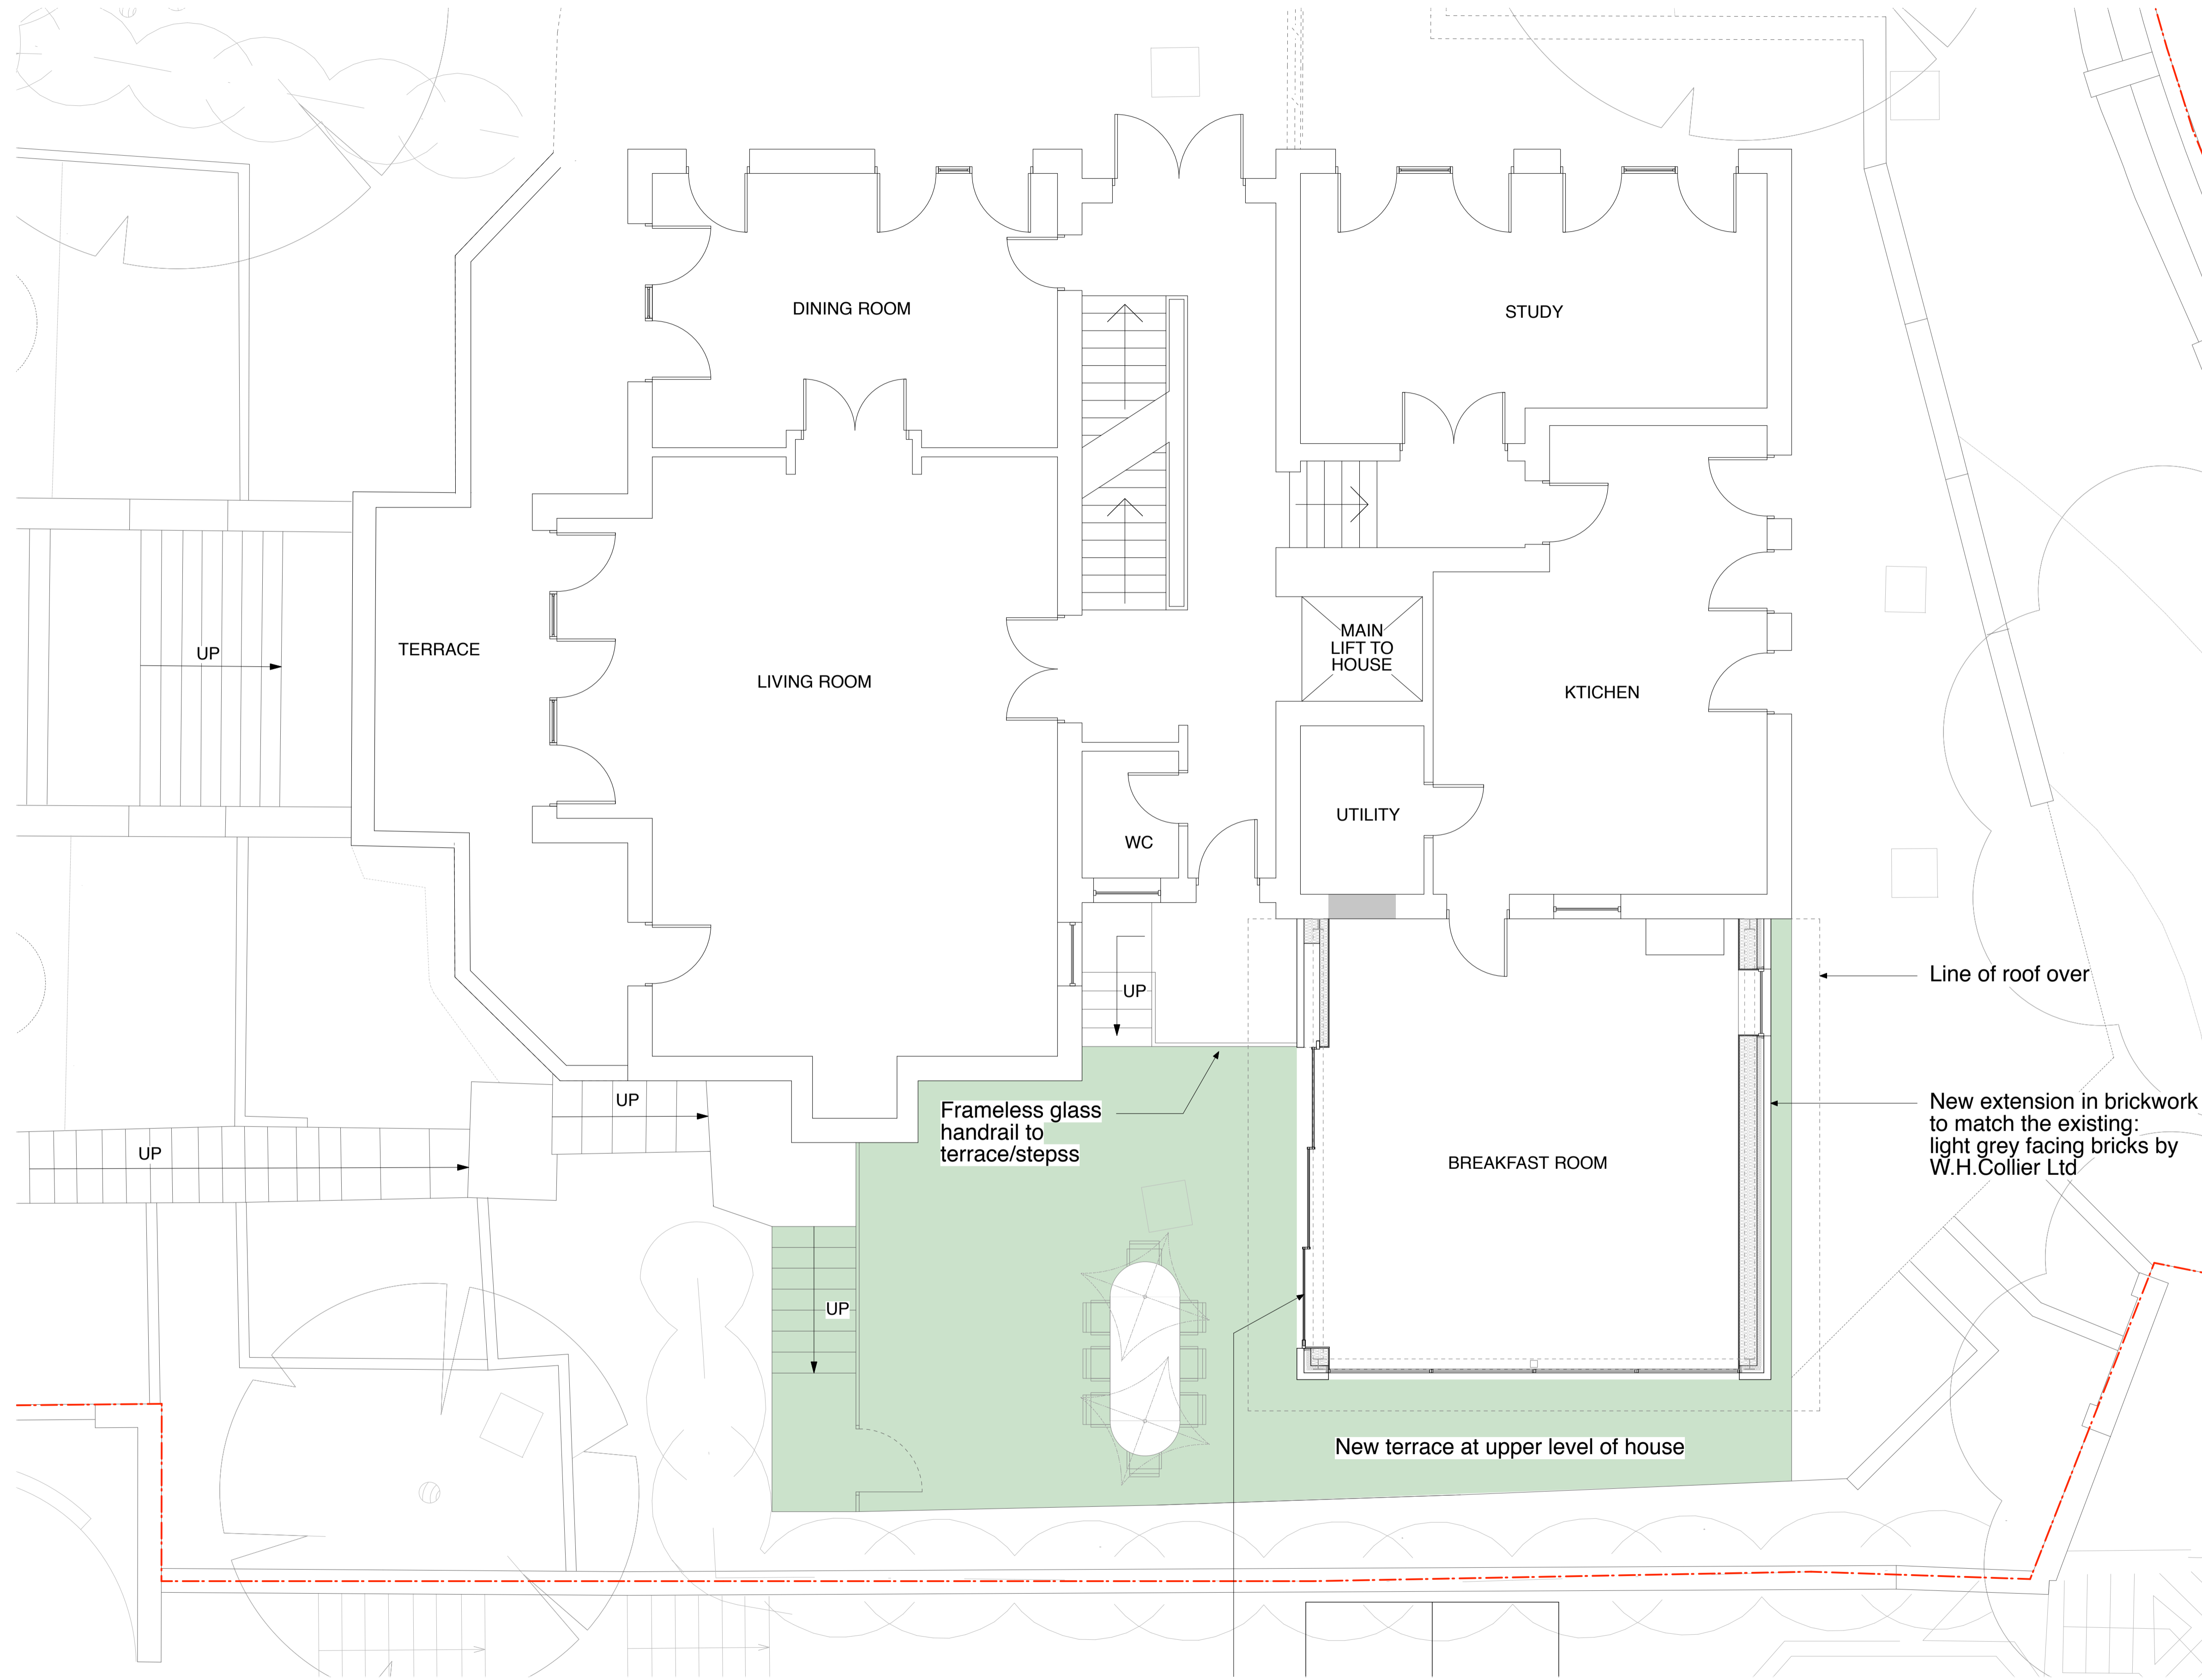



Frameless glass handrail to terrace/steps

Line of roof over

New extension in brickwork to match the existing: light grey facing bricks by W.H. Collier Ltd


New terrace at upper level of house

Sliding doors in aluminium frames, powder coated to match the existing windows, all 3 doors slide back into pocket in wall

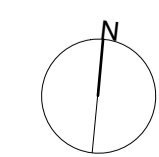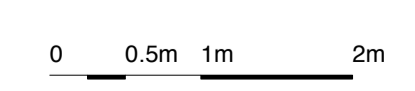

REV B	Raised terrace level shown in green	30/08/16
REV A	Existing internal steps shown	25/07/16
REVISION		DATE

Yeates Design LLP
74 Clerkenwell Road
London EC1M 5QA
tel: 020 7251 6667
www.yeatesdesign.co.uk

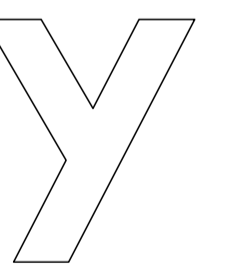

PROJECT : 4 HIGHFIELDS GROVE,
HIGHGATE, LONDON,
N6 6HN

DRAWING : PROPOSAL FIRST FLOOR PLAN

SCALE : 1:50 @ A1 1:100 @ A3

DATE : September 2015


DWG NO. 574/P/011 DWN BY : B

DRAWING STATUS : FOR TENDER
FOR PLANNING FOR CONSTRUCTION

INFORMATION CONTAINED IN THIS DRAWING IS THE SOLE COPYRIGHT OF YEATES DESIGN + ARCHITECTURE AND SHOULD NOT BE REPRODUCED WITHOUT THEIR PERMISSION


AS APPROVED

TO BE READ IN CONJUNCTION WITH STRUCTURAL
ENGINEER'S DRAWINGS.
REPORT ALL DISCREPANCIES PRIOR TO PROCEEDING.

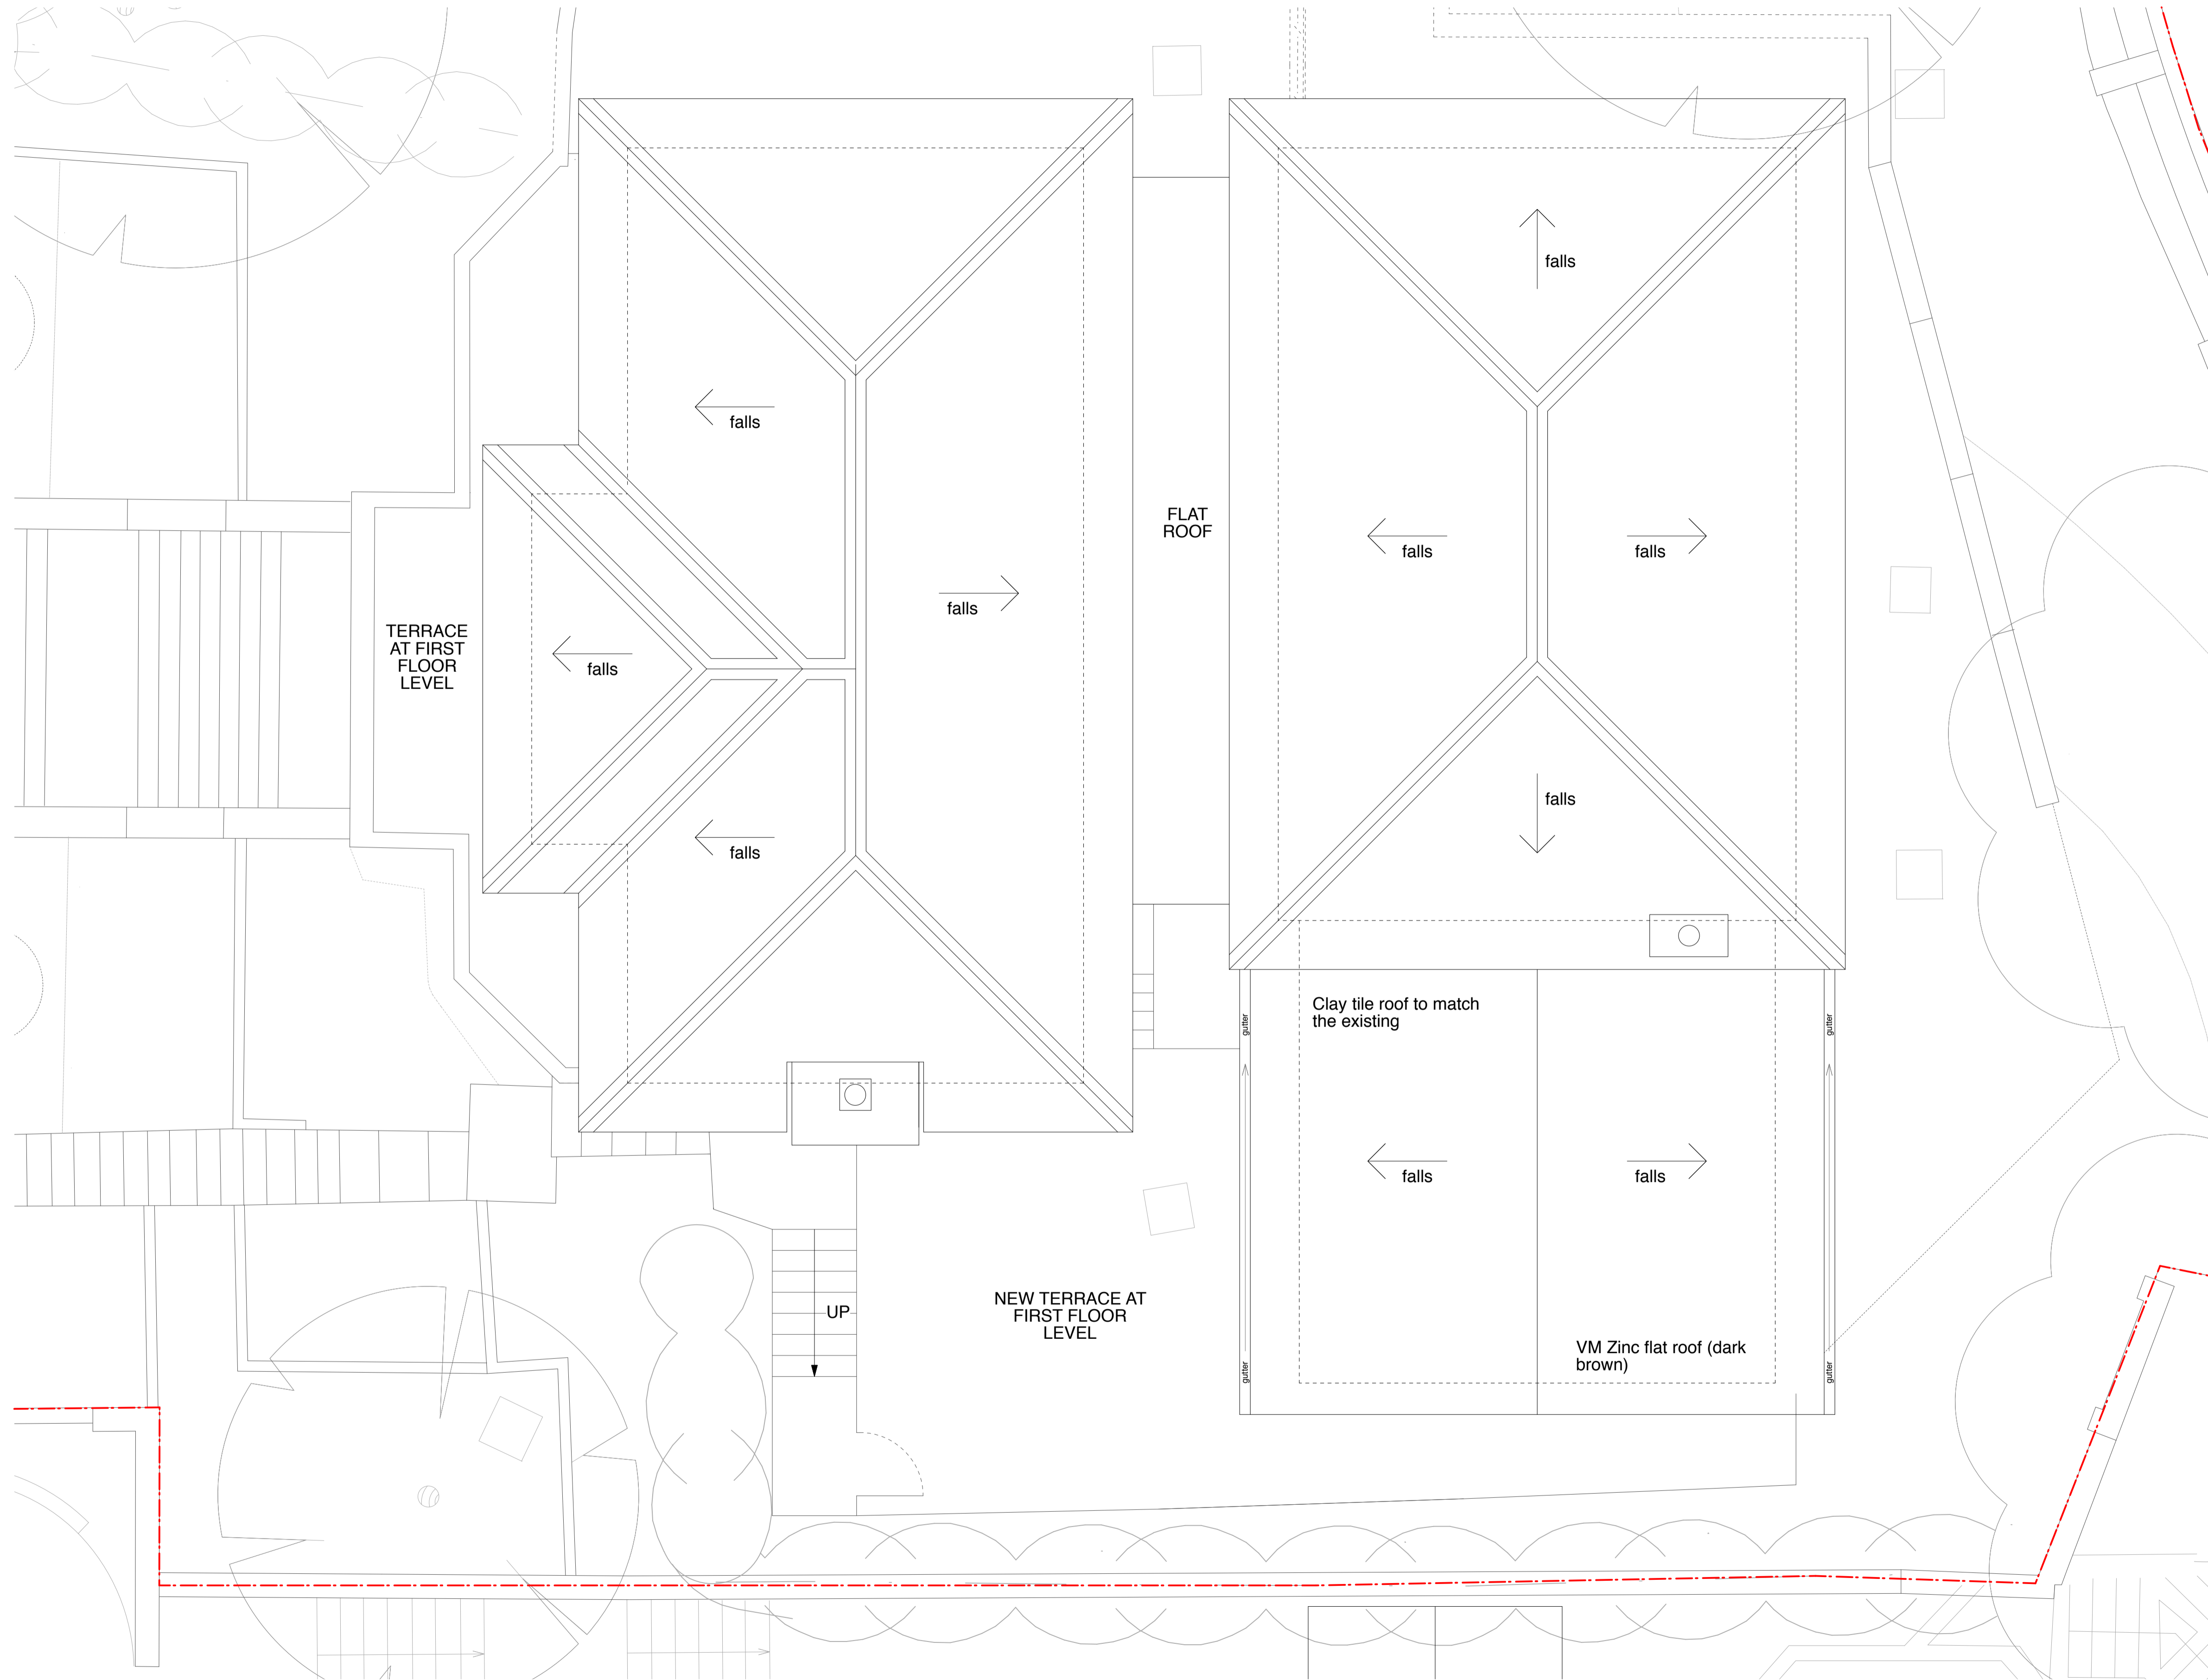

REVISION	DATE
----------	------

Yeates Design LLP
74 Clerkenwell Road
London EC1M 5QA
tel: 020 7251 6667
www.yeatesdesign.co.uk

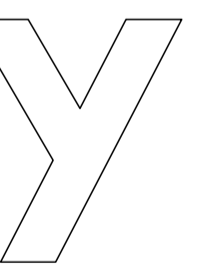

PROJECT : 4 HIGHFIELDS GROVE,
HIGHGATE, LONDON,
N6 6HN

DRAWING :
PROPOSED ROOF PLAN

SCALE : 1:50 @ A1 1:100 @ A3


DATE : September 2015

DWG NO. 574/P/012 DWN BY :

DRAWING STATUS : FOR TENDER
FOR PLANNING FOR CONSTRUCTION



INFORMATION CONTAINED IN THIS DRAWING IS THE SOLE COPYRIGHT
OF YEATES DESIGN + ARCHITECTURE AND SHOULD NOT BE
REPRODUCED WITHOUT THEIR PERMISSION

0 0.5m 1m 2m

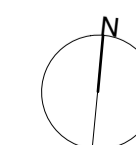

AS APPROVED


TO BE READ IN CONJUNCTION WITH STRUCTURAL ENGINEER'S DRAWINGS.
REPORT ALL DISCREPANCIES PRIOR TO PROCEEDING.

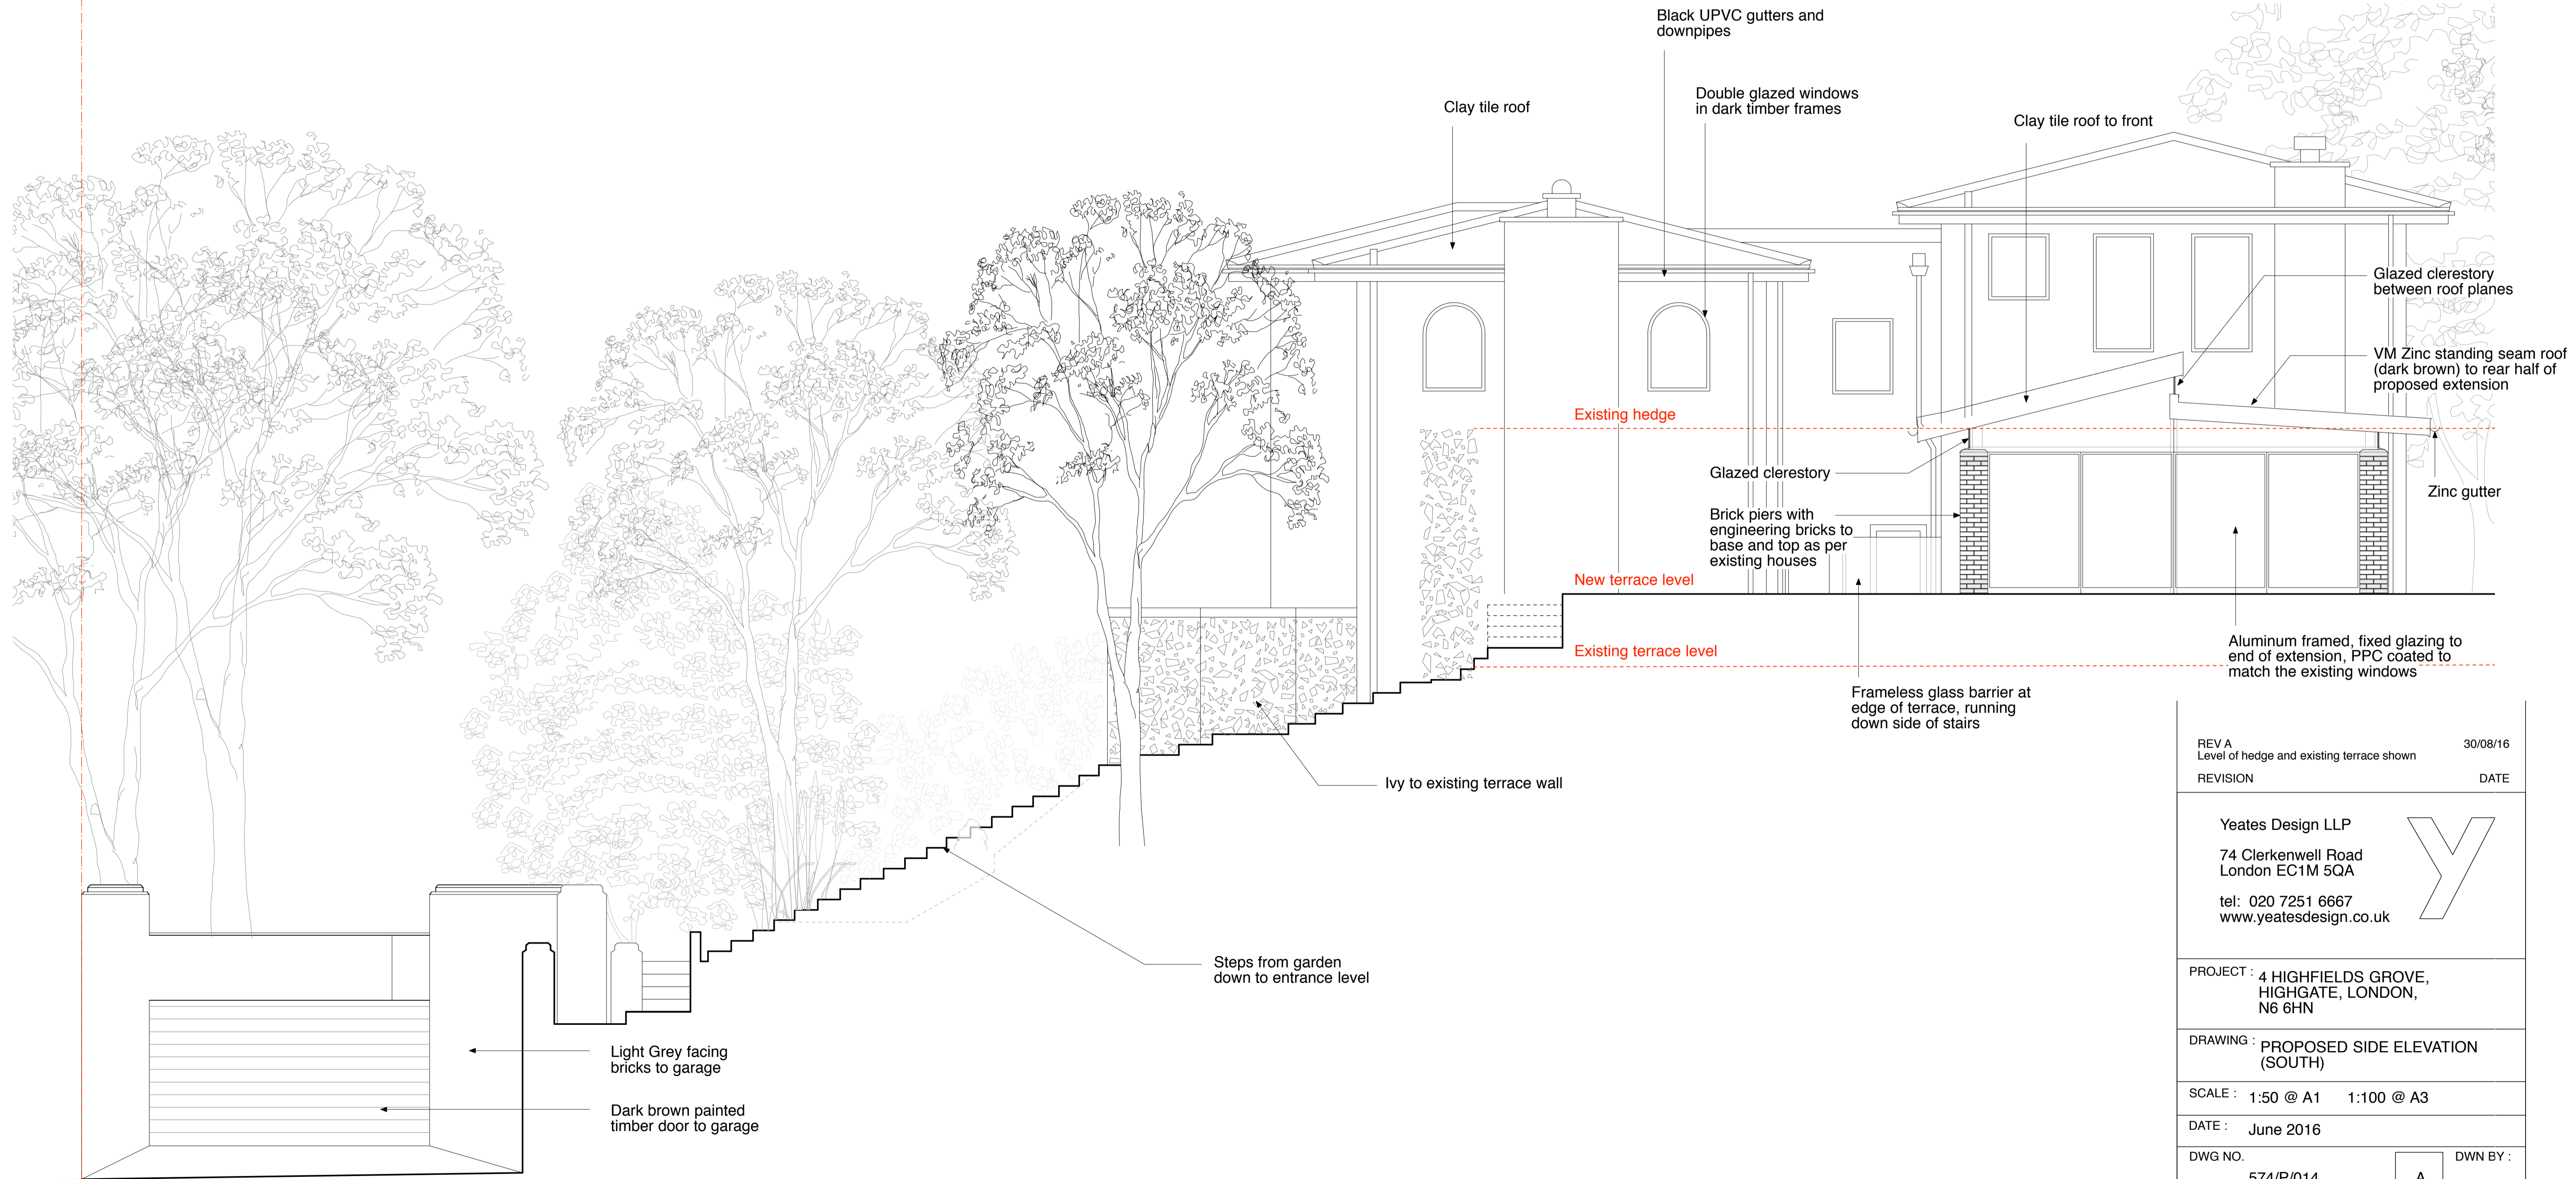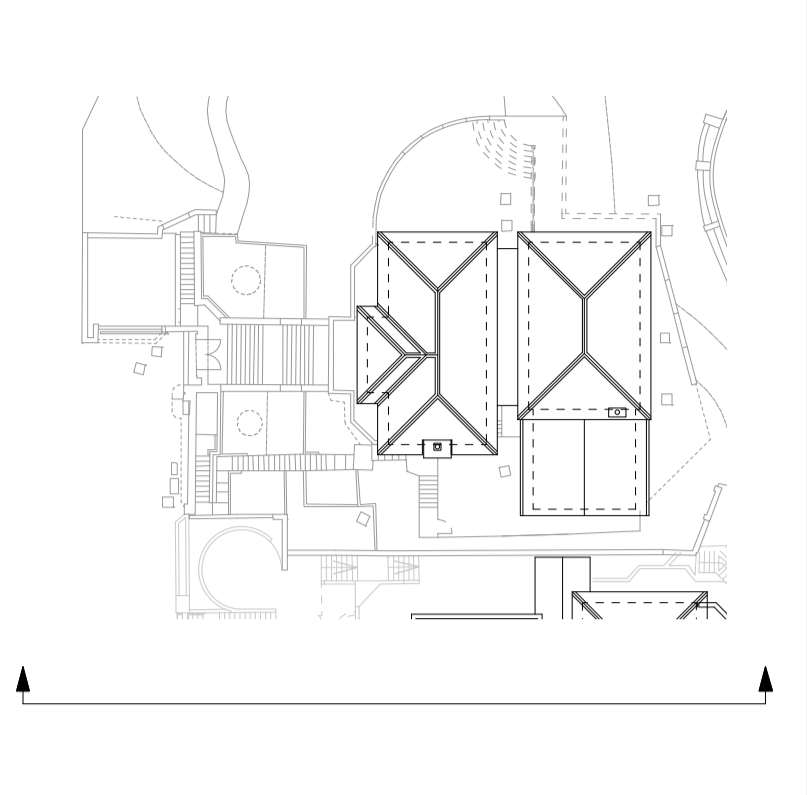

REV A 30/08/16
Level of hedge and existing terrace shown DATE

REVISION DATE

Yeates Design LLP
74 Clerkenwell Road
London EC1M 5QA
tel: 020 7251 6667
www.yeatesdesign.co.uk

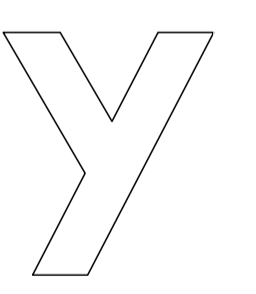

PROJECT: 4 HIGHFIELDS GROVE,
HIGHGATE, LONDON,
N6 6HN

DRAWING: PROPOSED SIDE ELEVATION
(SOUTH)

SCALE: 1:50 @ A1 1:100 @ A3

DATE: June 2016

DWG NO. 574/P/014 A DWN BY:

DRAWING STATUS: FOR TENDER
FOR PLANNING FOR CONSTRUCTION

INFORMATION CONTAINED IN THIS DRAWING IS THE SOLE
COPYRIGHT OF YEATES DESIGN LLP AND SHOULD NOT BE
REPRODUCED WITHOUT THEIR PERMISSION

4 Highfields Grove

0 0.5m 1m 2m