


AS PROPOSED

TO BE READ IN CONJUNCTION WITH STRUCTURAL ENGINEER'S DRAWINGS.
REPORT ALL DISCREPANCIES PRIOR TO PROCEEDING.

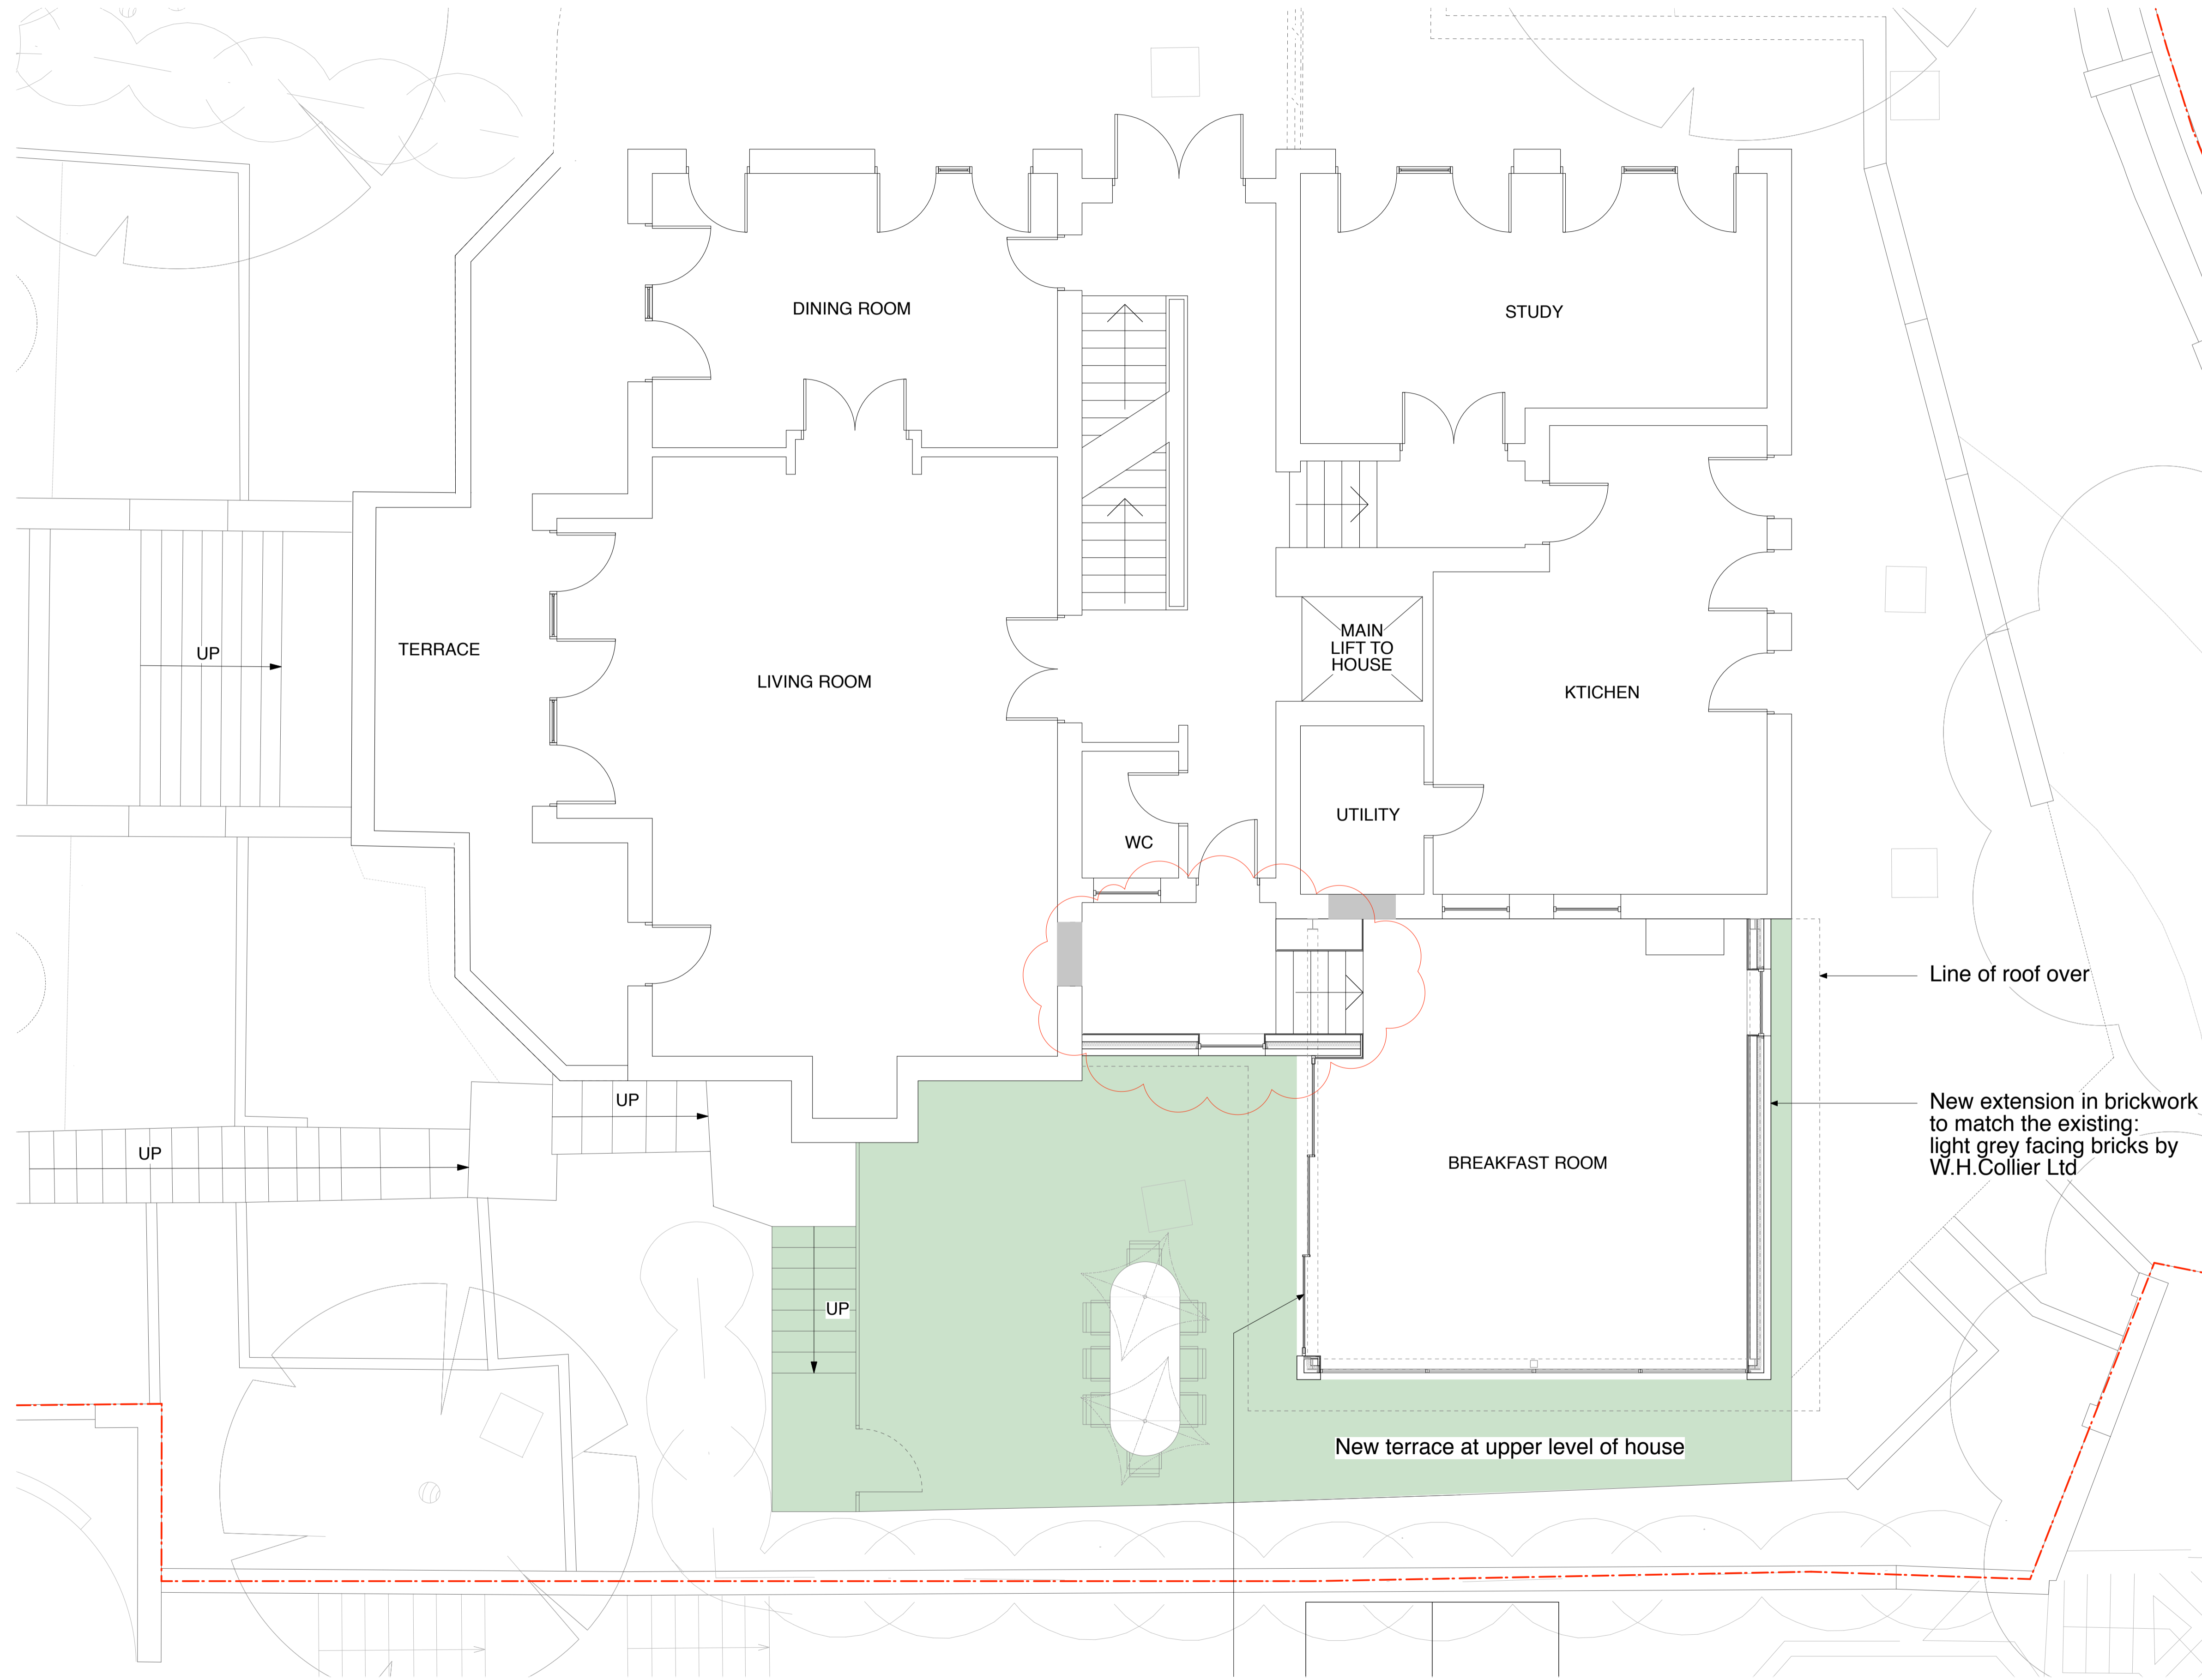


Sliding doors in aluminium frames, powder coated to match the existing windows, all 3 doors slide back into pocket in wall

0 0.5m 1m 2m



REVISION	DATE
REV C External steps enclosed to give internal access	04/04/17
REV B Raised terrace level shown in green	30/08/16
REV A Existing internal steps shown	25/07/16

Yeates Design LLP
74 Clerkenwell Road
London EC1M 5QA
tel: 020 7251 6667
www.yeatesdesign.co.uk

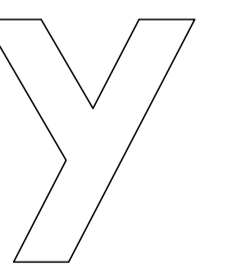

PROJECT : 4 HIGHFIELDS GROVE,
HIGHGATE, LONDON,
N6 6HN

DRAWING : PROPOSAL FIRST FLOOR PLAN

SCALE : 1:50 @ A1 1:100 @ A3

DATE : September 2015


DWG NO. 574/P/011 DWN BY : C

DRAWING STATUS : FOR TENDER
FOR PLANNING FOR CONSTRUCTION

INFORMATION CONTAINED IN THIS DRAWING IS THE SOLE COPYRIGHT OF YEATES DESIGN + ARCHITECTURE AND SHOULD NOT BE REPRODUCED WITHOUT THEIR PERMISSION


AS PROPOSED

TO BE READ IN CONJUNCTION WITH STRUCTURAL ENGINEER'S DRAWINGS.
REPORT ALL DISCREPANCIES PRIOR TO PROCEEDING.

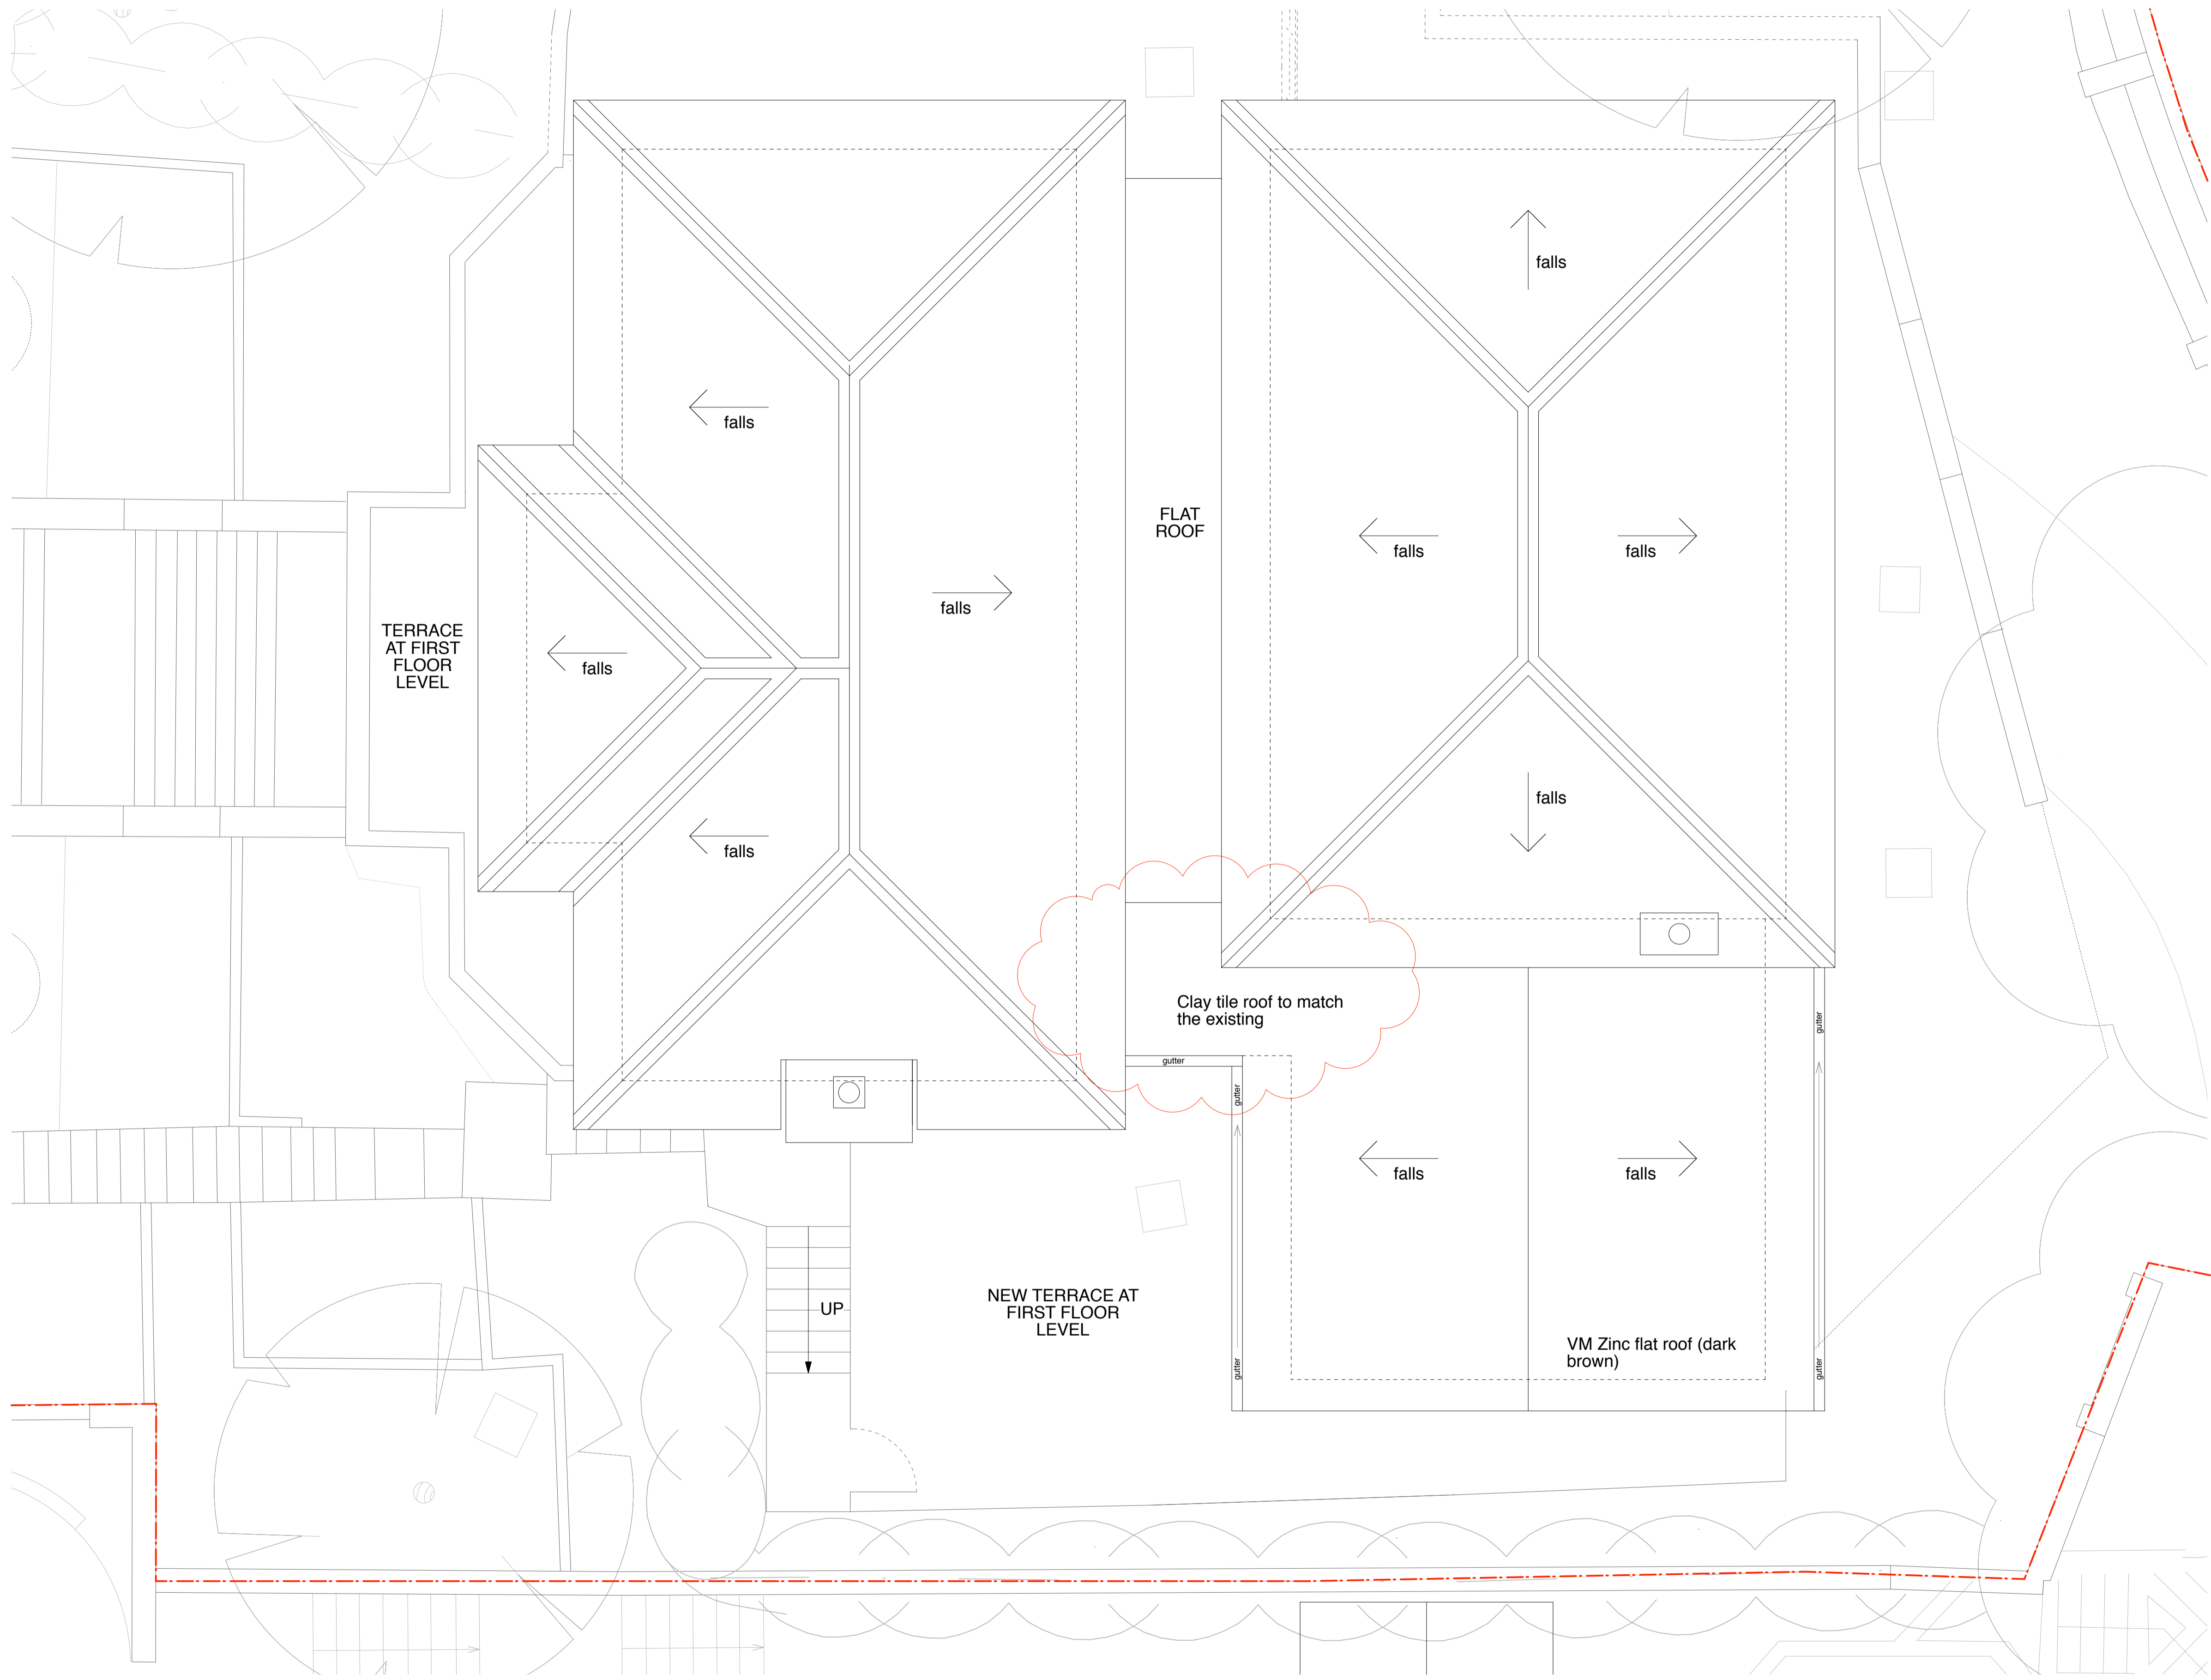

REV A External steps enclosed to give internal access 04/04/17
REVISION DATE

Yeates Design LLP
74 Clerkenwell Road
London EC1M 5QA
tel: 020 7251 6667
www.yeatesdesign.co.uk

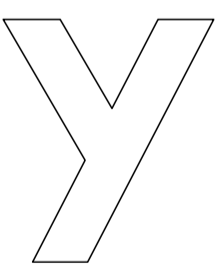

PROJECT : 4 HIGHFIELDS GROVE,
HIGHGATE, LONDON,
N6 6HN

DRAWING : PROPOSED ROOF PLAN

SCALE : 1:50 @ A1 1:100 @ A3

DATE : September 2015



DWG NO. 574/P/012 A DWN BY :

DRAWING STATUS : FOR TENDER
FOR PLANNING FOR CONSTRUCTION

INFORMATION CONTAINED IN THIS DRAWING IS THE SOLE COPYRIGHT OF YEATES DESIGN + ARCHITECTURE AND SHOULD NOT BE REPRODUCED WITHOUT THEIR PERMISSION


AS PROPOSED

TO BE READ IN CONJUNCTION WITH STRUCTURAL ENGINEER'S DRAWINGS.
REPORT ALL DISCREPANCIES PRIOR TO PROCEEDING.

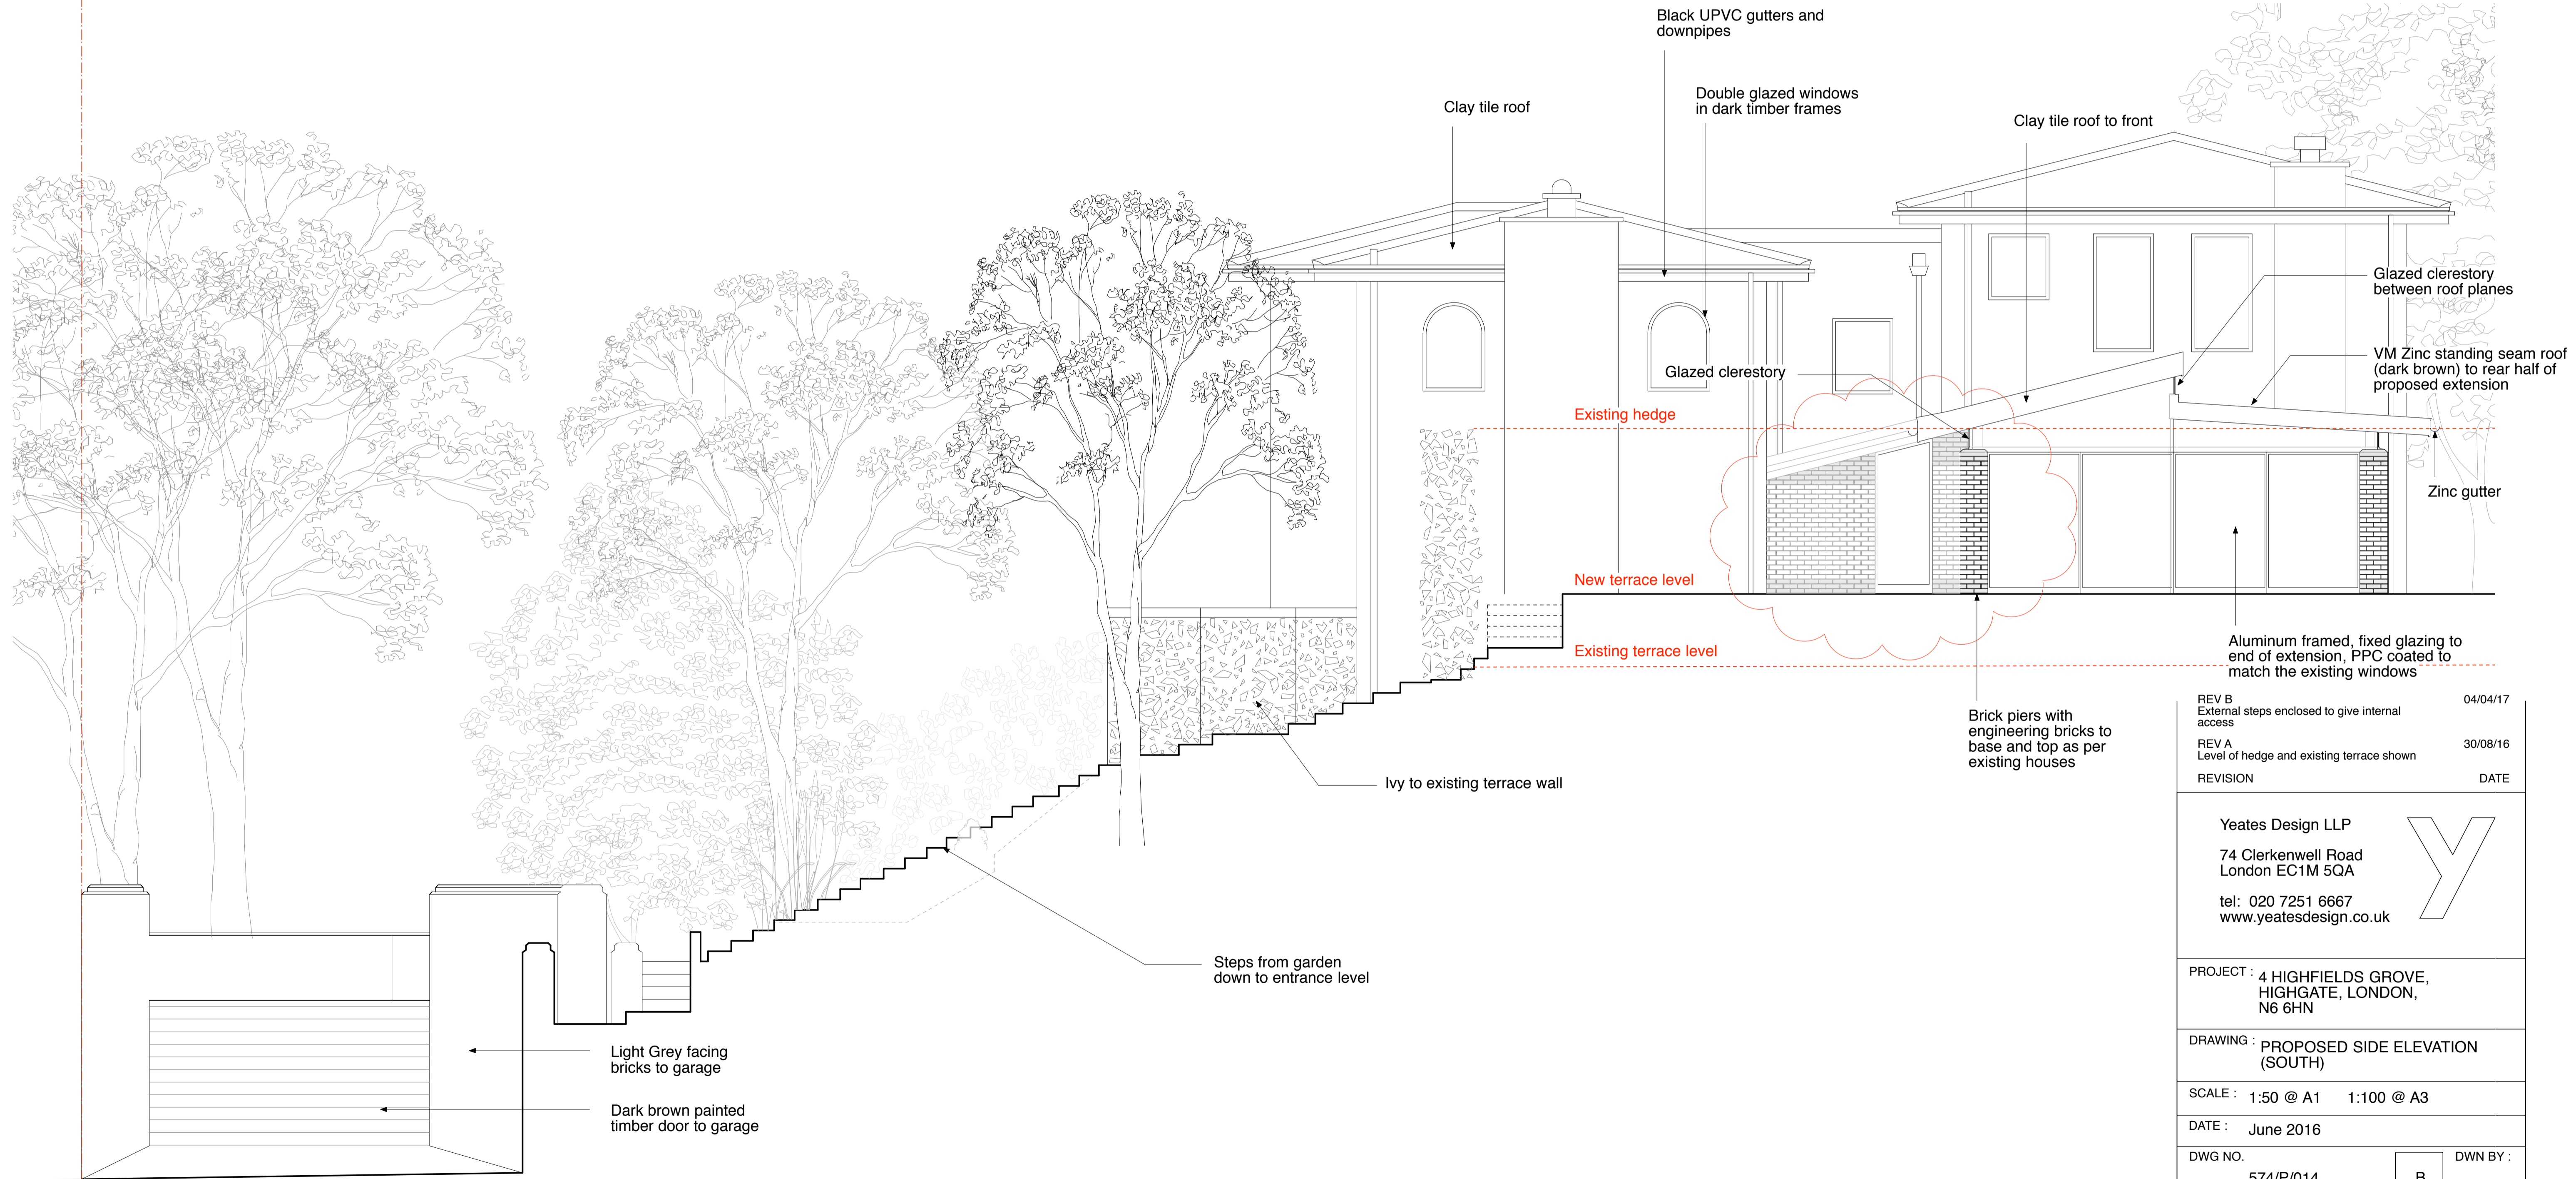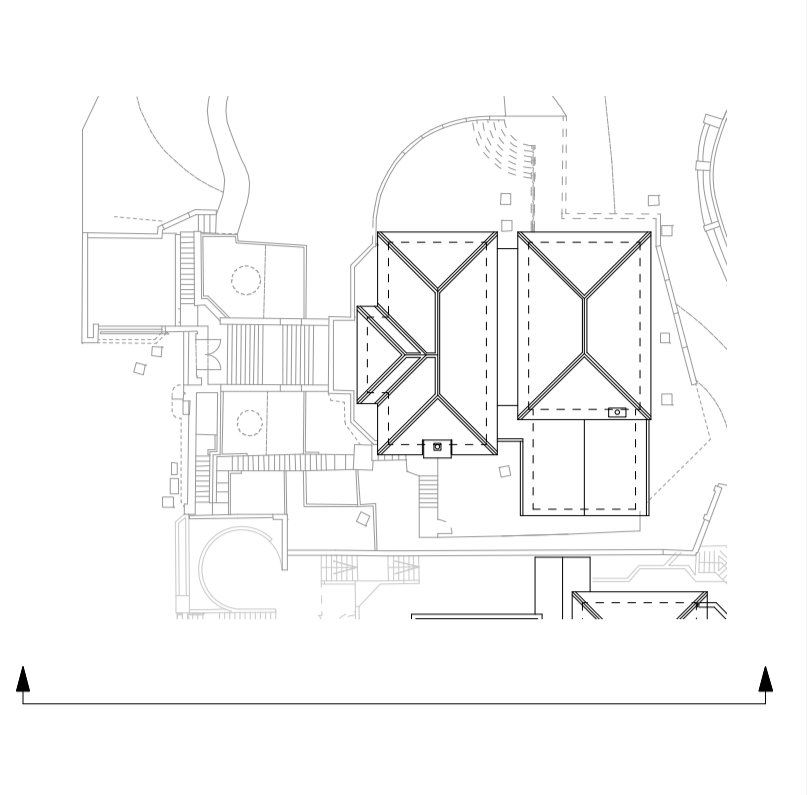

REV B	External steps enclosed to give internal access	04/04/17
REV A	Level of hedge and existing terrace shown	30/08/16
REVISION		DATE

Yeates Design LLP
 74 Clerkenwell Road
 London EC1M 5QA
 tel: 020 7251 6667
 www.yeatesdesign.co.uk

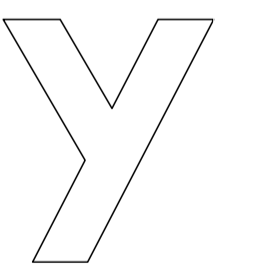

PROJECT: 4 HIGHFIELDS GROVE, HIGHGATE, LONDON, N6 6HN

DRAWING: PROPOSED SIDE ELEVATION (SOUTH)

SCALE: 1:50 @ A1 1:100 @ A3

DATE: June 2016

DWG NO. 574/P/014 B DWN BY:

DRAWING STATUS: FOR TENDER
 FOR PLANNING FOR CONSTRUCTION

INFORMATION CONTAINED IN THIS DRAWING IS THE SOLE COPYRIGHT OF YEATES DESIGN LLP AND SHOULD NOT BE REPRODUCED WITHOUT THEIR PERMISSION

4 Highfields Grove

0 0.5m 1m 2m