



'As built' Floor Plan:

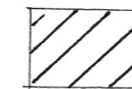

Areas shaded are where walls are constructed

Notes: all walls built are 'non load' bearing

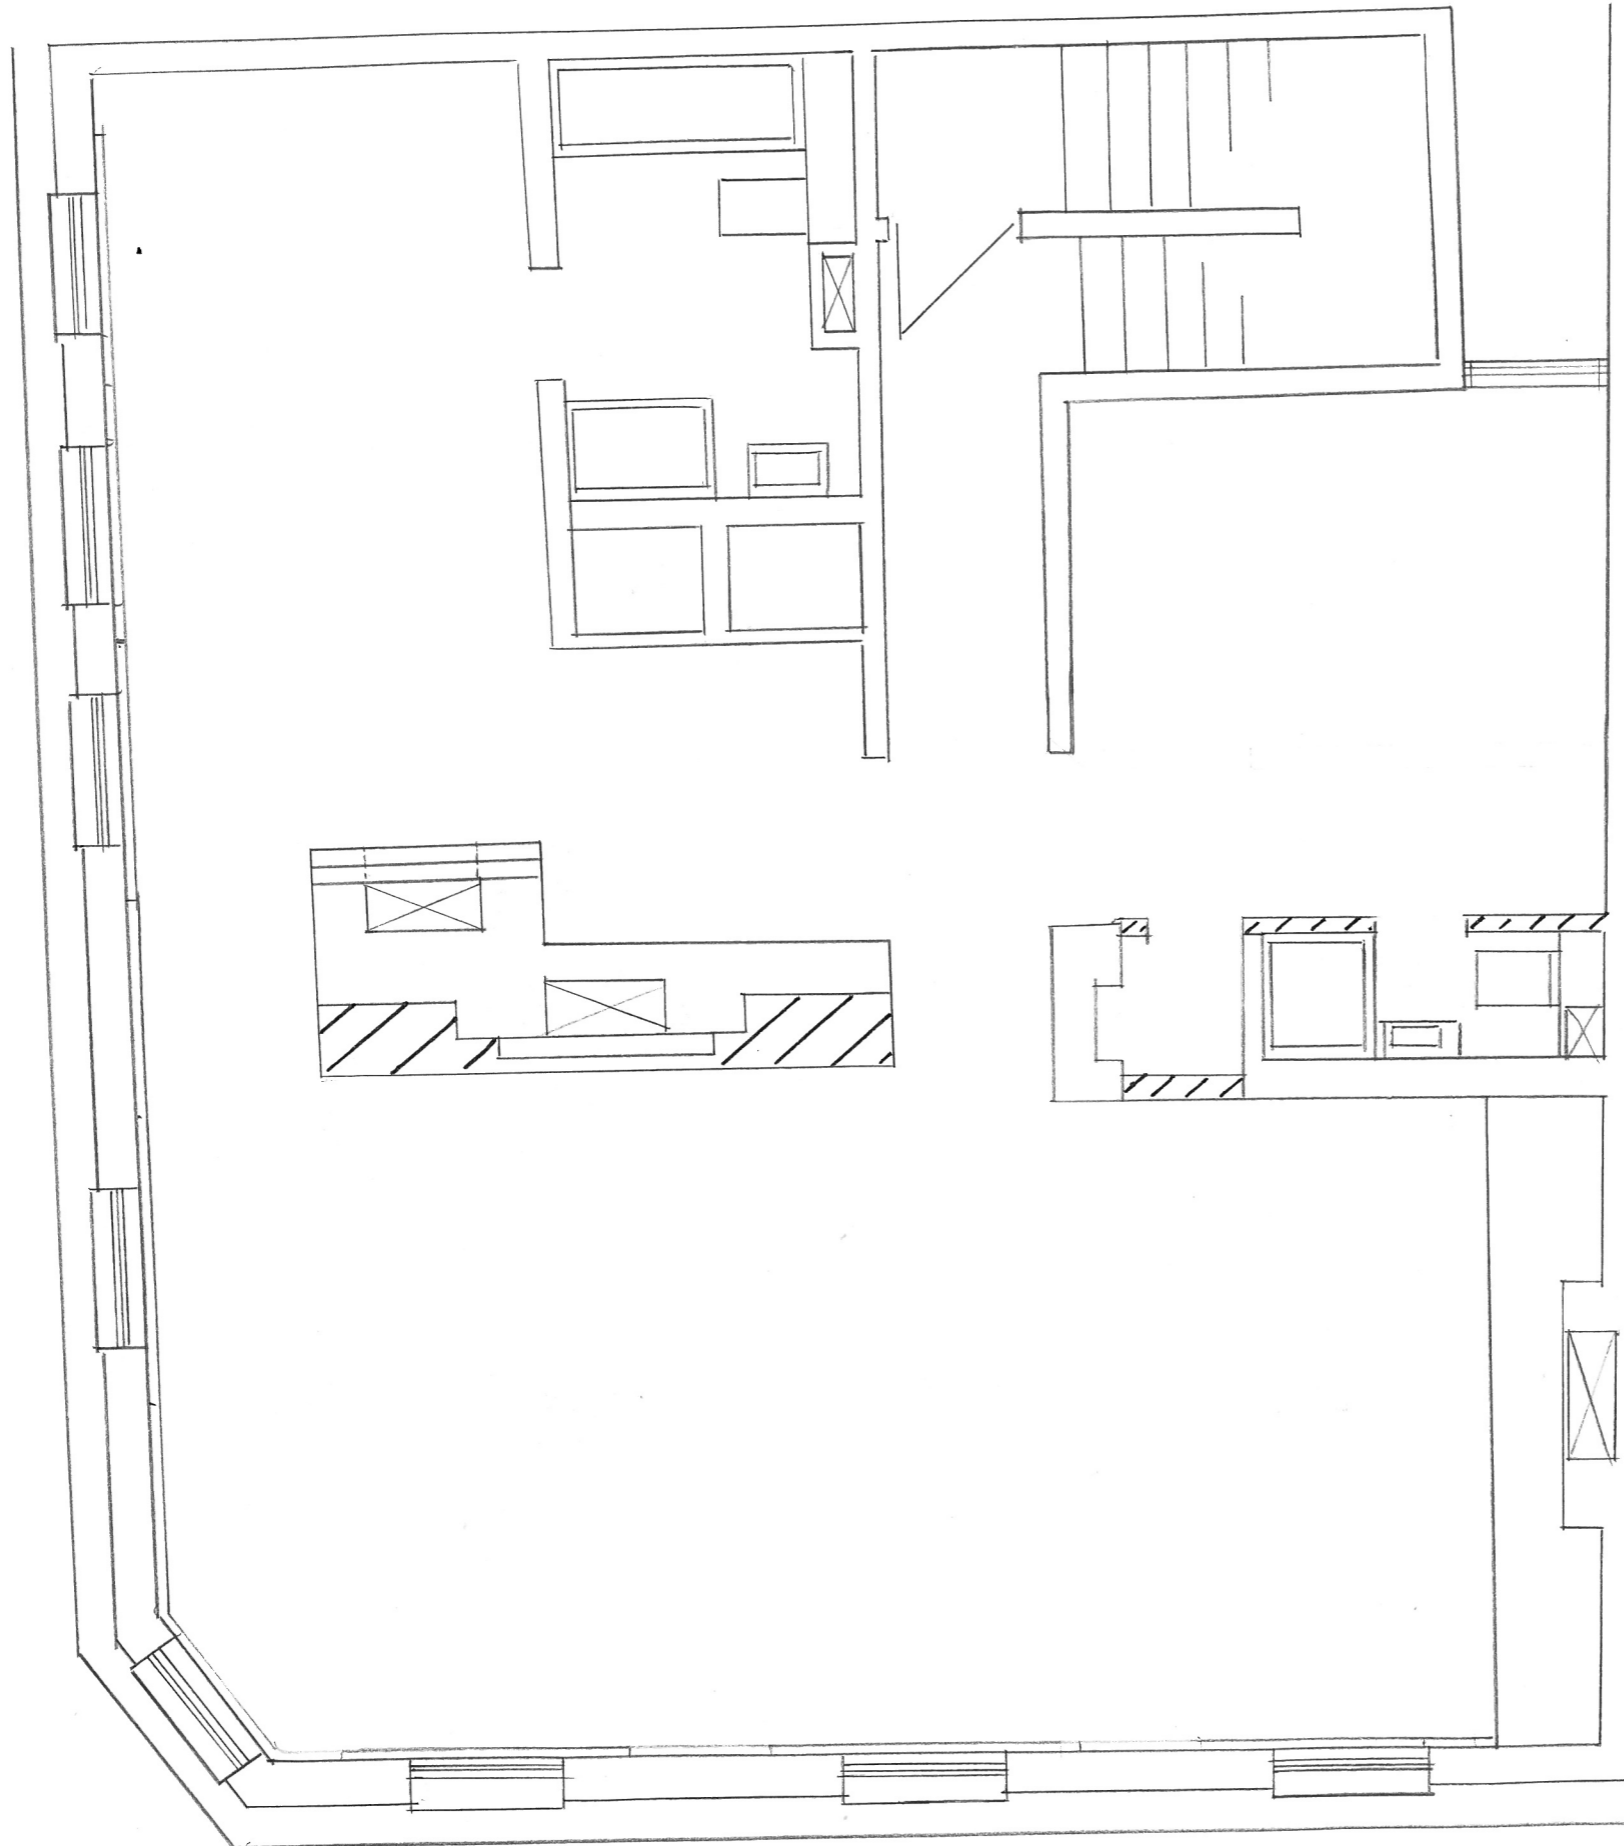

North



Drawing Title: Intervention plan / construction		Alex Sargeson 07447082328
Project: Flat 3, 34 Museum St. London. WC1A 1LH.		
Scale: 1:50	Date: 020317	Drawn by: AS
Drawing Number: 004		