
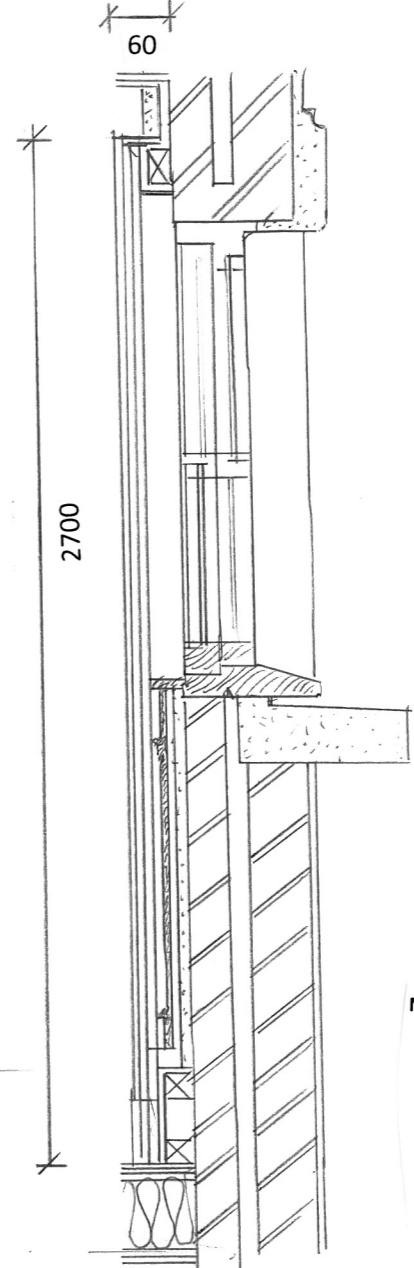
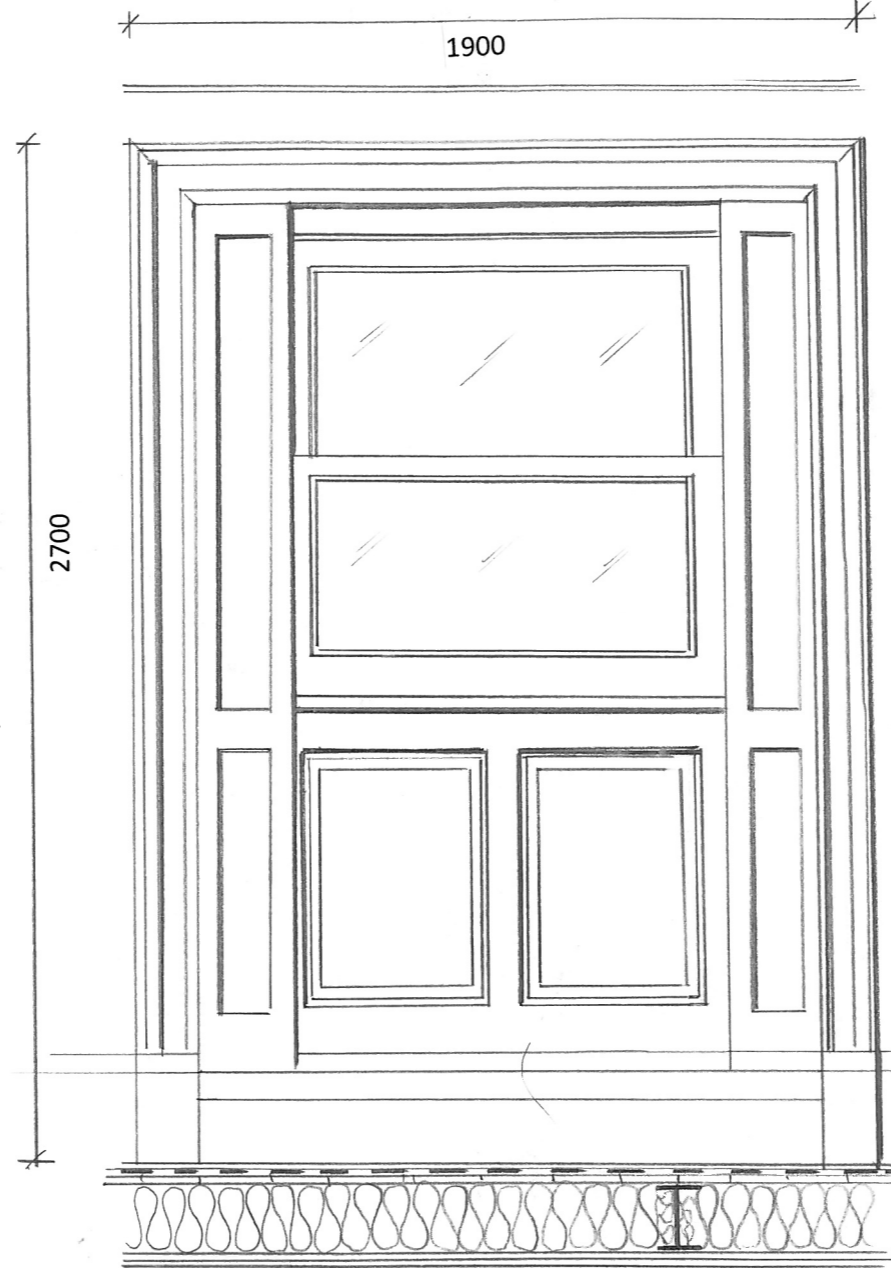
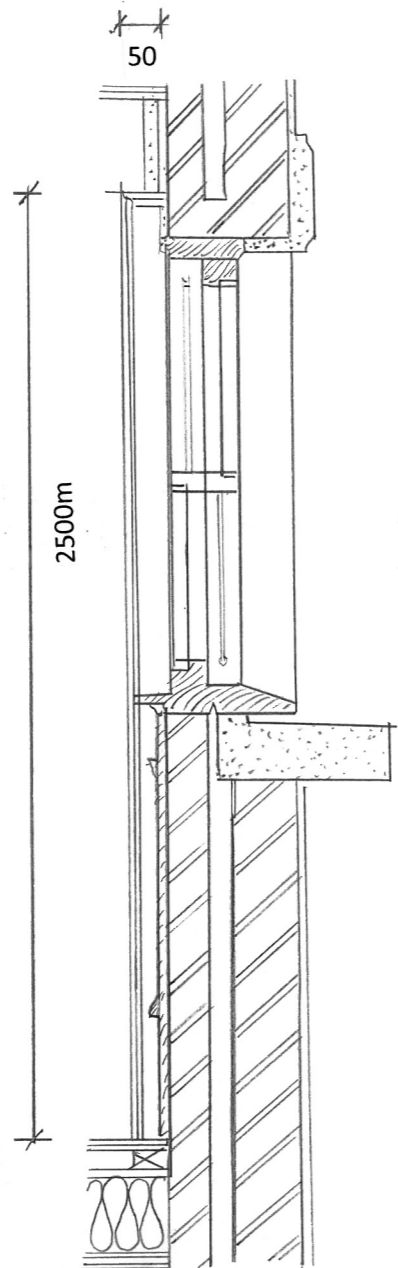


Pre existing Elevation

As Built Elevation:

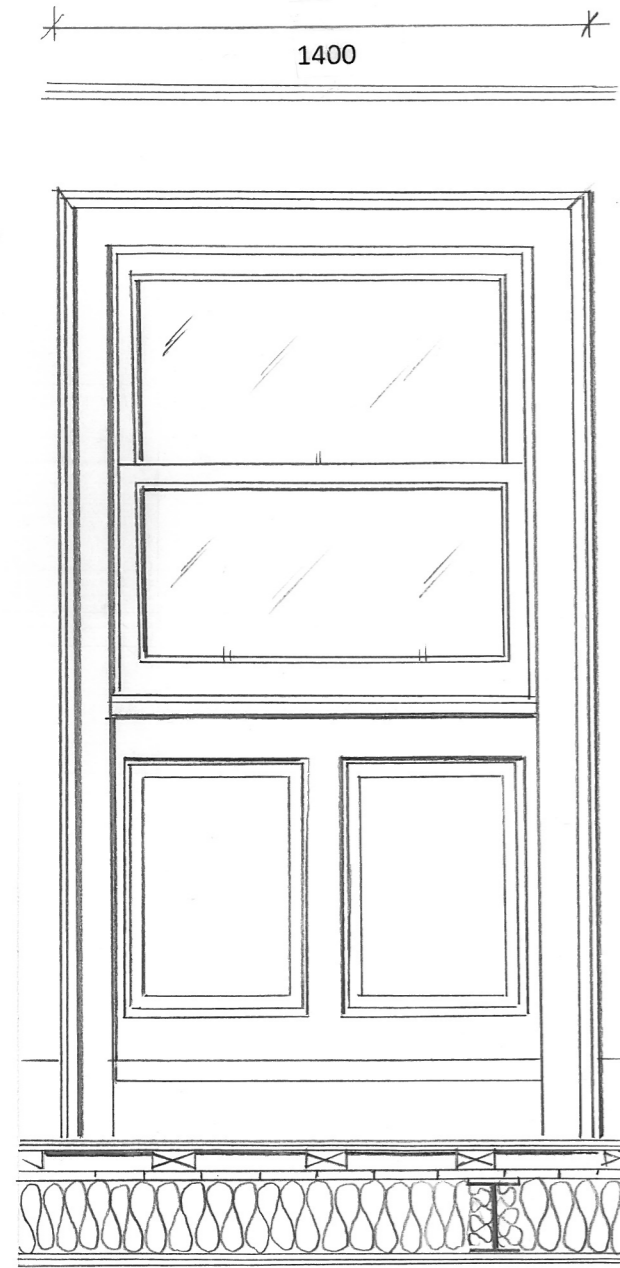


Elevation

Section

Elevation

Section

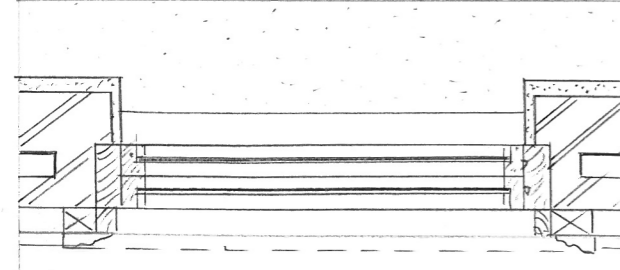


Plan




Plan

- Notes:**
- Shutters and panelling added to perimeter windows
 - All sash windows repaired and made good / weights adjusted
 - All glass protected / no glass replaced
 - 1993 timber moulding replaced like for like
 - Casements cannot be seen from road

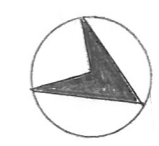

North

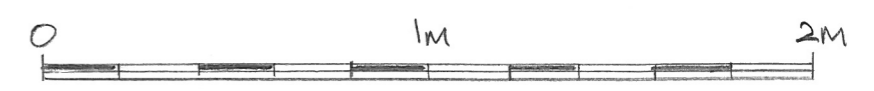

Drawing Title: Window casement INTERNAL			Alex Sargeson 07447082328
Project: Flat 3, 34 Museum St. London. WC1A 1LH.			
Scale: 1:20	Date: 020317	Drawn by: AS	
Drawing Number: 006			