
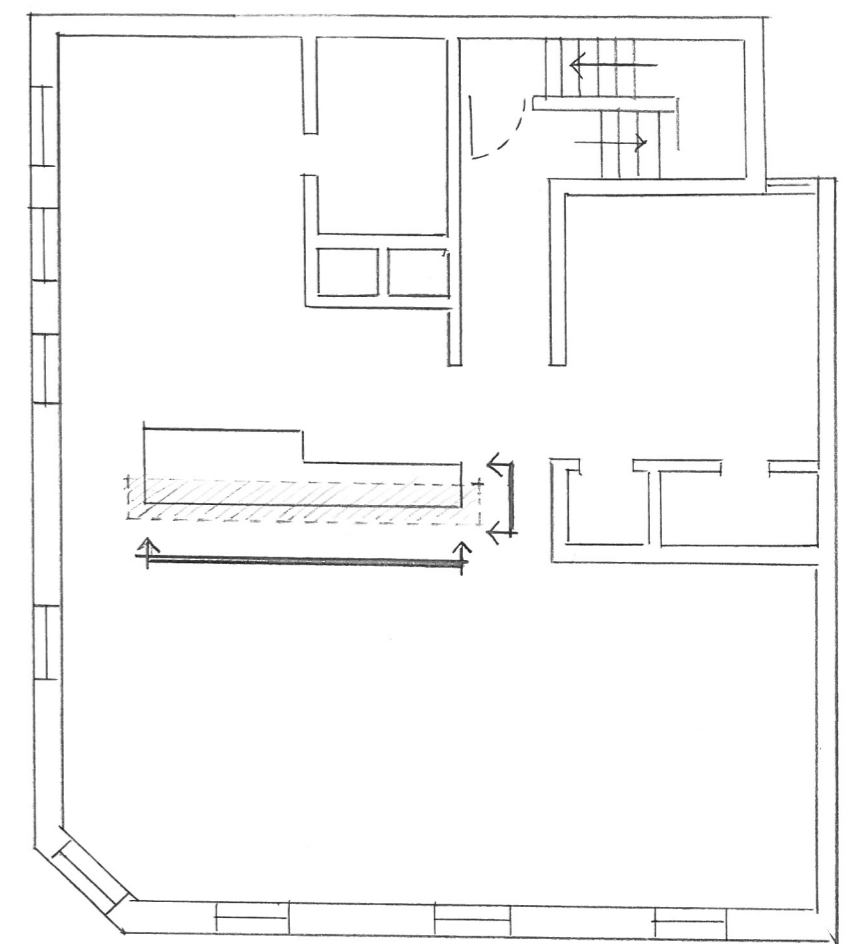



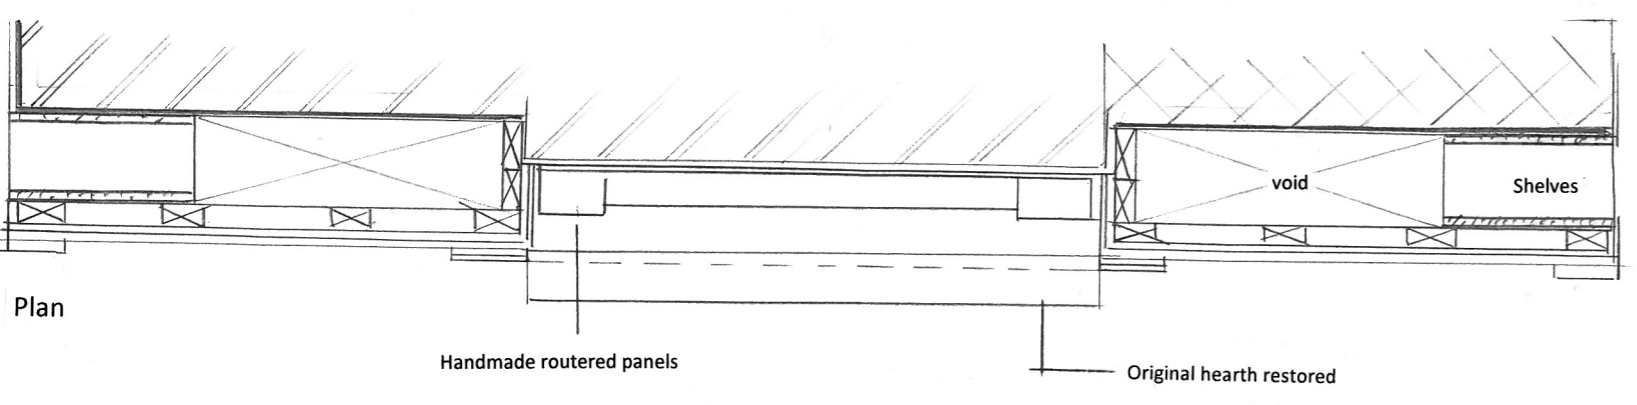
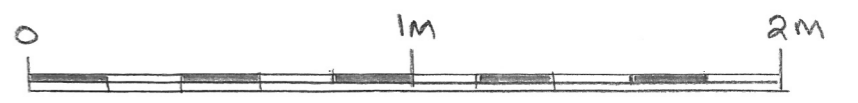
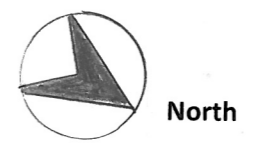
As Built Elevation:

Reference Plan:

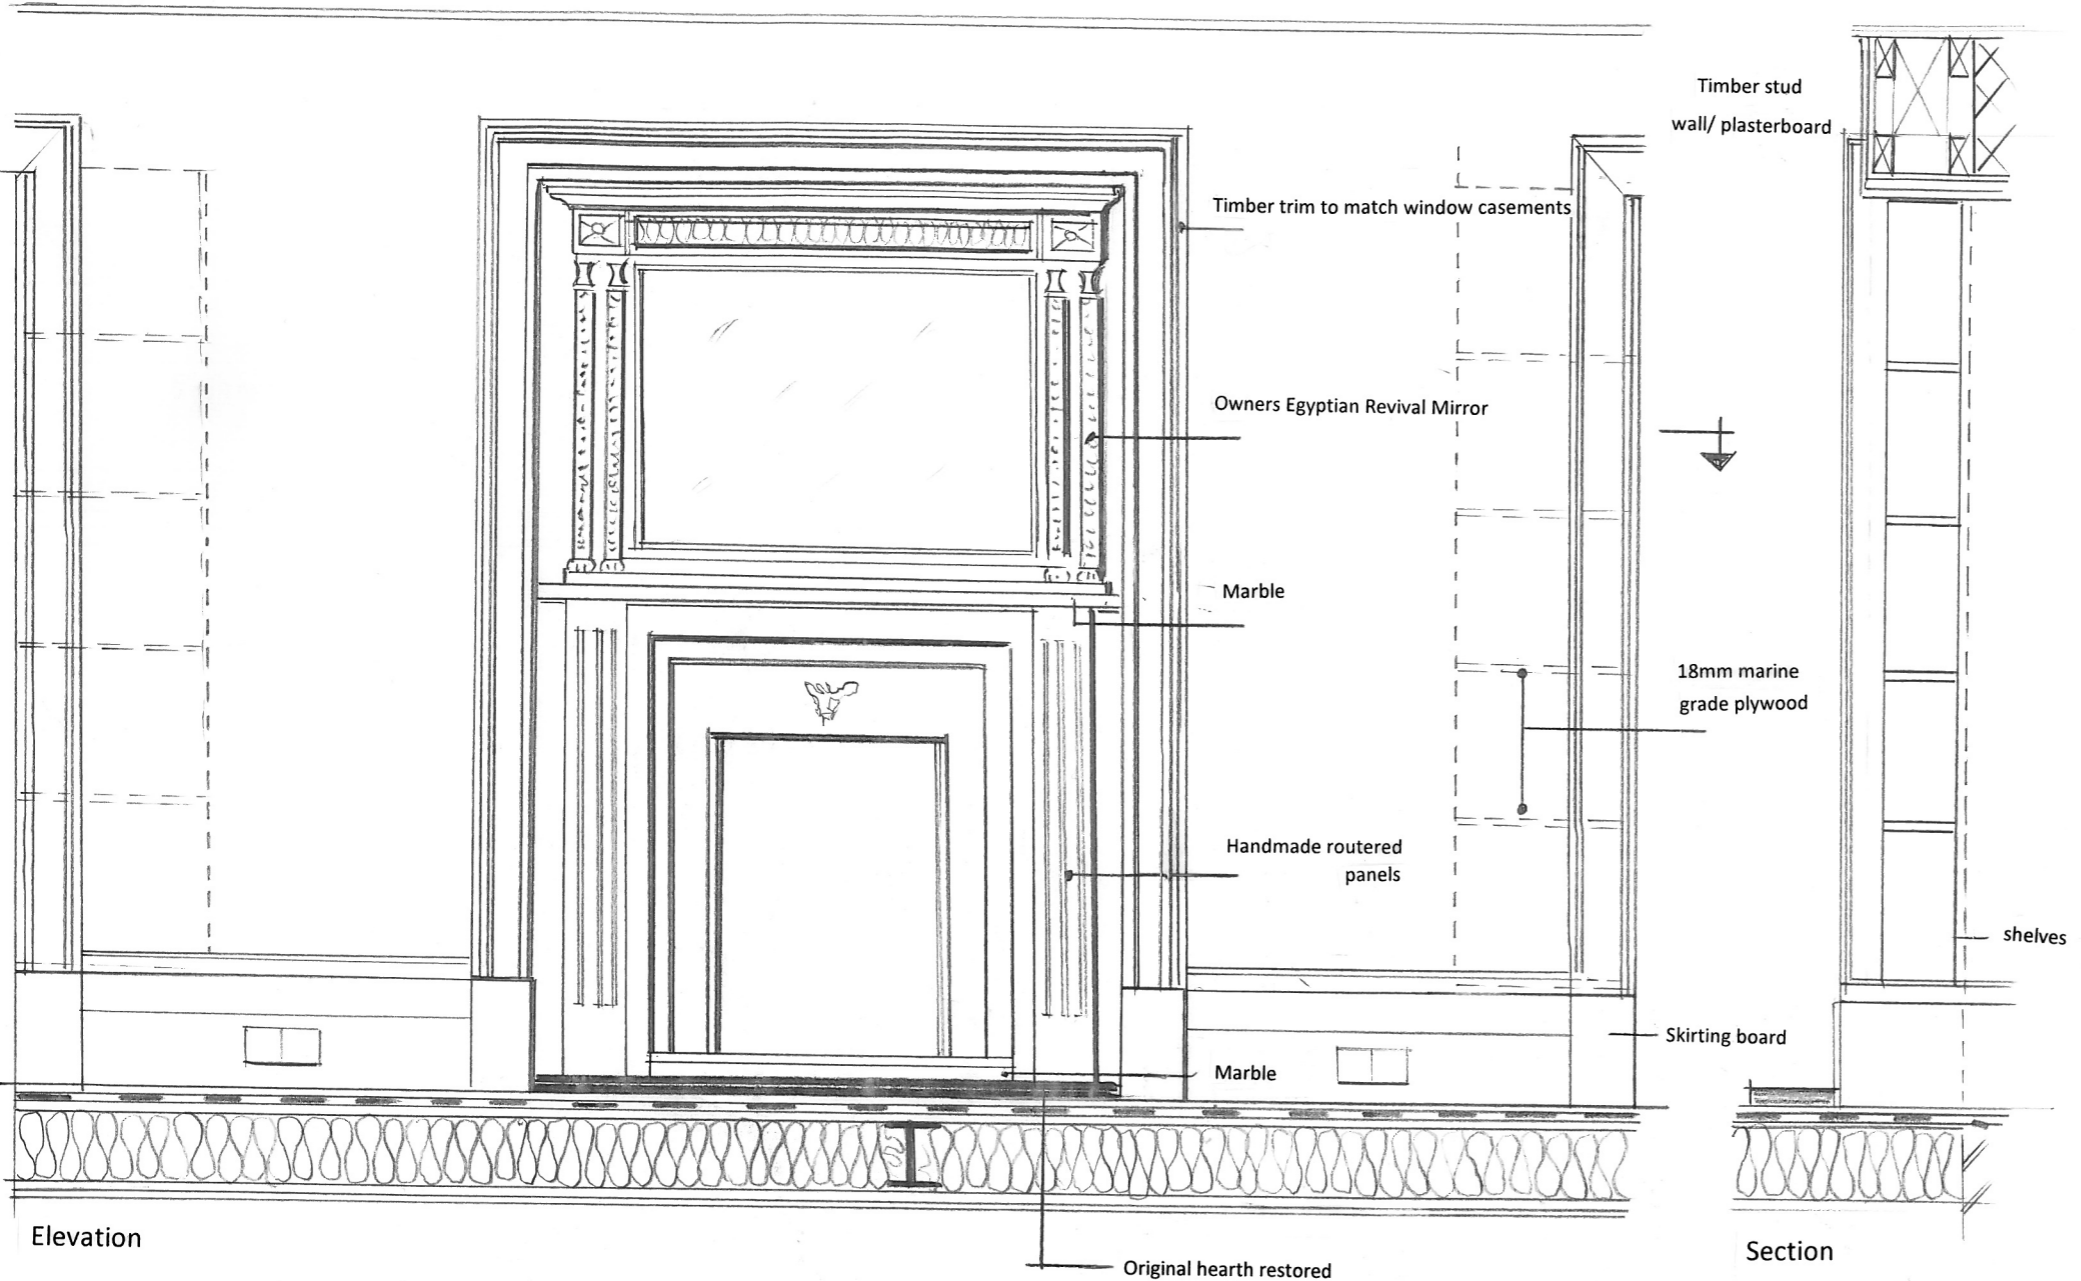

 Location of topic of drawing

Notes: Fireplace is not a real fire.



Plan

Section

Drawing Title: Fireplace		Alex Sargeson 07447082328
Project: Flat 3, 34 Museum St. London. WC1A 1LH.		
Scale: 1:20/1:200	Date: 020317	Drawn by: AS
Drawing Number: 010		