




Pre Existing

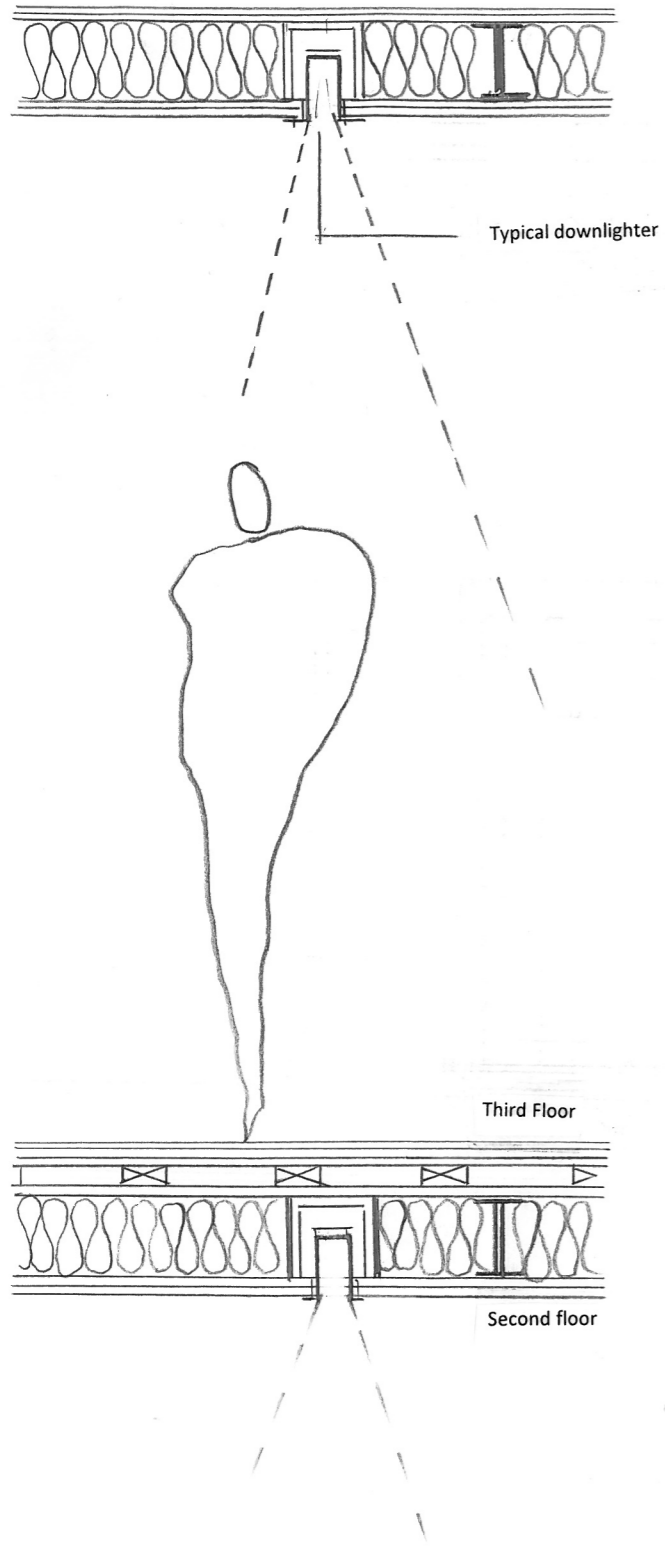


As built

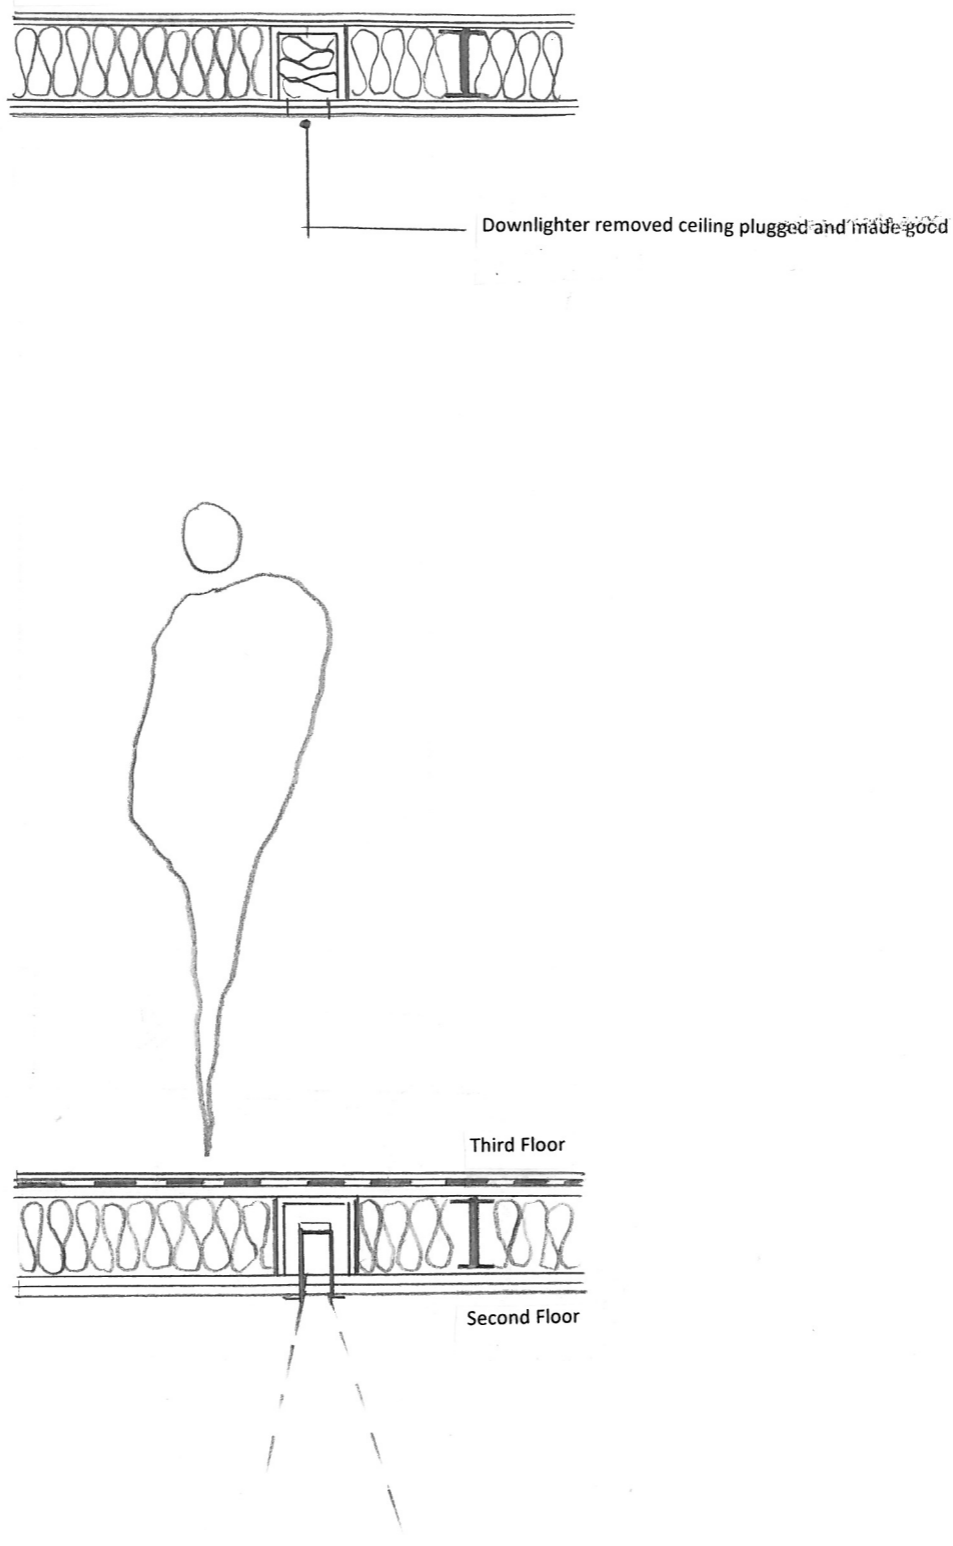


Reference Plan:

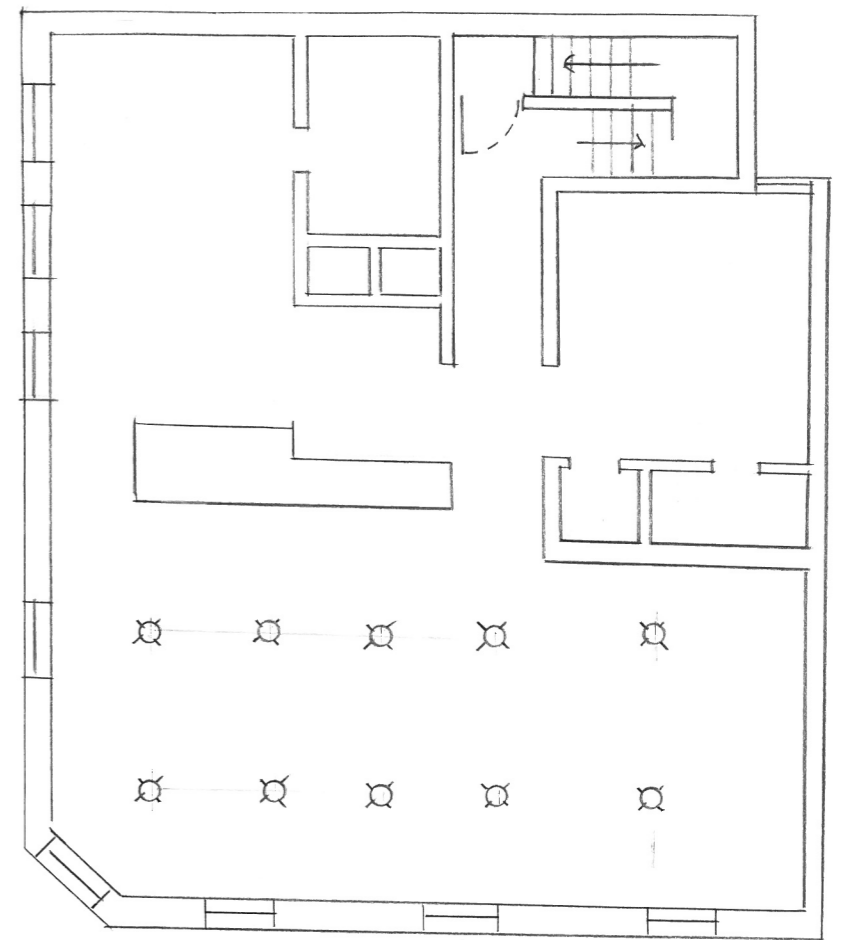

Ceiling: Downlighters locations

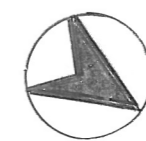

North

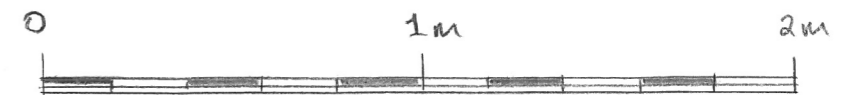

Drawing Title: Ceiling: Downlighters removed			Alex Sargeson 07447082328
Project: Flat 3, 34 Museum St. London. WC1A 1LH.			
Scale: 1:20/1:200	Date: 020317	Drawn by: AS	
Drawing Number: 011			