
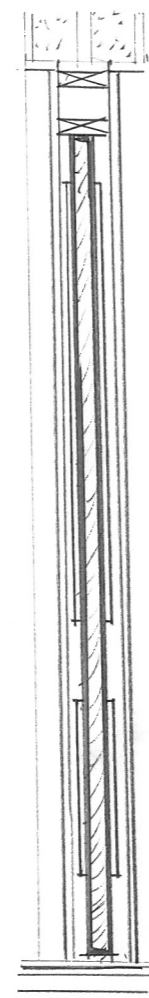



1120 Structural opening

Pre Existing Internal Door

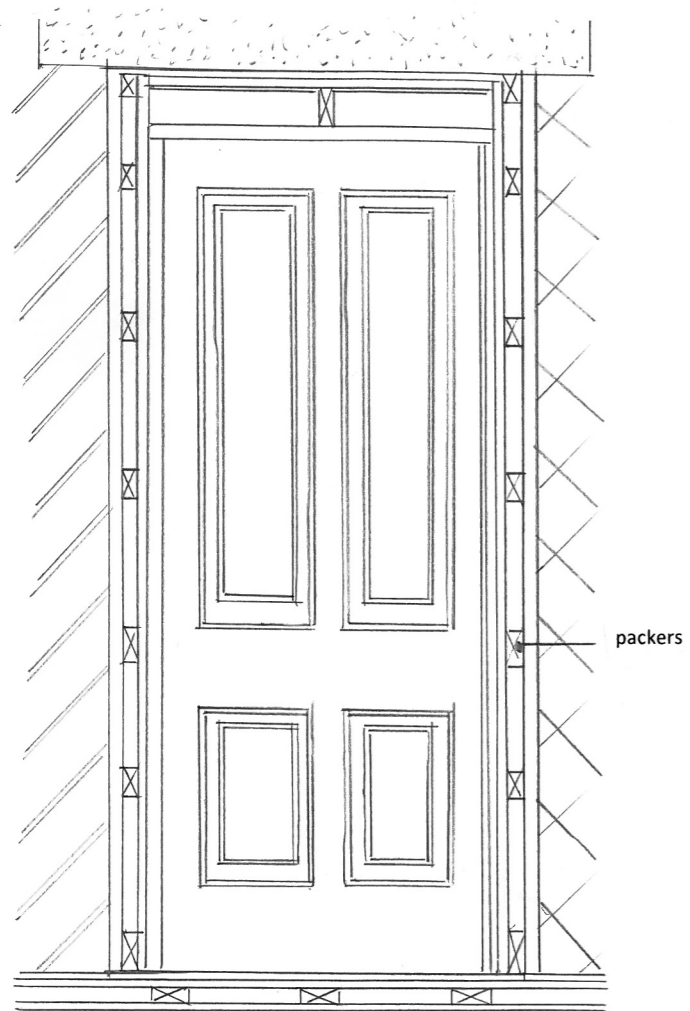


1120 Structural opening

As built Internal door

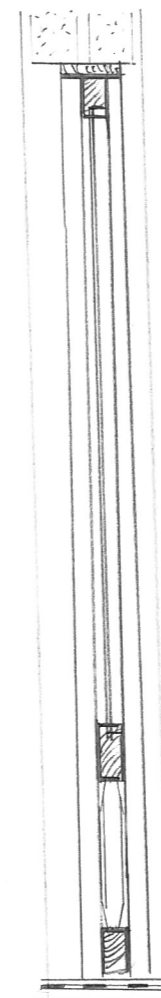


wheelchair / accessible opening

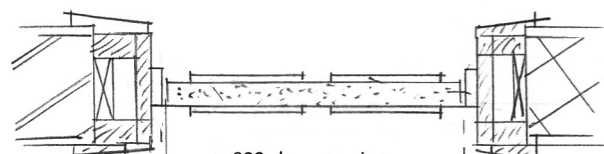

800 clear opening

1120 Structural opening

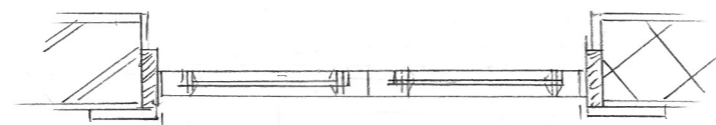


980 clear opening

1120 Structural opening


Notes:

- Pre existing softwood composite doors (with surface glued mouldings) and frames were removed.
- New frame to match actual opening sizes made and installed.
- Doors handmade and hung to allow maximum accessibility and transparency for owner


Reference Plan:

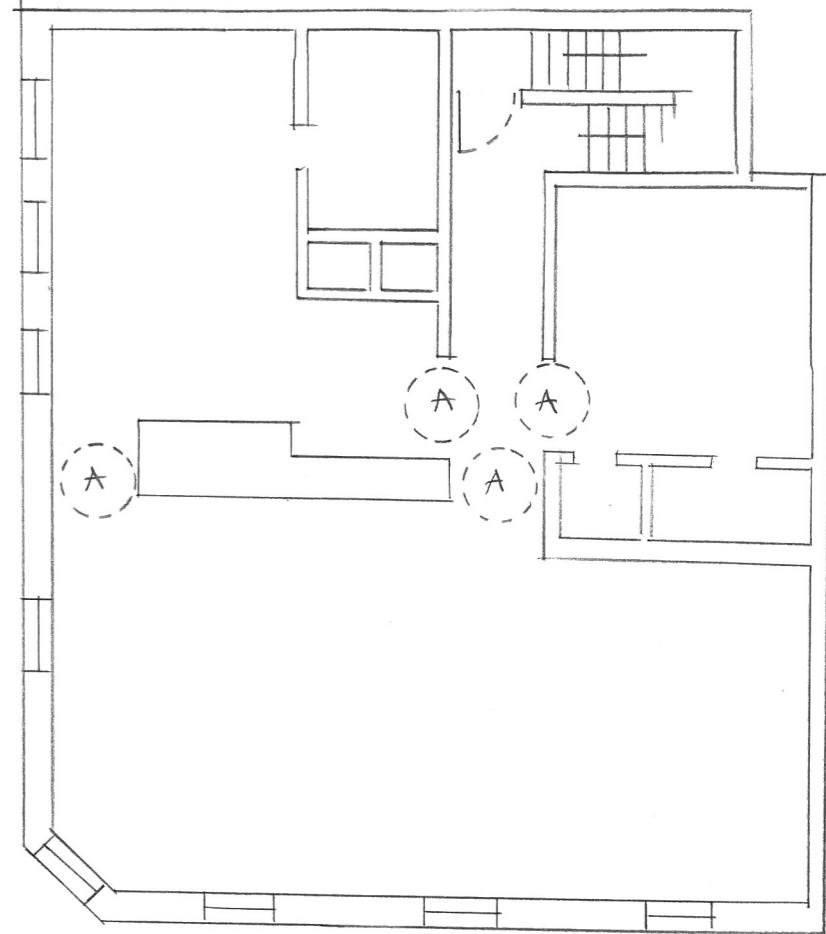

A Internal door locations

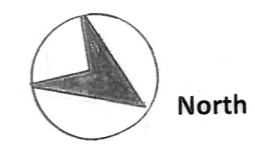

North

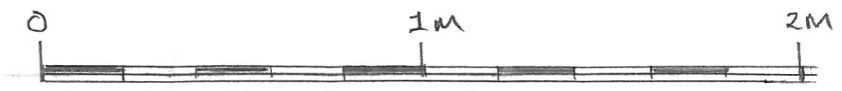

Drawing Title: Internal door replacement			Alex Sargeson 07447082328
Project: Flat 3, 34 Museum St. London. WC1A 1LH.			
Scale: 1:20/1:200	Date: 020317	Drawn by: AS	
Drawing Number: 012			