



EXTERIOR CHAIRS

460w 525d 855h powder coated metal framed chair in black with teak shaped slats inset and fixed along rear elevation & underside. slot dim 410x60. refer to nuts & bolts SD-200-10.



SMALL EXTERIOR TABLES

500w 500d 730h moulded hinge to table top allowing table to fold away for ease of storage. stainless steel table support & base, rubber stoppers to feet. tops pastel grey laminate with black profile. ref. Irespa exterior grade A.03.1.0 refer to nuts & bolts SD-200-12.




SEATING BALUSTRADES

1500 wide with logo applied by AEL Leisure Ltd nuts & bolts SD-200-13. Free standing branded canvas balustrades on weighted aluminium posts.

FURNITURE : TOTAL COVERS = 30 No.
 exterior furniture to be brought in to store outside trading hours

| | | | |
|--|--|--|---|
| | SMALL EXTERIOR TABLES - 15no. refer to adjacent details. | | SEATING BALUSTRADES - 07no. refer to adjacent details. 4no with logos applied where shown |
| | EXTERIOR CHAIRS BLACK - 30no. refer to adjacent details. | | |

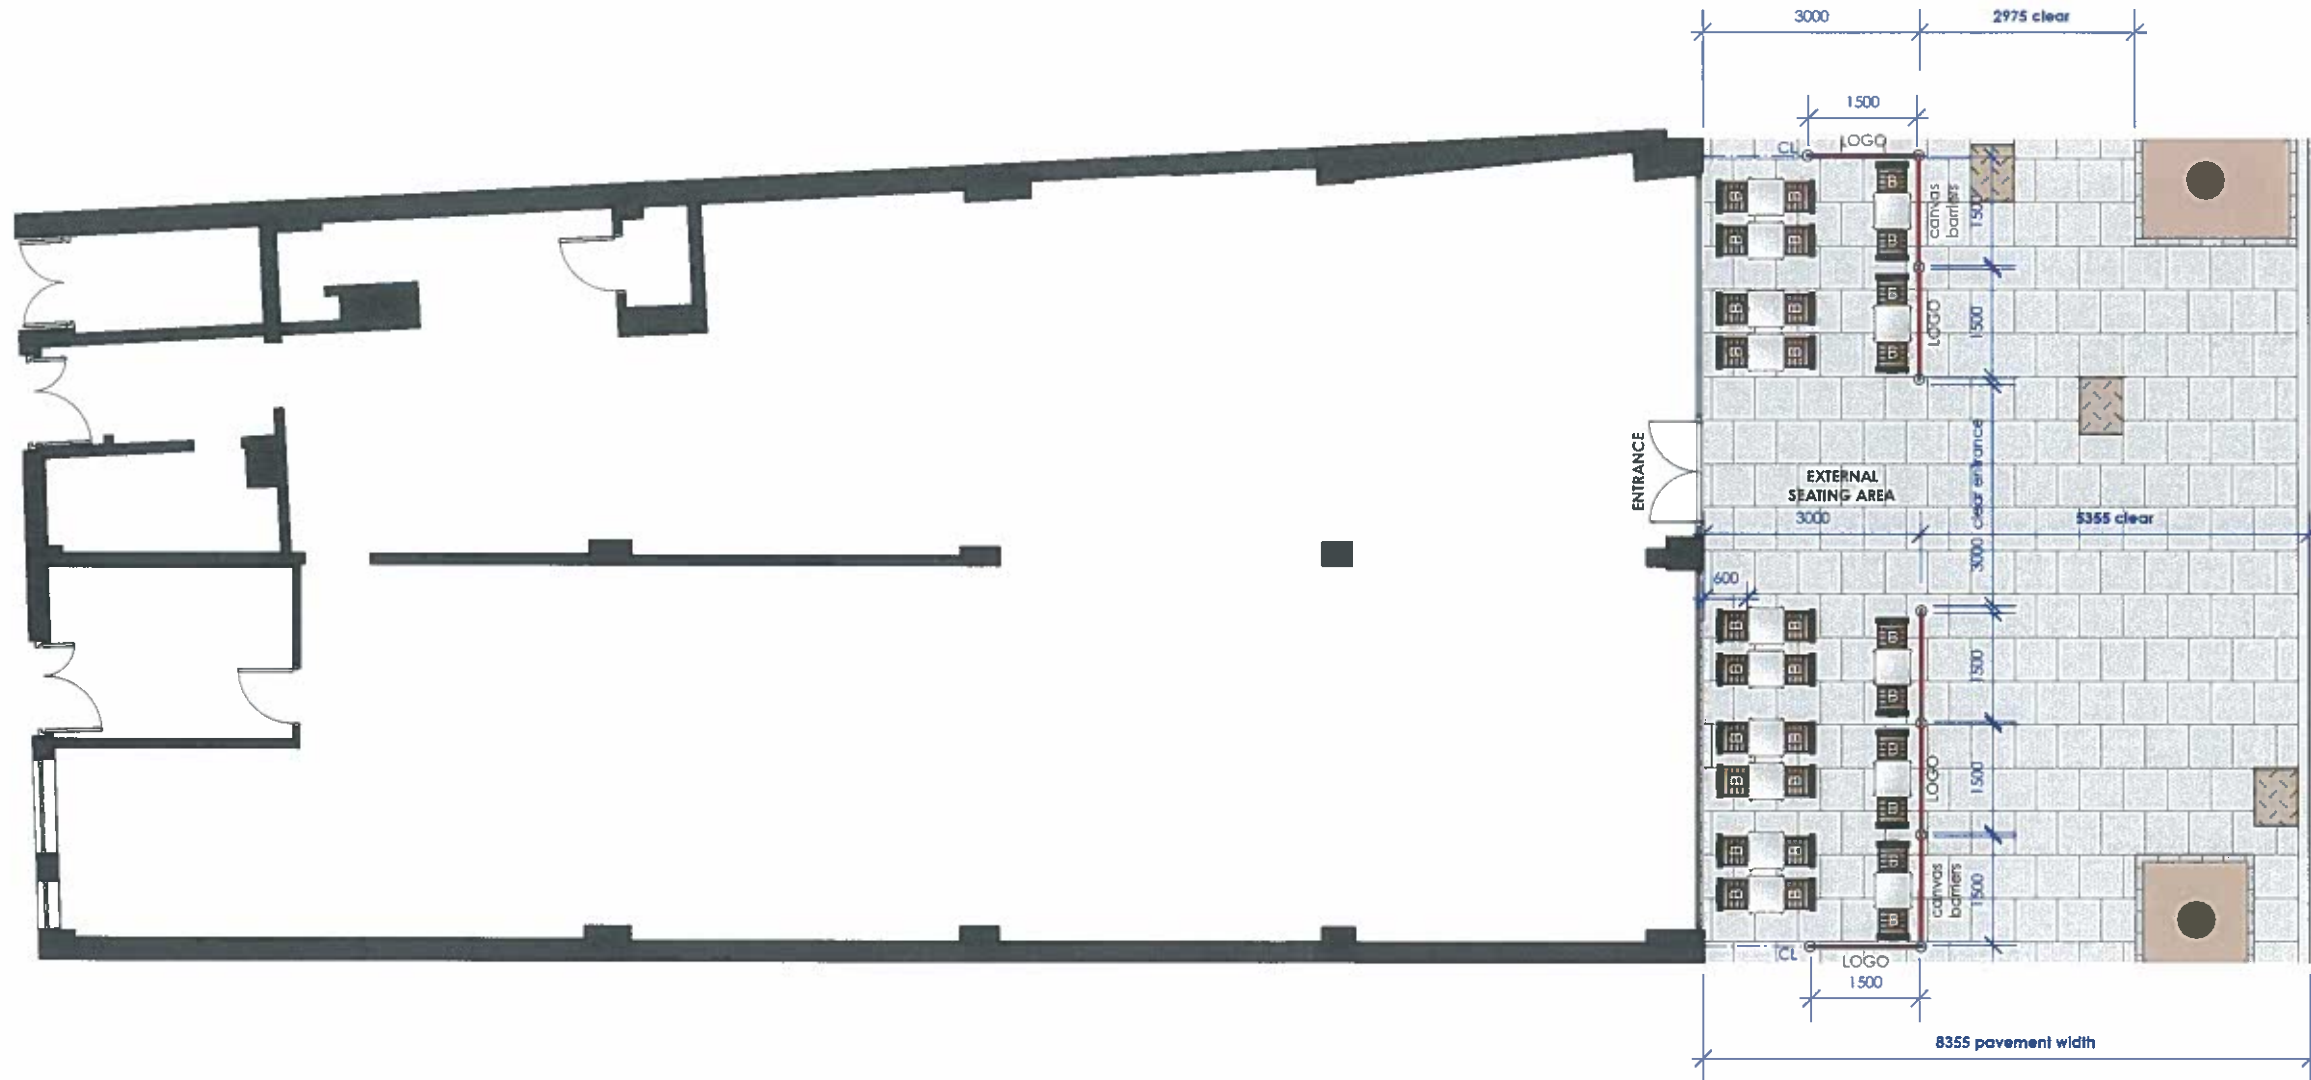

REVISIONS

PROJECT
★ PRET A MANGER ★

LOCATION
 100 Tottenham Court Road
 LONDON W1T 4TT

TITLE
 proposed
 external seating plan

DRAWING No.
 TD12-PM15-02

REVISION DATE SCALE A3
 AS BUILT 08.05.15 1:100

TANNERdesign
 2b/4b gosport street lynton hampshire SO41 9BE
 TEL 01590 689609 EMAIL studio@tannerdesign.co.uk

please do not scale from this drawing
 all dimensions to be confirmed on site by contractor
 all elements to comply with statutory requirements
 copyright TANNERdesign limited