




42 - 40.

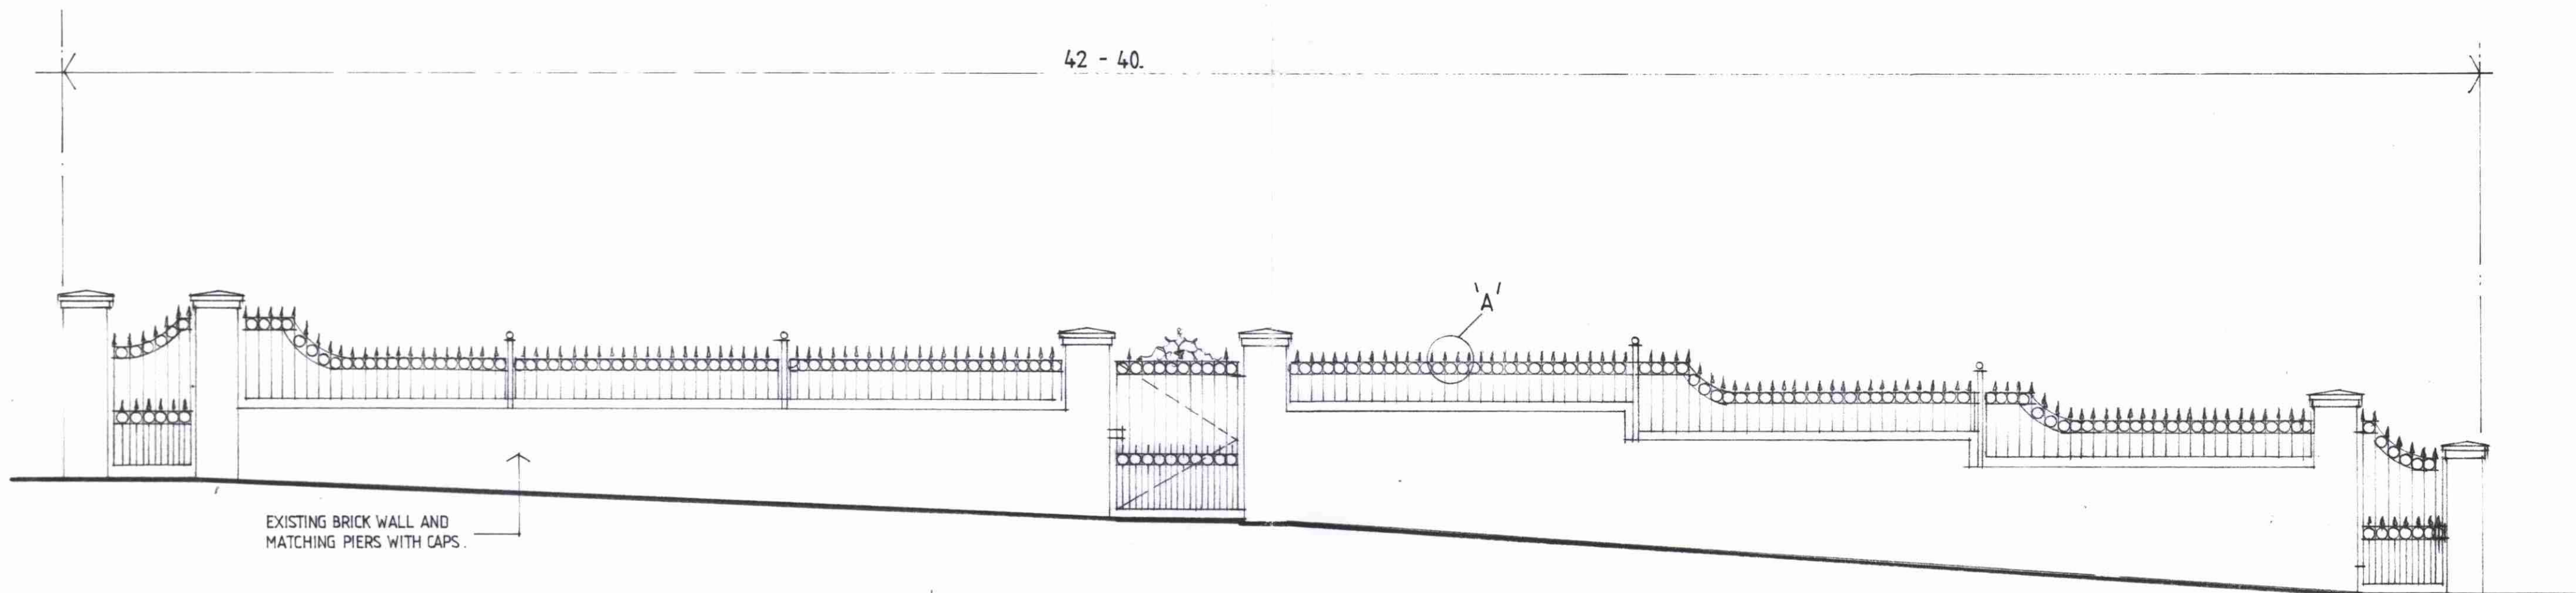

ELEVATION AS BUILT VIEW TO FITZJOHNS AVE.

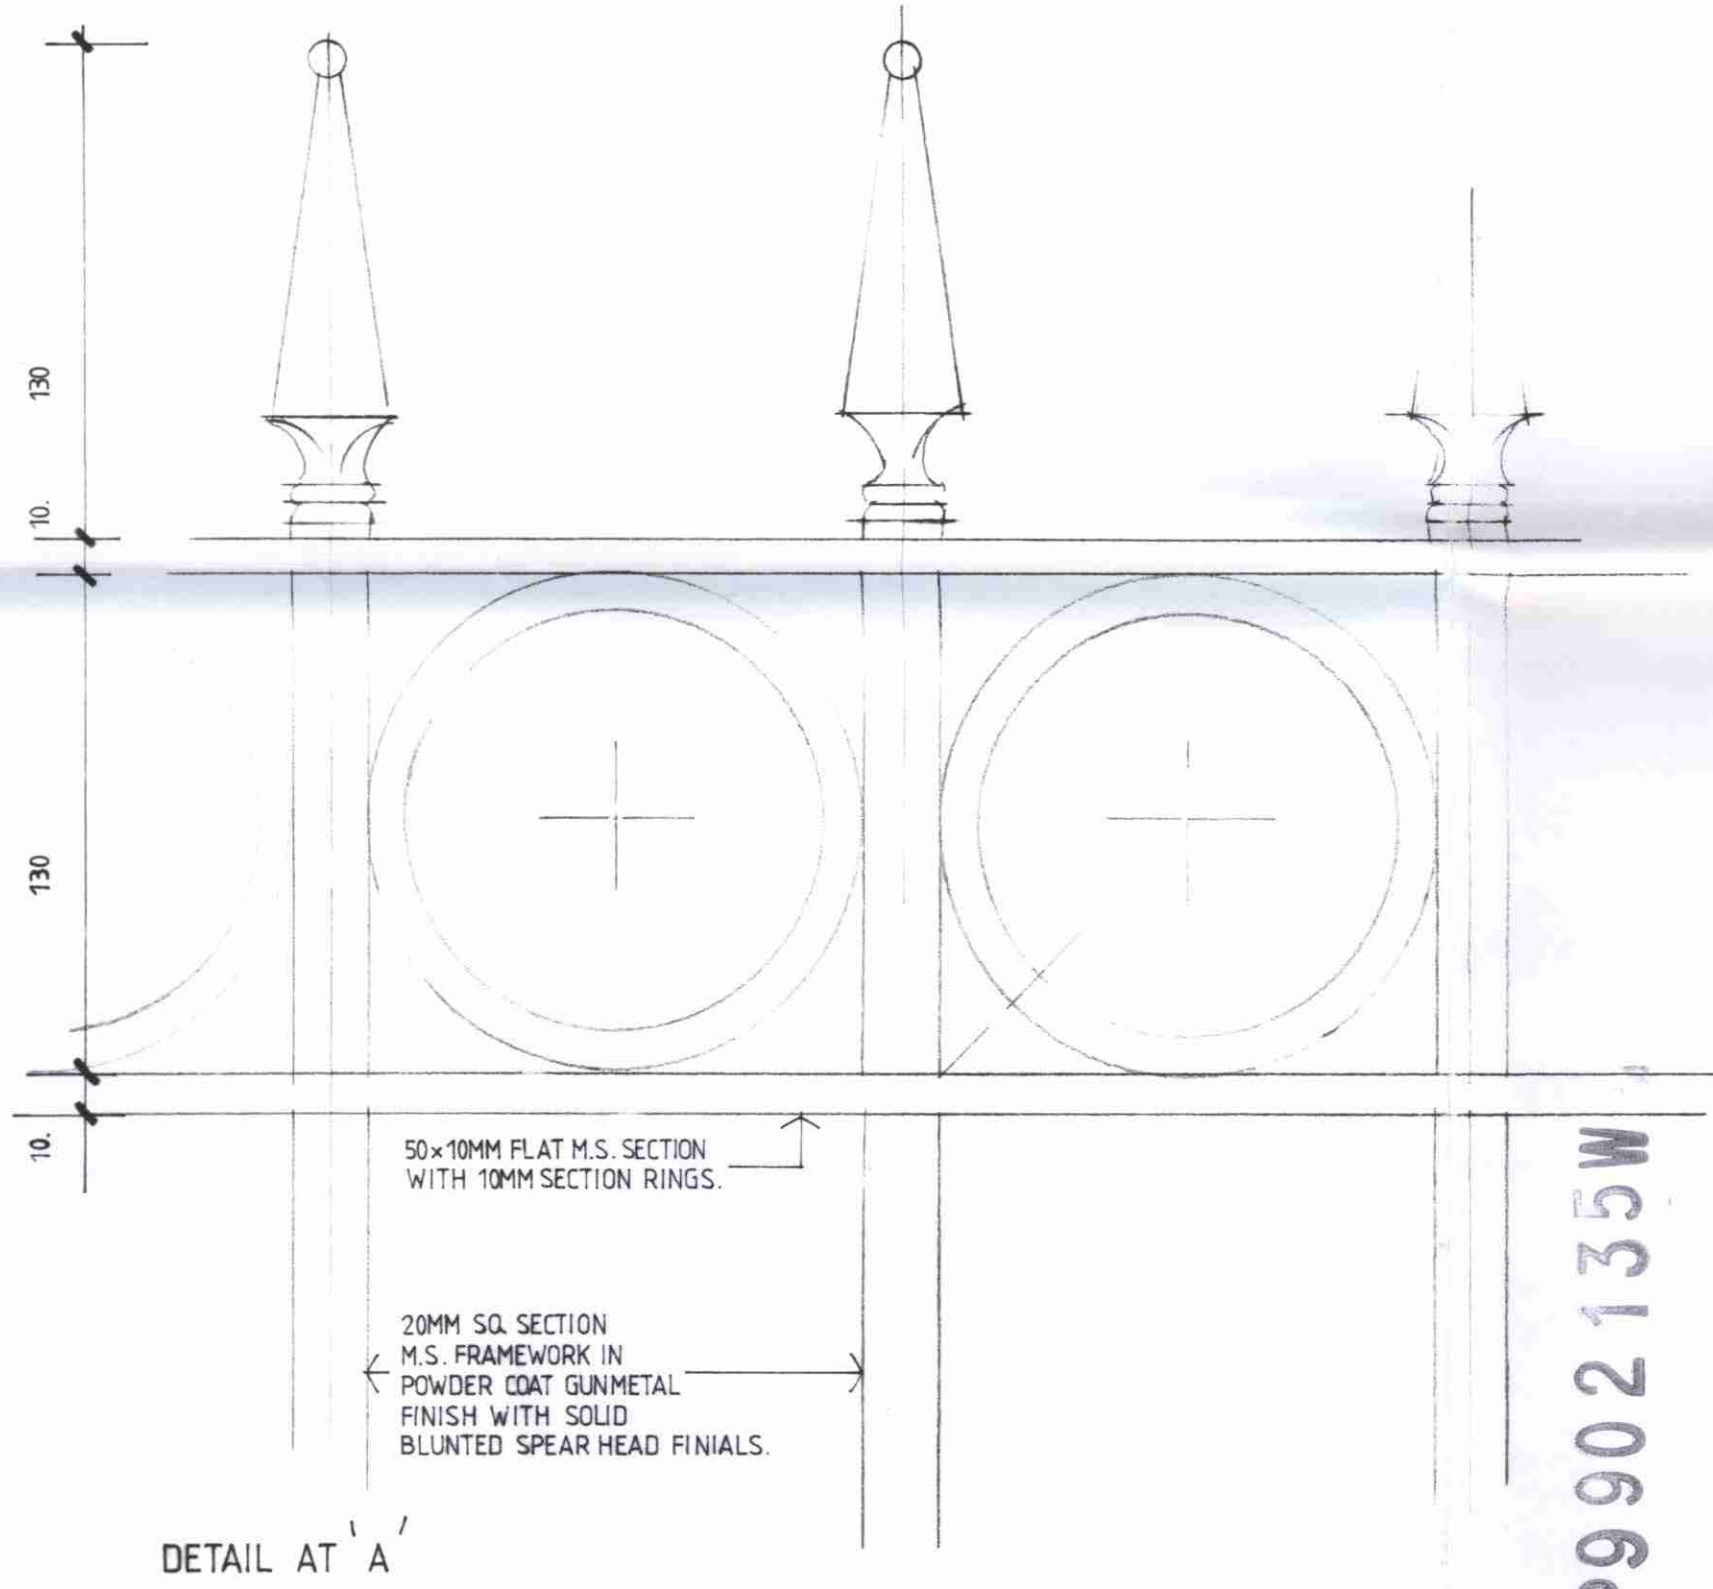

P9902135W

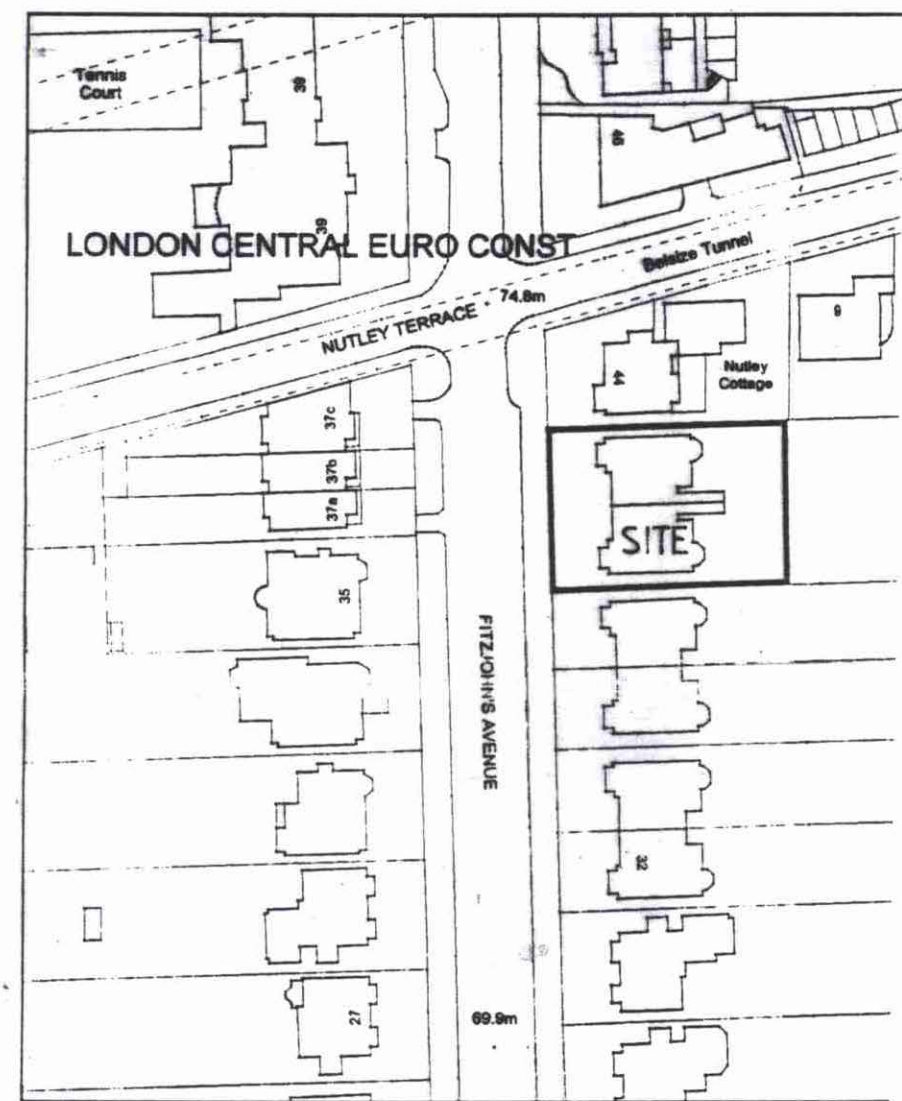

MICHAEL MILLER ASSOCIATES

CHARTERED ARCHITECTS & CONSULTANT DESIGNERS

69 MULBERRY WAY
SOUTH WOODFORD LONDON E18 1EE
40-42 FITZJOHNS AVENUE
HAMPSTEAD NW3
FOR K.F. PROPERTIES.

EXTERNAL RAILINGS.

SCALE : 1:50, 1:2
DATE : FEB 1999.

PROJECT NO	DRAWING NO	REVISION
1441	106.	

THIS DRAWING IS COPYRIGHT
NO DIMENSIONS SHOULD BE SCALED FROM THIS DRAWING
ALL STATED DIMENSIONS SHOULD BE VERIFIED ON SITE BEFORE COMMENCING WORK OR PREPARING SHOP DRAWINGS

International 44 181 530 4167.
Telephone : 0181 530 4167
Fax: 0181 530 4167

