


LOWER GROUND FLOOR PLAN




GROUND FLOOR PLAN

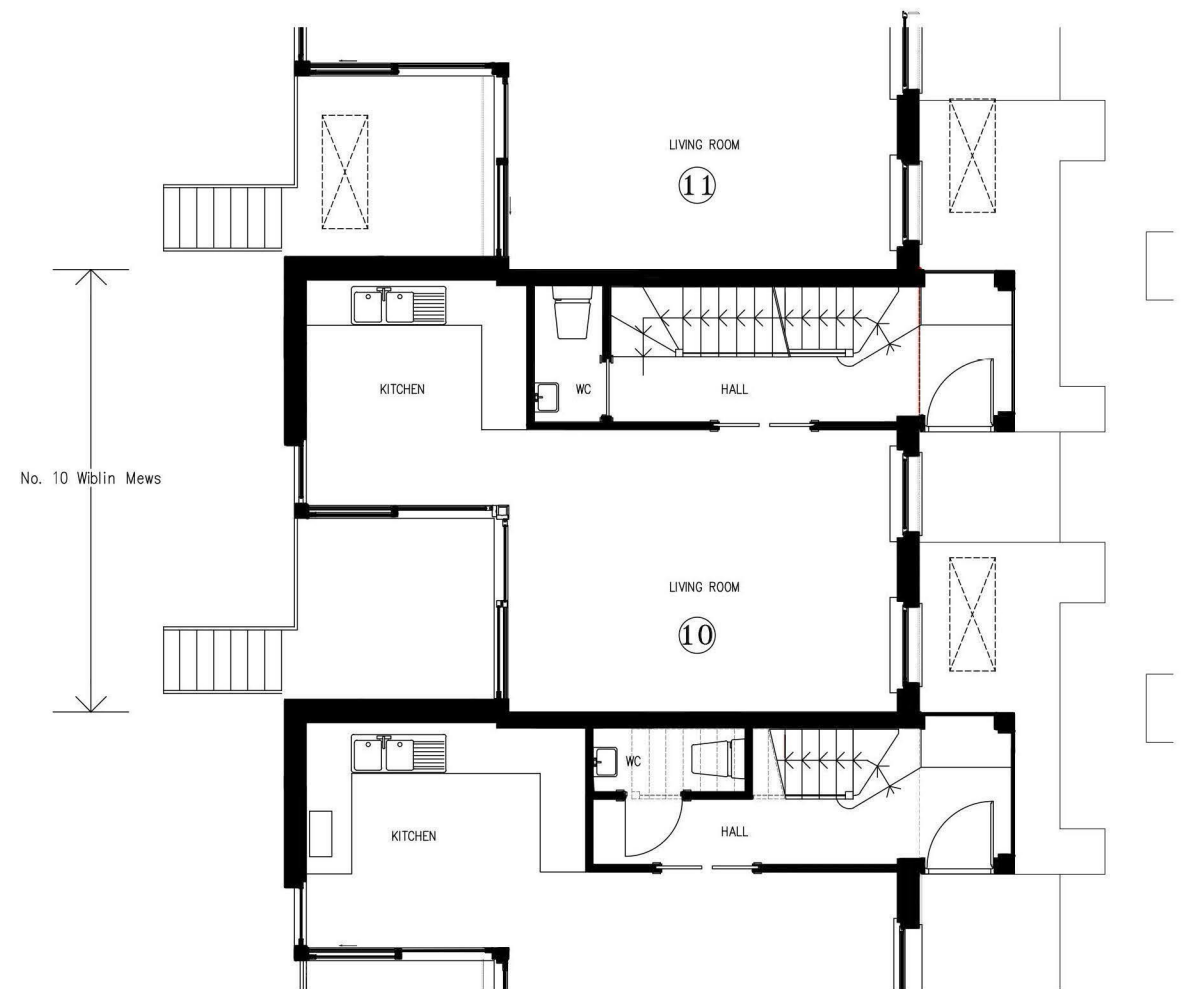


**Proctor Watts Cole Rutter**  
Chartered Architects & Town Planners

Grosvenor House, Bleke Street, Shaftesbury, Dorset, SP7 8AW.  
Phone: 01747 851881 Fax: 01747 851081  
mail@pwcr.co.uk www.pwcr.co.uk


Client: Mr A Desaraju		Drawn By: S Way
Dwg: 10, Wiblin Mews, Kentish Town		Checked By:
Job No: 4888	Dwg No: S02	Notes: As Built
Date: 31/03/2017	Scale: 1:100@A3	

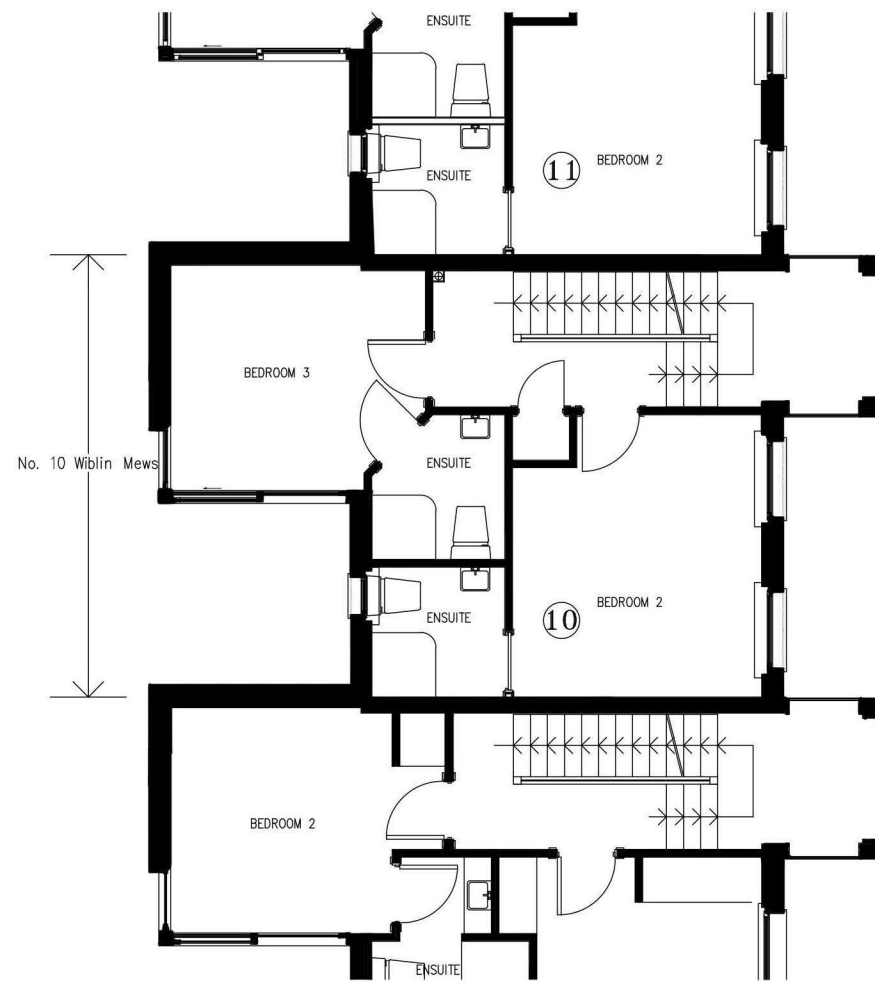

FIRST FLOOR PLAN

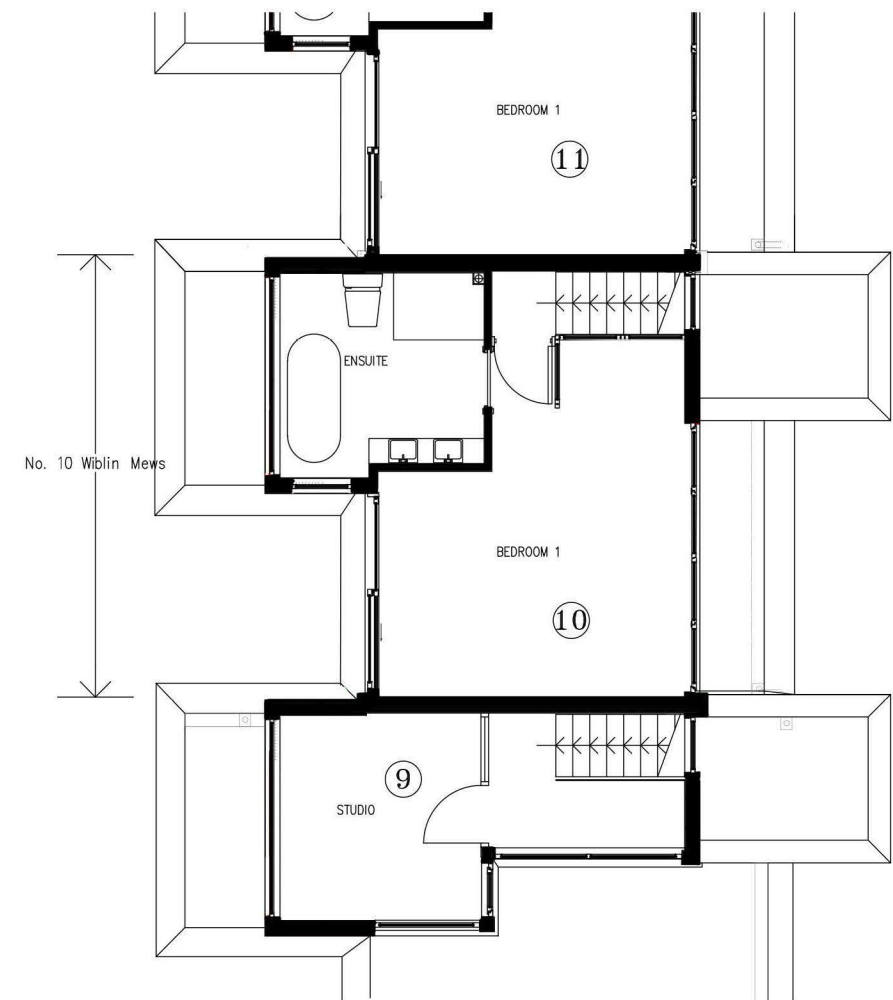


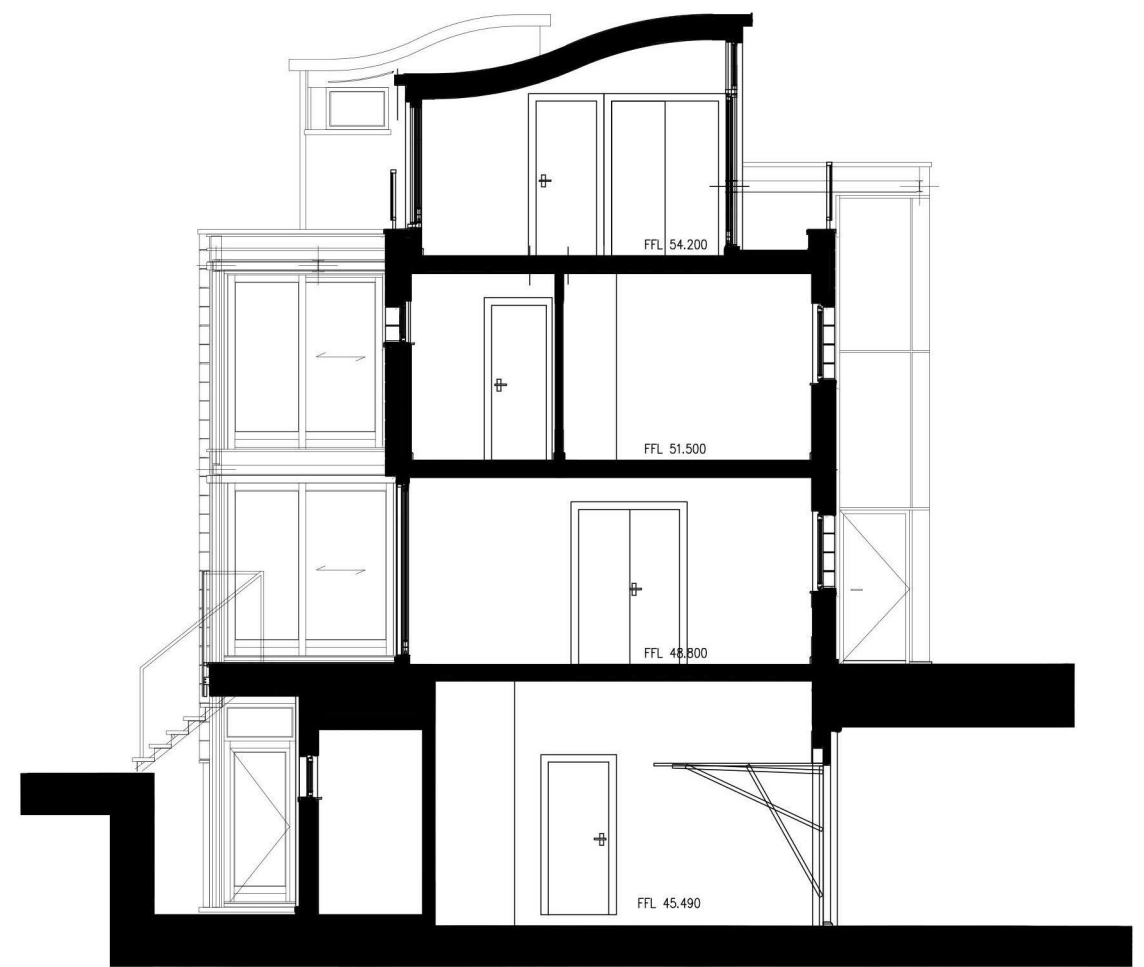
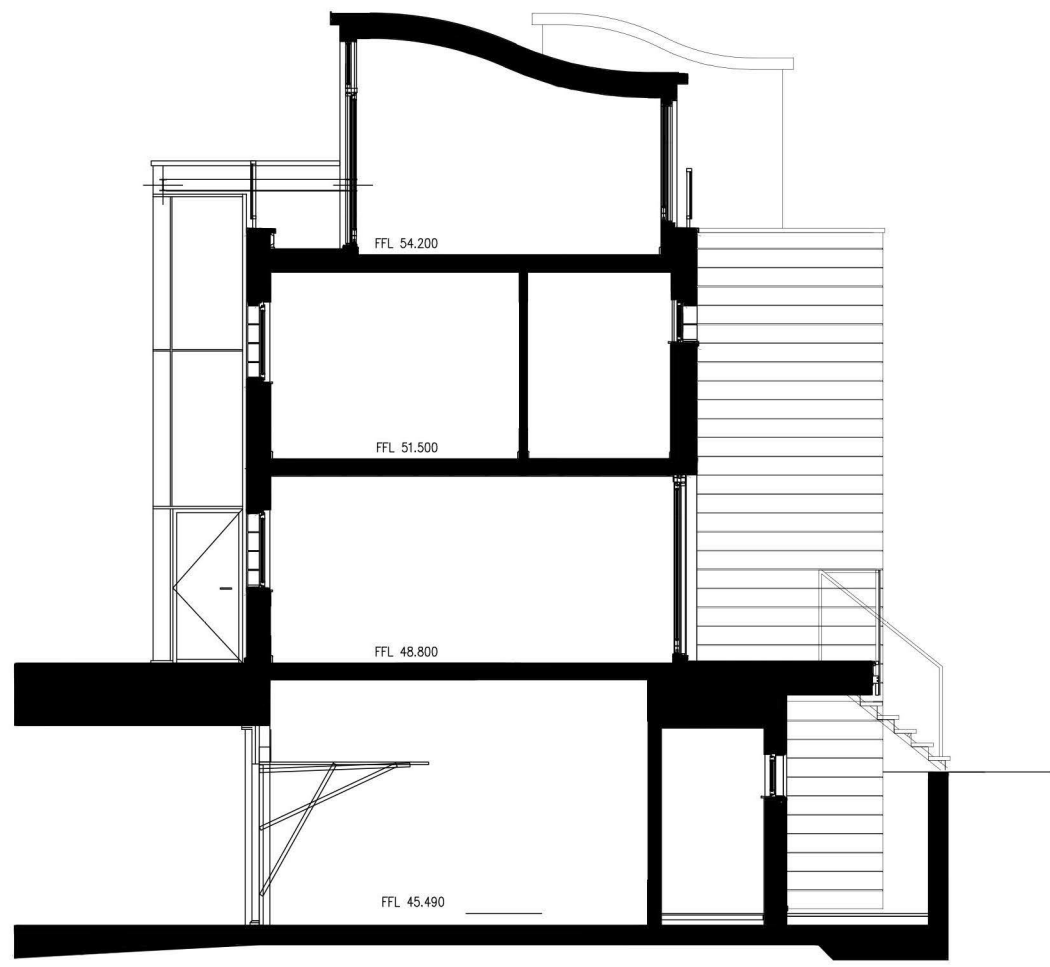
SECOND FLOOR PLAN


 <b>Proctor Watts Cole Rutter</b> Chartered Architects & Town Planners Grosvenor House, Bleke Street, Shaftesbury, Dorset, SP7 8AW. Phone: 01747 851881 Fax: 01747 851081 mail@pwcr.co.uk www.pwcr.co.uk	Client: Mr A Desaraju	Drawn By: S Way
	Dwg: 10, Wiblin Mews, Kentish Town	Checked By:
Job No: 4888	Dwg No: S03	Notes: As Built
Date: 31/03/2017	Scale: 1:100@A3	



NORTH WEST ELEVATION

 <b>Proctor Watts Cole Rutter</b> Chartered Architects & Town Planners Grosvenor House, Bleke Street, Shaftesbury, Dorset, SP7 8AW. Phone: 01747 851881 Fax: 01747 851081 mail@pwcr.co.uk www.pwcr.co.uk	Client: Mr A Desaraju	Drawn By: S Way
	Dwg: 10, Wiblin Mews, Kentish Town	Checked By:
Job No: 4888	Dwg No: S04	Notes: As Built
Date: 31/03/2017	Scale: 1:100@A3	



 <b>Proctor Watts Cole Rutter</b> Chartered Architects & Town Planners Grosvenor House, Bleke Street, Shaftesbury, Dorset, SP7 8AW. Phone: 01747 851881 Fax: 01747 851081 mail@pwcr.co.uk www.pwcr.co.uk	Client: Mr A Desaraju	Drawn By: S Way
	Dwg: 10, Wiblin Mews, Kentish Town	Checked By:
Job No: 4888	Dwg No: S05	Notes: As Built
Date: 31/03/2017	Scale: 1:100@A3	