

Rev No	Description	Drawn By	Date
A	ISA & BSA of New Arrangement	RW	25/05/14
B	Revised Planning and Survey	RW	15/07/14
C	New detailed ground floor plan 1000mm grid	CS	28/07/14
D	Finalise report for A. Shawley	CS	01/08/14
E	Finalise report report	CS	11/08/14

**Notes**

This drawing represents a performance guide upon which the contractor/subcontractor must base his/her working drawings & details. Include all necessary tolerances prior to manufacture and installation.

Contractor to must undertake a full survey of the area to establish all dimensions & ensure accurate setting out.

Advise on suitability of all details shown to ensure structural stability, ease and economy of construction.

Refer to digital master artwork in regard to all graphic work shown.


**AS BUILT**

**bedrock**  
 Bedrock Design Consultants Ltd  
 2nd Floor, 39 Gold Street, Northampton,  
 NN1 1PA  
 T 01604 250002  
 F 01604 250003  
 info@bedrockdesign.co.uk

Client: **Caffe Nero**  
 Project: **Holborn**  
 Description: **External Seating**

Scale	Drawn by	Date
1:75@A3	CA	23/03/17
Drawing No	Revision	
CN640 - 100	E	

This drawing is the copyright of Bedrock Design Consultants Ltd. This drawing cannot be copied, reproduced, related or disclosed to any person without prior permission in writing from the design.

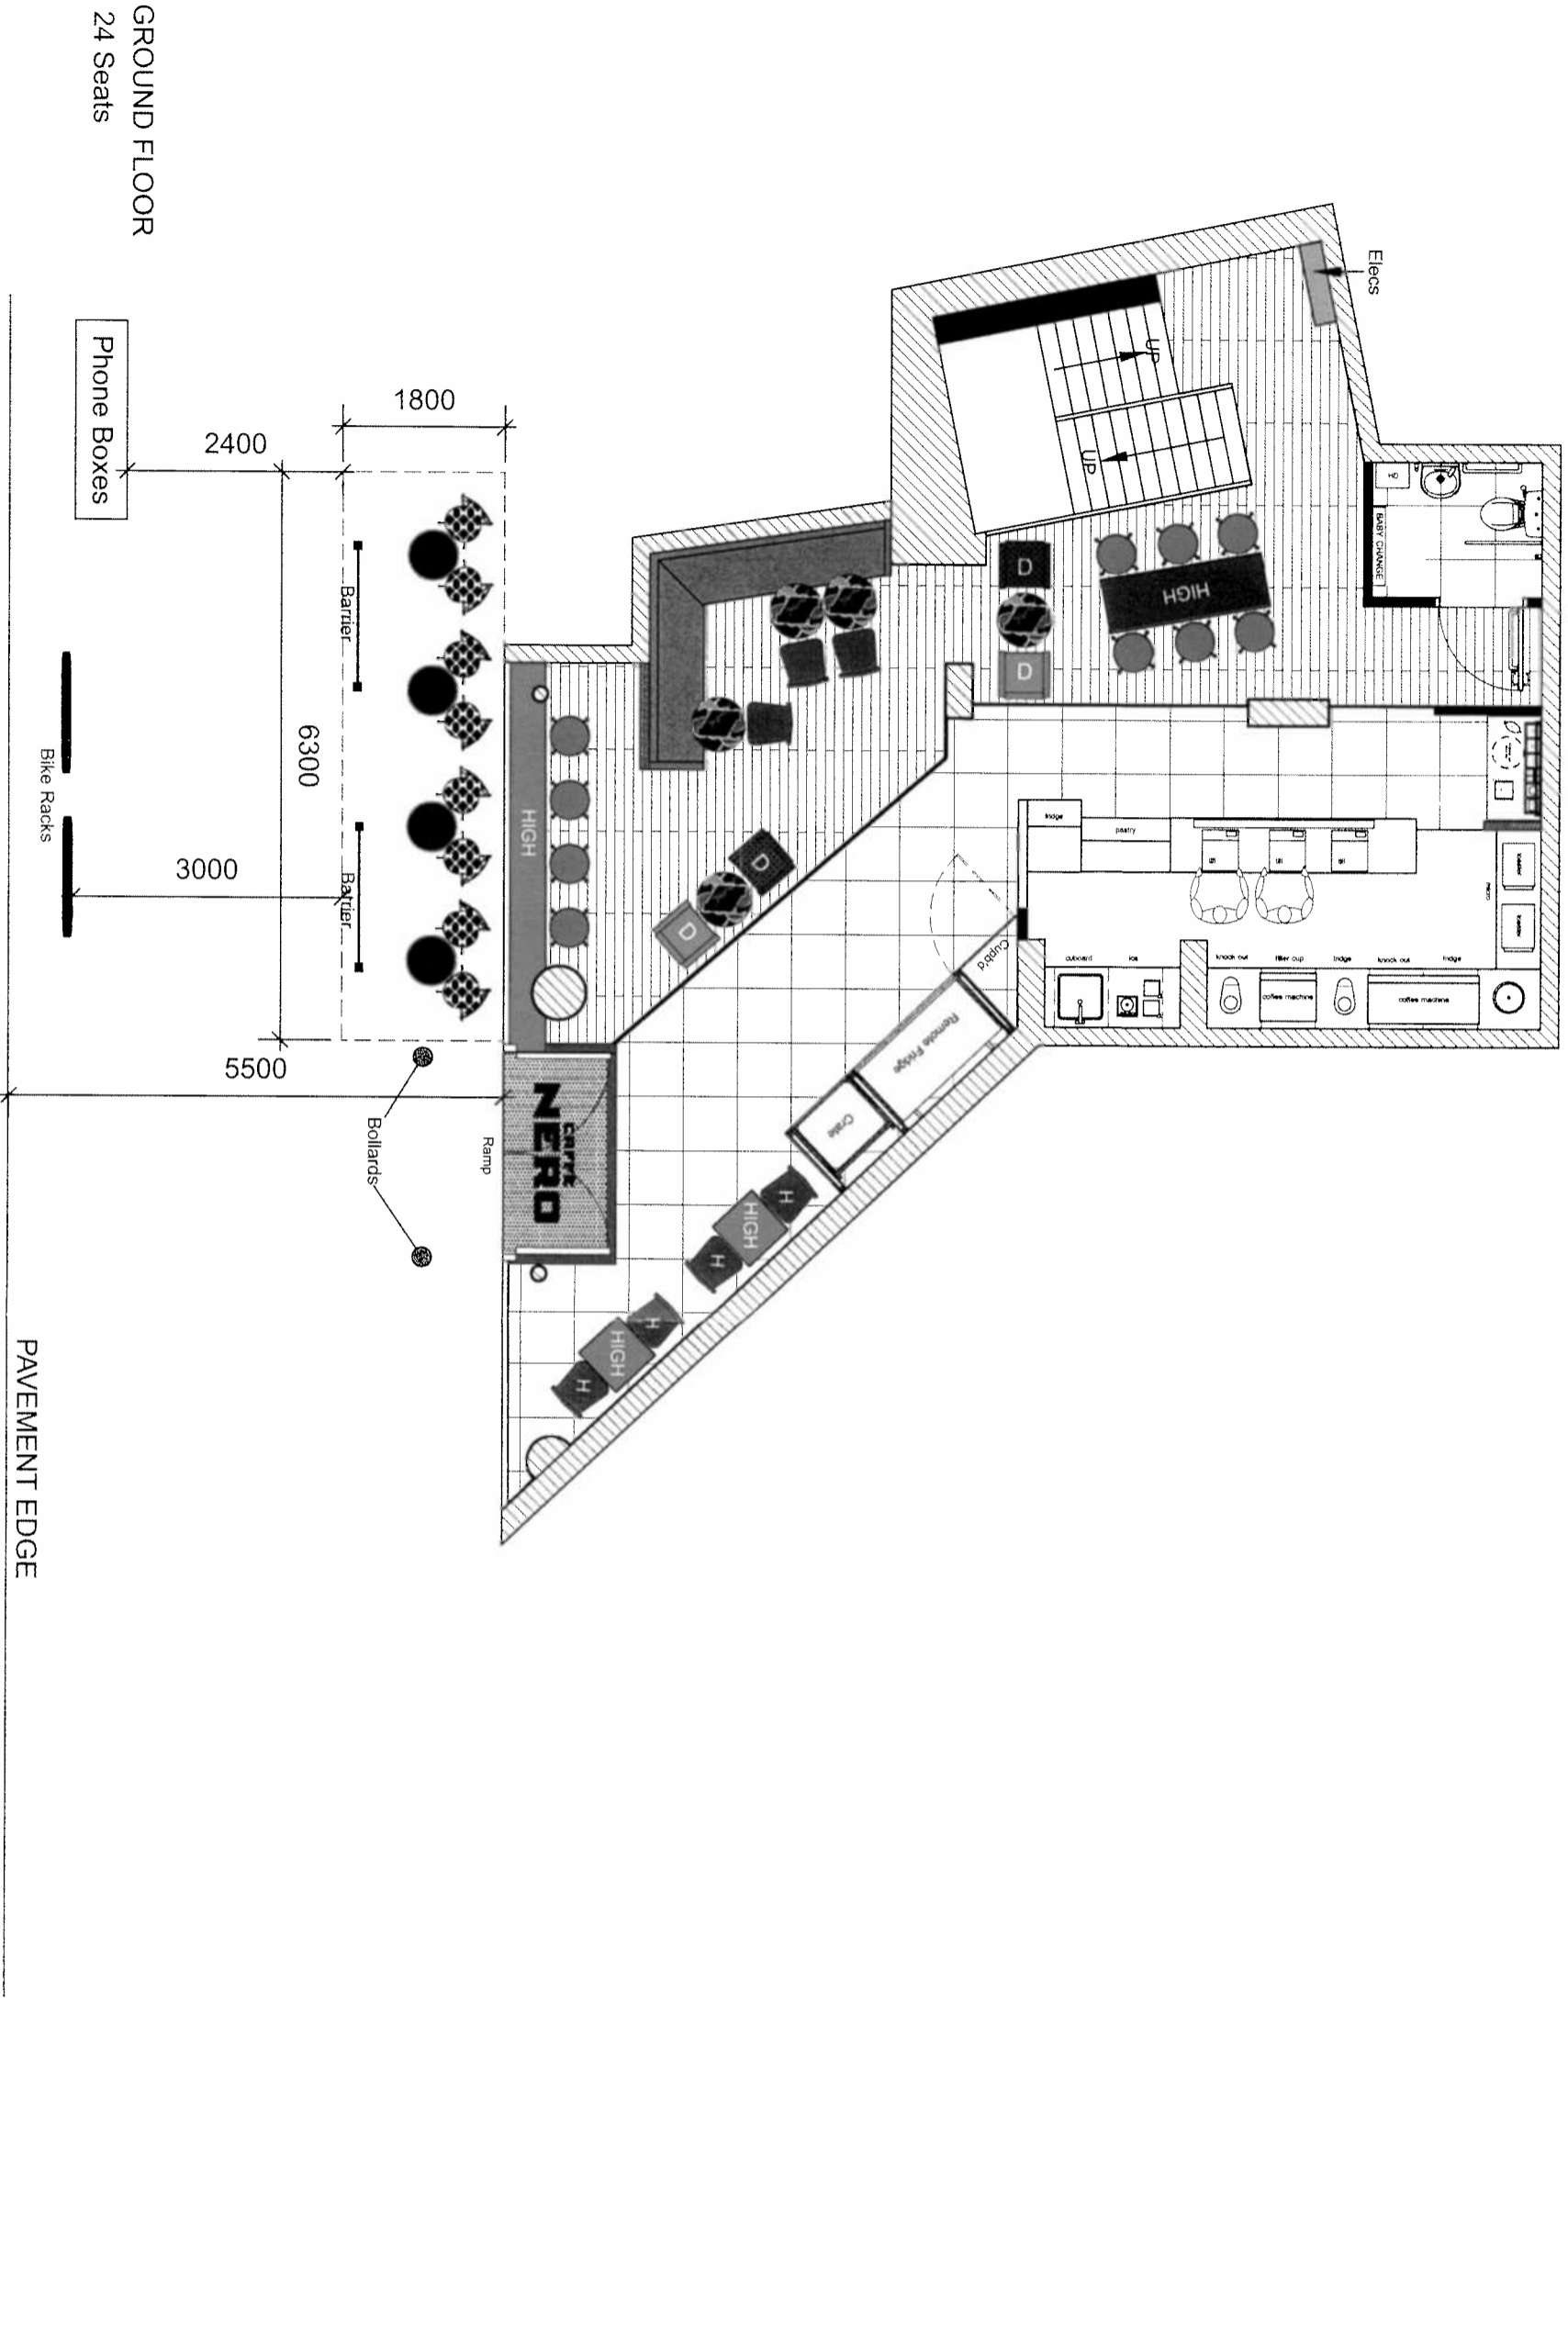

**GROUND FLOOR**  
 24 Seats

Phone Boxes

Barrier

Bike Racks

Bollards

**PAVEMENT EDGE**