
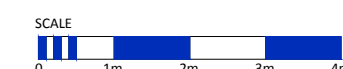


Application for Planning Permission
And
Listed Building Consent

LABS

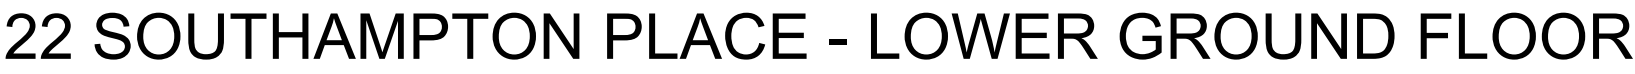

LABS - Architectural Drawing Pack
March 2017

[illegible]

Rev	Descriptive amendments	Drawn by	Date
-----	------------------------	----------	------

Pre-Design - Construction - As Built

Client

LABS

Client Contact

Site Address
22 Southampton Place
Holborn
London WC1A 2BP

Drawing Title
EXISTING GENERAL ARRANGEMENT


Account Manager
Wayne Judge

Designer/ Project Manager
Monika Passey


Scale 1:50 @ A1	Drawn by FL	First Drawing Date 20/03/2017
---------------------------	-----------------------	---

Contract Number	Building	Floor	Detail	Revision
0000	01	LG/GRD	EX	



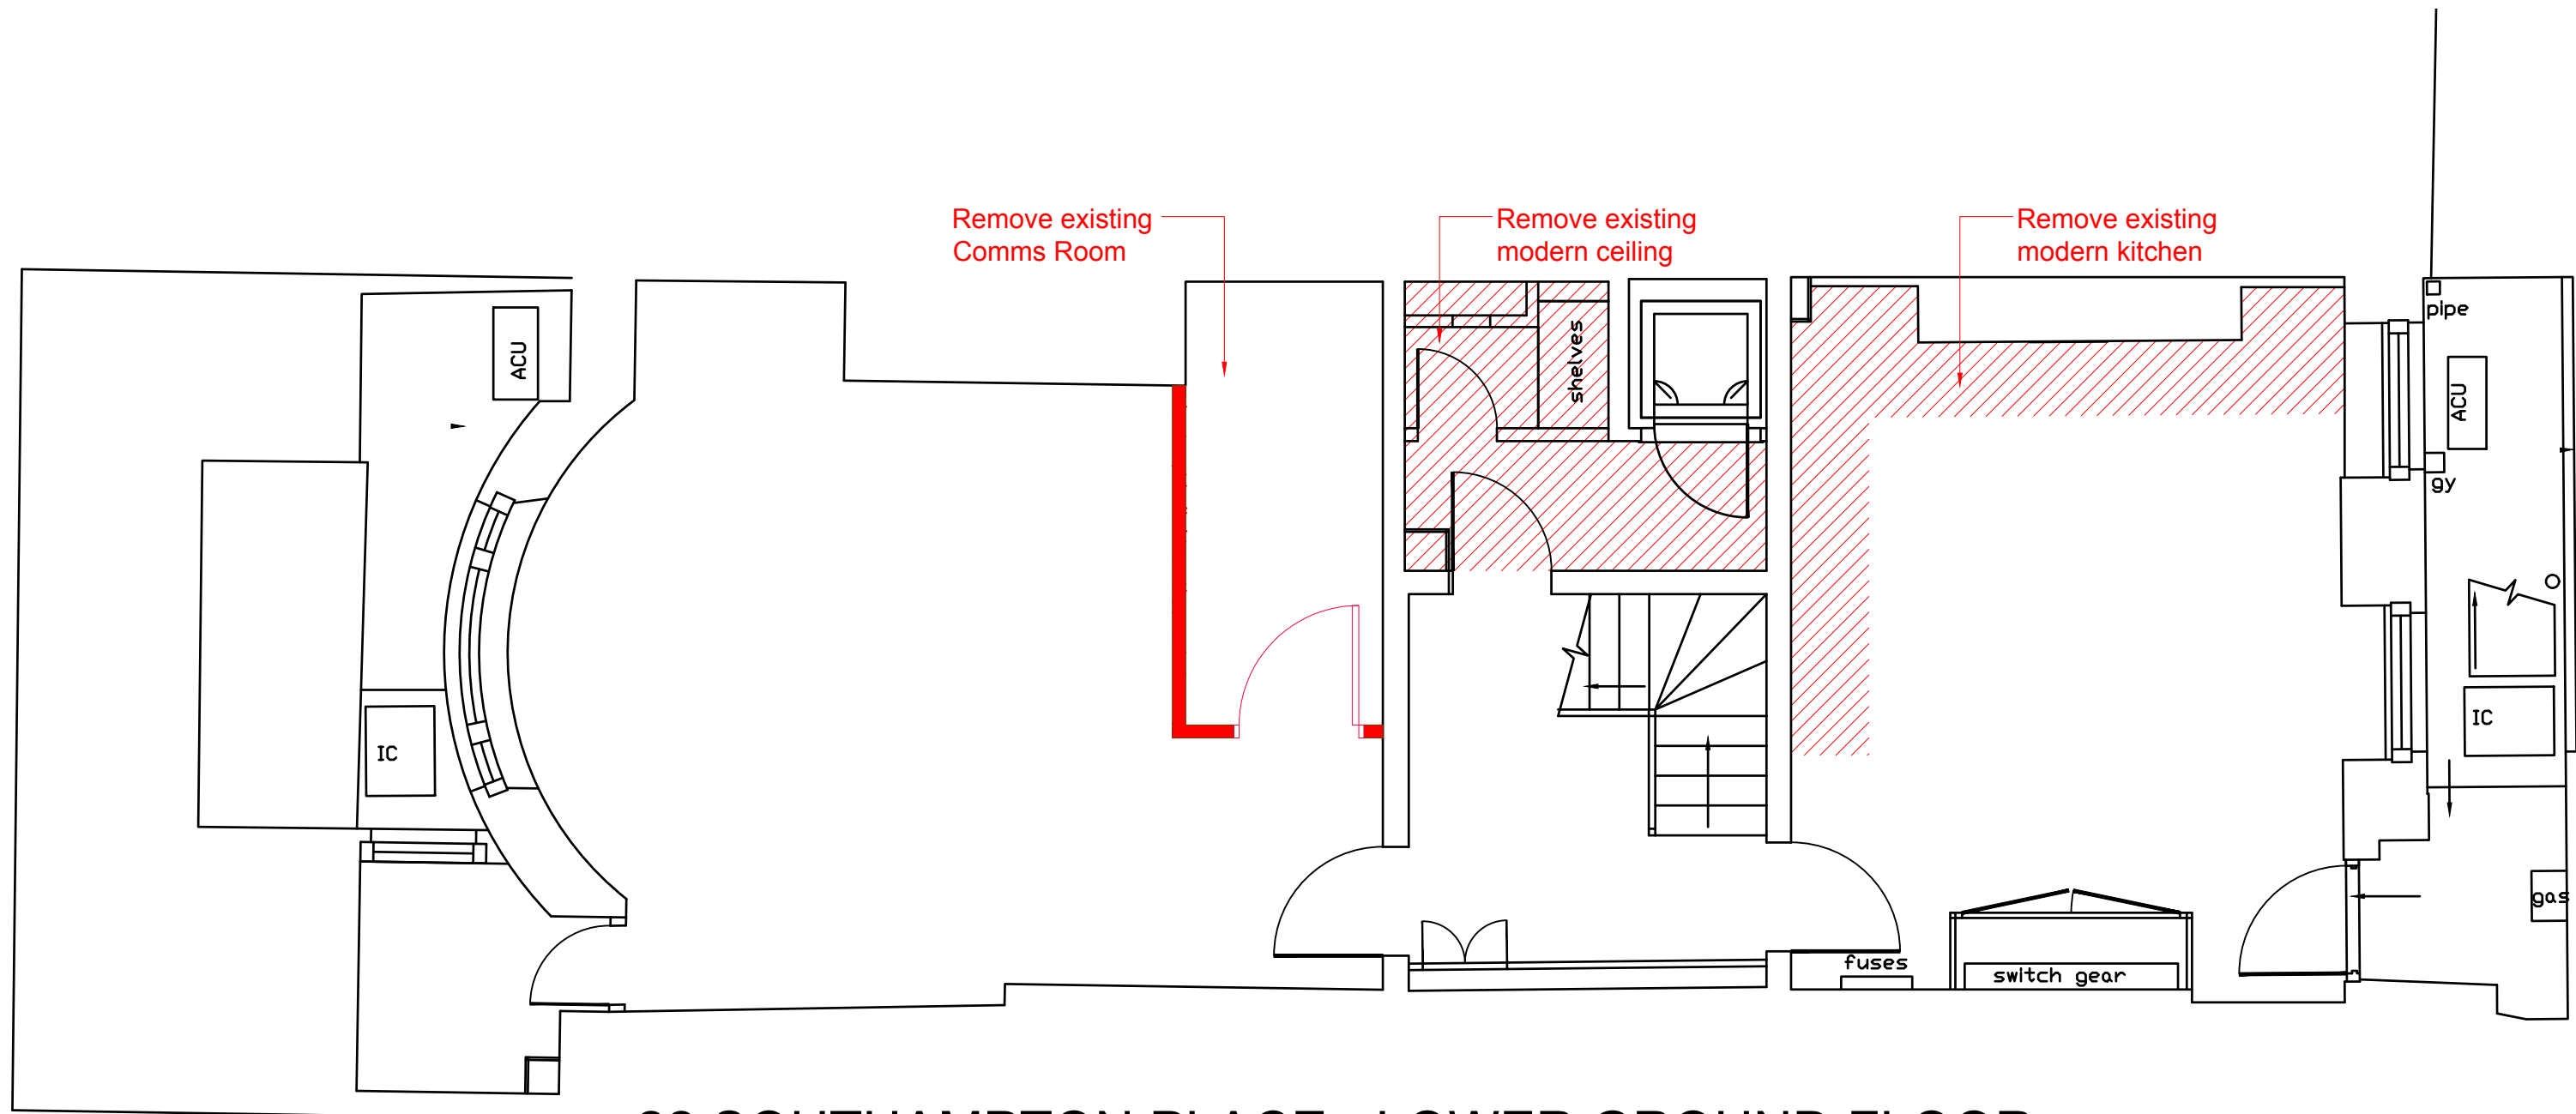

22 SOUTHAMPTON PLACE - LOWER GROUND FLOOR

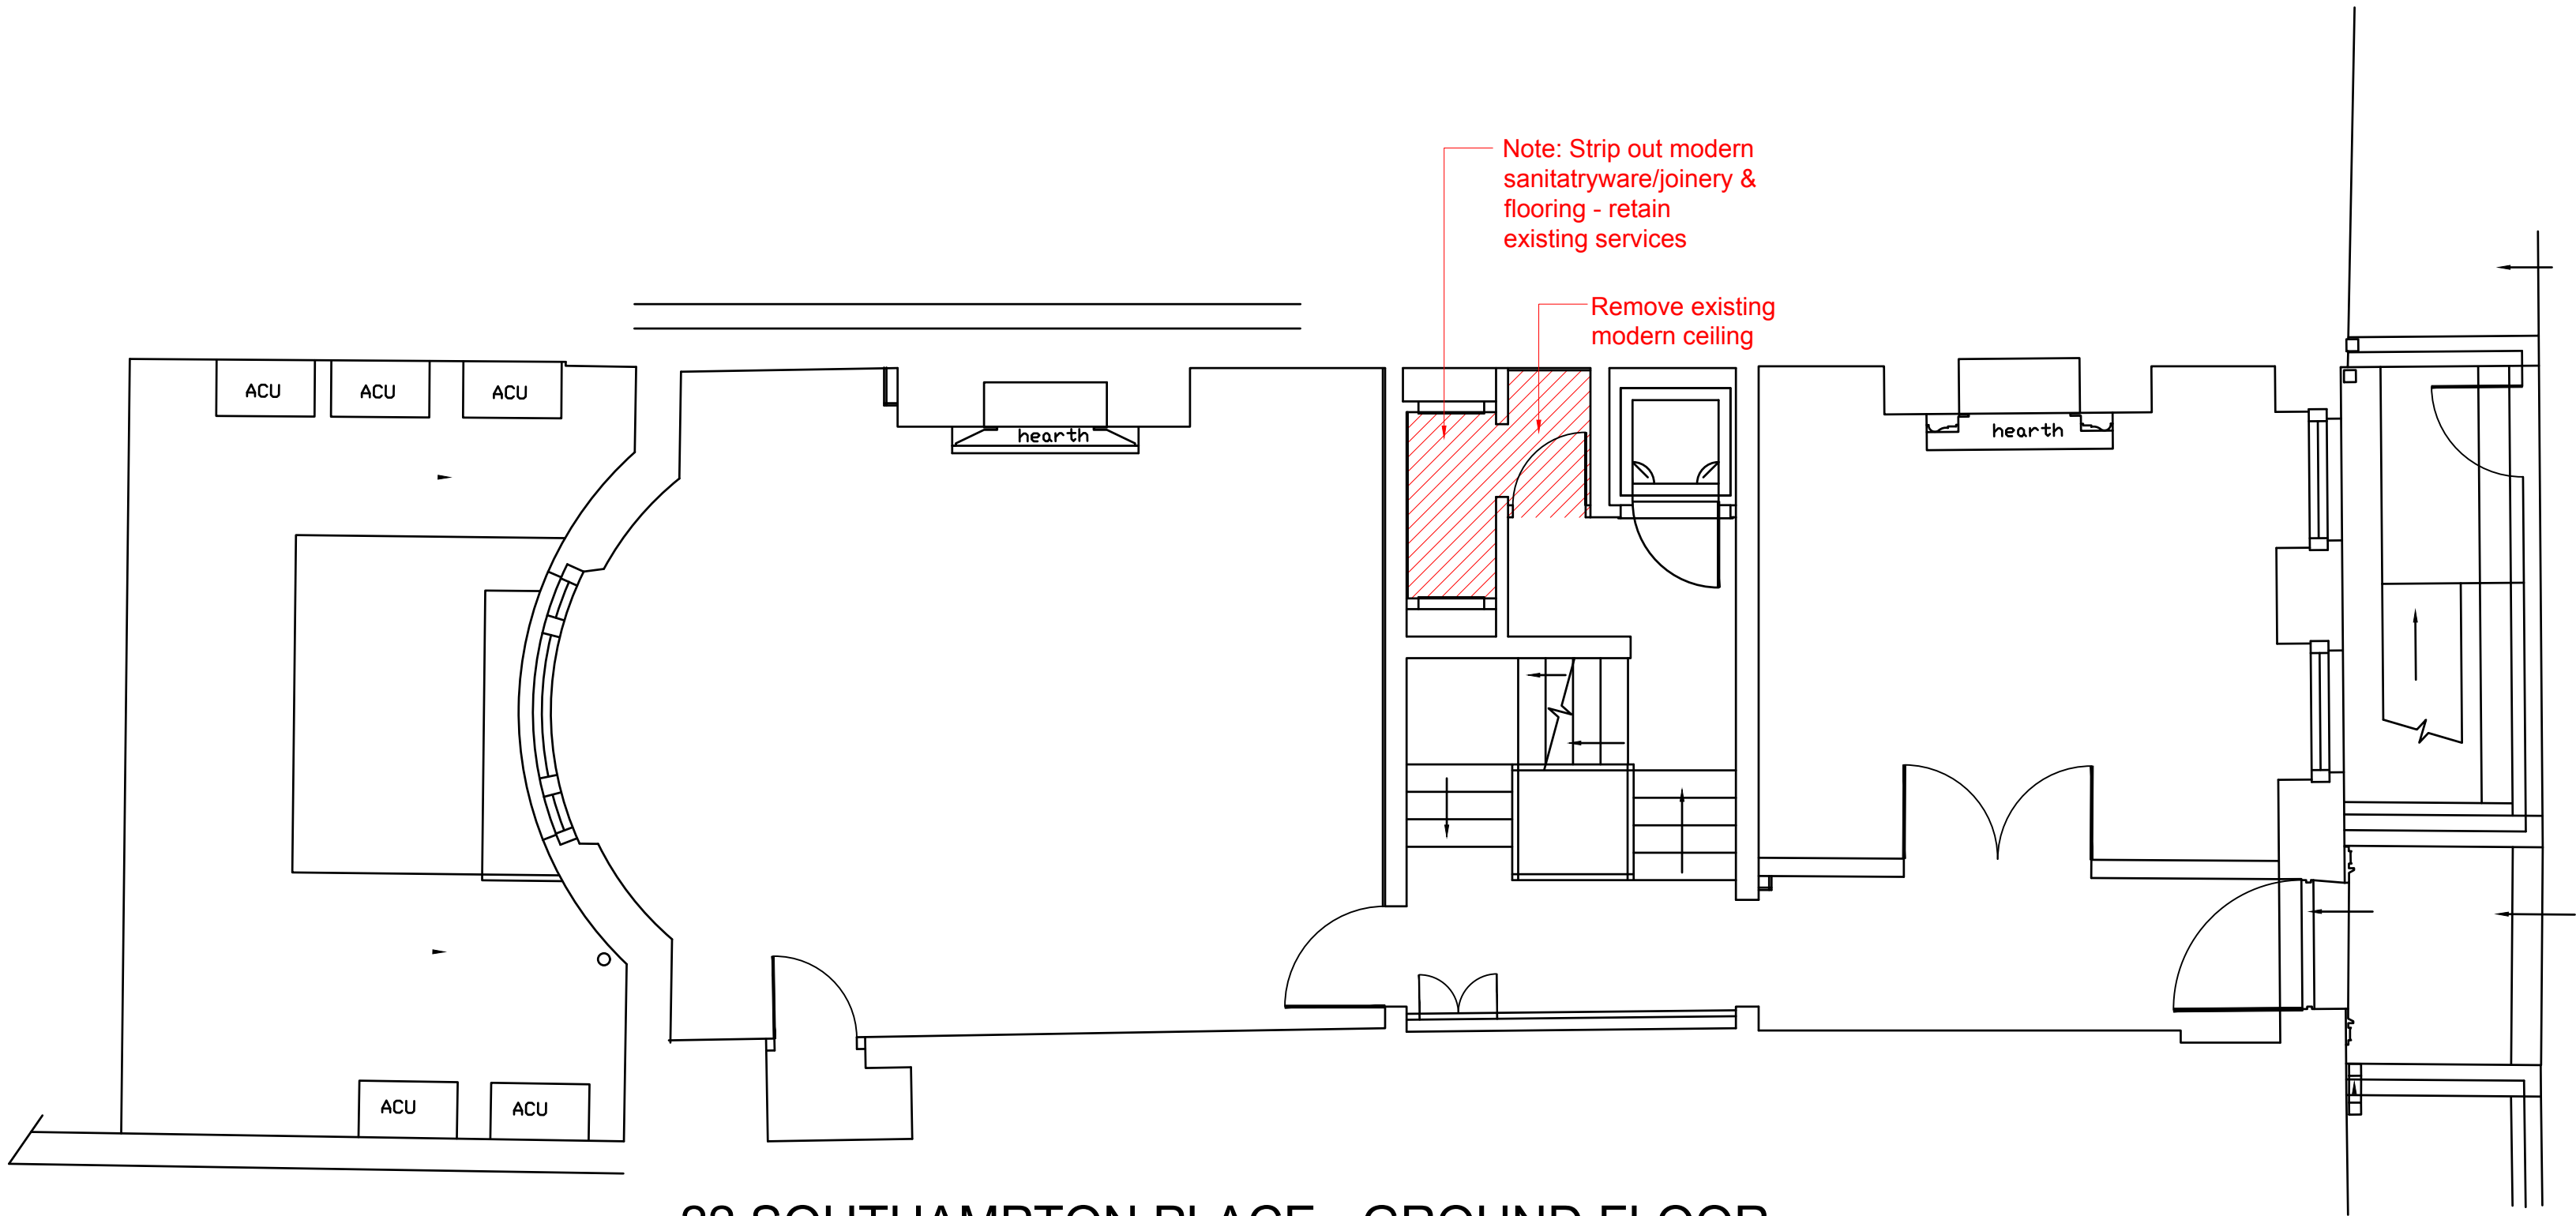

22 SOUTHAMPTON PLACE - GROUND FLOOR

Demolition


Remove all existing floor coverings

Existing ceilings to remain unless identified as removal


Washrooms, all associated rooms to have floor and wall coverings, ceilings, sanitary ware removed, retaining existing services

DEMO LEGEND	
Symbols shown are not to scale some symbols may not appear on the layout plan	
WALL STYLES	
	Existing structural wall
	Existing internal partition
	Demolished Partition
	Demolished Window Module
	Demolished Silicon Glass
	Demolished Single Door
	Demolished Hospital Door
	Demolished Double Door

Rev	Descriptive amendments	Drawn by	Date
Pre-Design - Construction - As Built			
PLANNING			
Client			
LABS			
Client Contact			
Site Address			
22 Southampton Place			
Holborn			
London WC1A 2BP			
Drawing Title			
DEMOLITION WORKS			
Account Manager			
Wayne Judge			
Designer/ Project Manager			
Monika Passey			
Scale	Drawn by	First Drawing Date	
1:50 @ A1	FL	20/03/2017	
Contract Number	Building	Floor	Detail
0000	01	LG/GR	DEMO
First Floor			
322 High Holborn			
London			
WC1V 7PB			
T: +44 (0)20 7553 9500			
www.oktra.co.uk			

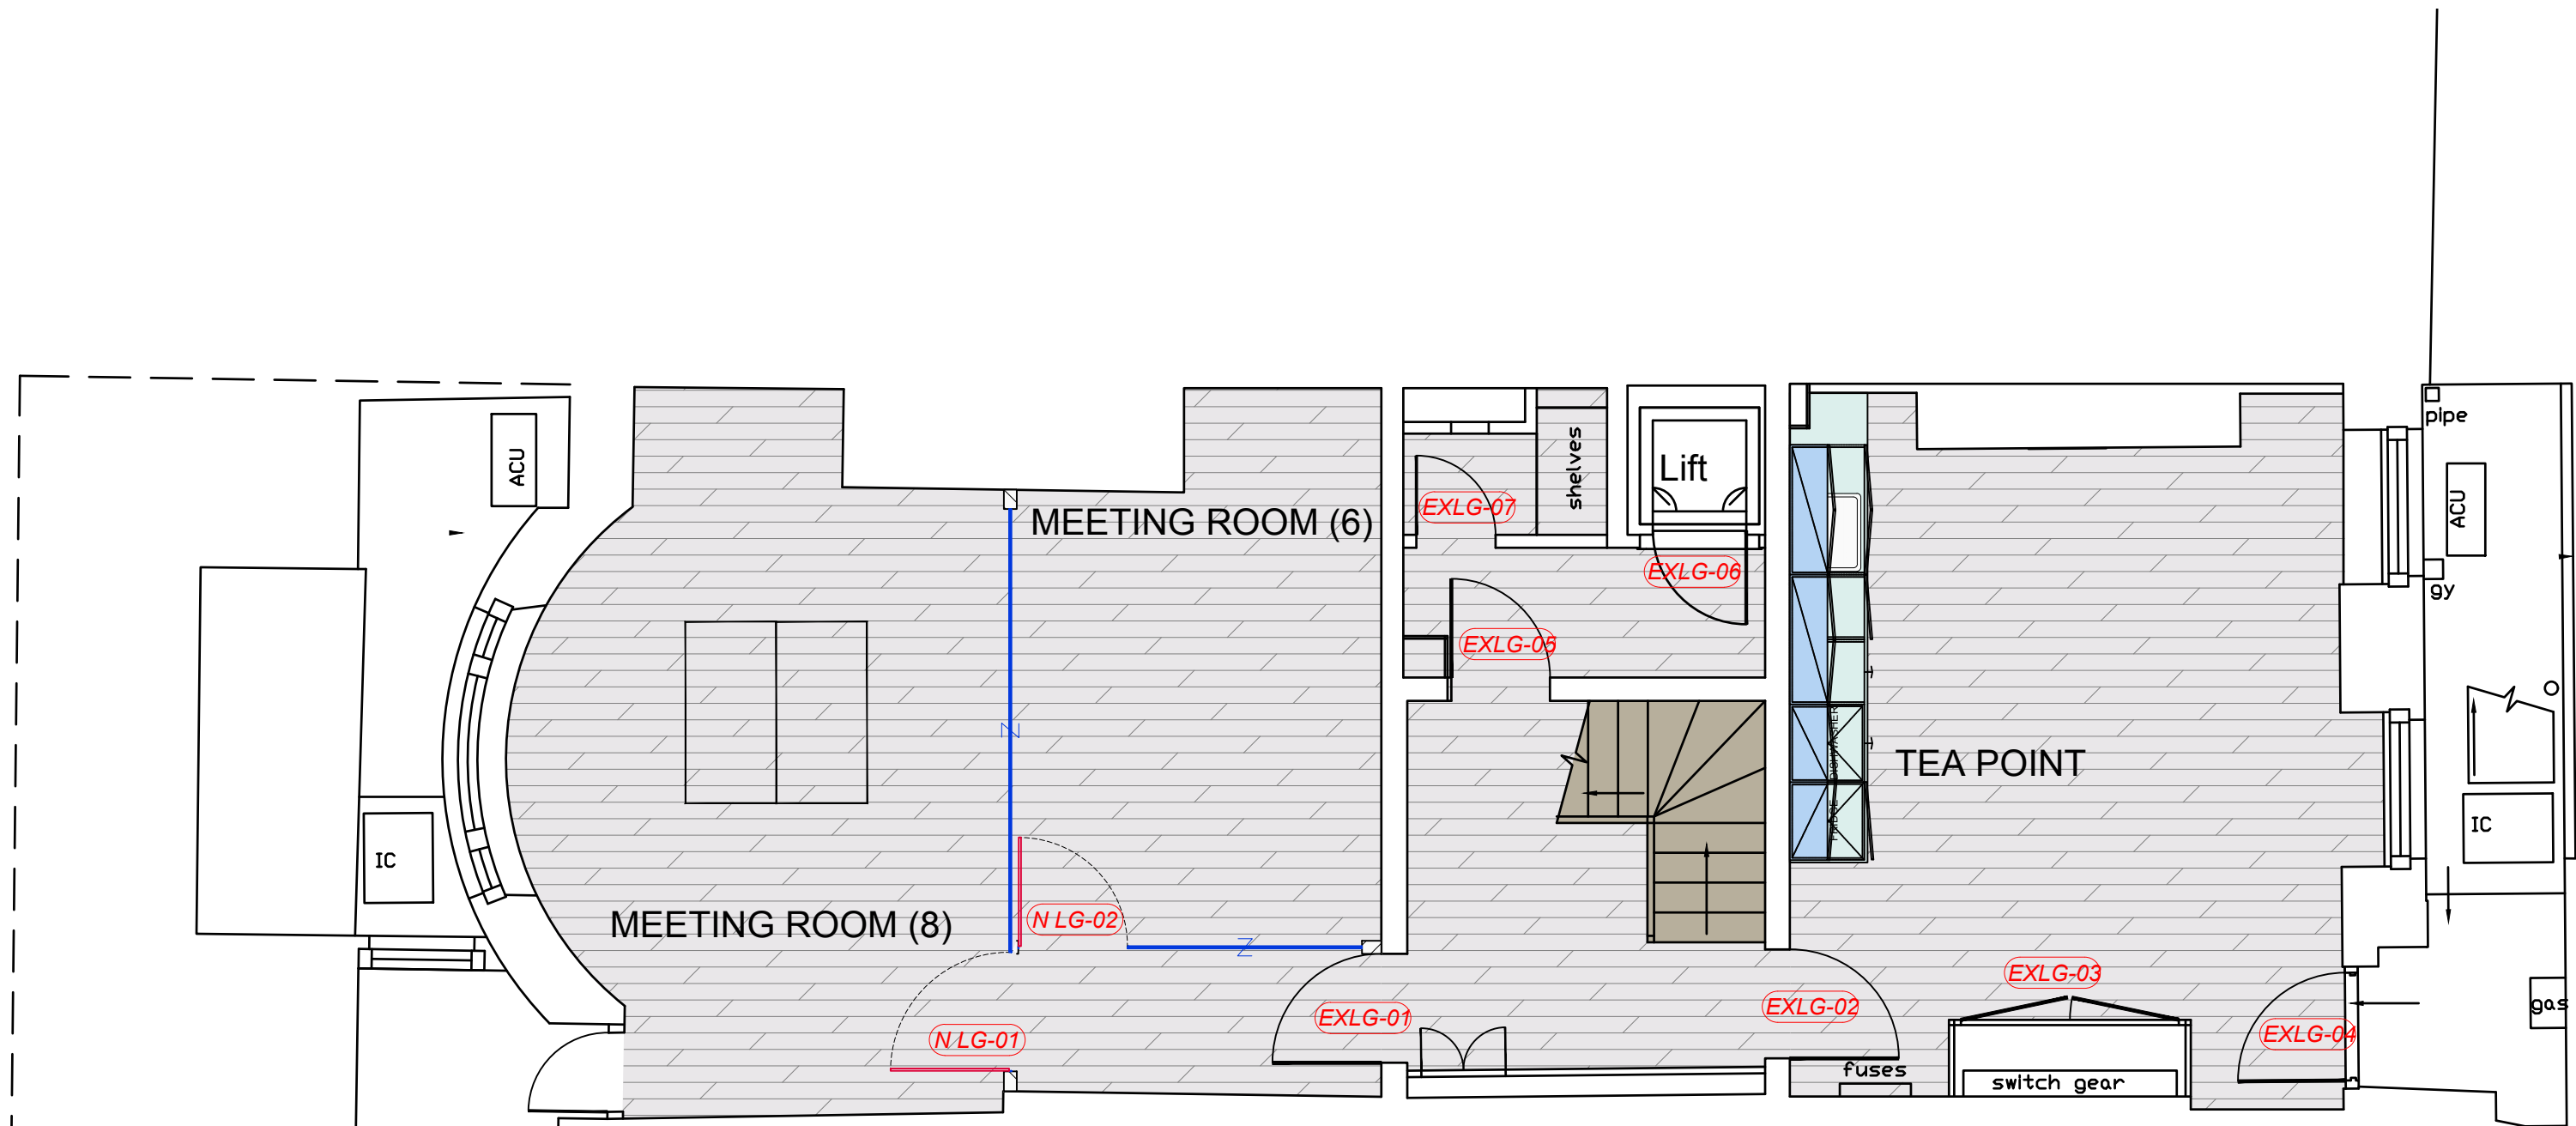

22 SOUTHAMPTON PLACE - LOWER GROUND FLOOR

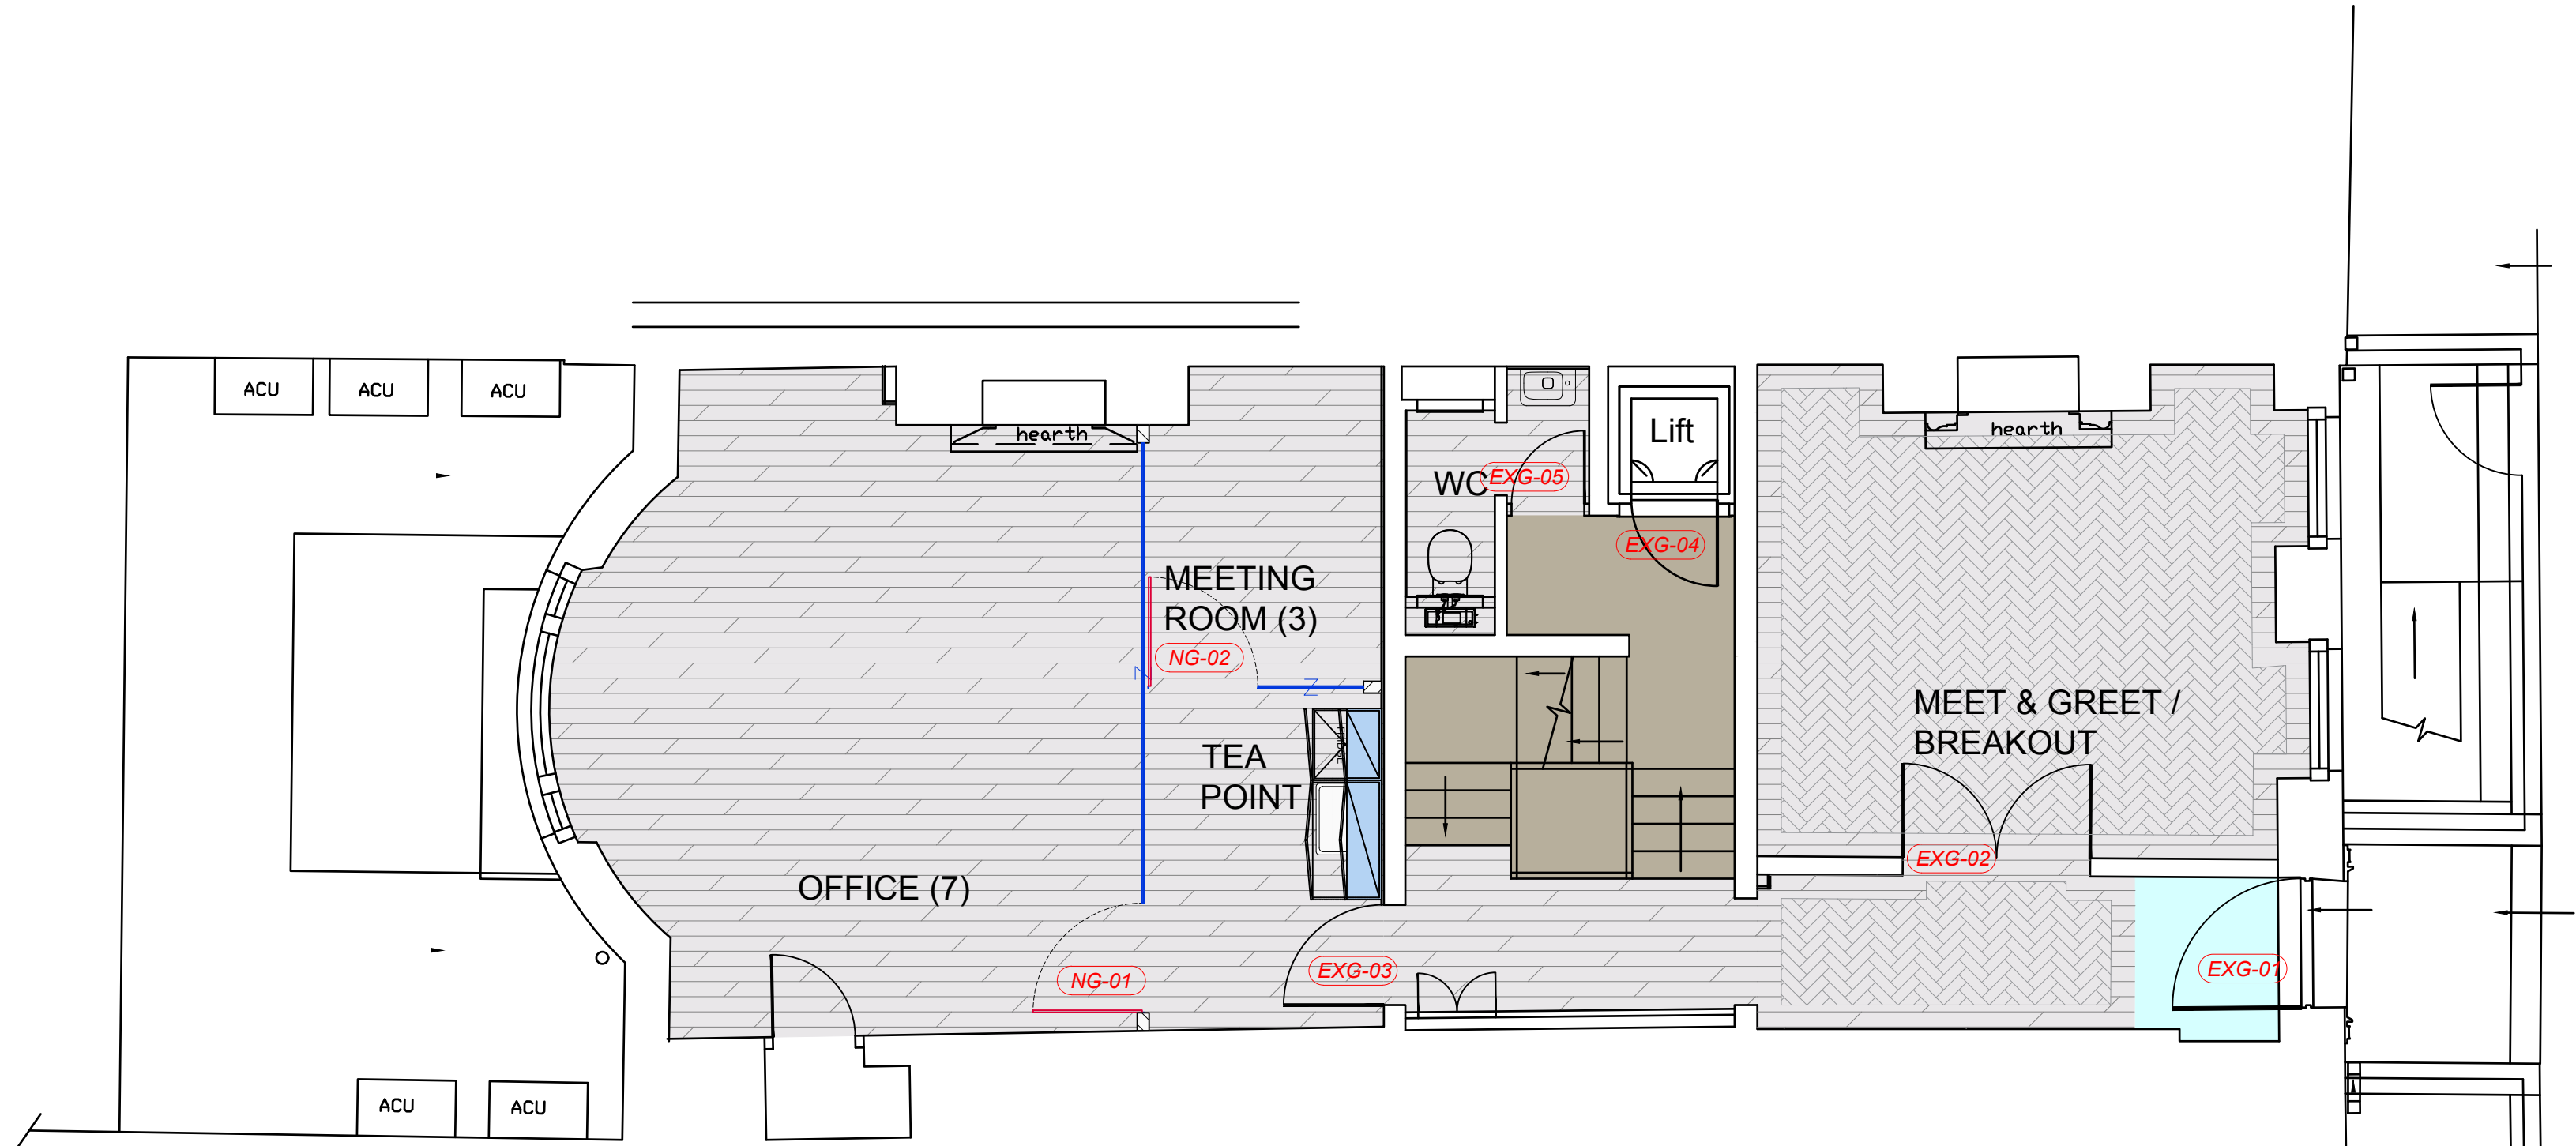

22 SOUTHAMPTON PLACE - GROUND FLOOR

GENERAL ARRANGEMENT LEGEND

Symbols shown are not to scale
some symbols may not appear on the layout plan

WALL STYLES	
	Existing structural wall
	Existing internal partition
	New single skin partition - 75mm
	New single skin partition - 100mm
	New double skin partition - 100mm
	Demolished Partition
	New low partition
	New half height partition with glazing above

GLAZING DETAILS	
	Existing glazed module
	Existing silicon glass
	New single glazed module
	New double glazed module
	New single glazed silicon glass
	New double glazed silicon glass

DOOR DETAILS	
	Existing door
	New Solid door
	New Frameless glass door
	New Framed glass door
	New Aluminium Framed glass door
	New Oversized Solid door
	New Special Oversized door
	New Glass Sliding Door
	New Pivot Door

(EX-27) EX1=Existing 1st floor (EX1-27) EX1=Relocated 1st floor (N1-05) N1=New 1st floor

FINISHES LAYOUT LEGEND

Symbols shown are not to scale
some symbols may not appear on the layout plan

FLOOR FINISHES	
	Wood effect vinyl flooring - 1 To replace modern carpet floor, to be laid over
	Wood effect vinyl flooring - 2 To replace modern carpet floor, to be laid over
	Barrier Matting To replace modern carpet floor, to be laid over
	Carpet - broadloom to stairs To replace modern carpet floor, to be laid over

Rev	Descriptive amendments	Drawn by	Date
-----	------------------------	----------	------

Pre-Design - Construction - As Built
PLANNING

Client

LABS

Client Contact

Site Address
22 Southampton Place
Holborn
London WC1A 2BP

Drawing Title
PROPOSED GENERAL ARRANGEMENT

Account Manager
Wayne Judge

Designer/ Project Manager
Monika Passey

Scale
1:50 @ A1

Drawn by
FL

First Drawing Date
20/03/2017

Contract Number
0000

Building
01


Floor
LG/GRD

Detail
GA

Revision

First Floor
322 High Holborn
London
WC1V 7PB
T: +44 (0)20 7553 9500
www.oktra.co.uk

SCALE
0 1m 2m 3m 4m

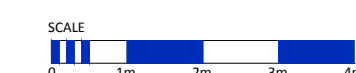[illegible]

Rev	Descriptive amendments	Drawn by	Date
-----	------------------------	----------	------

Pre-Design - Construction - As Built
PLANNING

Client

LABS

Client Contact

Site Address
22 Southampton Place
Holborn
London WC1A 2BP


Drawing Title
EXISTING GENERAL ARRANGEMENT

Account Manager
Wayne Judge


Designer/ Project Manager
Monika Passey

Scale 1:50 @ A1	Drawn by FL		First Drawing Date 20/03/2017	
Contract Number 0000	Building 01	Floor 01/02	Detail EX	Revision



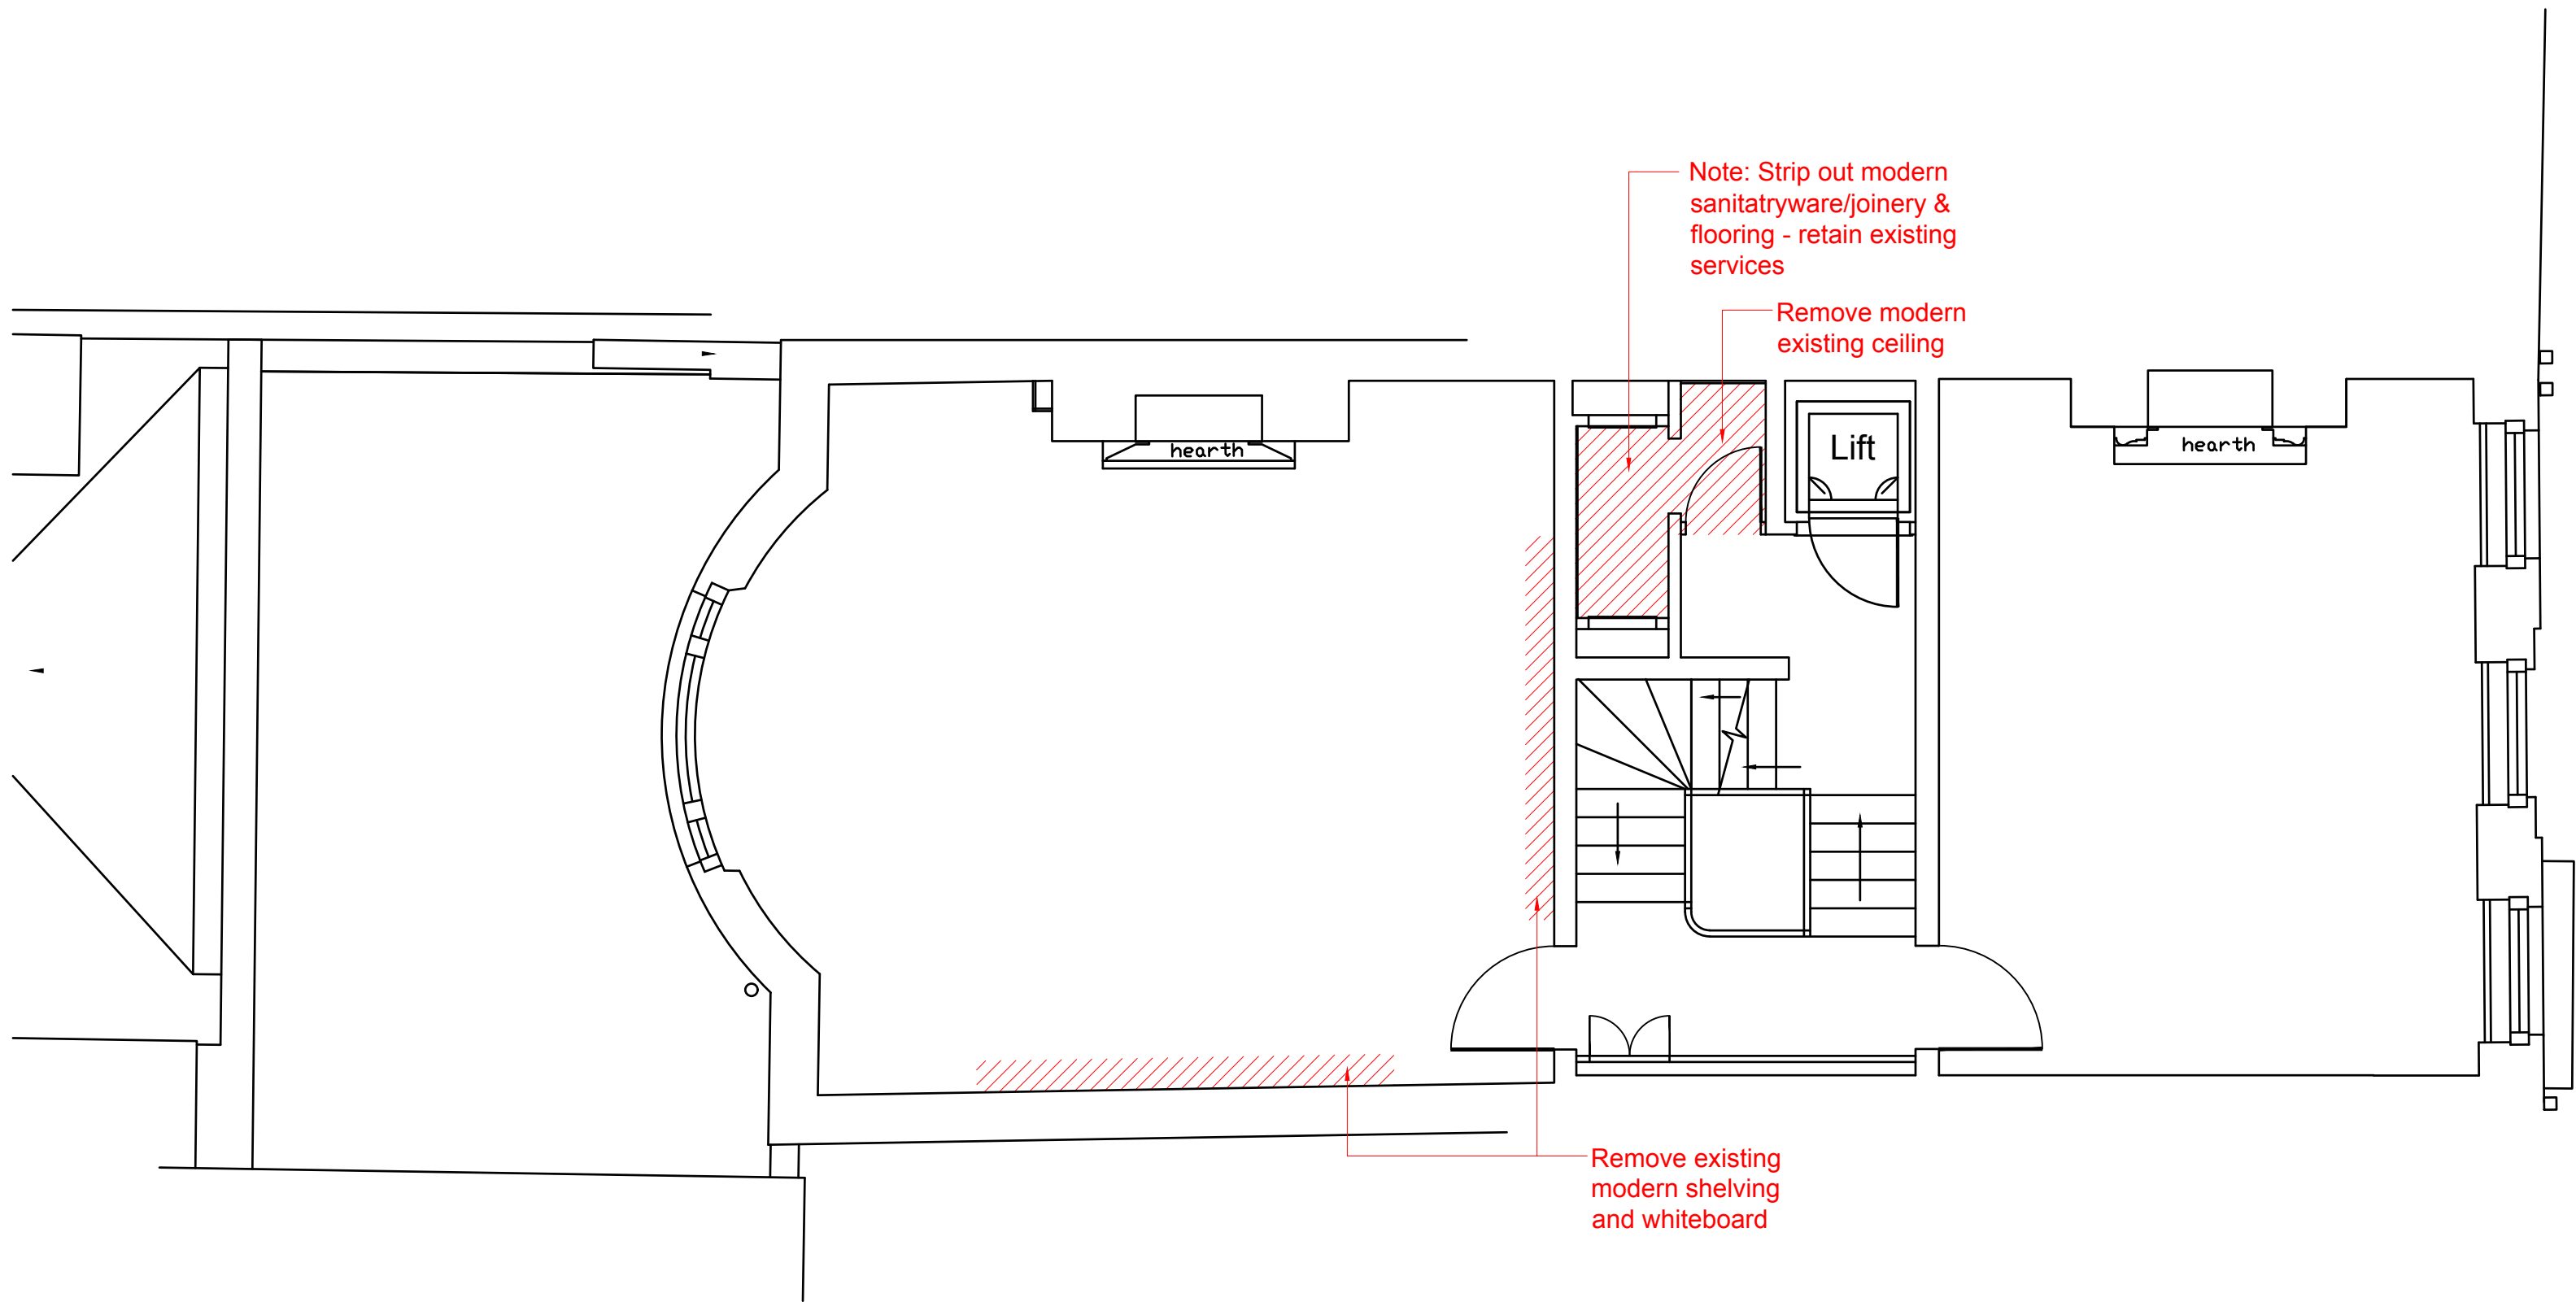

22 SOUTHAMPTON PLACE - FIRST FLOOR

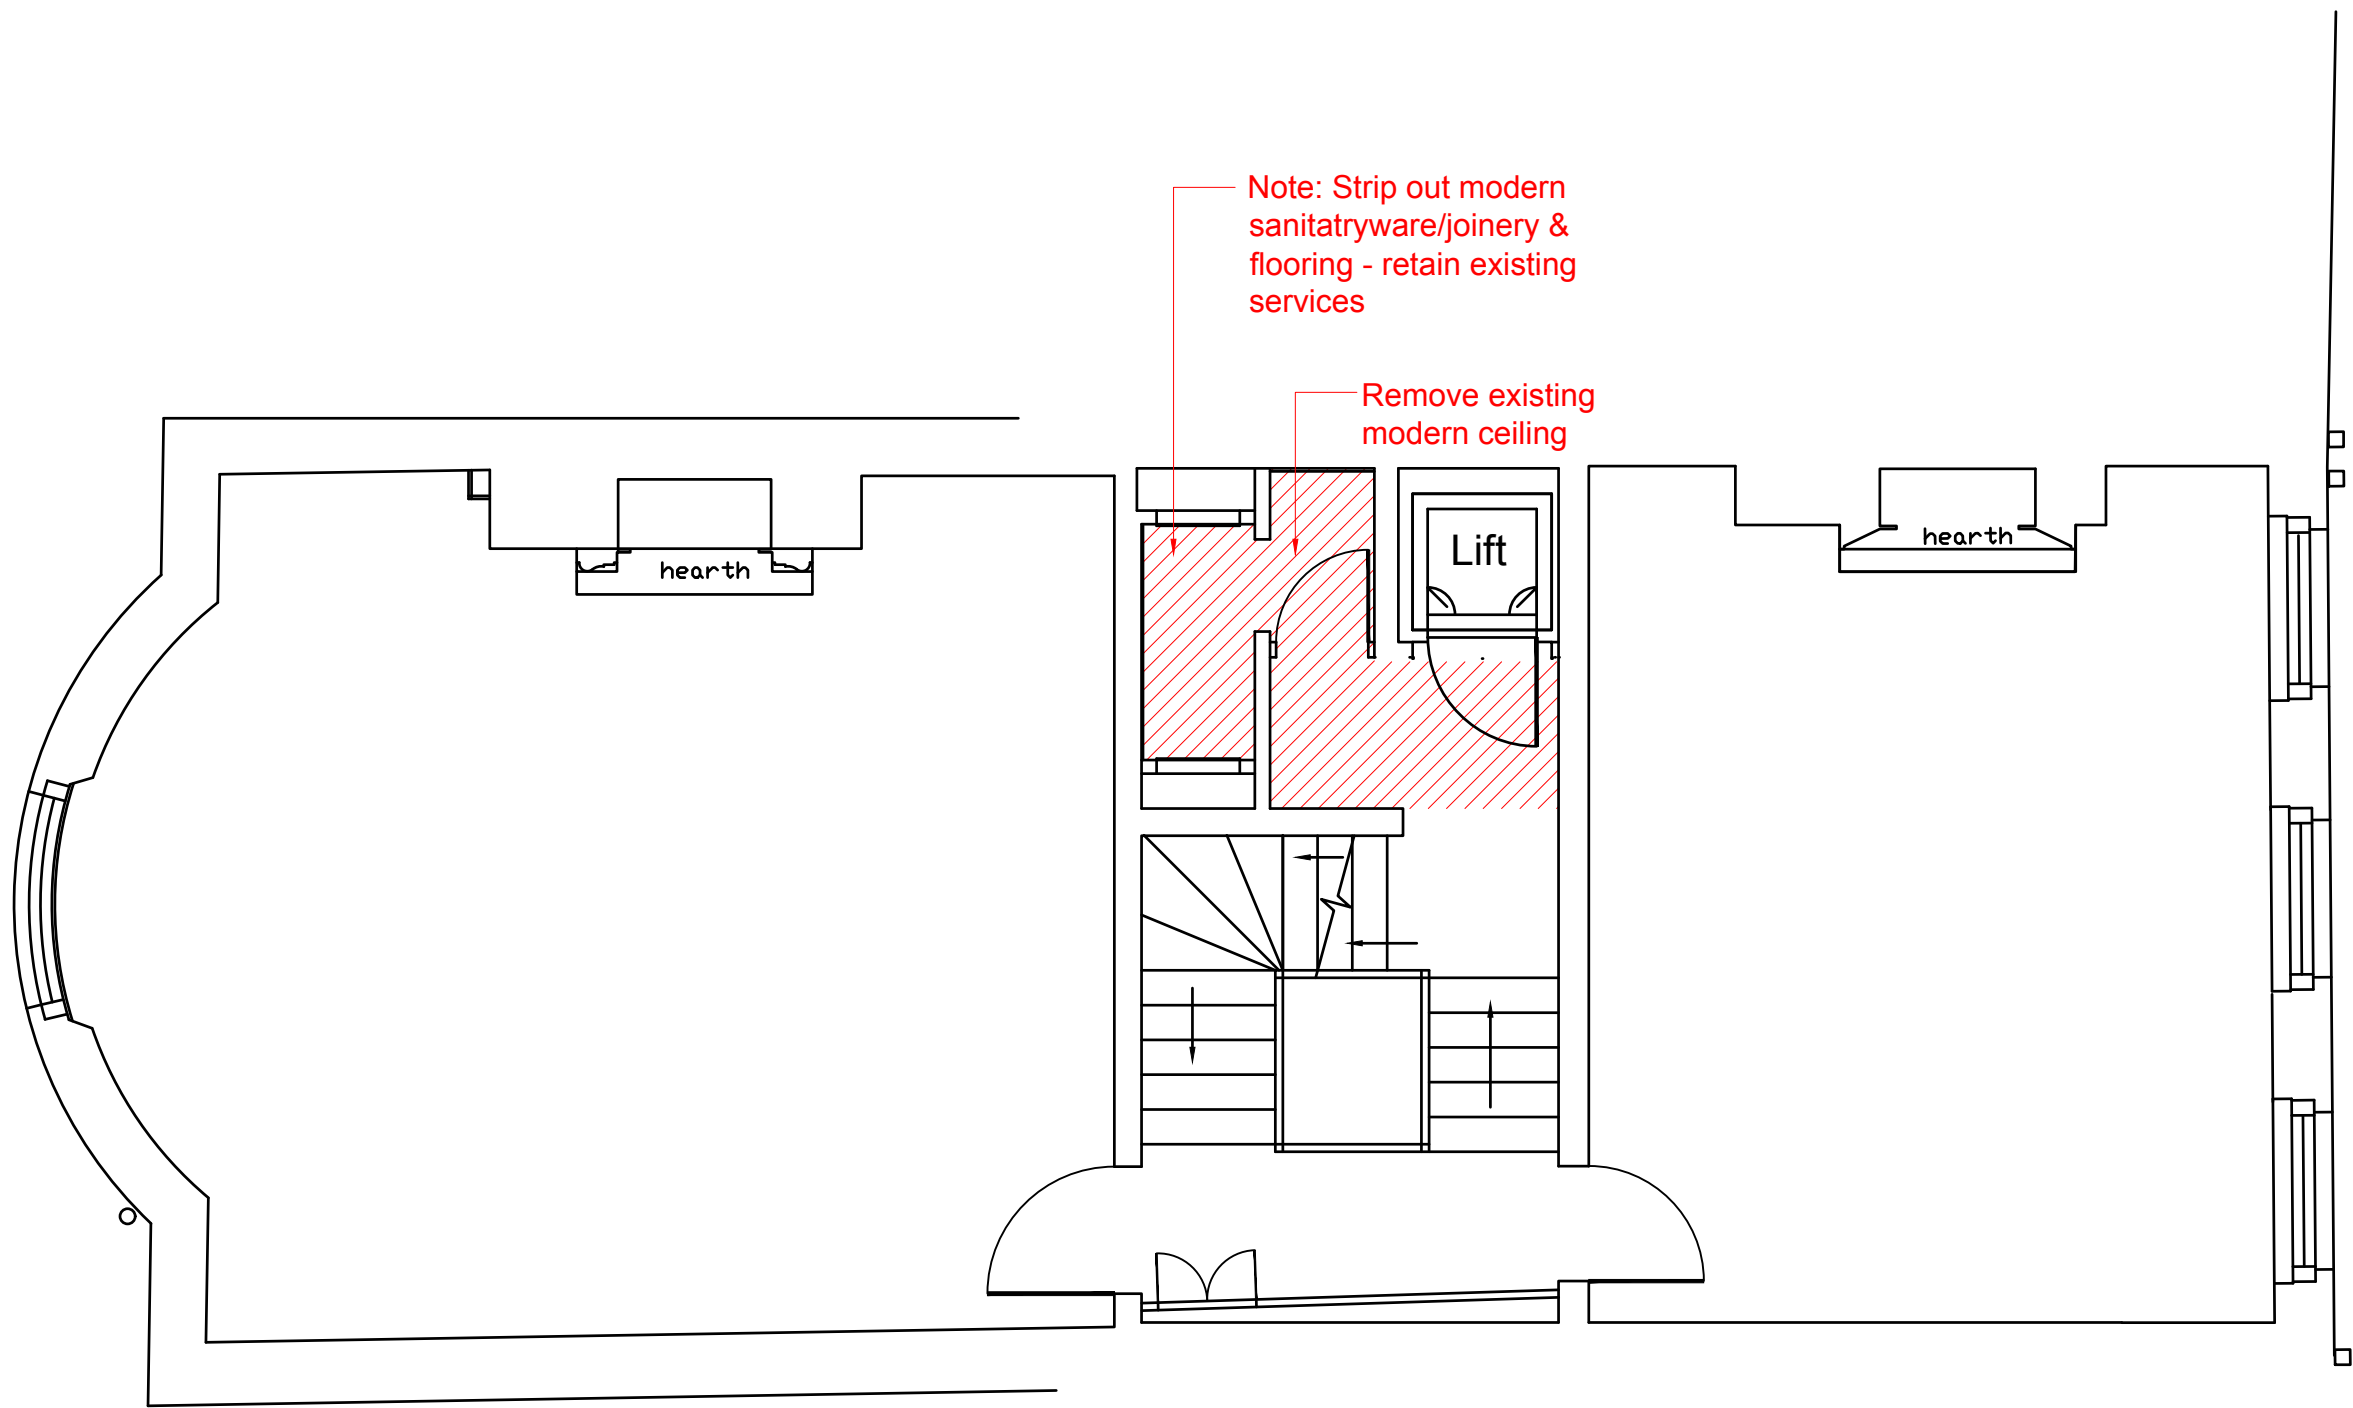

22 SOUTHAMPTON PLACE -SECOND FLOOR

Demolition

Remove all existing floor coverings

Existing ceilings to remain unless identified as removal

Washrooms, all associated rooms to have floor and wall coverings, ceilings, sanitary ware removed, retaining existing services


DEMO LEGEND	
Symbols shown are not to scale some symbols may not appear on the layout plan	
WALL STYLES	
	Existing structural wall
	Existing internal partition
	Demolished Partition
	Demolished Window Module
	Demolished Silicon Glass
	Demolished Single Door
	Demolished Hospital Door
	Demolished Double Door

Rev	Descriptive amendments	Drawn by	Date
Pre-Design - Construction - As Built			
PLANNING			
Client			
LABS			
Client Contact			
Site Address			
22 Southampton Place			
Holborn			
London WC1A 2BP			
Drawing Title			
DEMOLITION WORKS			
Account Manager			
Wayne Judge			
Designer/ Project Manager			
Monika Passey			
Scale	Drawn by	First Drawing Date	
1:50 @ A1	FL	20/03/2017	
Contract Number	Building	Floor	Detail Revision
0000	01	01/02	DEMO
First Floor			
322 High Holborn			
London			
WC1V 7PB			
T: +44 (0)20 7553 9500			
www.oktra.co.uk			


NOTES: This drawing is the exclusive Copyright of Oktra and may not be copied or handed to any Third parties without prior consent. All dimensions must be checked on site and not scaled from the drawing. All drawings and proposals are subject to approvals by statutory authorities




 First Floor
322 High Holborn
London
WC1V 7PB
T: +44 (0)20 7553 9500
www.oktra.co.uk

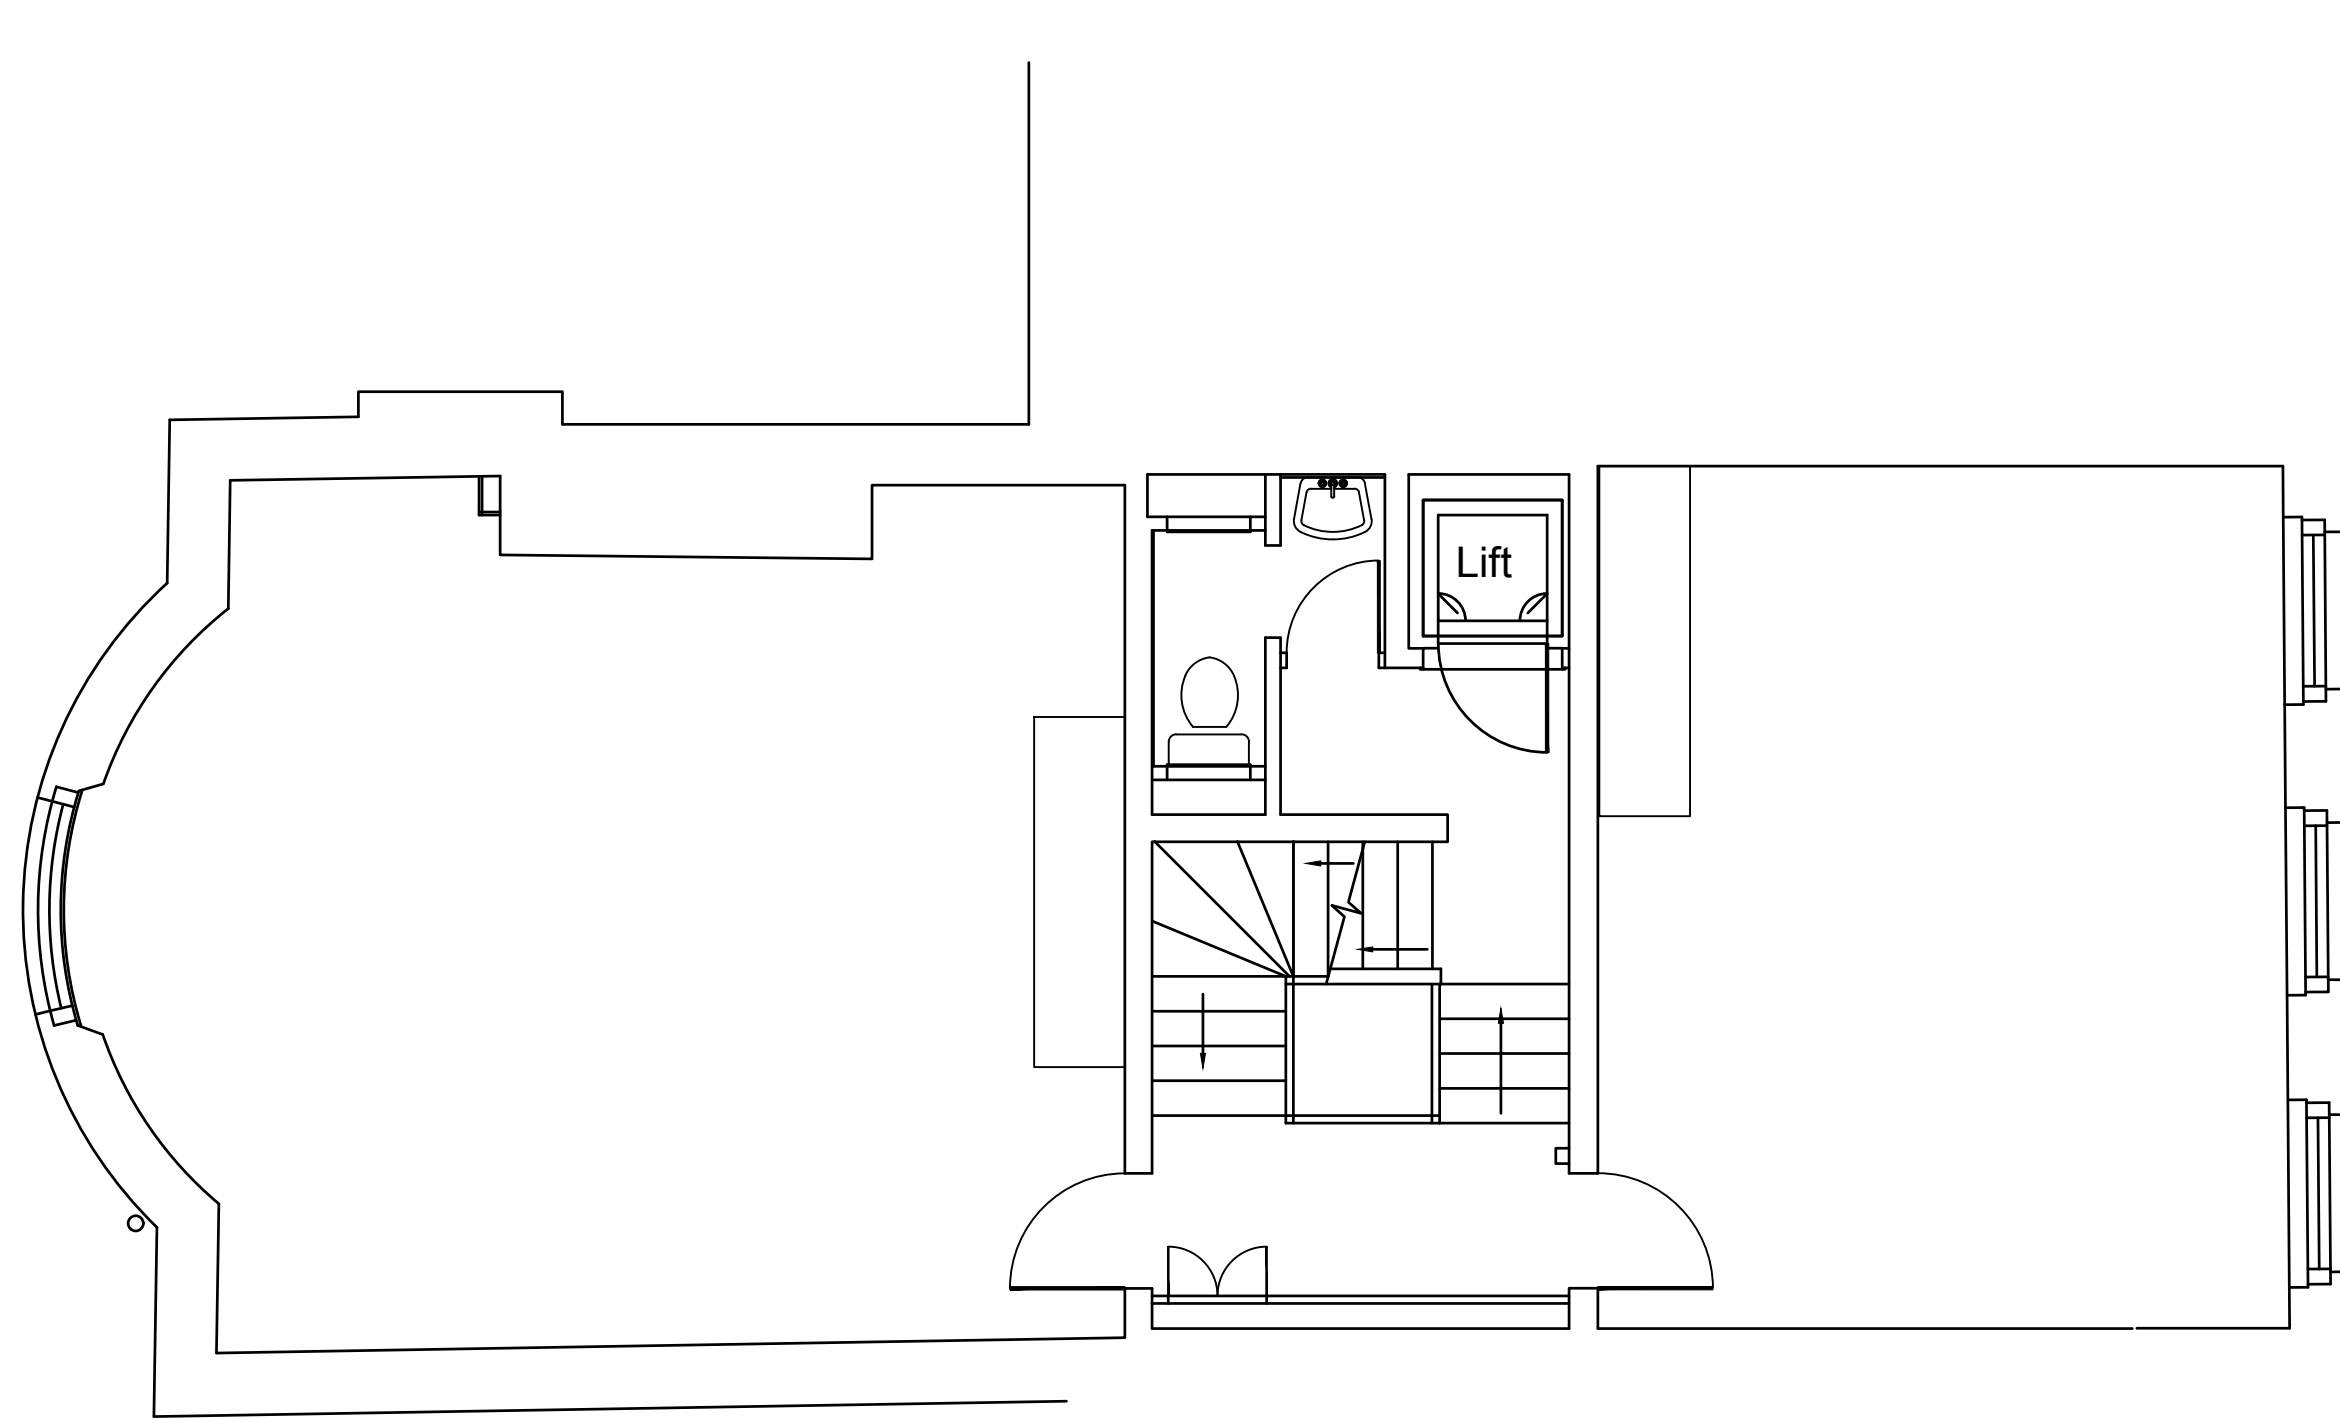

22 SOUTHAMPTON PLACE - THIRD FLOOR

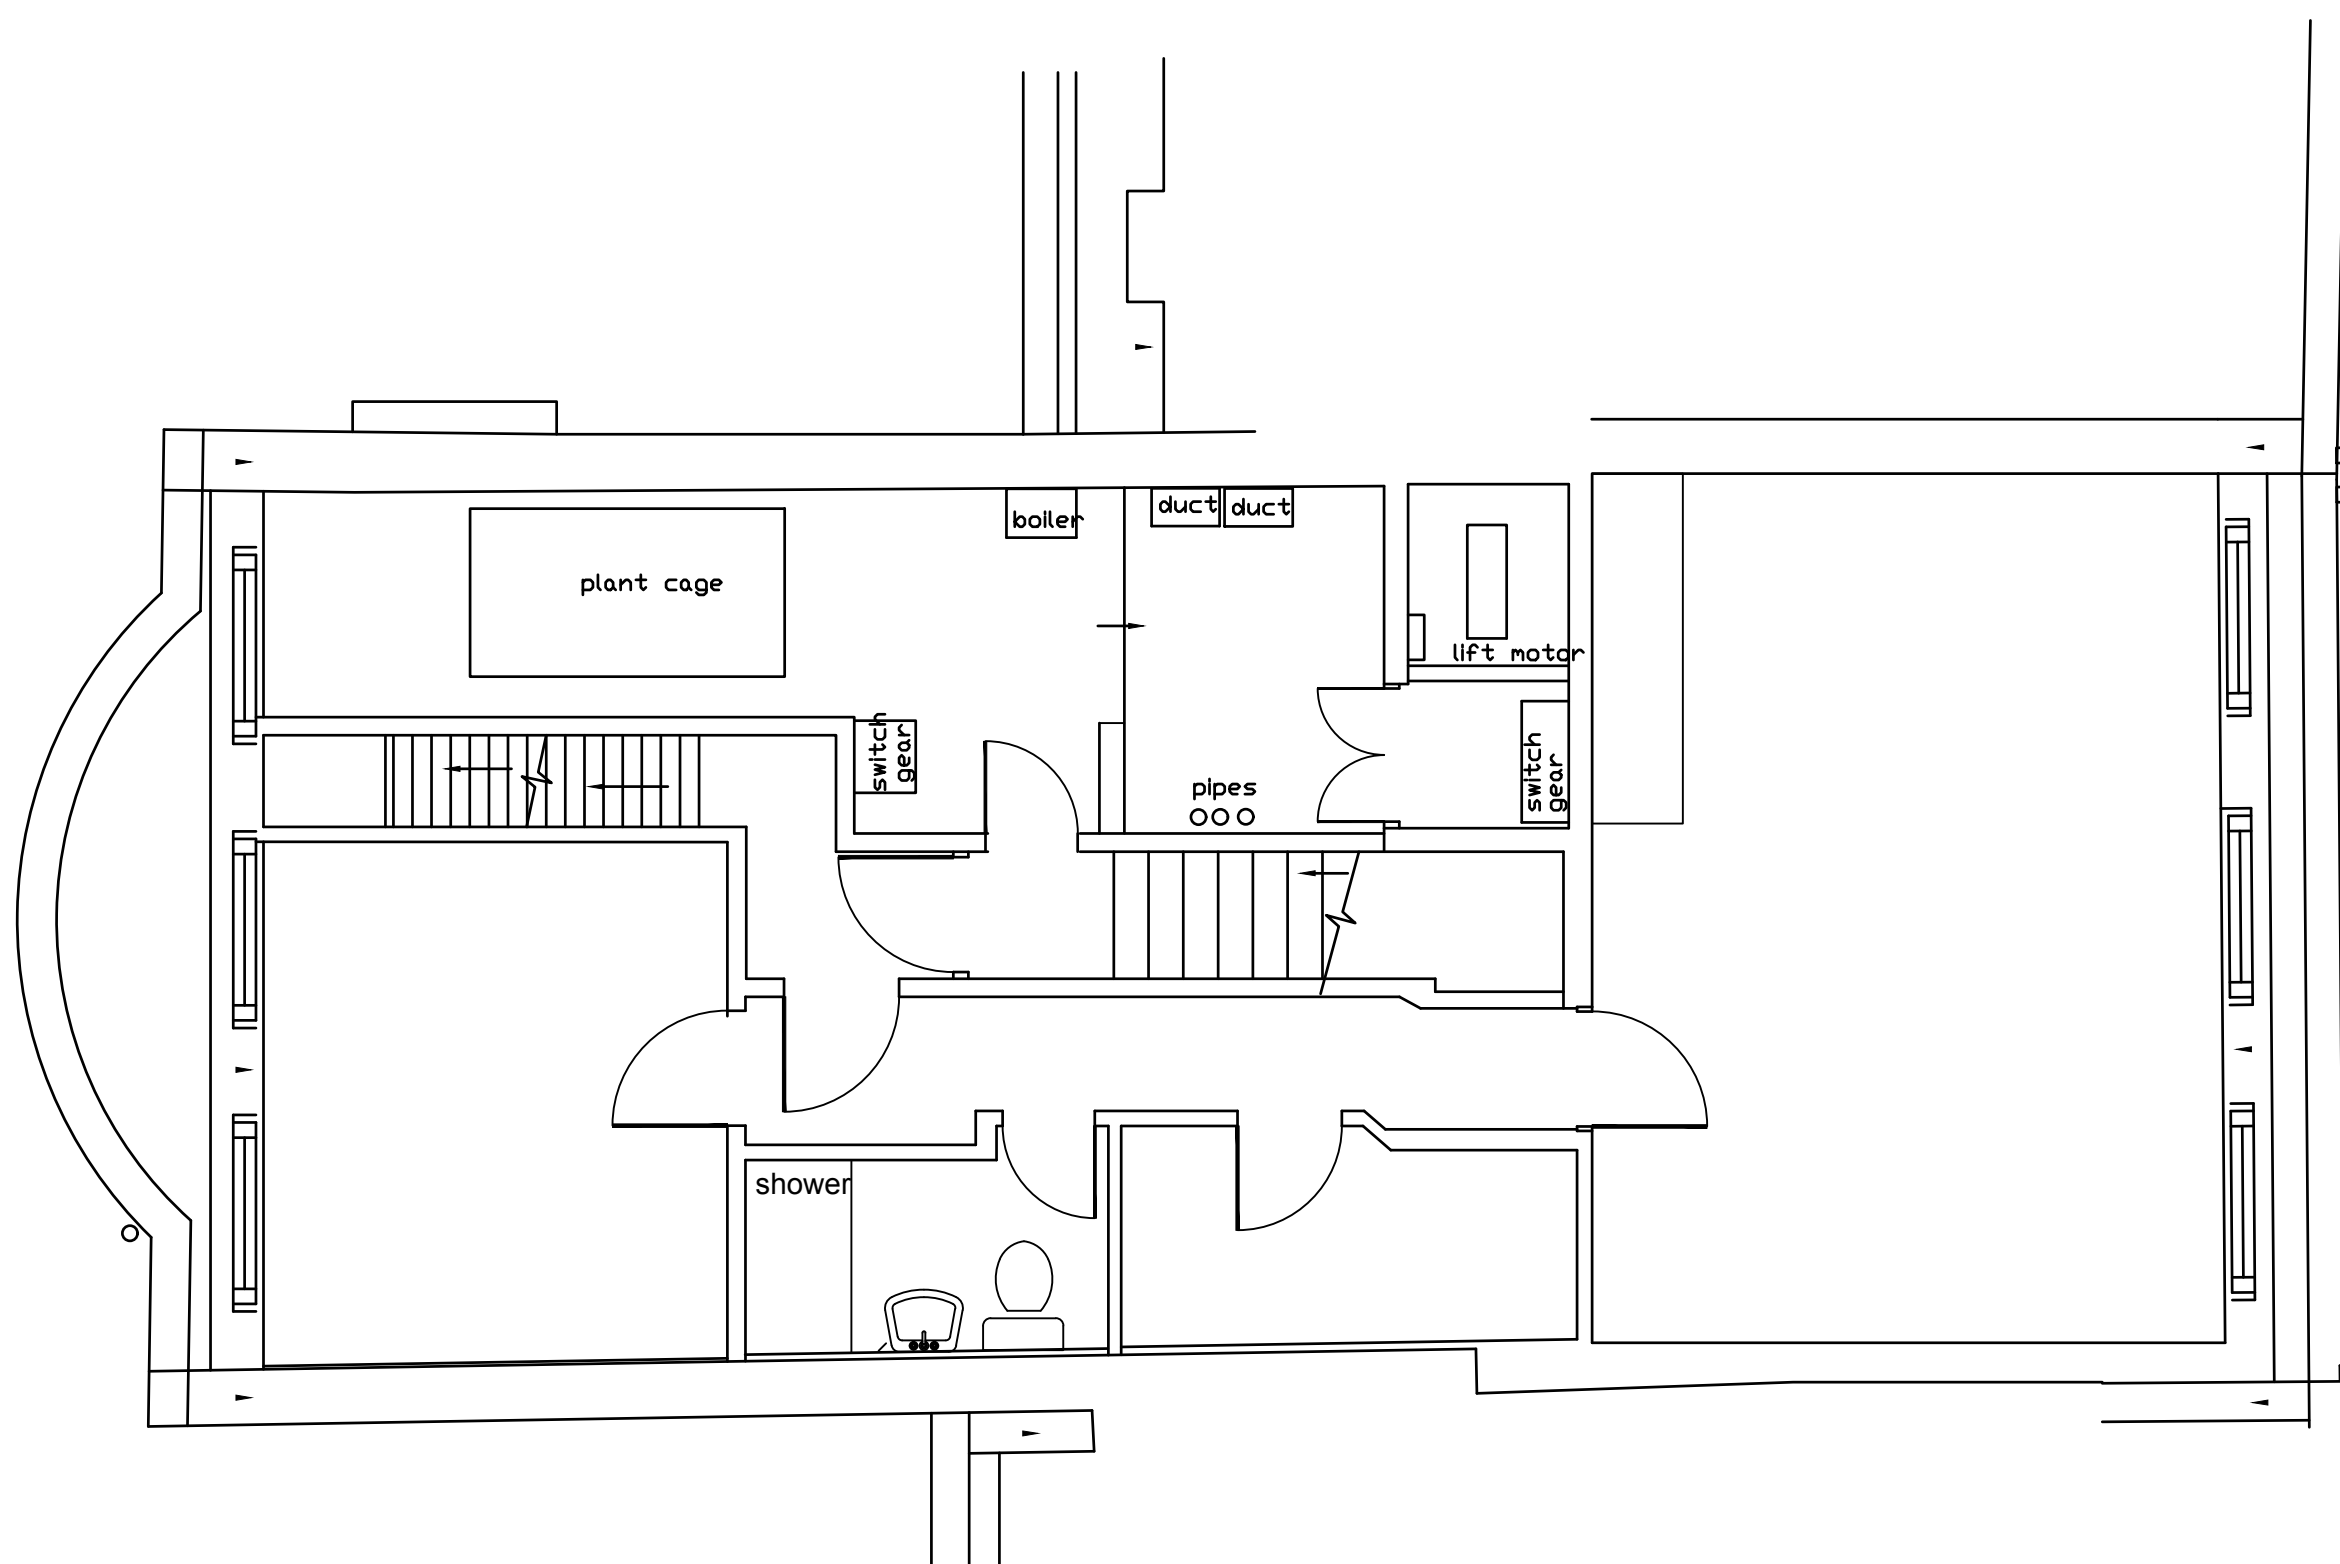

22 SOUTHAMPTON PLACE - FOURTH FLOOR

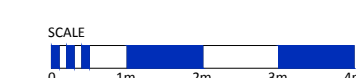[illegible]

Rev	Descriptive amendments	Drawn by	Date
-----	------------------------	----------	------

Pre-Design - Construction - As Built

Pre-Design - Construction - As Built

Client

LABS

Client Contact

Site Address

22 Southampton Place
Holborn
London WC1A 2BP

Drawing Title

EXISTING GENERAL ARRANGEMENT

Account Manager

Wayne Judge

Wayne Sudge
Designer/ Project Manager

Monika Passey


Scale	Drawn by	First Drawing Date
1:50 @ A1	FL	20/03/2017

Contract Number	Building	Floor	Detail	Revision
0000	01	03/04	EX	




First Floor
322 High Holborn
London
WC1V 7PB
T: +44 (0)20 7553 9500

www.oktra.co.uk

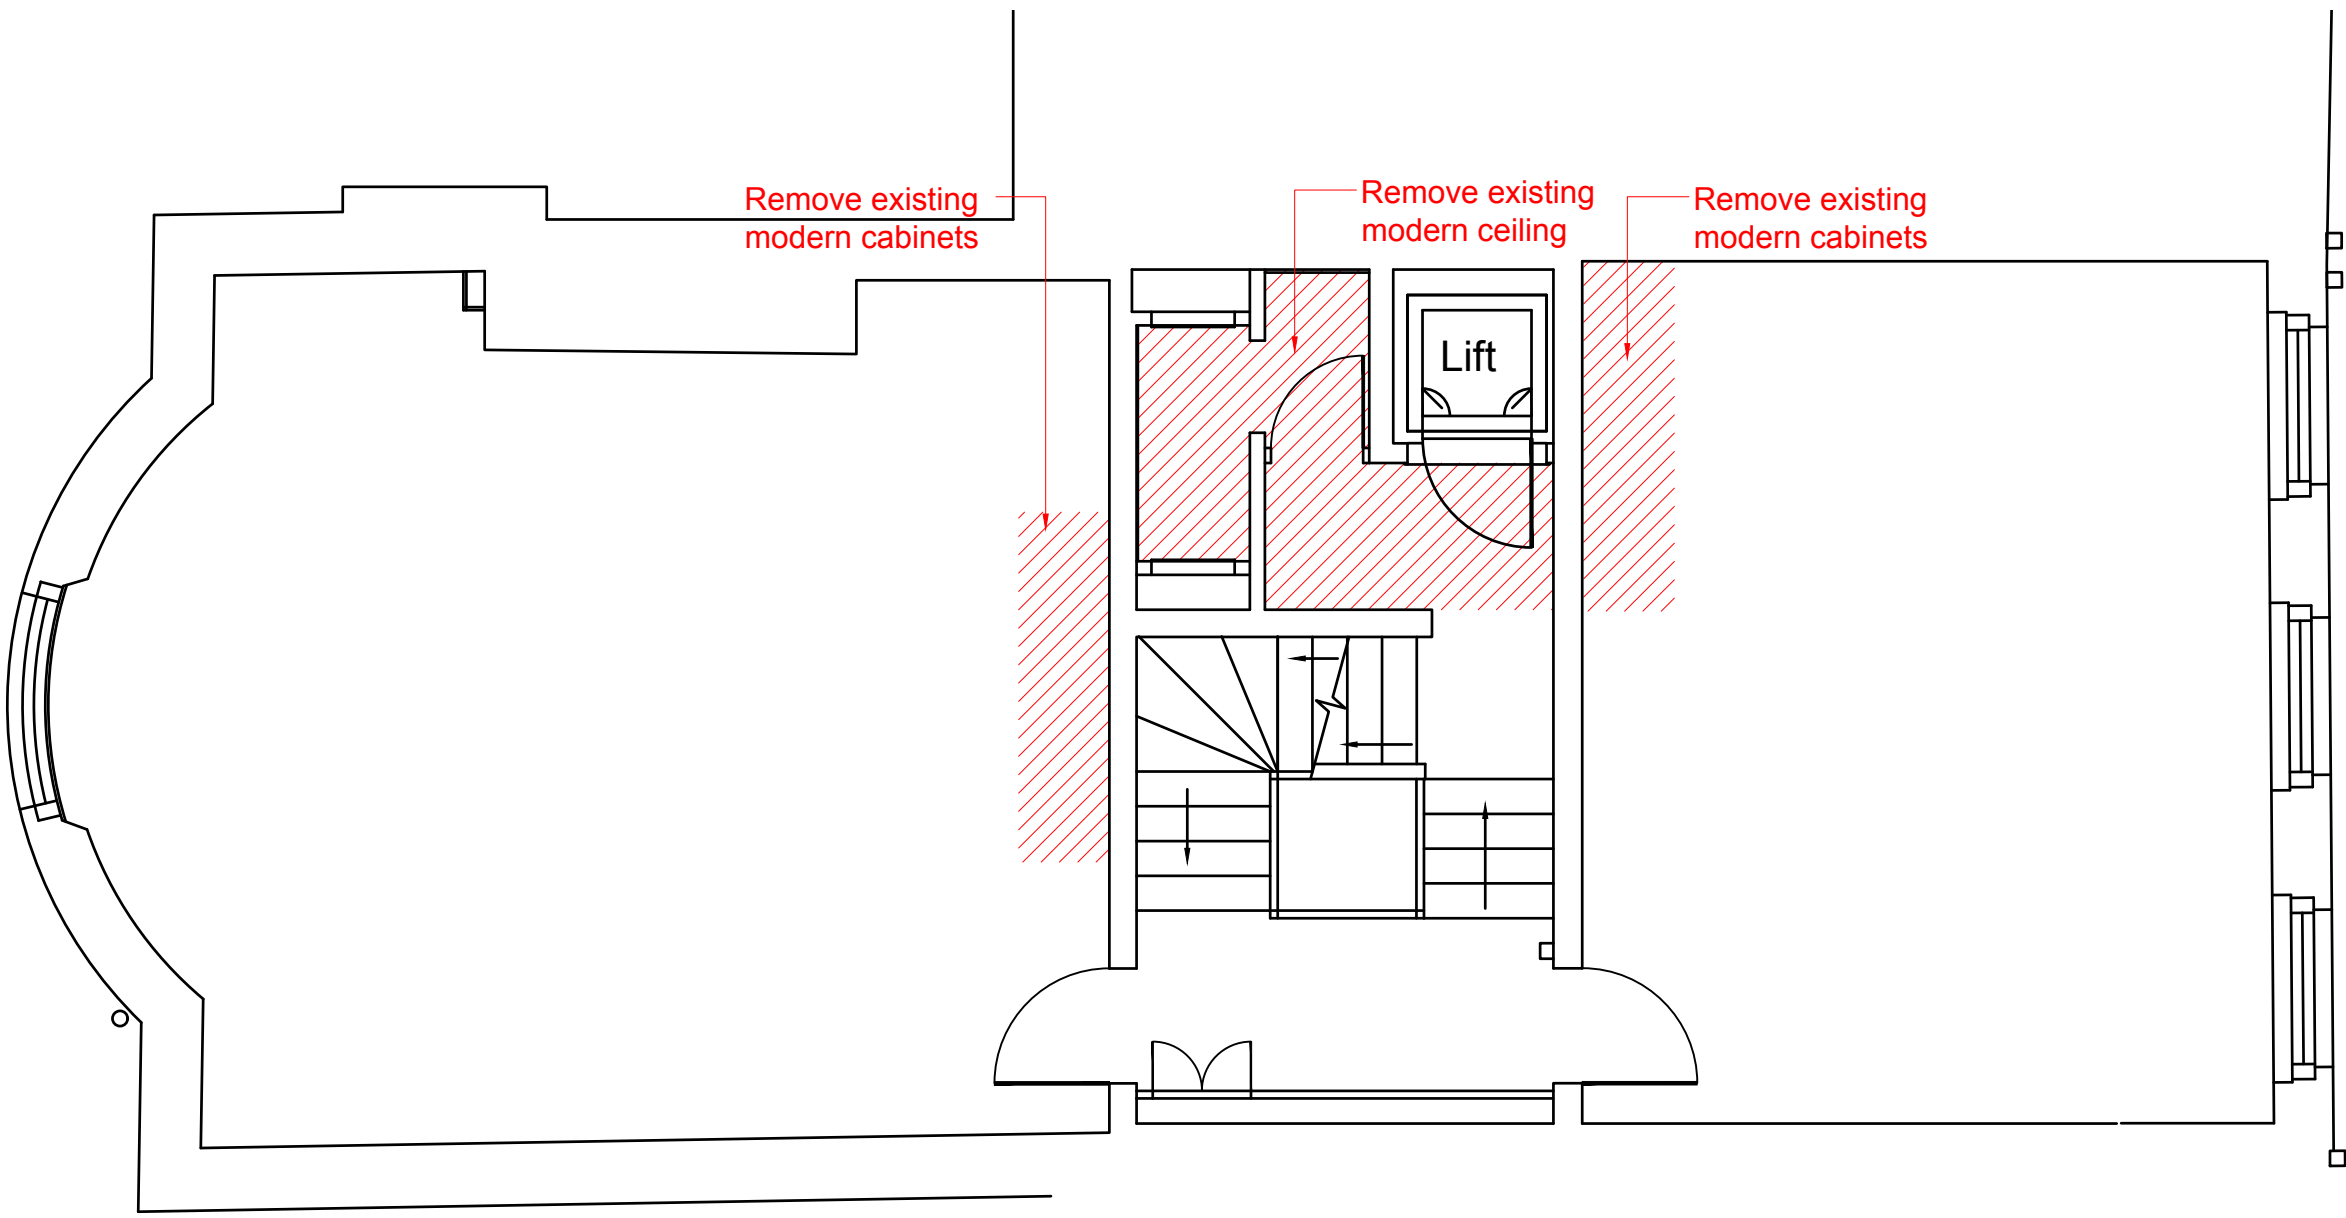

22 SOUTHAMPTON PLACE - THIRD FLOOR

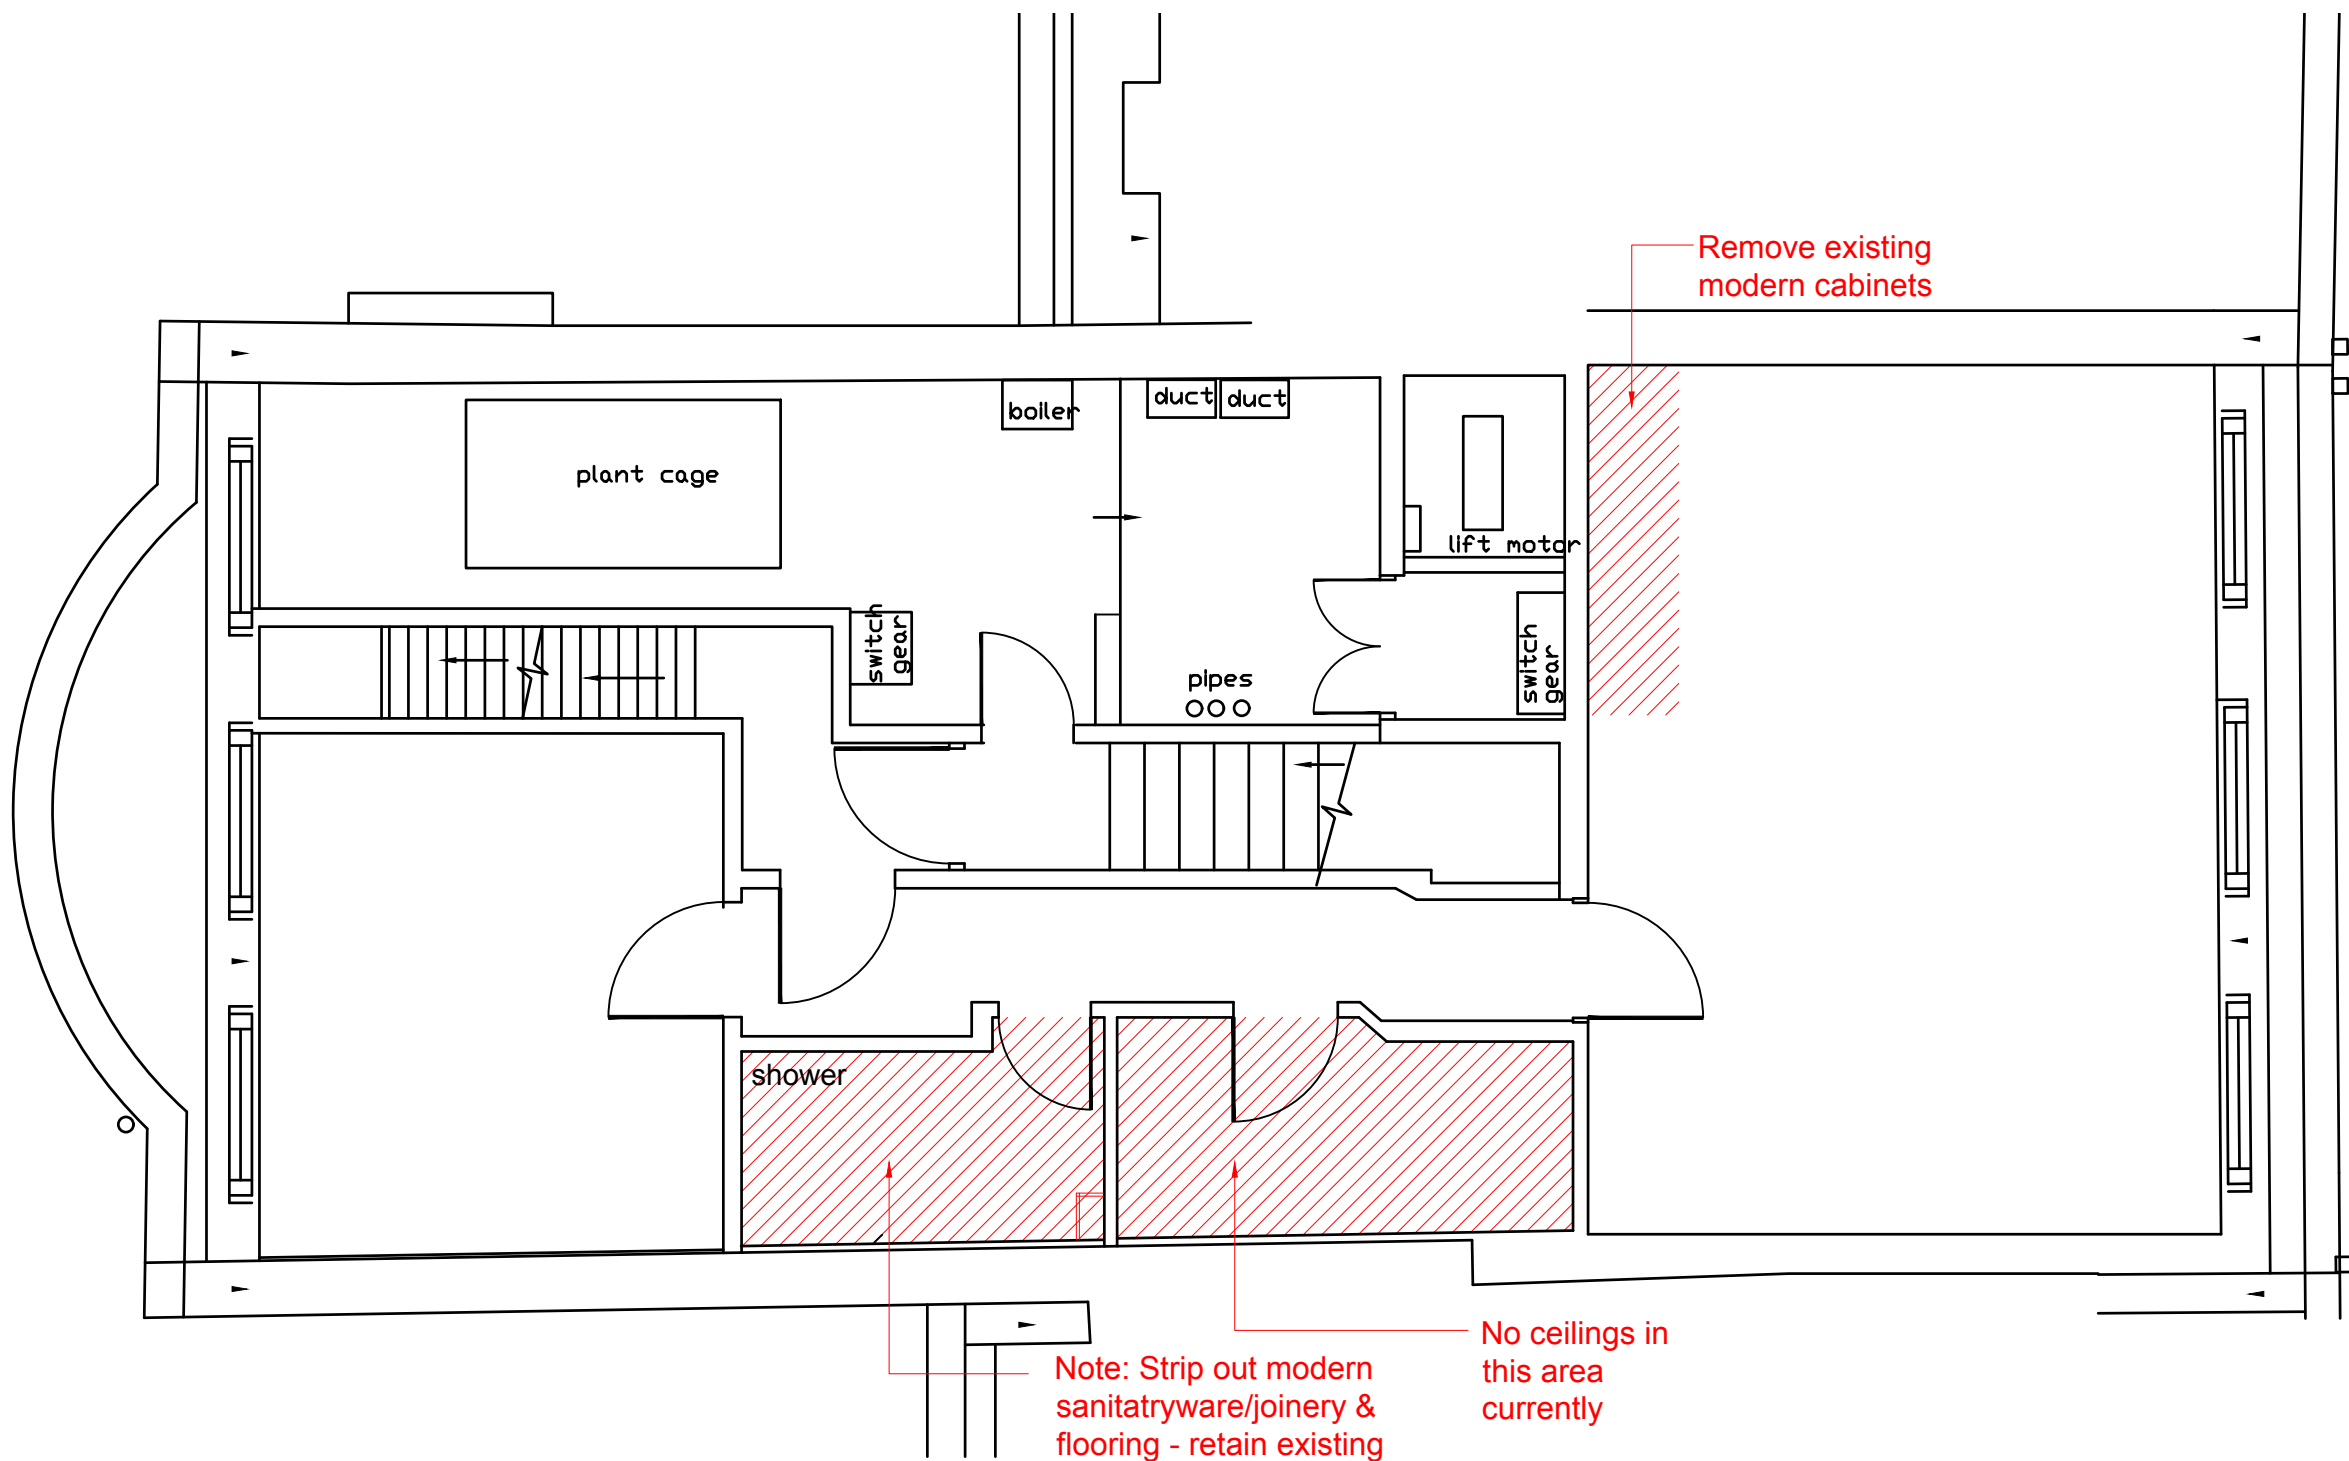

22 SOUTHAMPTON PLACE - FOURTH FLOOR

Demolition

Remove all existing floor coverings

Existing ceilings to remain unless identified as removal

Washrooms, all associated rooms to have floor and wall coverings, ceilings, sanitary ware removed, retaining existing services

DEMO LEGEND	
Symbols shown are not to scale some symbols may not appear on the layout plan	
WALL STYLES	
	Existing structural wall
	Existing internal partition
	Demolished Partition
	Demolished Window Module
	Demolished Silicon Glass
	Demolished Single Door
	Demolished Hospital Door
	Demolished Double Door

Rev	Descriptive amendments	Drawn by	Date
-----	------------------------	----------	------

Pre-Design - Construction - As Built			
PLANNING			

Client

LABS

Client Contact

Site Address
22 Southampton Place
Holborn
London WC1A 2BP

Drawing Title
DEMOLITION WORKS

Account Manager
Wayne Judge

Designer/ Project Manager
Monika Passey

Scale
1:50 @ A1

Drawn by
FL

First Drawing Date
20/03/2017

Contract Number
0000


Building
01


Floor
03/04

Detail
DEMO


Revision

First Floor
322 High Holborn
London
WC1V 7PB
T: +44 (0)20 7553 9500
www.oktra.co.uk

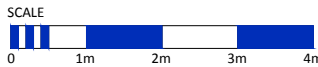

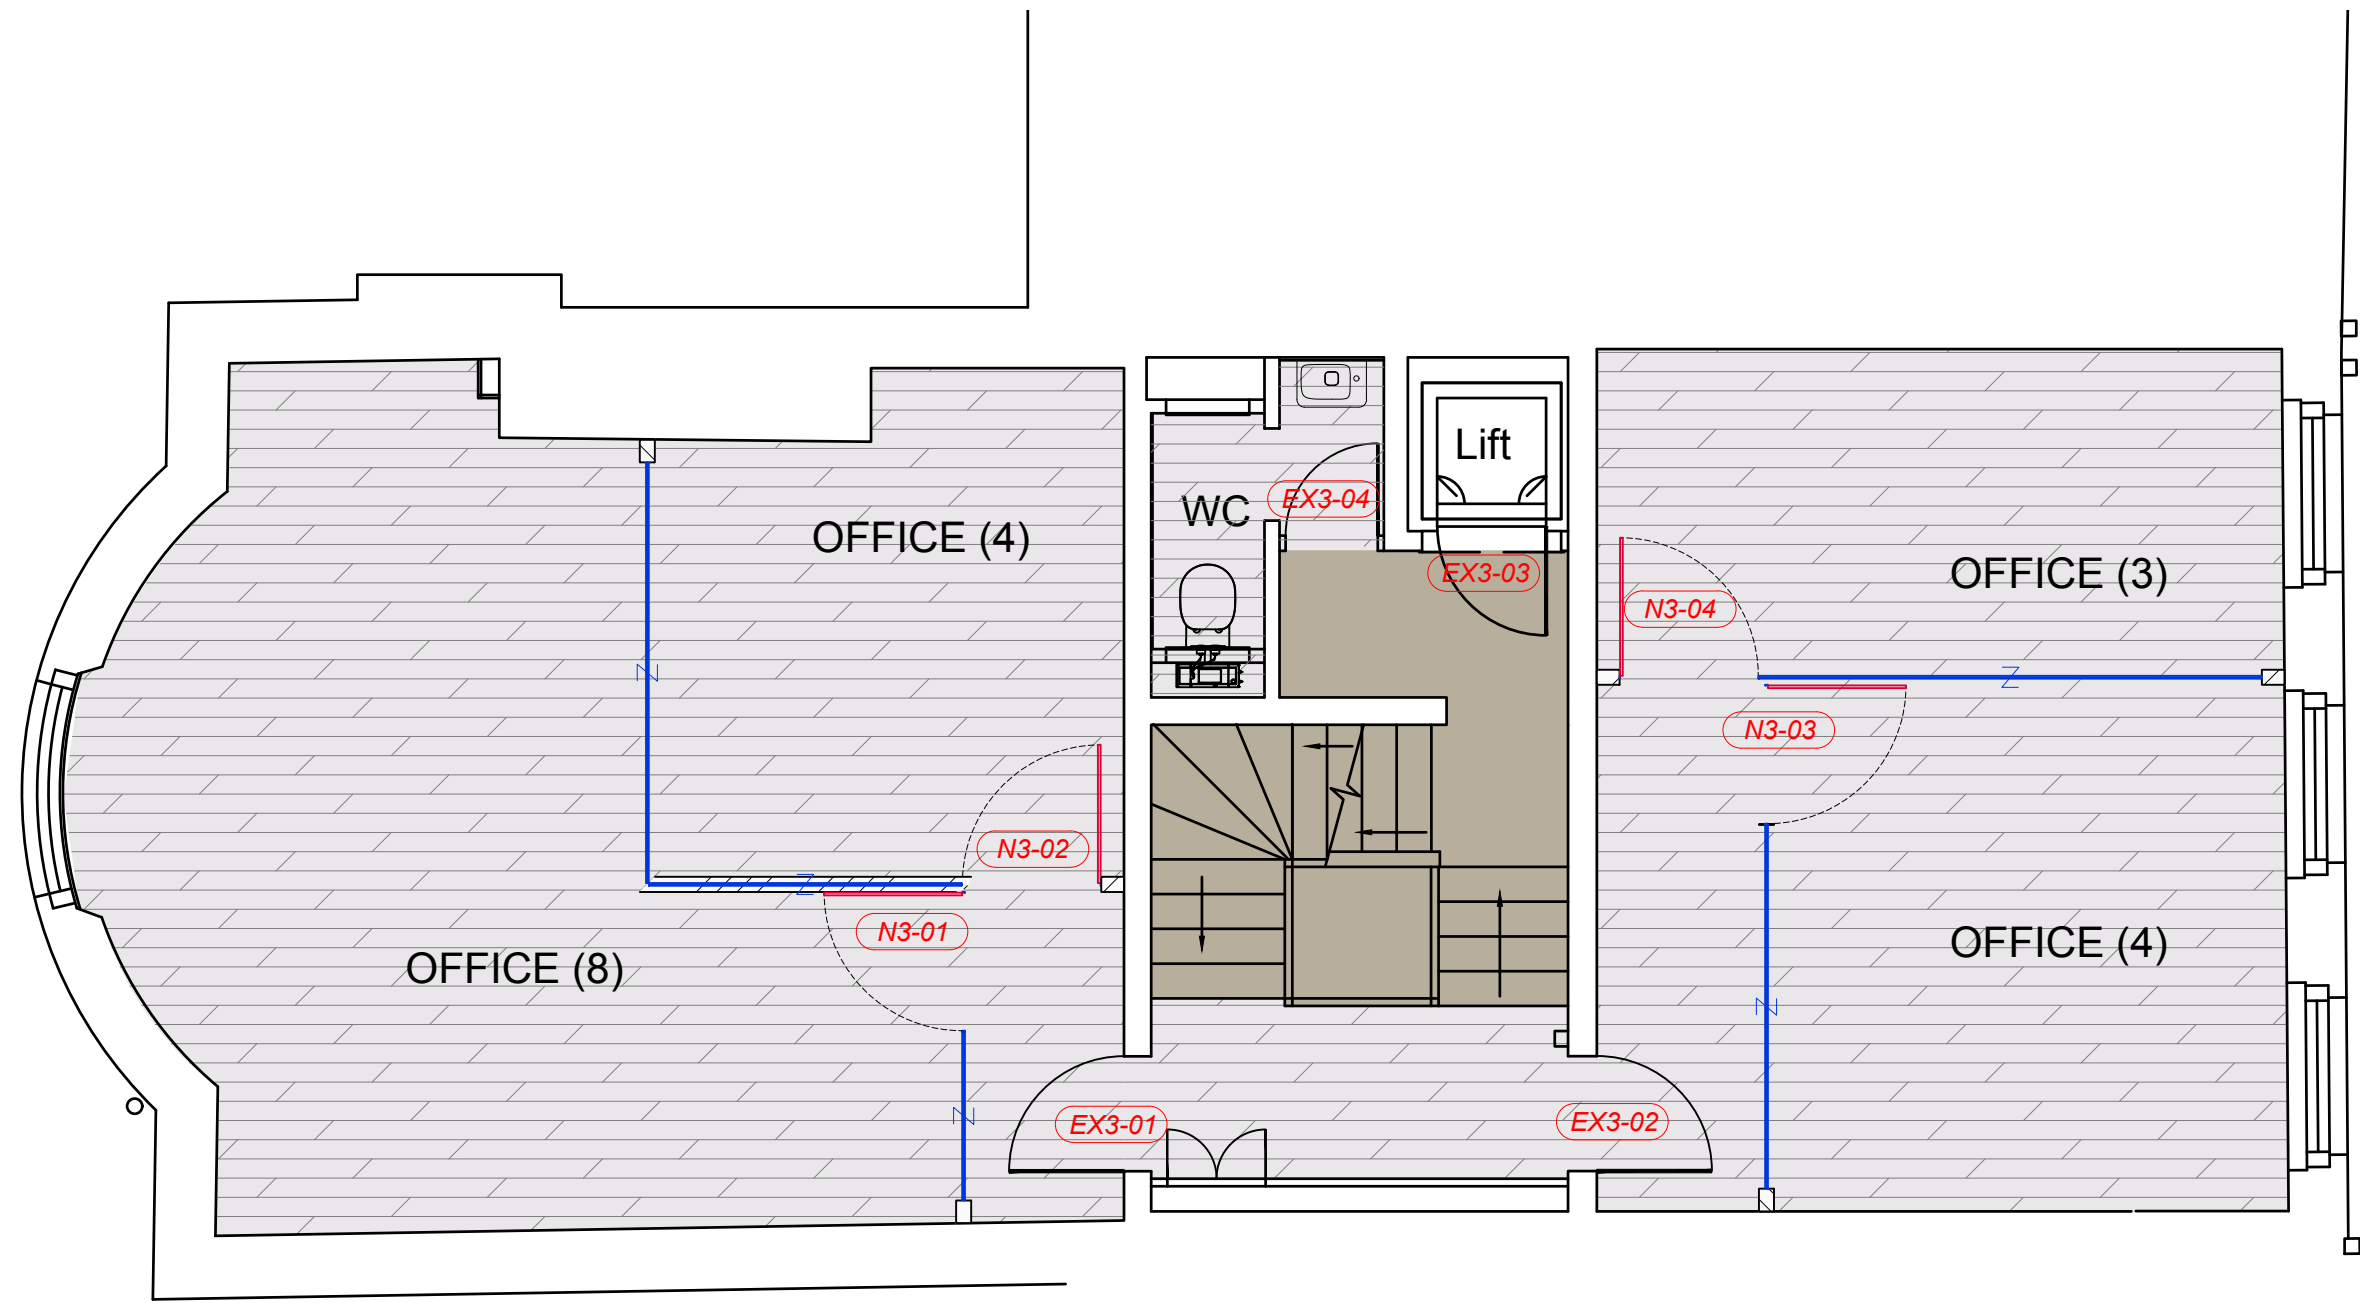

22 SOUTHAMPTON PLACE - THIRD FLOOR

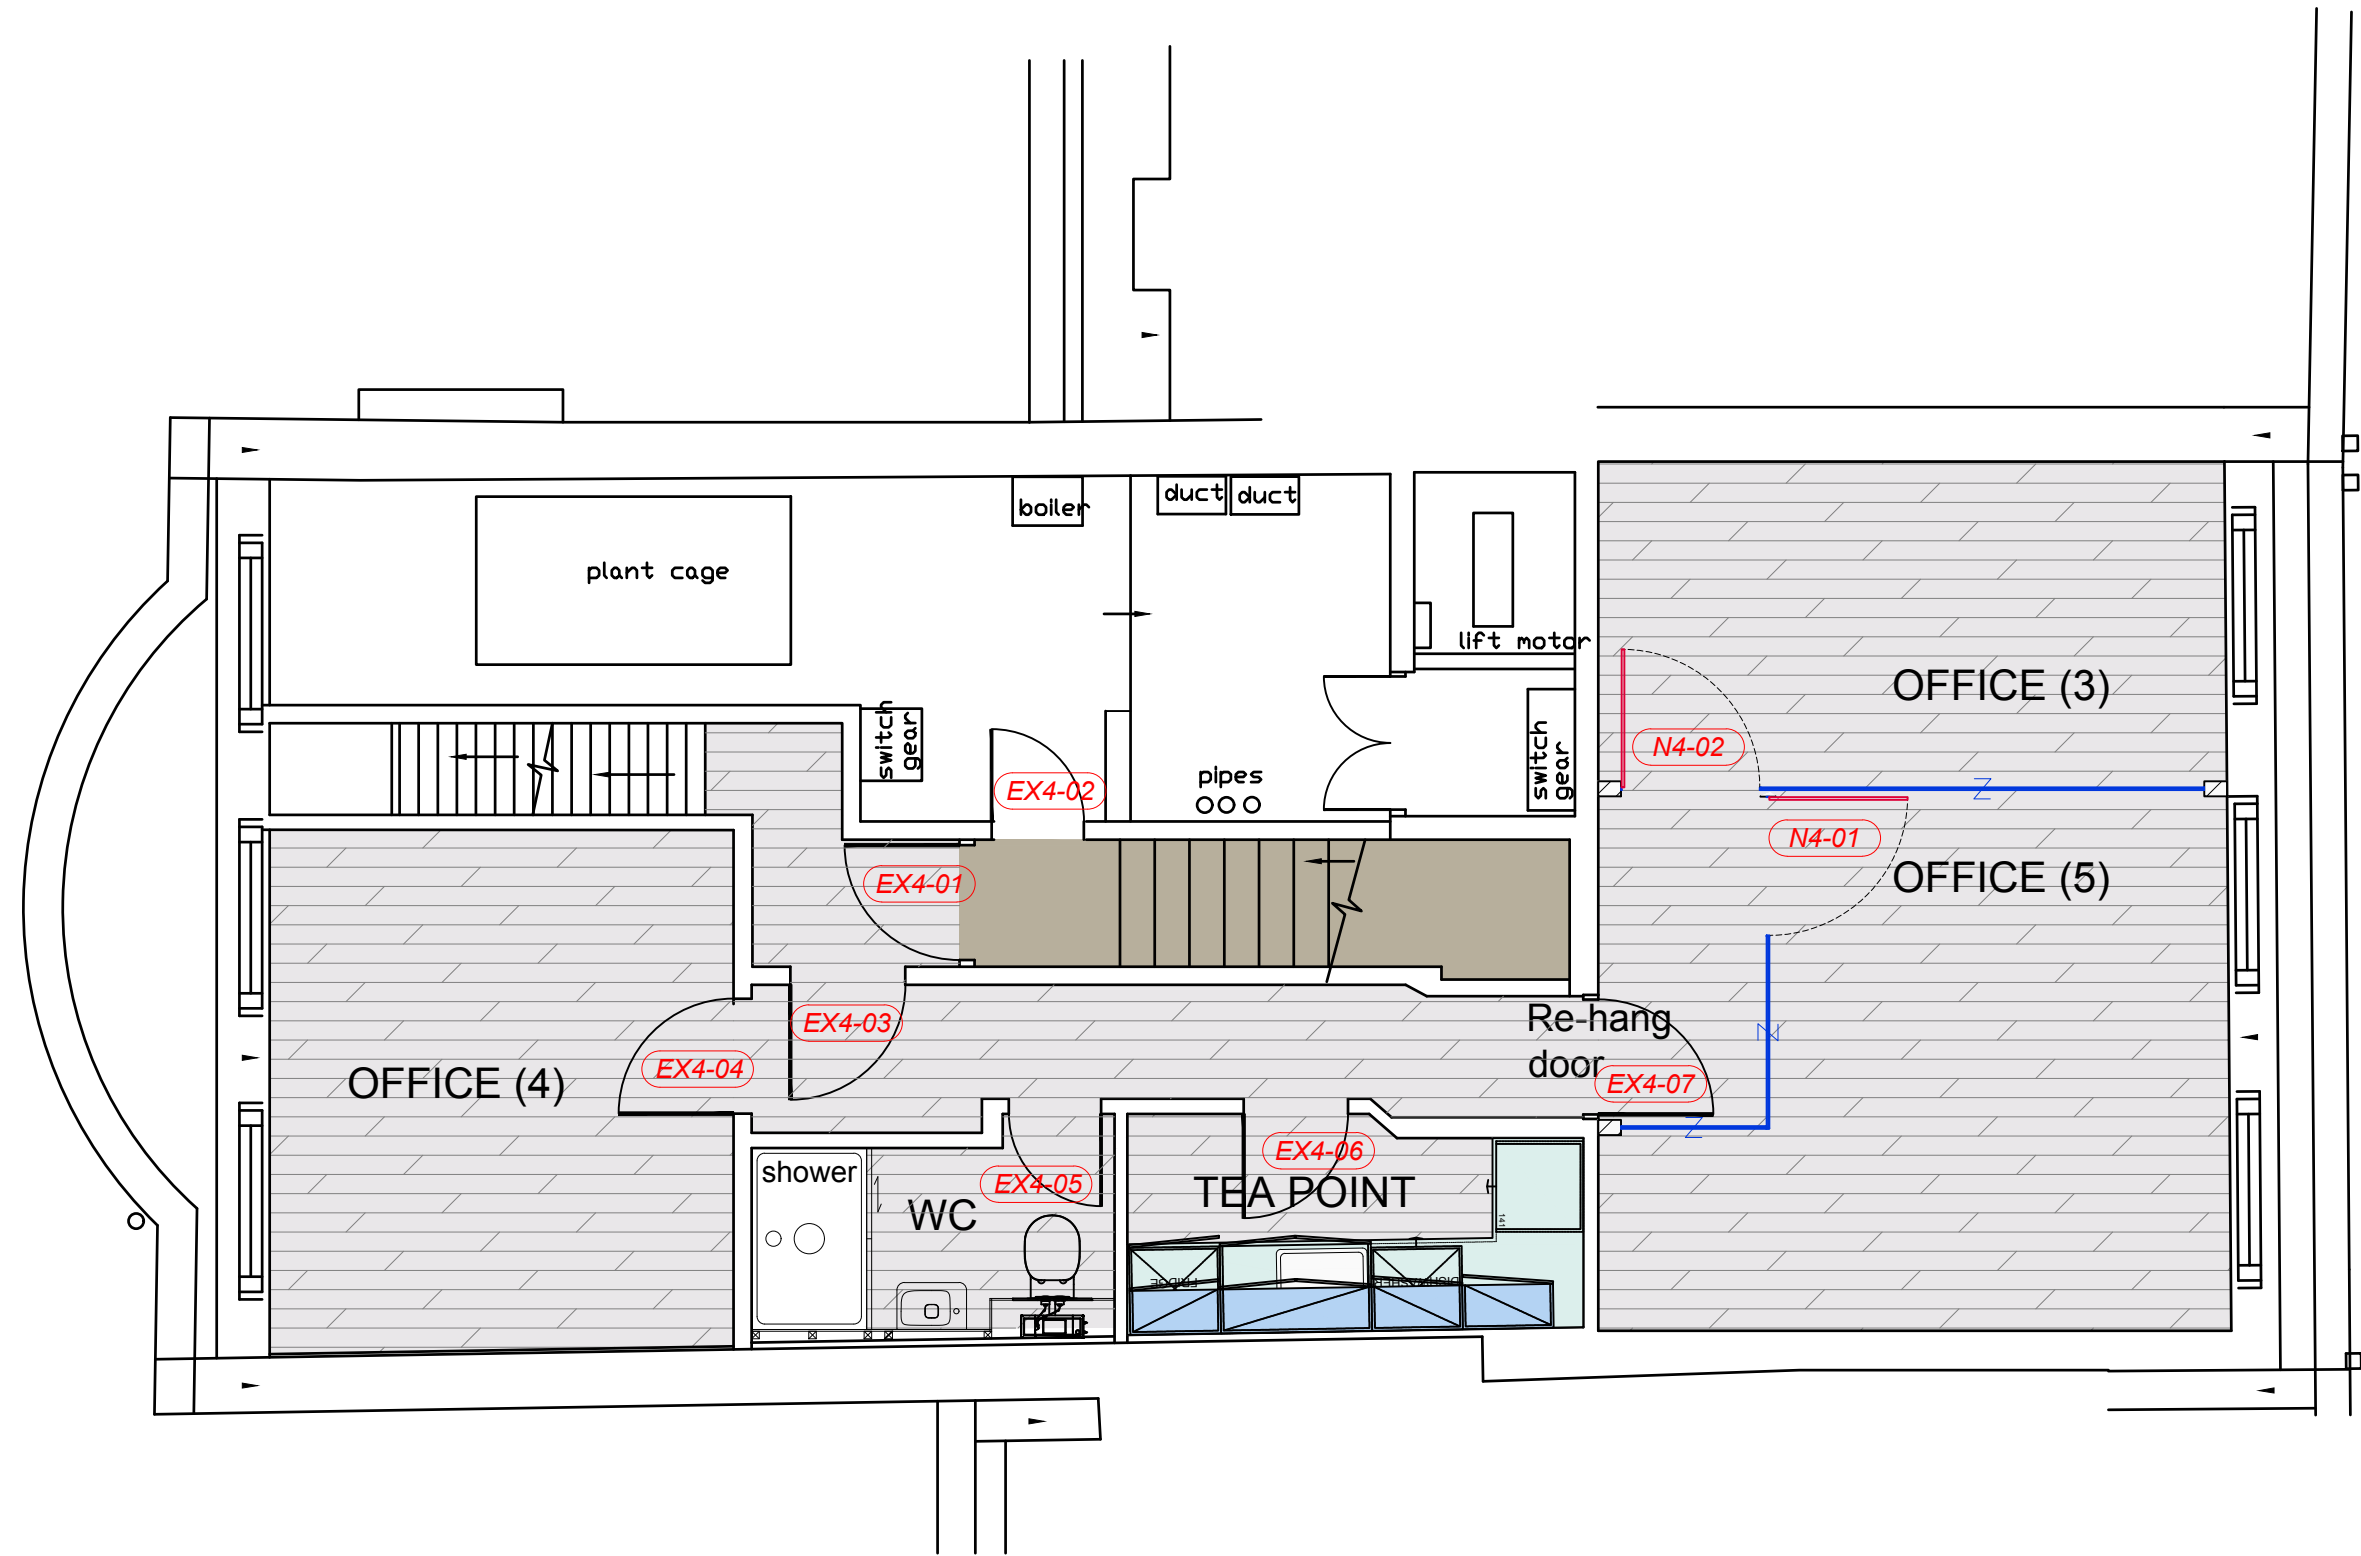

22 SOUTHAMPTON PLACE - FOURTH FLOOR

GENERAL ARRANGEMENT LEGEND

Symbols shown are not to scale
some symbols may not appear on the layout plan

WALL STYLES

Existing structural wall

Existing internal partition

New single skin partition - 75mm

New single skin partition - 100mm

New double skin partition - 100mm

Demolished Partition

New low partition

New half height partition with glazing above

GLAZING DETAILS

Existing glazed module

Existing silicon glass

New single glazed module

New double glazed module

New single glazed silicon glass

New double glazed silicon glass

DOOR DETAILS

Existing door

New Solid door

New Frameless glass door

New Framed glass door

New Aluminium Framed glass door

New Oversized Solid door

New Special Oversized door

New Glass Sliding Door

New Pivot Door

EX1=Existing 1st floor

EX1=Relocated 1st floor

N1=New 1st floor

FINISHES LAYOUT LEGEND

Symbols shown are not to scale
some symbols may not appear on the layout plan

FLOOR FINISHES

Wood effect vinyl flooring - 1
To replace modern carpet floor, to be laid over

Wood effect vinyl flooring - 2
To replace modern carpet floor, to be laid over

Barrier Matting
To replace modern carpet floor, to be laid over

Carpet - broadloom to stairs
To replace modern carpet floor, to be laid over

Rev	Descriptive amendments	Drawn by	Date
	Pre-Design - Construction - As Built		

Client

LABS

Client Contact

Site Address
22 Southampton Place
Holborn
London WC1A 2BP

Drawing Title
PROPOSED GENERAL ARRANGEMENT

Account Manager
Wayne Judge

Designer/ Project Manager
Monika Passey

Scale	Drawn by	First Drawing Date
1:50 @ A1	FL	20/03/2017

Contract Number	Building	Floor	Detail	Revision
0000	01	03/04	GA	

oktra

First Floor
322 High Holborn
London
WC1V 7PB
T: +44 (0)20 7553 9500
www.oktra.co.uk

[illegible]

Pre-Design - Construction - As Built

PLANNING


Client Contact

Drawing Title
EXISTING ROOF PLAN


Designer/ Project Manager

Scale








 First Floor
322 High Holborn
London
WC1V 7PB
T: +44 (0)20 7553 9500
www.oktra.co.uk

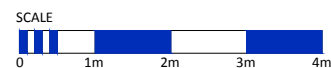

A	Drawing first produced	FL		06-03-17
Rev	Descriptive amendments	Drawn by	Date	
Pre-Design - Construction - As Built				
PRE DESIGN				
Client				
LABS				
Client Contact				
Site Address 22 Southampton Place Holborn London WC1A 2BP				
Drawing Title EXISTING - ALL FLOORSELEVATION				
Account Manager				
Designer/ Project Manager Dominic Duggan				
Scale 1:50	Drawn by FL		First Drawing Date 06/03/2017	
Contract Number 57159	Building 01	Floor ALL	Detail EX	Revision
		First Floor 322 High Holborn London WC1V 7PB T: +44 (0)20 7553 9500 www.oktra.co.uk		

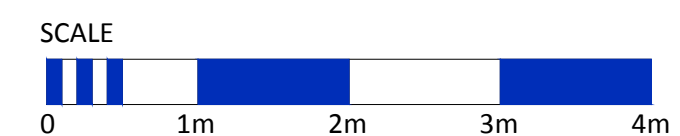

     NOTES: This drawing is the exclusive Copyright of Oktra and may not be copied or handed to any Third parties without prior consent. All dimensions must be checked on site and not scaled from the drawing. All drawings and proposals are subject to approvals by statutory authorities.

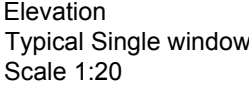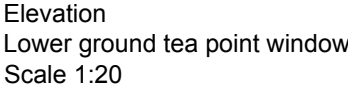

www.oktra.co.uk



Monika Passey

Designer

Oktra Ltd

**First Floor, 322 High Holborn, London, WC1V 7PB,
UK**

T: +44 (0)788 038 0878 E: mpassey@oktra.co.uk