


Information contained within this drawing is the sole copyright of NMA Studio Ltd. and is not to be reproduced without express permission. No implied licence exists. This drawing not to be used for land transfer or valuation purposes. Do not scale from this drawing. All dimensions & levels are to be checked on site by the contractor. Issued for purposes indicated only. Drawing errors and omissions to be reported to the architect.

Notes

P1 8/6/17 Issued to Client

Revisions

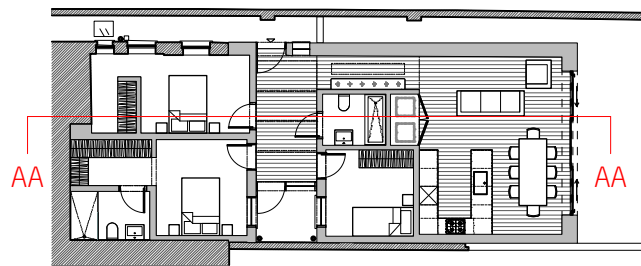

Farrington House
First Floor
105-107 Farrington Road
London EC1R 3BU
T +447792949233
niki@nmastudio.co.uk


Client
Mr T. Korn

Project
119 Canfield Gardens

Drawing Title
As-Built Section AA

Status	Drawn	Checked
Planning	-	NM
Scale	Date	
1:50@A1, 1:100@A3	Jun 17	

Drwg. No. & Revision
135-GS01_P1

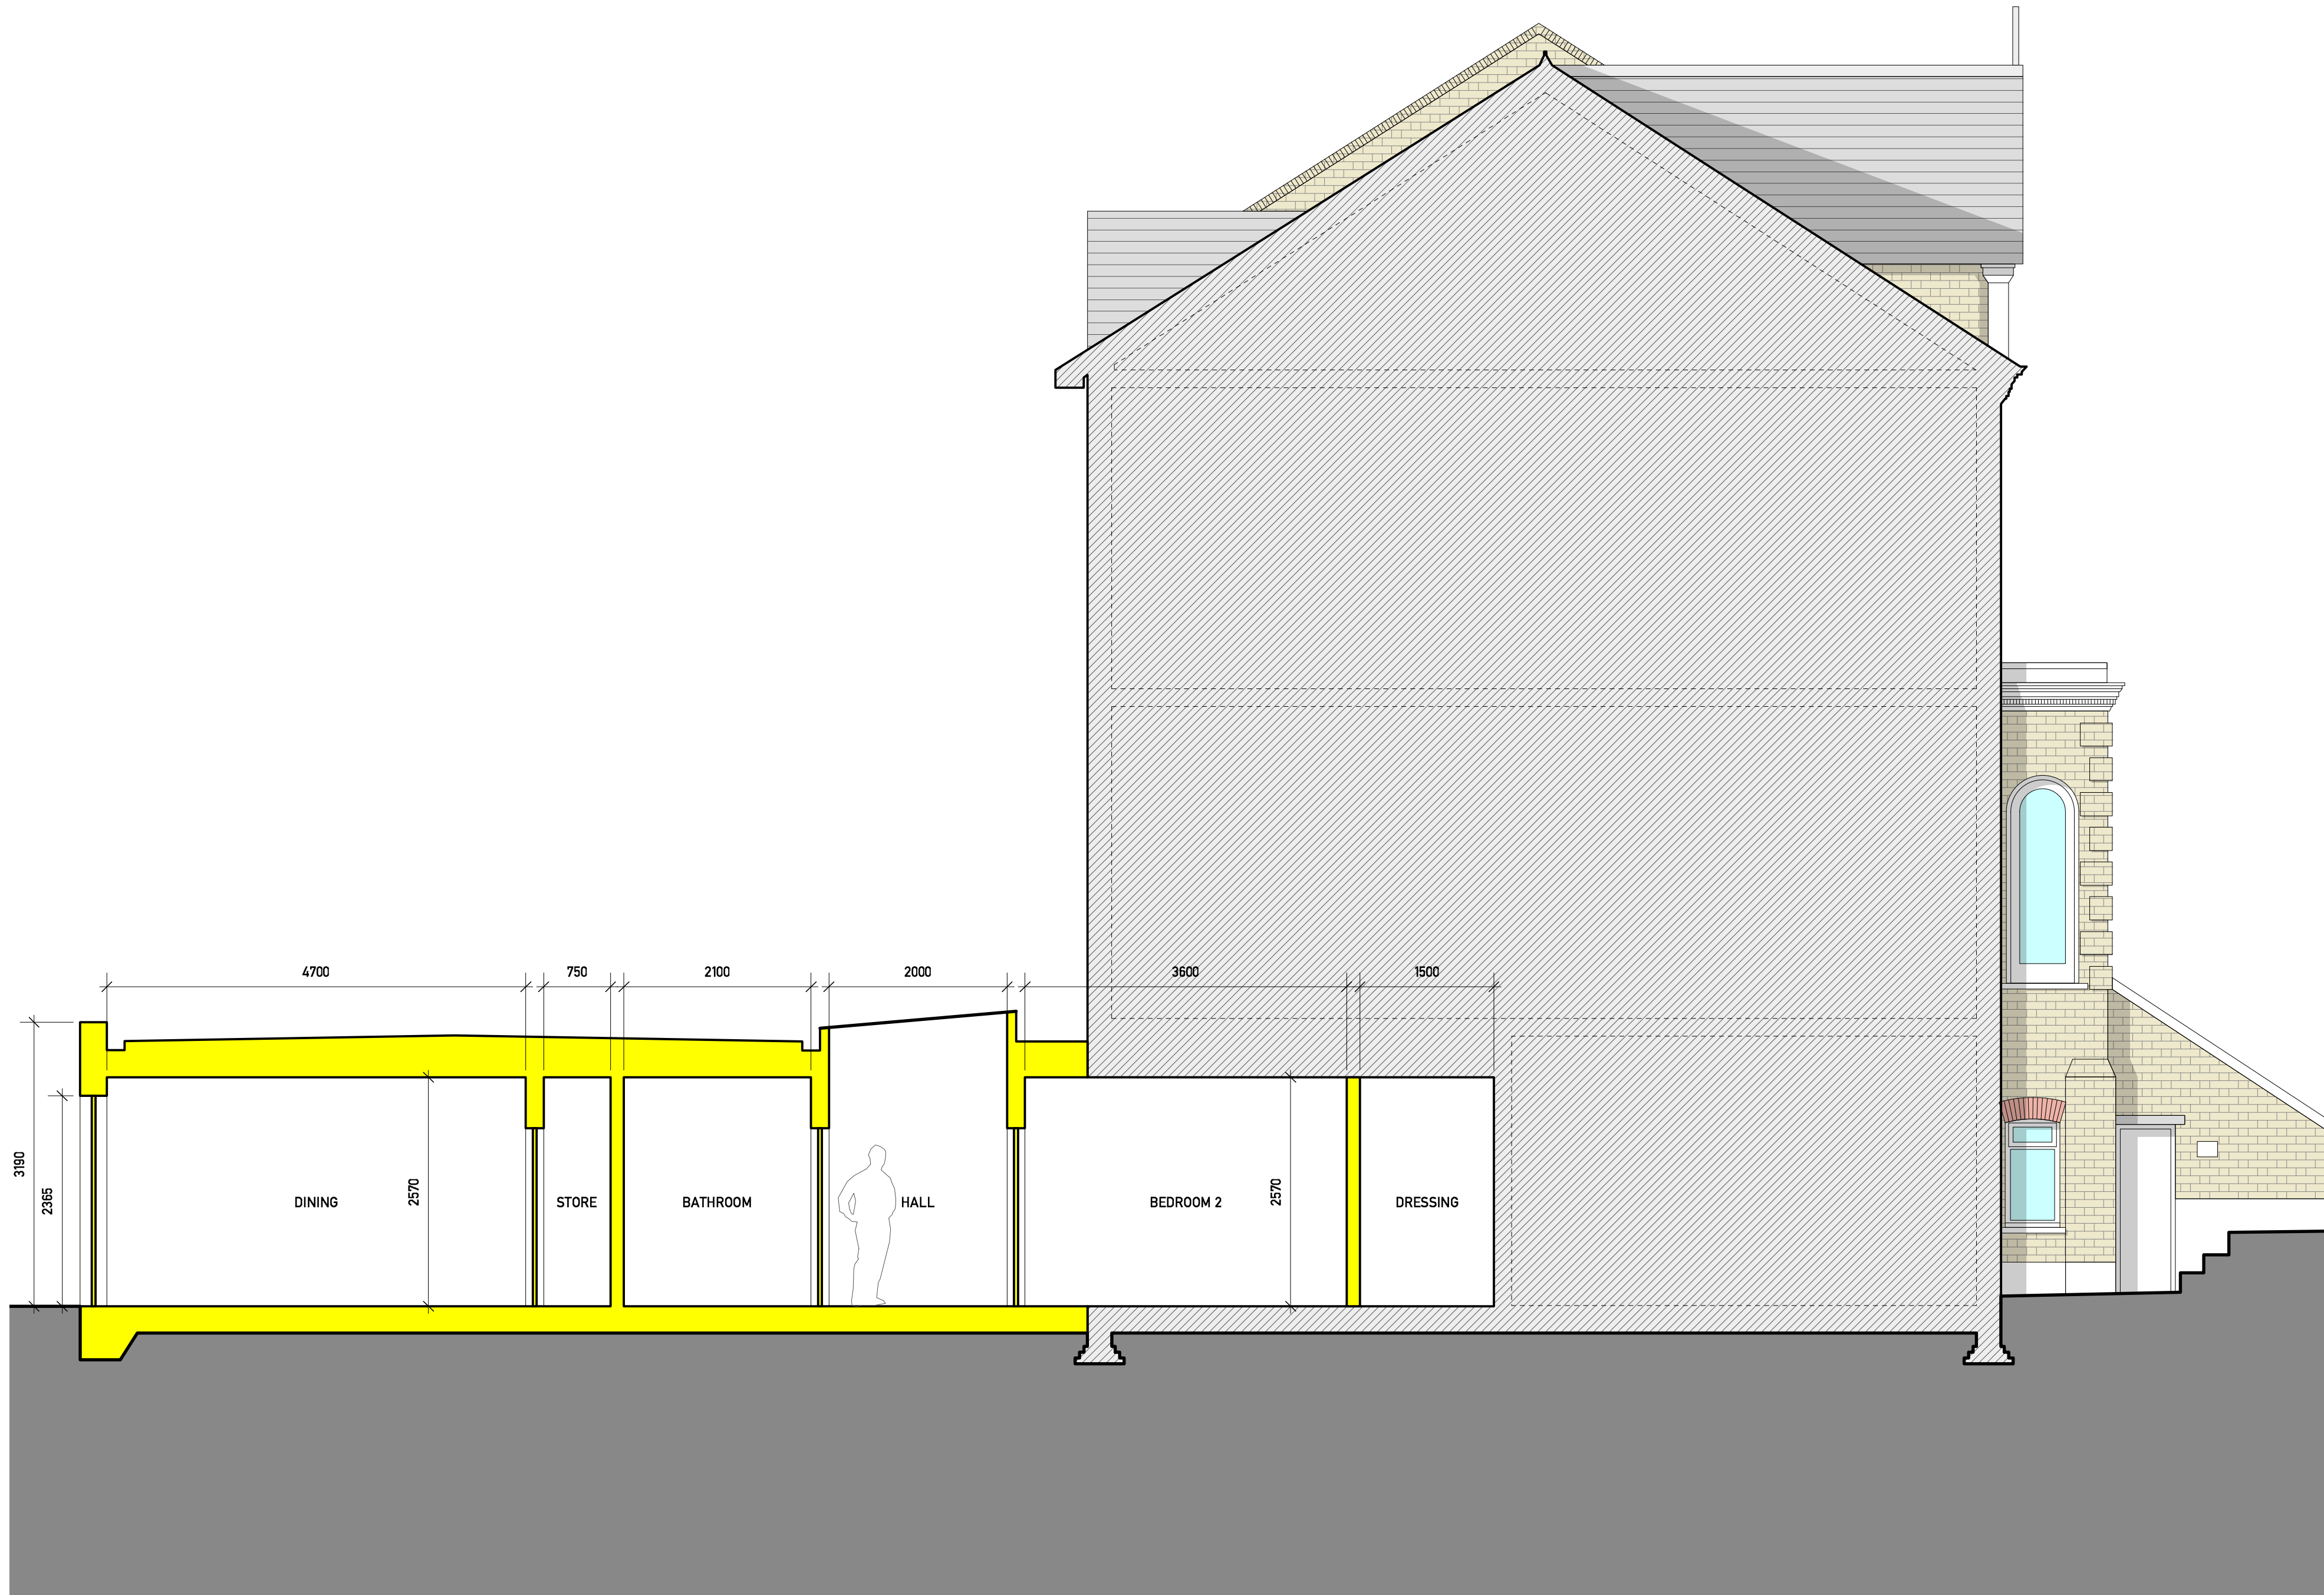

AA As-Built Section AA
Scale 1:50@A1, 1:100@A3

0m 1m 2m 5m 10m