

Notes

P1 8/6/17 Issued to Client

Revisions



Farringdon House
First Floor
105-107 Farringdon Road
London EC1R 3BU
T +447792949233
niki@nmastudio.co.uk


Client
Mr T. Korn

Project
119 Canfield Gardens

Drawing Title
As-Built Roof Plan

Status	Drawn	Checked
Planning	-	NM
Scale	Date	
1:50@A1, 1:100@A3	Jun 17	

Drwg. No. & Revision
135-GARF_P1

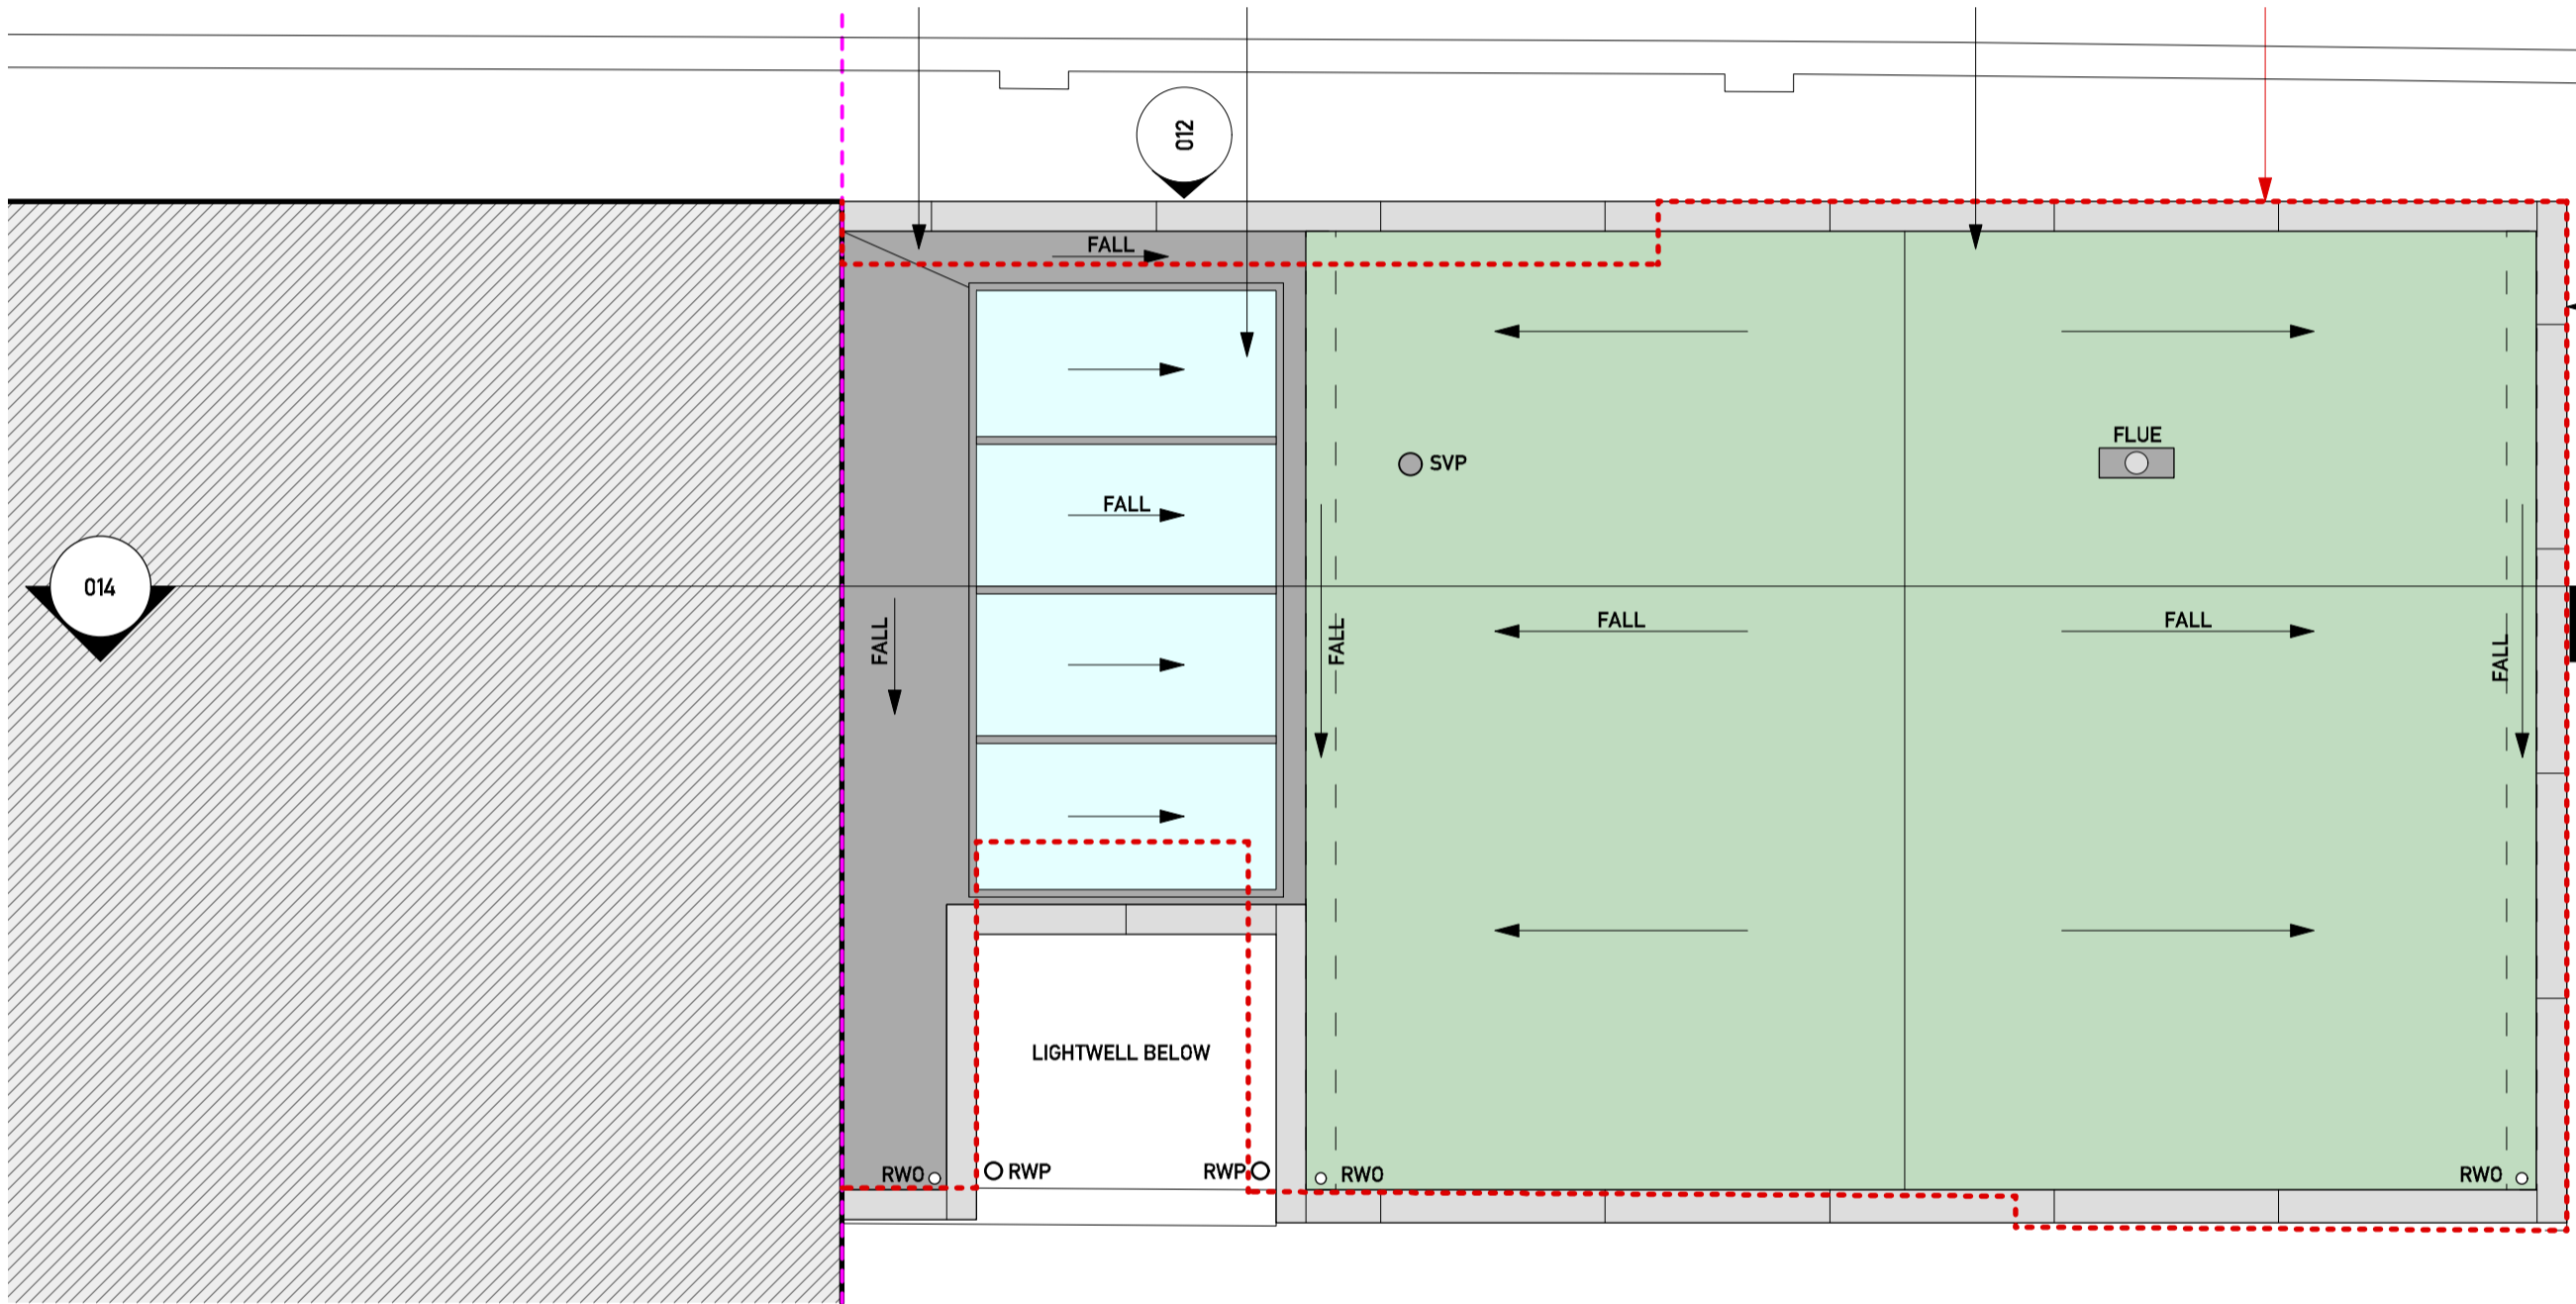

01 As-Built Roof Plan
Scale 1:50@A1, 1:100@A3