



68 Oxford Street, London W1D 1BN
Phone : +44 207 636 4636

DATE: 23.06.2016

F.GB.LONSTH

SRIMIT SARAYI

LONDON SOUTHAMPTON ROW BRANCH

PAFTA ADI/ SHEET TITLE
EXISTING SIGNAGE DETAILS

PAFTA NO/ SHEET NO
SS.LONSTH.LP-G01

A.104.00

Drawn Interior
Architect Cansu AYRILMAZ

Architectural Confirm
Alev GÖNENCER



Operational Confirm
Erju MUSTAFA

Director Confirm

Final Approval
Gino SÖLAK

NOTES

- The dimensions will be checked out on the site, so changes may occur on the drawings.
- This is not a "Construction Drawing". Cannot be used for application and manufacturing.
- For final manufactures, dimensions must be checked out on the site.

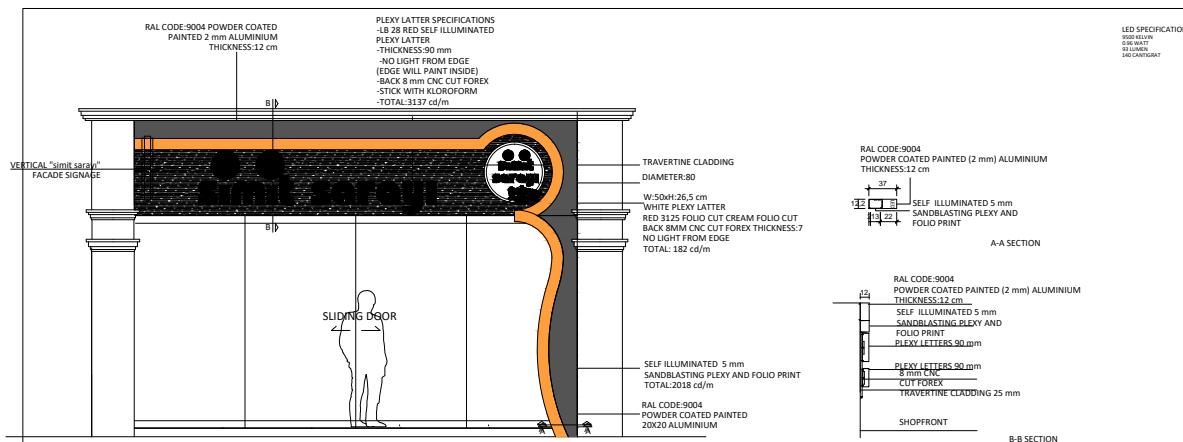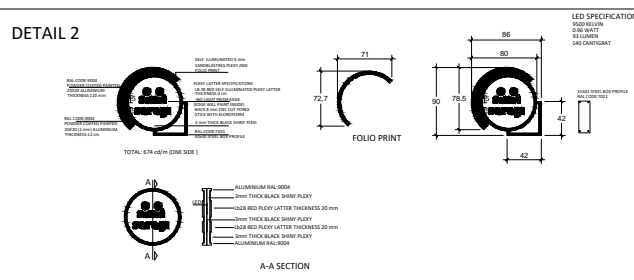

AS BUILT SIGNAGE DETAIL ELEVATION