



FRONT ENTRY SIGNAGE  
SCALE 1:50

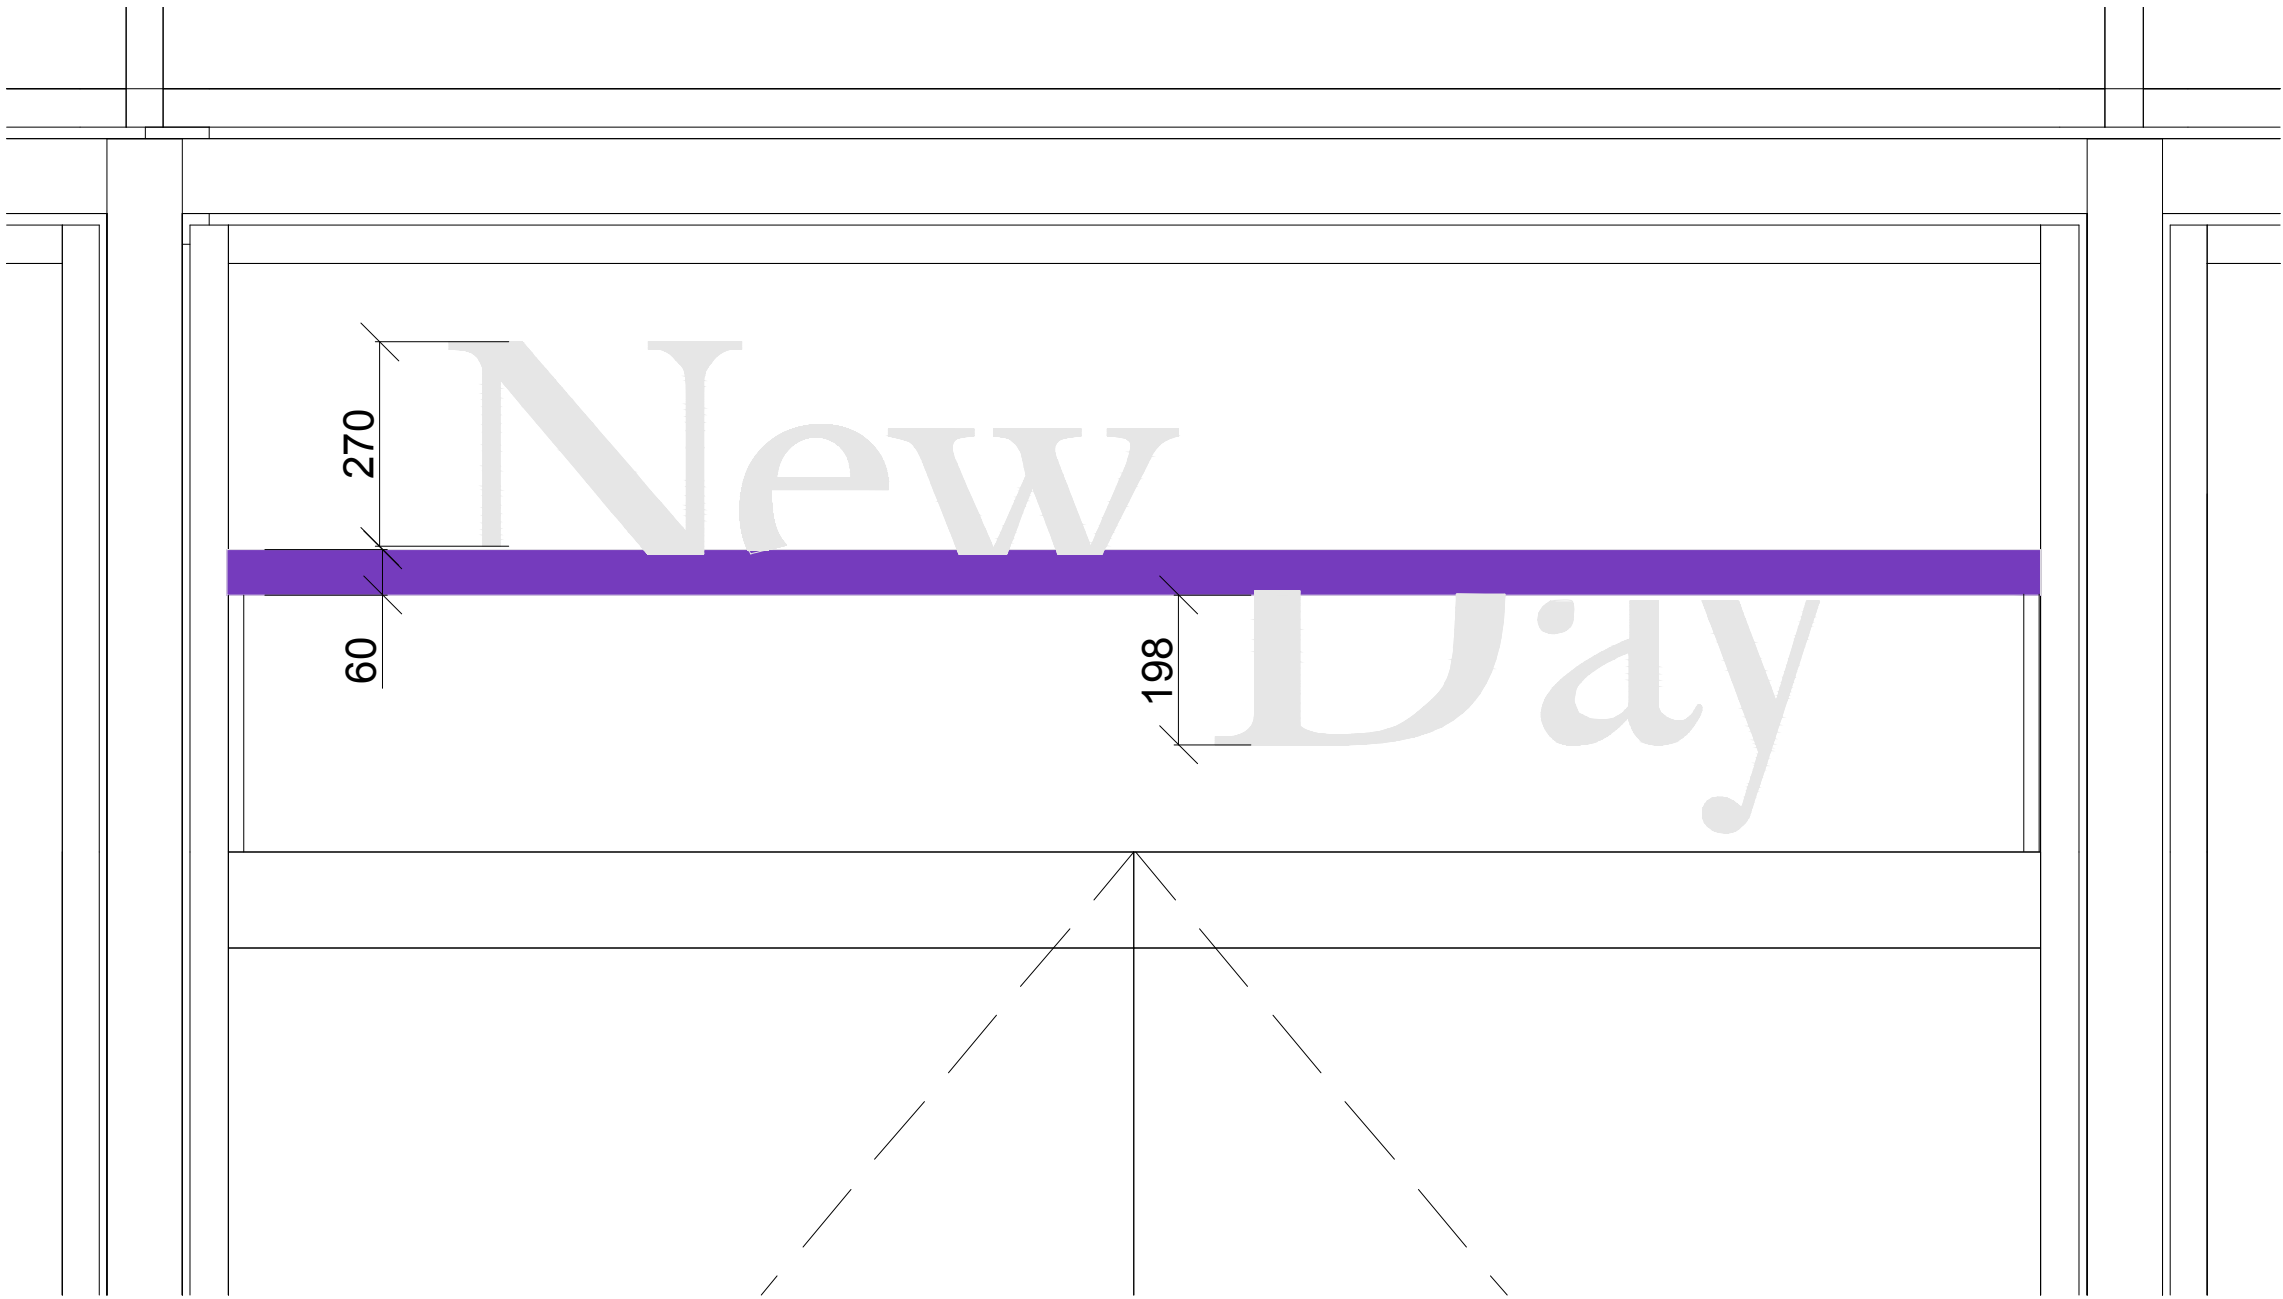

SIGNAGE DETAIL  
SCALE 1:10

3D LOGO/TEXT  
NEW DAY + LINE - BUILT UP DESCALED STAINLESS STEEL RIMLESS LETTERING POWDER COATED TO A RAL PURPLE/WHITE WITH 60MM RETURNS AND CAP HEIGHT AT 270MM WITH LINE 60MM HIGH X LENGTH APPROX. 2400MM X 800MM TO BE CONSTRUCTED WITH FULL METAL BACK TRAY AND 6MM ALUMINIUM SUPPORT TO THE REAR FOR STRUCTURAL STABILITY, WITH REAR COUNTERSUNK FIXINGS, 5MM ACRYLIC FACES IN PURPLE/WHITE AND LIT INTERNALLY BY LED ILLUMINATION AND SUPPLIED WITH SUITABLE TRANSFORMER, POWER, AND LIGHTING CONNECTIVITY TO LINK WITH BUILDING

PURPLE - TO MATCH PANTONE PMS 266C

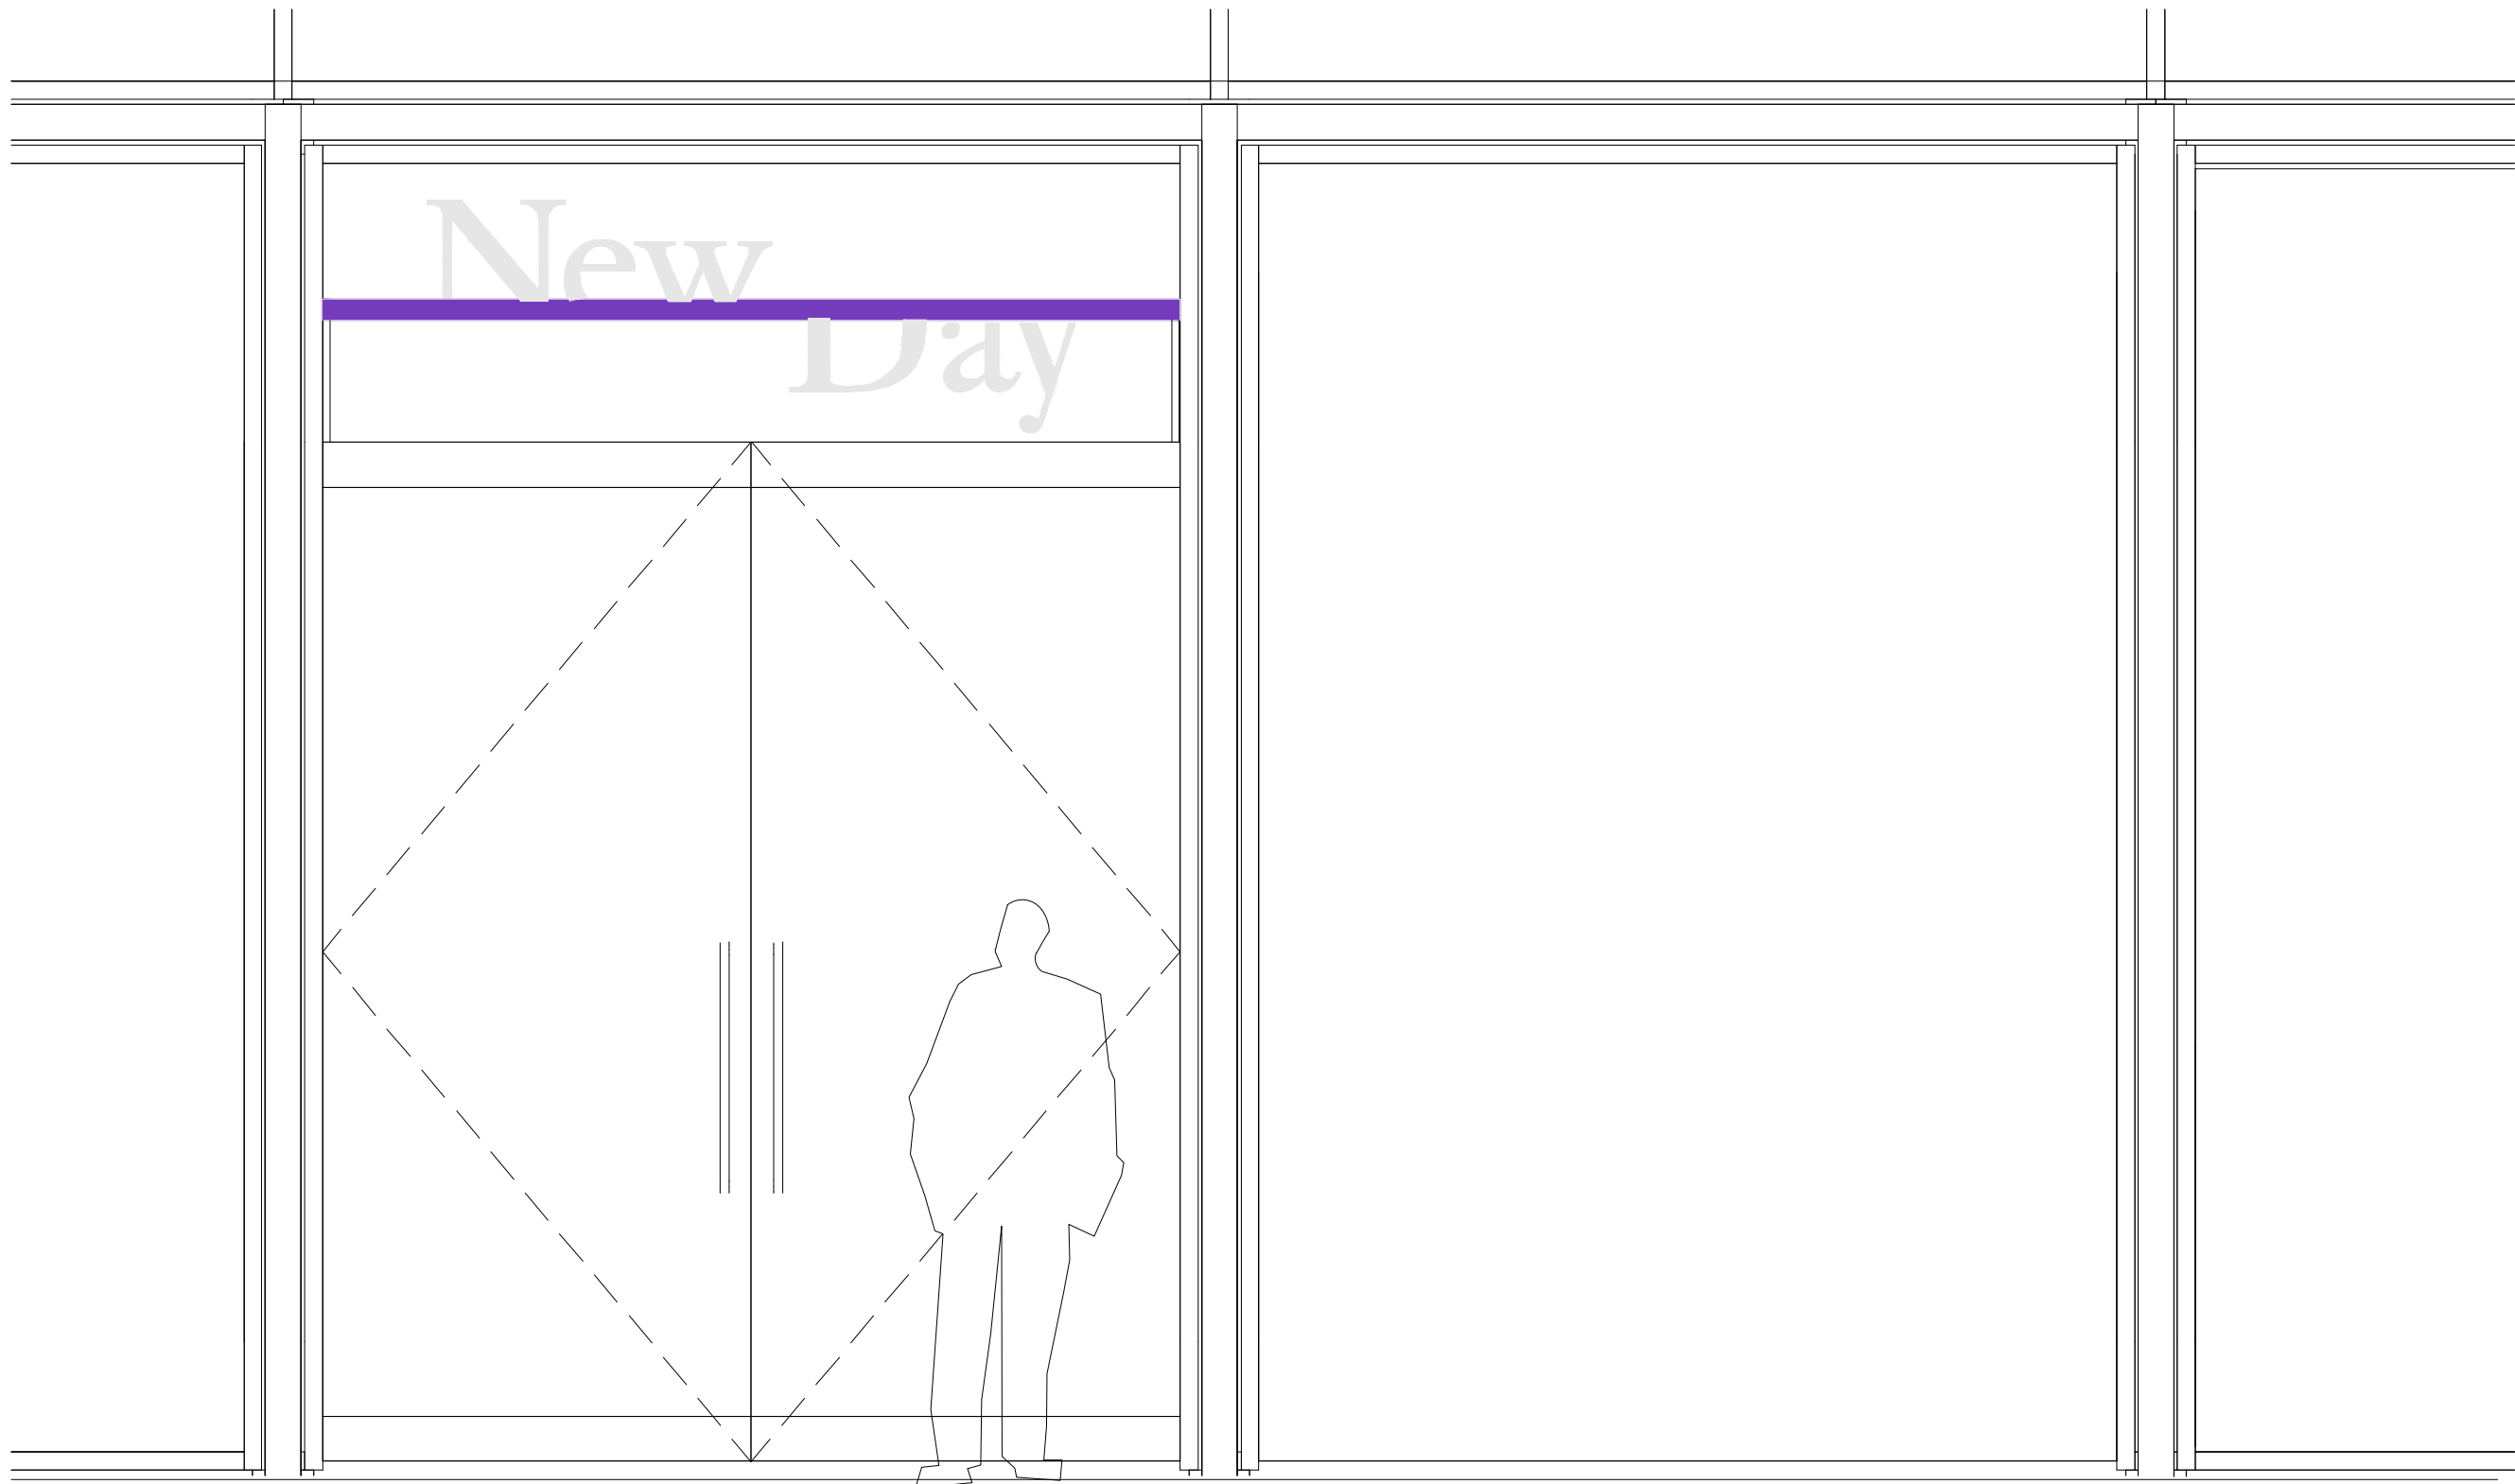

FRONT ENTRY SIGNAGE  
SCALE 1:20

NOTES: This drawing is the exclusive Copyright of Oktra and may not be copied or handed to any Third parties without prior consent. All dimensions must be checked on site and not scaled from the drawing. All drawings and proposals are subject to approvals by statutory authorities


Rev	Descriptive amendments	Drawn by	Date
-----	------------------------	----------	------

Pre-Design - Construction - As Built

AS BUILT

Client

NEW DAY

Client Contact

Site Address  
Handyside St,  
London N1C

Drawing Title  
DT51 Signage Details  
Account Manager

Designer/ Project Manager

Scale	Drawn by	First Drawing Date
As Shown @ A1	SH	25.05.17
Contract Number	Building	Floor
56500	01	ALL
		Detail
		Revision
		DT51



First Floor  
322 High Holborn  
London  
WC1V 7PB  
T: +44 (0)20 7553 9500  
www.oktra.co.uk