

TOTAL NUMBER OF WASTE CONTAINERS / DIRTY LINEN CAGES AT LVL 6:
No Disposal Holds at level 6.

LOCATION OF DISPOSAL HOLDS PER FLOOR - GA MARK-UP - 2017.05.30
(mark-up on latest GA's Rev. G for drawing sequence 111131, issued on 3rd March 2017)
SCOTT TALLON WALKER ARCHITECTS

NOTES:

Rev	DATE	REVISION HISTORY	Dsg	Drw	Chk	App
G	2017.03.03	GEN Set of Drawings / Issued for Approval	STW	RG	K	KB
F	2017.01.27	GEN Set Of Drawings / Issued For Approval	STW	KK	CK	KB
E	2016.10.07	Issued for Acceptance	STW	MDM	CK	KB
D	2016.07.06	Issued for Facade Tender	STW	MDM	CK	KB
C	2016.06.03	Updated to incorporate comments received under PM2016 and EWN2016 as per MoM of 05/05/2016 Issued For Acceptance	STW	MDM	CK	KB
B	2016.02.20	Issued for Approval	STW	STW	STW	STW





BOUYGUES
Head Office:
Elizabeth House,
39 York Road,
London, SE1 7NG.
Tel: 020 7401 0020
Fax: 020 7401 0030
www.bouygues-uk.com

Name	Signature	Date
Designed by	STW	2017.03.03
Drawn by	KK	2017.03.03
Checked	KK	2017.03.03
Approved	KB	2017.03.03

ORIGINATOR	SCALE	BIM FILE NAME
University College London Hospitals NHS Foundation Trust	1 : 200	P4PBT-STW-AAB-SL-M3-A31-100054
Scott Tallon Walker Architects	FIRST ISSUE DATE	PROPOSED STATUS
	2016.02.16	S2 - FOR INFORMATION

DRAWING TITLE									
Proton Beam Therapy - Phase 4									
General Arrangement Plans Sixth Floor Level									
PROJECT	ISSUER	AREA	LEVEL	TYPE	TRADE	SEQUENCE	REV		
P4PBT	STW	AAB	06	GA	A31	111131	G		

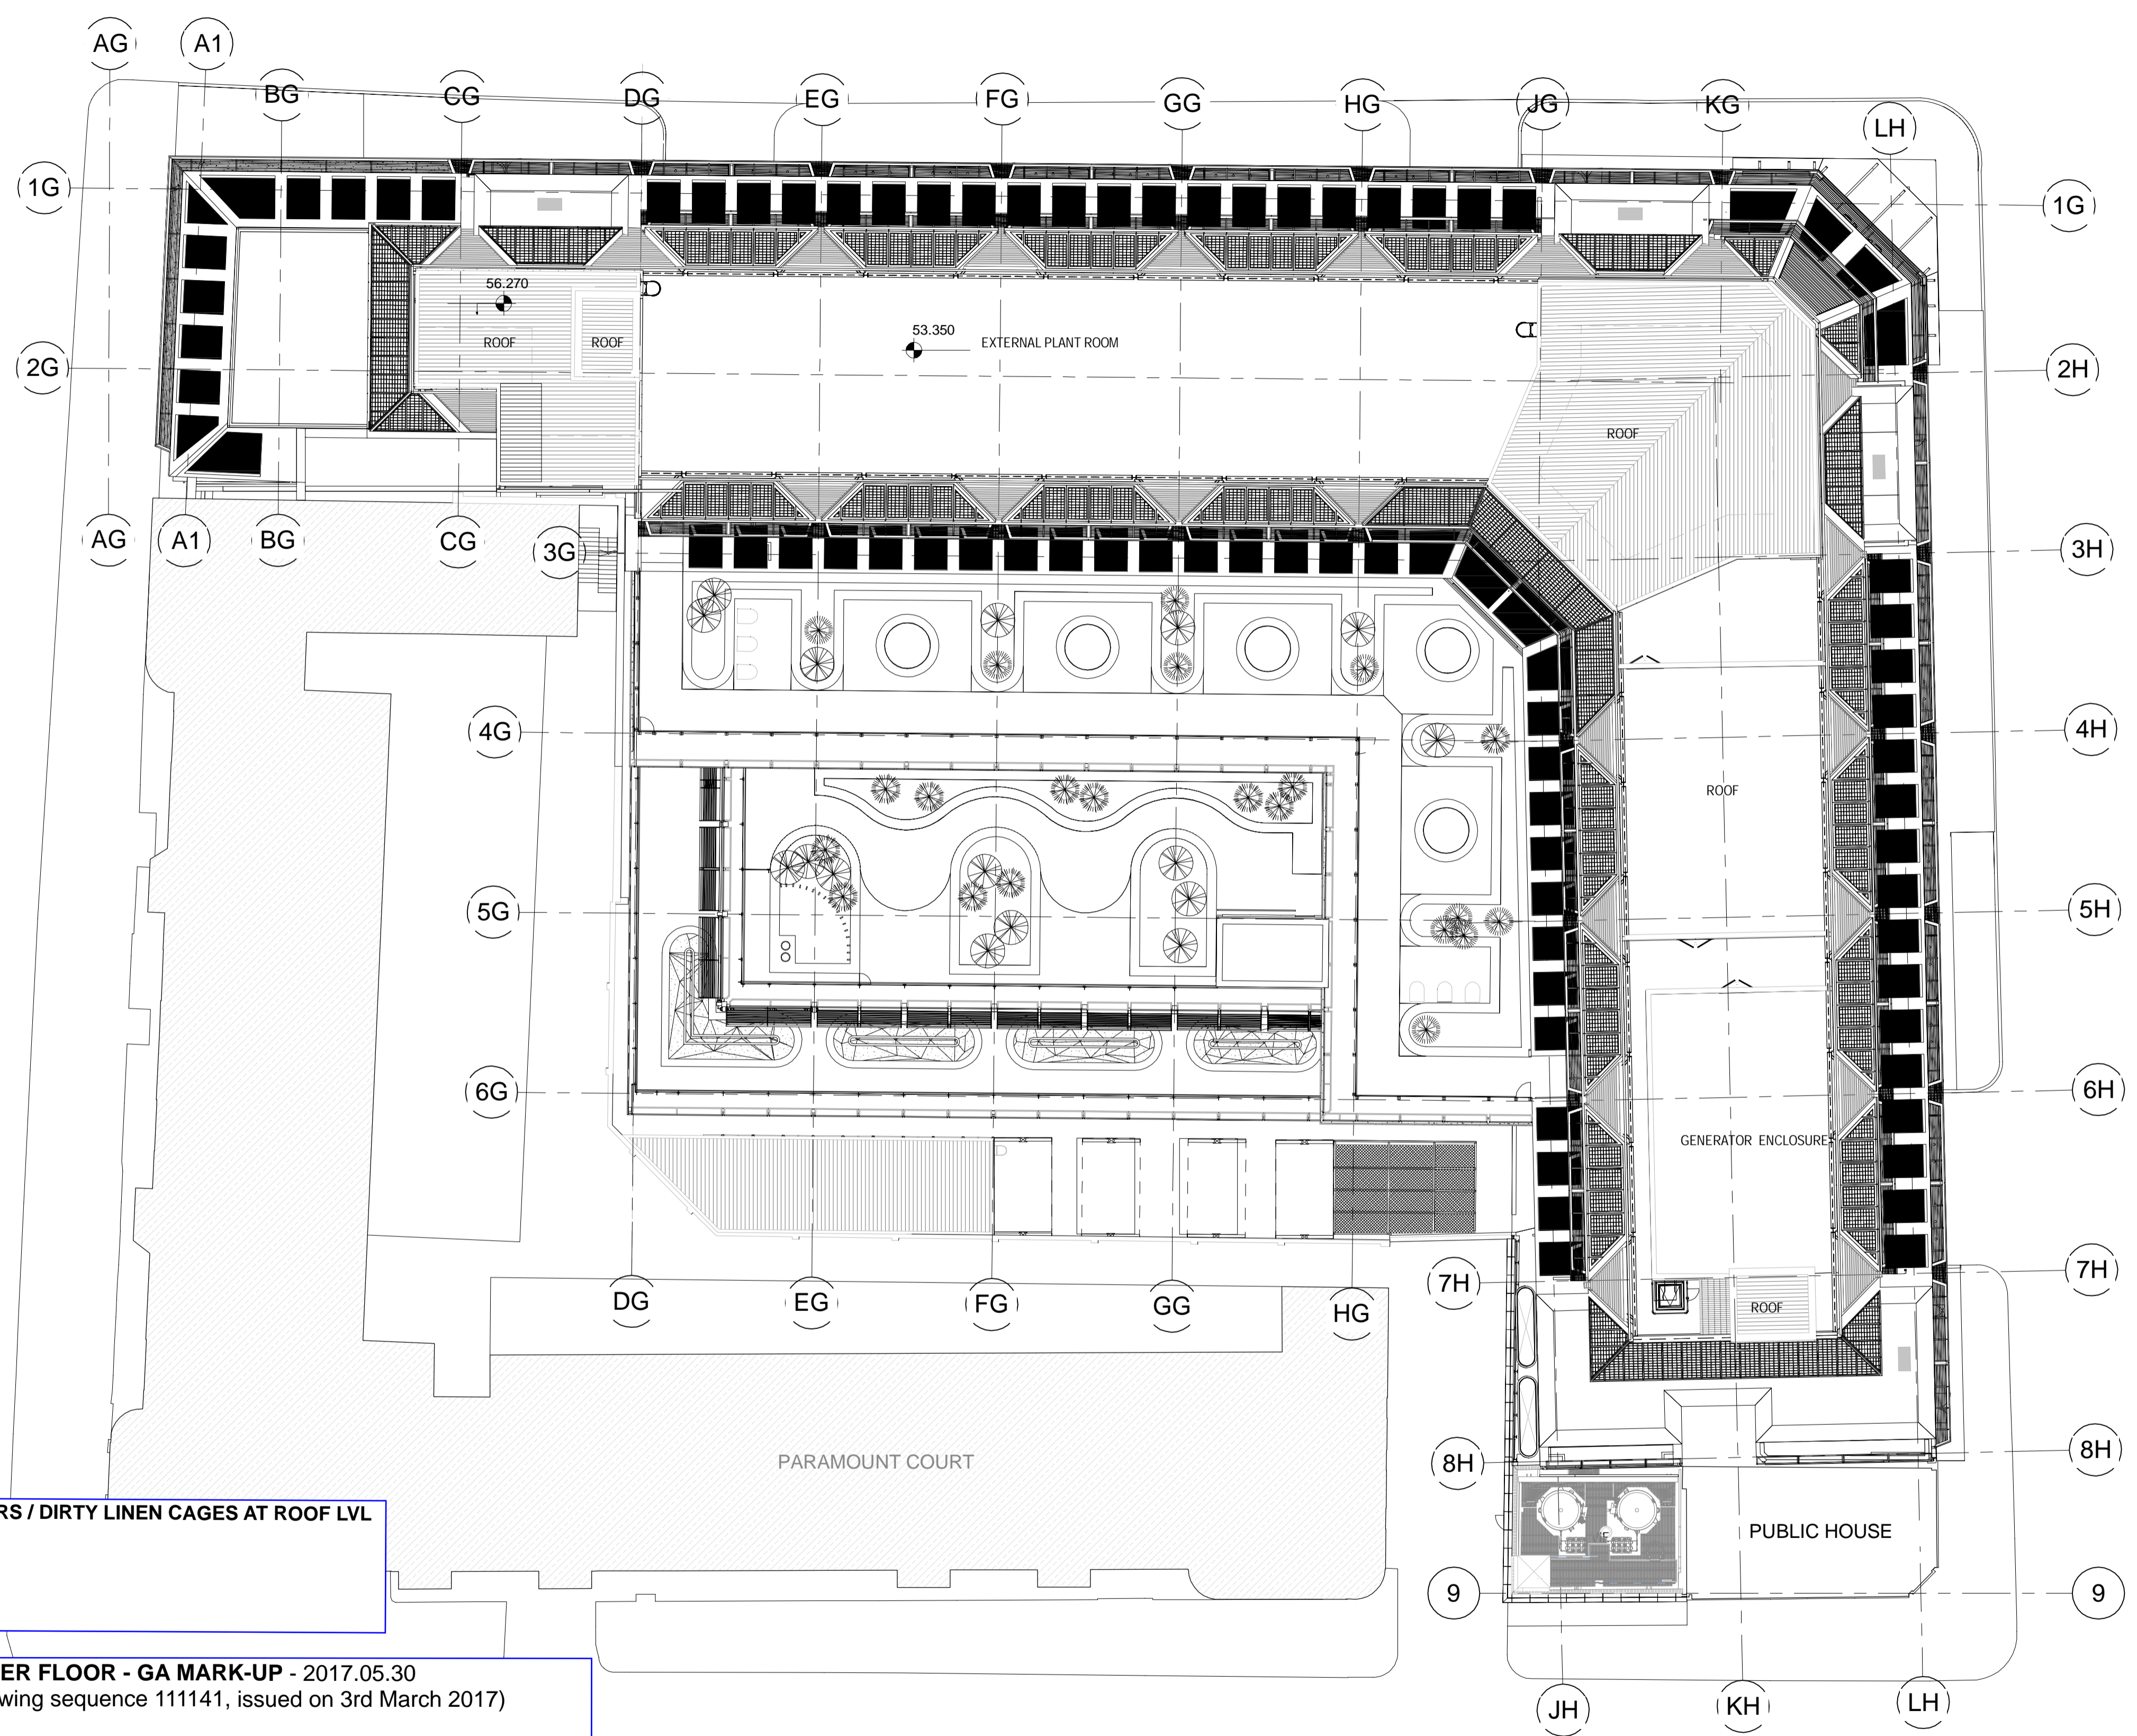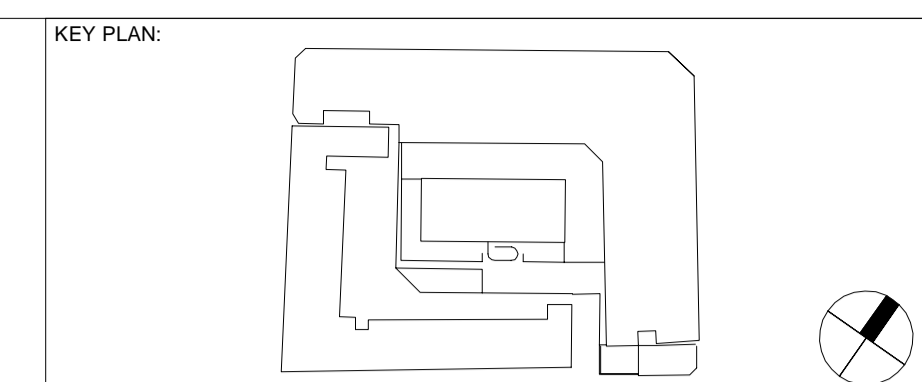

TOTAL NUMBER OF WASTE CONTAINERS / DIRTY LINEN CAGES AT ROOF LVL
 No Disposal Holds at Roof level.

LOCATION OF DISPOSAL HOLDS PER FLOOR - GA MARK-UP - 2017.05.30
 (mark-up on latest GA's Rev. F for drawing sequence 111141, issued on 3rd March 2017)
SCOTT TALLON WALKER ARCHITECTS

NOTES:

Rev	DATE	REVISION HISTORY	Dsg	Drw	Chk	App
F	2017.03.03	GEN Set of Drawings / Issued for Approval	STW	RG	K	KB
E	2017.01.27	GEN Set Of Drawings / Issued For Approval	STW	KK	CK	KB
D	2016.10.07	Issued for Acceptance	STW	MDM	PS	KB
C	2016.06.03	Updated to incorporate comments received under PMC206 and EWN008 as per MoM of 05/05/2016 Issued For Acceptance	STW	MDM	CK	KB
B	2016.02.20	Issued for Approval	STW	MDM	CK	KB
A	2016.02.16	Issued For Approval	STW	MDM	CK	KB



BOUYGUES
Head Office:
 Elizabeth House,
 39 York Road,
 London, SE1 7NG.
 Tel: 020 7401 0020
 Fax: 020 7401 0030
 www.bouygues-uk.com

Name	Signature	Date
Designed by: STW		2017.03.03
Drawn by: KK		2017.03.03
Checked: KK		2017.03.03
Approved: KB		2017.03.03

ORIGINATOR	UNIVERSITY COLLEGE LONDON HOSPITALS NHS FOUNDATION TRUST	SCOTT TALLON WALKER ARCHITECTS
SCALE	1 : 200	@ A1
FIRST ISSUE DATE	2016.02.16	BIM FILE NAME
PROPOSED STATUS	S2 - FOR INFORMATION	P4PBT-STW-AAB-SL-M3-A31-100054

DRAWING TITLE		Proton Beam Therapy - Phase 4						
		General Arrangement Plans Roof Level						
PROJECT	ISSUER	AREA	LEVEL	TYPE	TRADE	SEQUENCE	REV	
P4PBT	STW	AAB	RF	GA	A31	111141	F	