



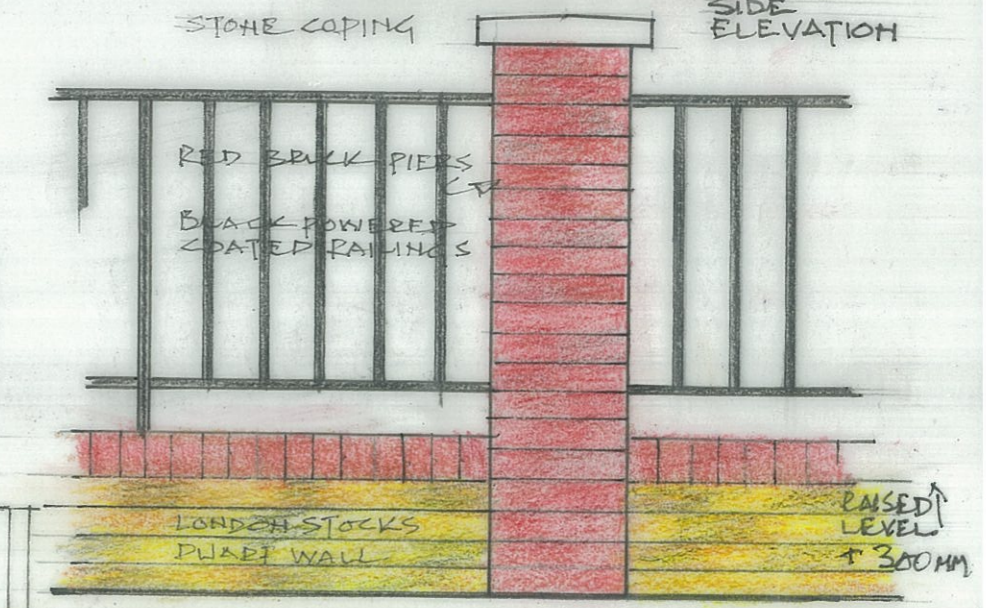

STONE COPING SIDE ELEVATION

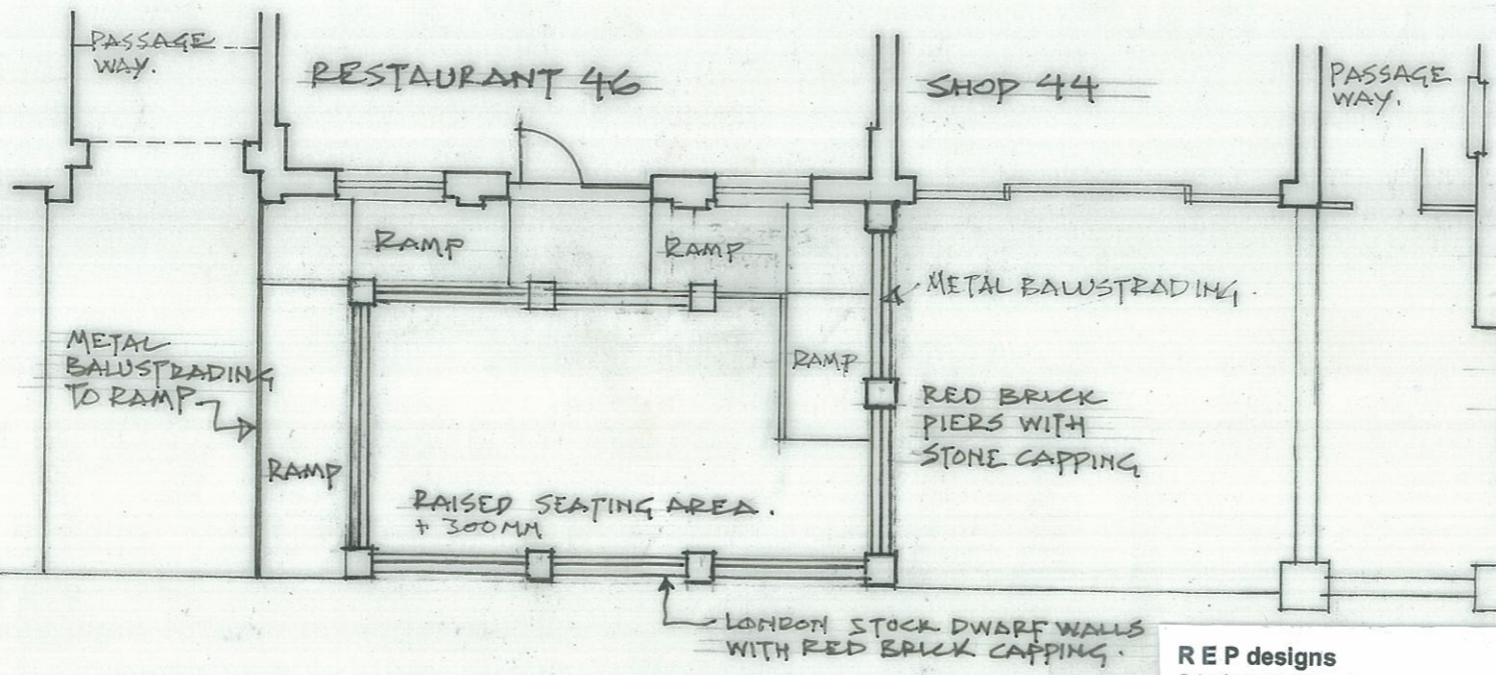

PART ELEVATION OF SUPROUND TO RAISED SEATING AREA.


REVISION A 10.7.17  
 DIMENSIONS ADDED (1.50 PIERS)  
 RAISED LEVEL + 300MM  
 COLOURS OF MATERIALS ADDED.

PROPOSED ALTERATION TO FRONTAGE NO 46

REP designs  
 2 Lulworth Court  
 13 Cannon Hill  
 London N14 7DJ

Contract  
 46 Birchington Road  
 London NW6 4LJ  
 Client  
 Neritan


Drawing No 15/GL/02A  
 Proposed Alterations to Frontage  
 Scale 1:100  
 Date June 2017  
 Drawn by EP

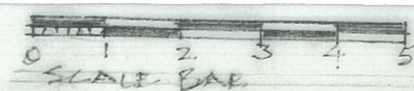



AS BUILT ELEVATION OF NO 46.

SIDE ELEVATION

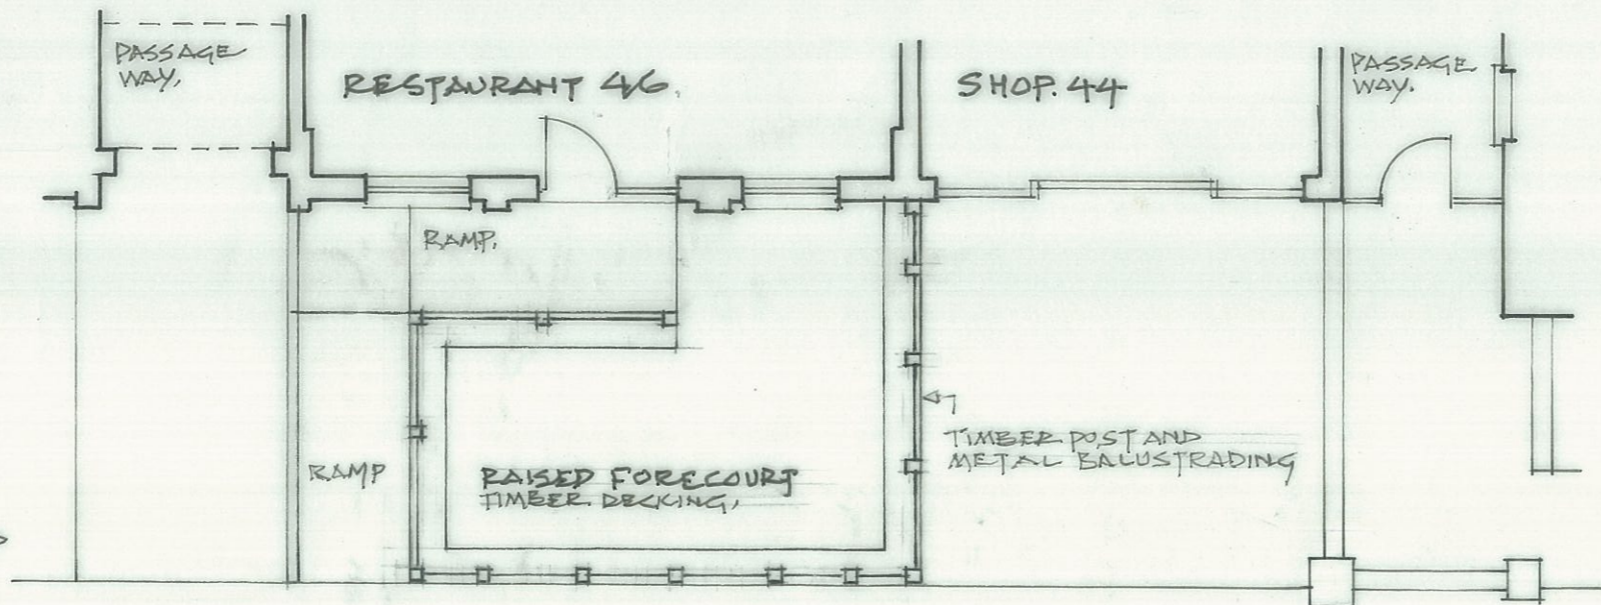

AS BUILT PLAN OF FRONTAGE NO 46

REVISION 'A' 10.7.17  
 DIMENSIONS ADDED  
 COLOUR OF MATERIALS ADDED  
 SCALE B&P SHOWN

NO 46, BIRCHINGTON ROAD  
 KILBURN, LONDON NW6 4LJ

REP designs  
 2 Lulworth Court  
 13 Cannon Hill  
 London N14 7DJ  
 020 8882 3803

Contract  
 46 Birchington Road  
 Kilburn London NW64LJ  
 Client  
 Neritan

Drawing No 17/GL/01 'A'  
 As Built Frontage  
 Scale 1:100  
 Date June 2017  
 Drawn by EP

