

LEGEND - L00 Yard Level

- T1** : Granite Stone Set Paving various rotation. Lengths between 100-250mm Width x 100 Depth. 24% Stirling Red/Grey (availability of Stirling red TBC by quarry), 38% Millennium Green, 38% Sea Black 10mm joints 40mm bed
- T2** : Sea black setts. The setting-out of the setts within the perimeter of the fan is indicative and should be developed with the paving subcontractor along traditional laying techniques.
SEE DRAWING (90)-5003 FOR TYPICAL 'FAN' PAVING LAYOUTS TYP 1,2,3
- T3** : Lightly Sawn and Textured Granite Setts - Source from site. Lengths between 100-250mm x 80-125mm Width x APPROX 100 Depth Sawn + Textured (Tolerance +/- 2mm). (sizes will be limited to available existing sett sizes & numbers.)
- T5** : Rough Reclaimed Granite Setts - Source from site. Lengths between 100-250mm x 80-125mm Width x Approx 100 Depth Reclaimed, cleaned + laid with no finish. (sizes will be limited to available existing sett sizes & numbers.)
- T7** : Sea black paving zone to mark original ECD Viaduct footprint! Two rows border around periphery
- T8** : Tactile Granite Cordonuroy Paving of milled granite setts to match surrounding paving Length 800mm x 400mm Width x 50mm depth. Abion grey
- T9** : Single line of new granite setts threshold 100x100 Width x 100 Depth Colour to match T1.
- T9B** : Triple line of new granite setts threshold 100x100 Width x 100 Depth. Colour to match T1.
- Solo Slot Drain - C250
- Duo Slot Drain - D400



Status Code (as defined in B01192)

Work In Progress (WIP)

S0 - Initial Status or WIP

Shared

S1 - Issued for co-ordination

S2 - Issued for information

S3 - Issued for internal review

S4 - Issued for construction approval

Documentation (Pre-construction)

D1 - Issued for costing

D2 - Issued for tender

D3 - Issued for contractor design

D4 - Issued for manufacture/procurement

Documentation (Contractual)

A - Issued for construction

B - Issued for construction but with comments


C - Comprehensive revision required

Archives

AB - Record Drawing

006	TM	DW	26.05.17	Updated to suit BAMC comments
005	RIS	DW	17.02.17	Call outs of enlarged sheets included Construction Issue
004	SS	MWB	15.02.16	Updated to meet Page Turn meeting Comments
003	SS	MWB	27.01.16	Updated to meet BAMC Comments
002	SS	MWB	21.12.15	General Paving Layout Updated to meet HS and BAMC Comments
001	SS	DW	20.11.15	General Paving Layout and services Updated
Rev	To	By	Date	Description

KEY PLAN

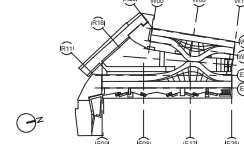

bam

BAM Design Ltd
An operating company of
BAM Construction UK Ltd

Architectural
Interior Design
3D Visualisation
Feasibility Studies
Structural Engineering
Construction Management
Building Information Modelling

Carlton Business Park
Coffin Lane, St Albans
Hertfordshire, AL1 2TD
01727 860000
design@bam.co.uk
www.bam.co.uk

project COAL DROPS YARD

External Paving Layout -L00
Yard Level

scale 1:250 @ A1
date 20.11.2015
rev 001

drawn SS
checked MWB
approved JMB

4389

CONSTRUCTION

page 1 of 1

S4
006

External Finishes - The Yard - Ground Floor Level

T2 : Sea black setts. The setting-out of the setts within the perimeter of the fan is indicative and should be developed with the paving subcontractor along traditional laying techniques.

SEE DRAWING (90)-5003 FOR TYPICAL 'FAN' PAVING LAYOUTS TYP 1,2,3

T3: Lightly Sawn and Textured Granite Setts - Source from site.
Lengths between 100-250mm x 80-125mm Width x APPROX. 100
Depth Sawn + Textured (Tolerance +/- 2mm). (sizes will be limited to
available existing sett sizes & numbers.)

T5: Rough Reclaimed Granite Setts - Source from site
Lengths between 100-250mm x 80-125mm Width x Appox 100 D
Reclaimed, cleaned + laid with no finish.
(sizes will be limited to available existing sett sizes & numbers.)

T7 : Sea black paving zone to mark original ECD Viaduct footprint. Two rows border around periphery

T8 : Tactile Granite Corduroy Paving of milled granite to match surrounding paving (Sea black). 800mm Length x 400mm Width x 50mm depth

T9 : Single line of new granite setts threshold
100x100 Width x 100 Depth. Colour to match T1

T9B : Triple line of new granite setts threshold
100x100 Width x 100 Depth, Colour to match T1.

Slot Drain - C250

 Slot Drain - D400

Concrete encasing for Slot Drain

Concrete encasing for Slot Drain

— CF: Compressible filler

MJ: Expansion joint in paving
See Structural Engineers Details

--- Fall lines shown indicatively, slopes to be executed with soft blends, no setts to be cut

 **SOP** Setting out position for paving finish

DO NOT SCALE FROM THIS DRAWING

ALL DIMENSIONS TO BE CHECKED ON SITE

FOR REFERENCED VIEWS REFER TO KXC- 12- 001- A- ((90)
SERIES OF DRAWINGS

Continuation on drawing (90) - 400509

Continuation on drawing (90) - 400510

Continuation on drawing (90) - 400402

Continuation on drawing (90) - 400510

DO NOT SCALE FROM THIS DRAWING - ALL DIMENSIONS TO BE CHECKED ON SITE

2. Figured dimensions only are to be taken from this drawing. All contractors must visit site & are responsible for taking & checking all dimensions relating to their work. BAM Design to be advised of any variation between drawings & site conditions.


3. All vertical dimensions to be taken from FFL, please note that all manufacturing schedules are to take this into account.
4. All dimensions are in millimetres unless noted otherwise.
5. All levels in meters unless noted otherwise.

5. All levels in meters unless noted otherwise.
To be read in conjunction with -
ARUP drawings for structural frame, openings, supports

TO BE READ IN CONJUNCTION WITH ALL ARCH DETAILS & SPECIFICATIONS

- **General -**
 - Material finishes all to approved samples
 - Areas stated are approximate for pricing exercise only and are total area of BAMC scope of works boundary as indicated on drawing 4389-A-20-001
 - Existing services covers in new / re-instated paving to be re-aligned with paving where possible - individual covers to be reviewed on site
- To be read in conjunction with -**
 - ARUP Structural Engineers drawings for sub base information
 - ARUP / PBA drawings for drainage layouts
 - BAMD Electrical Engineers drawings for services, lighting layouts
 - BAMD for waterproofing details (23 - Series)
 - Miller Druck for paving finishes / cut patterns
 - PBA - Drainage levels

KEY PLAN

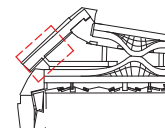

BAM Design Ltd
An operating company
BAM Construct UK Ltd

Architecture
Interior Design
3D Visualisation
Feasibility Studies
Structural Engineering
Environmental Services
Building Information Modelling

Centrium Business Park
Griffiths Way, St Albans
Hertfordshire, AL1 2PD
01727 894200
design@bam.co.uk

| project COAL DROPS YARD

External Paving Layout - I2 WRA
- L00 Yard Level - Sheet 01

CONSTRUCTION

scale	As indicated @ A1	drawn	TM	SAM job no.	dry status
date	03/08/16	checked	MWB	4389	S4
site	pitblotacion	project	Consultant	Rate	CI/SFB
dry / doc ref.	KXC-I2-	001-BD4389-A-	(90)-400401	002	rev.

LEGEND


External Finishes - The Yard - Ground Floor Level

- T1 : Granite Stone Sett Paving various rotation. Lengths between 100-250mm Width x 100 Depth. 24% Stirling Red/Grey (availability of Stirling red TBC by quarry). 38% Millennium Green, 38% Sea Black 10mm joints 40mm bed
- T2 : Sea black setts. The setting-out of the setts within the perimeter of the fan is indicative and should be developed with the paving subcontractor along traditional laying techniques.
- SEE DRAWING (90)-5003 FOR TYPICAL 'FAN' PAVING LAYOUTS TYP 1,2,3
- T3 : Lightly Sawn and Textured Granite Setts - Source from site. Lengths between 100-250mm x 80-125mm Width x APPROX. 100 Depth Sawn + Textured (Tolerance +/- 2mm). (sizes will be limited to available existing sett sizes & numbers.)
- T5 : Rough Reclaimed Granite Setts - Source from site. Lengths between 100-250mm x 80-125mm Width x Approx 100 Depth Reclaimed, cleaned + laid with no finish. (sizes will be limited to available existing sett sizes & numbers.)
- T7 : Sea black paving zone to mark original ECD Viaduct footprint. Two rows border around periphery
- T8 : Tactile Granite Corduroy Paving of milled granite to match surrounding paving (Sea black). 800mm Length x 400mm Width x 50mm depth
- T9 : Single line of new granite setts threshold 100x100 Width x 100 Depth. Colour to match T1.
- T9B : Triple line of new granite setts threshold 100x100 Width x 100 Depth. Colour to match T1.
- Slot Drain - C250
- Slot Drain - D400
- Concrete encasing for Slot Drain
- Concrete encasing for Slot Drain
- CF: Compressible filler
- MJ: Expansion joint in paving See Structural Engineers Details
- Fall lines shown indicatively, slopes to be executed with soft blends, no setts to be cut
- SOP Setting out position for paving finish

DO NOT SCALE FROM THIS DRAWING.
ALL DIMENSIONS TO BE CHECKED ON SITE.
FOR REFERENCED VIEWS REFER TO
SERIES OF DRAWINGS

Continuation drawing (90) - 400508

Continuation drawing (90) - 400509

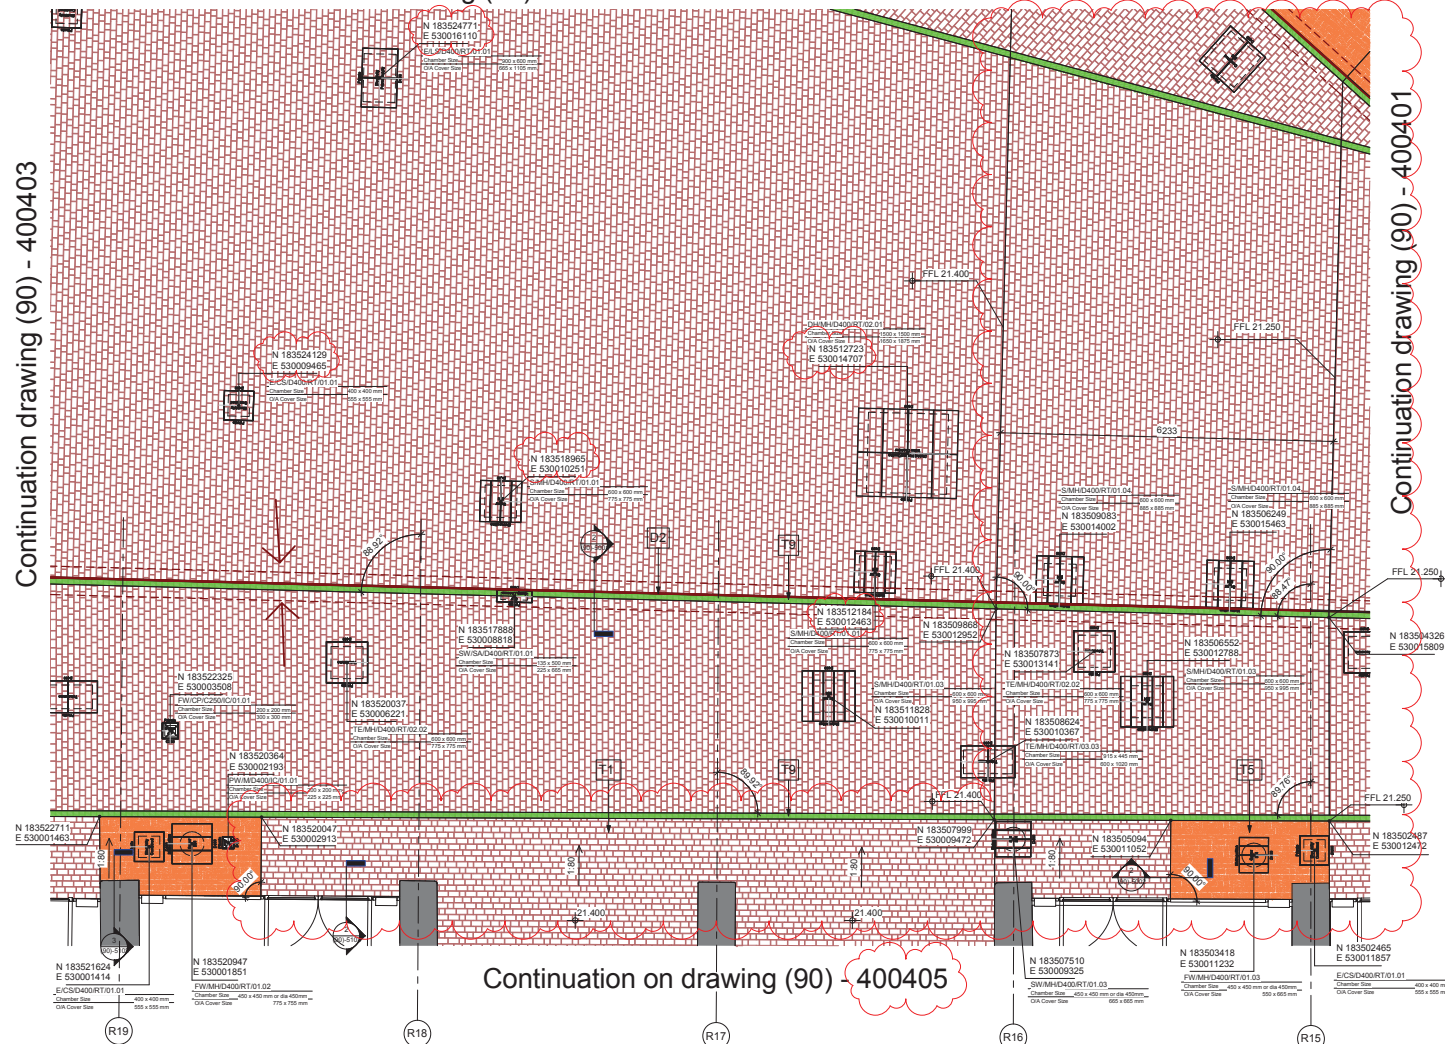

Continuation on drawing (90) - 400405

DO NOT SCALE FROM THIS DRAWING - ALL DIMENSIONS TO BE CHECKED ON SITE

TO BE READ IN CONJUNCTION WITH ALL ARCH DETAILS & SPECIFICATIONS


NOTES:

- This drawing shows design intent only & is subject to detailed design specialists.
 - Figured dimensions only are to be taken from this drawing. All contractors must visit site & are responsible for taking & checking all dimensions relating to their work. BAM Design to be advised of any variation between drawings & site conditions.
 - All vertical dimensions to be taken from FFL, please note that all manufacturing schedules are to take this into account.
 - All dimensions are in millimetres unless noted otherwise.
 - All levels in meters unless noted otherwise.
- To be read in conjunction with -
ARUP drawings for structural frame, openings, supports

NOTES:

- General -**
- Material finishes all to approved samples
 - Areas stated are approximate for pricing exercise only and are total area of BAMC scope of works boundary as indicated on drawing 4389-A-20-001
 - Existing services covers in new / re-installed paving to be re-aligned with paving where possible - individual covers to be reviewed on site
- To be read in conjunction with -
- ARUP Structural Engineers drawings for services, lighting layouts
 - ARUP / PBA drawings for drainage layouts
 - BAMC Electrical Engineers drawings for services, lighting layouts
 - BAMC for waterproofing details (23 - Series)
 - Miler Druck for paving finishes / cut patterns
 - PBA - Drainage levels

KEY PLAN

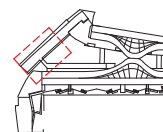

NO.	TM	DW	26.05.17	Updated as per BAMC comments
002	TM	DW	26.05.17	Updated as per BAMC comments

bam
BAM Design Ltd
An operating company of
BAM Contract UK Ltd
Architect
Interior Design
3D Visualisation
Feasibility Studies
Structural Engineering
Building Information Modelling

ARGENT

project COAL DROPS YARD

External Paving Layout - I2 WRA
- L00 Yard Level - Sheet 02

CONSTRUCTION

As indicated @ A1
03/08/16
KXC-12-
001-BD4389-A-(90)-400402 002

drawn TM
checked MHB
Rate 4389
S4

project of issue

LEGEND
External Finishes - The Yard - Ground Floor Level

T1: Granite Stone Sett Paving various rotation. Lengths between 100-250mm Width x 100 Depth. 24% Stirling Red/Grey (availability of Stirling red TBC by quarry), 38% Millennium Green, 38% Sea Black 10mm joints 40mm bed

T2: Sea black setts. The setting-out of the setts within the perimeter of the fan is indicative and should be developed with the paving subcontractor along traditional laying techniques.

SEE DRAWING (90)-5003 FOR TYPICAL 'FAN' PAVING LAYOUTS TYP 1,2,3

T3: Lightly Sawn and Textured Granite Setts - Source from site. Lengths between 100-250mm x 80-125mm Width x APPROX. 100 Depth Sawn + Textured (Tolerance +/- 2mm). (sizes will be limited to available existing sett sizes & numbers.)

T5: Rough Reclaimed Granite Setts - Source from site. Lengths between 100-250mm x 80-125mm Width x Approx 100 Depth. Reclaimed, cleaned + laid with no finish. (sizes will be limited to available existing sett sizes & numbers.)

T7: Sea black paving zone to mark original ECD Viaduct footprint. Two rows border around periphery

T8: Tactile Granite Corduroy Paving of milled granite to match surrounding paving (Sea black). 800mm Length x 400mm Width x 50mm depth

T9: Single line of new granite setts threshold 100x100 Width x 100 Depth. Colour to match T1.

T9B: Triple line of new granite setts threshold 100x100 Width x 100 Depth. Colour to match T1.

Slot Drain - C250
Slot Drain - D400

Concrete encasing for Slot Drain

Concrete encasing for Slot Drain

CF: Compressible filler


MJ: Expansion joint in paving

See Structural Engineers Details

Fall lines shown indicatively, slopes to be executed with soft blends, no setts to be cut

SOP: Setting out position for paving finish

Continuation on drawing (90) - 400504

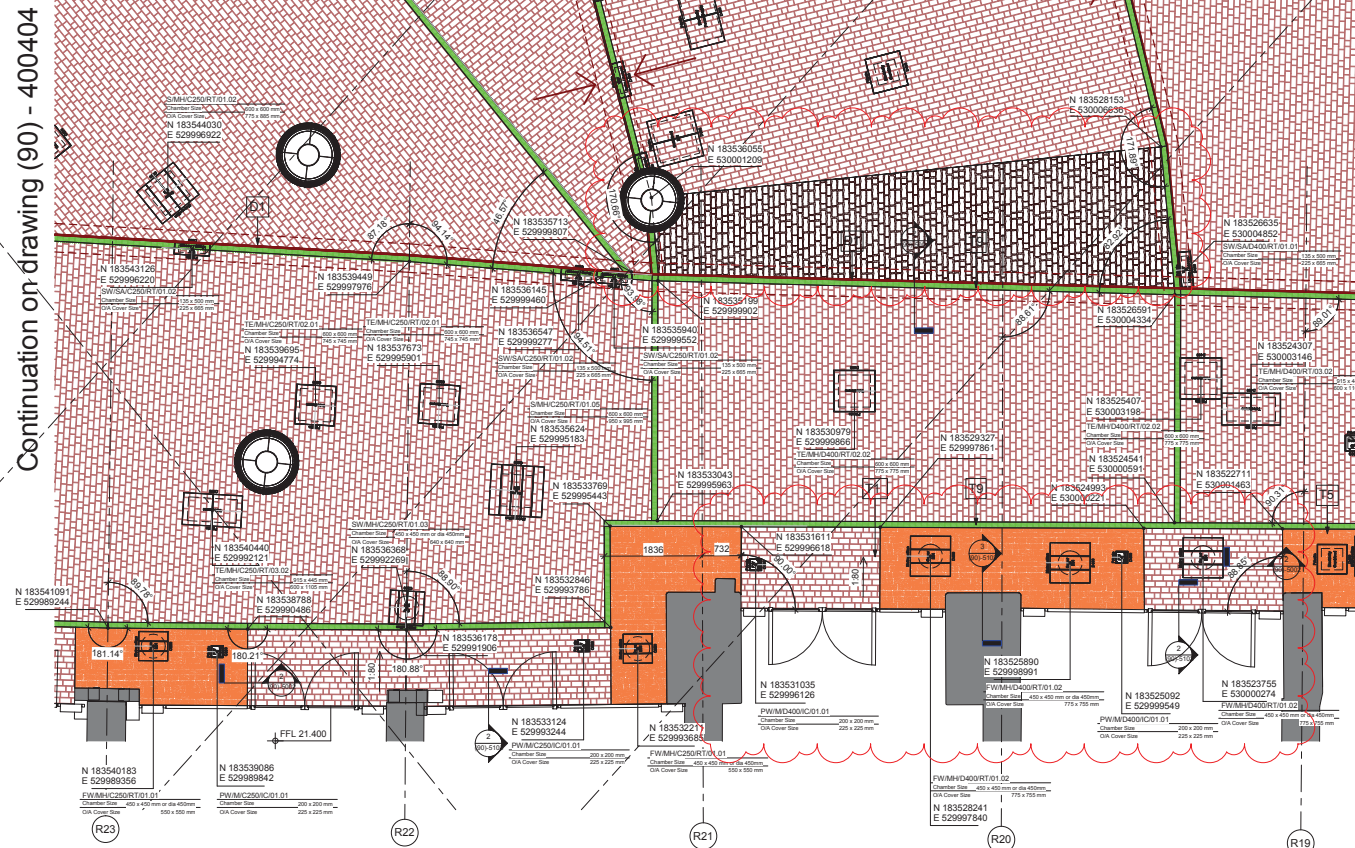

Continuation on drawing (90) - 400404

Continuation on drawing (90) - 400402

DO NOT SCALE FROM THIS DRAWING - ALL DIMENSIONS TO BE CHECKED ON SITE

NOTES:

- This drawing shows design intent only & is subject to detailed design specialists.
- Figured dimensions only are to be taken from this drawing. All contractors must visit site & are responsible for taking & checking all dimensions relating to their work. BAM Design to be advised of any variation between drawings & site conditions.
- All vertical dimensions to be taken from FFL, please note that all manufacturing schedules are to take this into account.
- All dimensions are in millimetres unless noted otherwise.
- All levels in meters unless noted otherwise.


To be read in conjunction with -
ARUP drawings for structural frame, openings, supports

TO BE READ IN CONJUNCTION WITH ALL ARCH DETAILS & SPECIFICATIONS

NOTES:

- General -**
- Material finishes all to approved samples
- Areas stated are approximate for pricing exercise only and are total area of BAMC scope of works boundary as indicated on drawing 4389-A-20-01
- Existing services covers in new / re-installed paving to be re-aligned with paving where possible - individual covers to be reviewed on site
- To be read in conjunction with -
- ARUP Structural Engineers drawings for sub base information
- ARUP / PBA drawings for drainage layouts
- BAMC Electrical Engineers drawings for services, lighting layouts
- Miller Druck for paving finishes / cut patterns
- PBA - Drainage levels

KEY PLAN

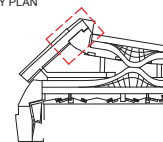

002	TM	DW	26.05.17	Updated as per BAMC comments
Rev	To	By	Date	Description



BAM Design Ltd
An operating company of
BAM Contract UK Ltd
Architect
Interior Design
3D Visualisation
Feasibility Studies
Structural Engineering
Groundwater Services
Building Information Modelling

PROJECT COAL DROPS YARD

External Paving Layout - I2 WRA
- L00 Yard Level - Sheet 03

As indicated @ A1	drawn	TM	26.05.17	day	03/08/16	checked	MWB	4389	Scale	1:500	Sheet	S4
date	03/08/16	checked	MWB	4389	Scale	1:500	Sheet	S4				
job	KXC-12-	001-BD4389-A-	(90)-400403	002								