




1 Yard Level- Plan Detail LSS Slot Drain - T1-T9B
1:5

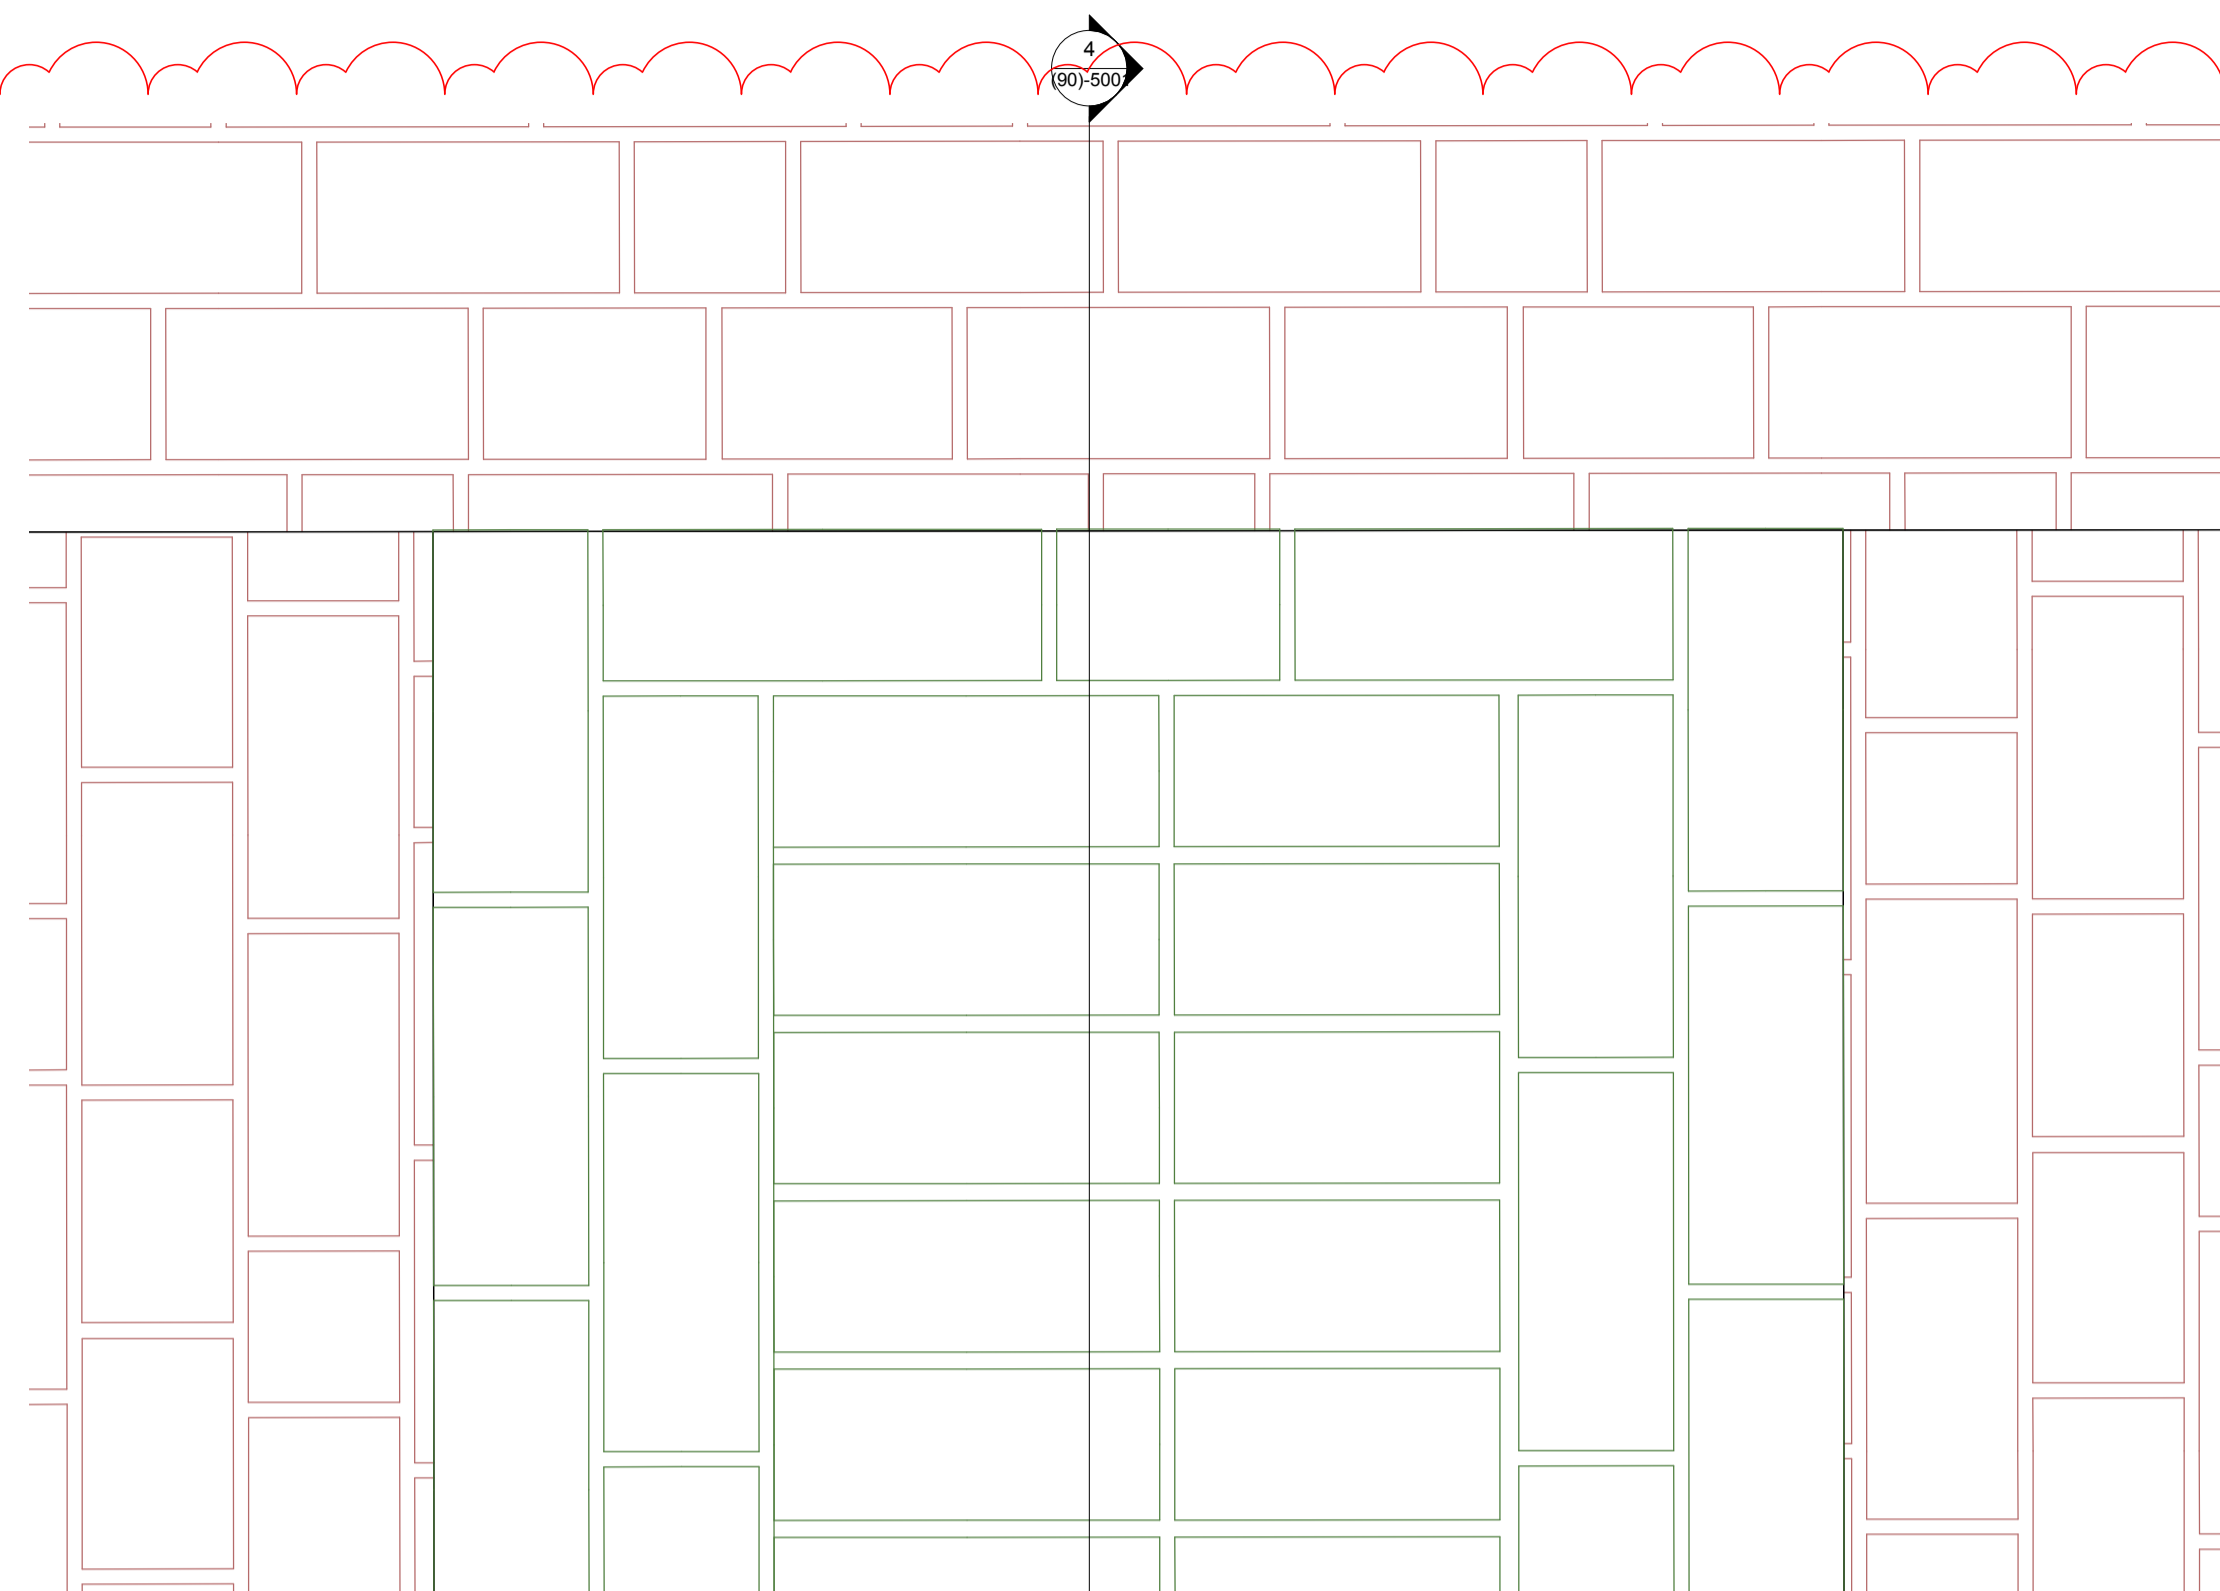

3 Yard Level- Plan Detail ECD Arch Footprint - T1-T7
1:5

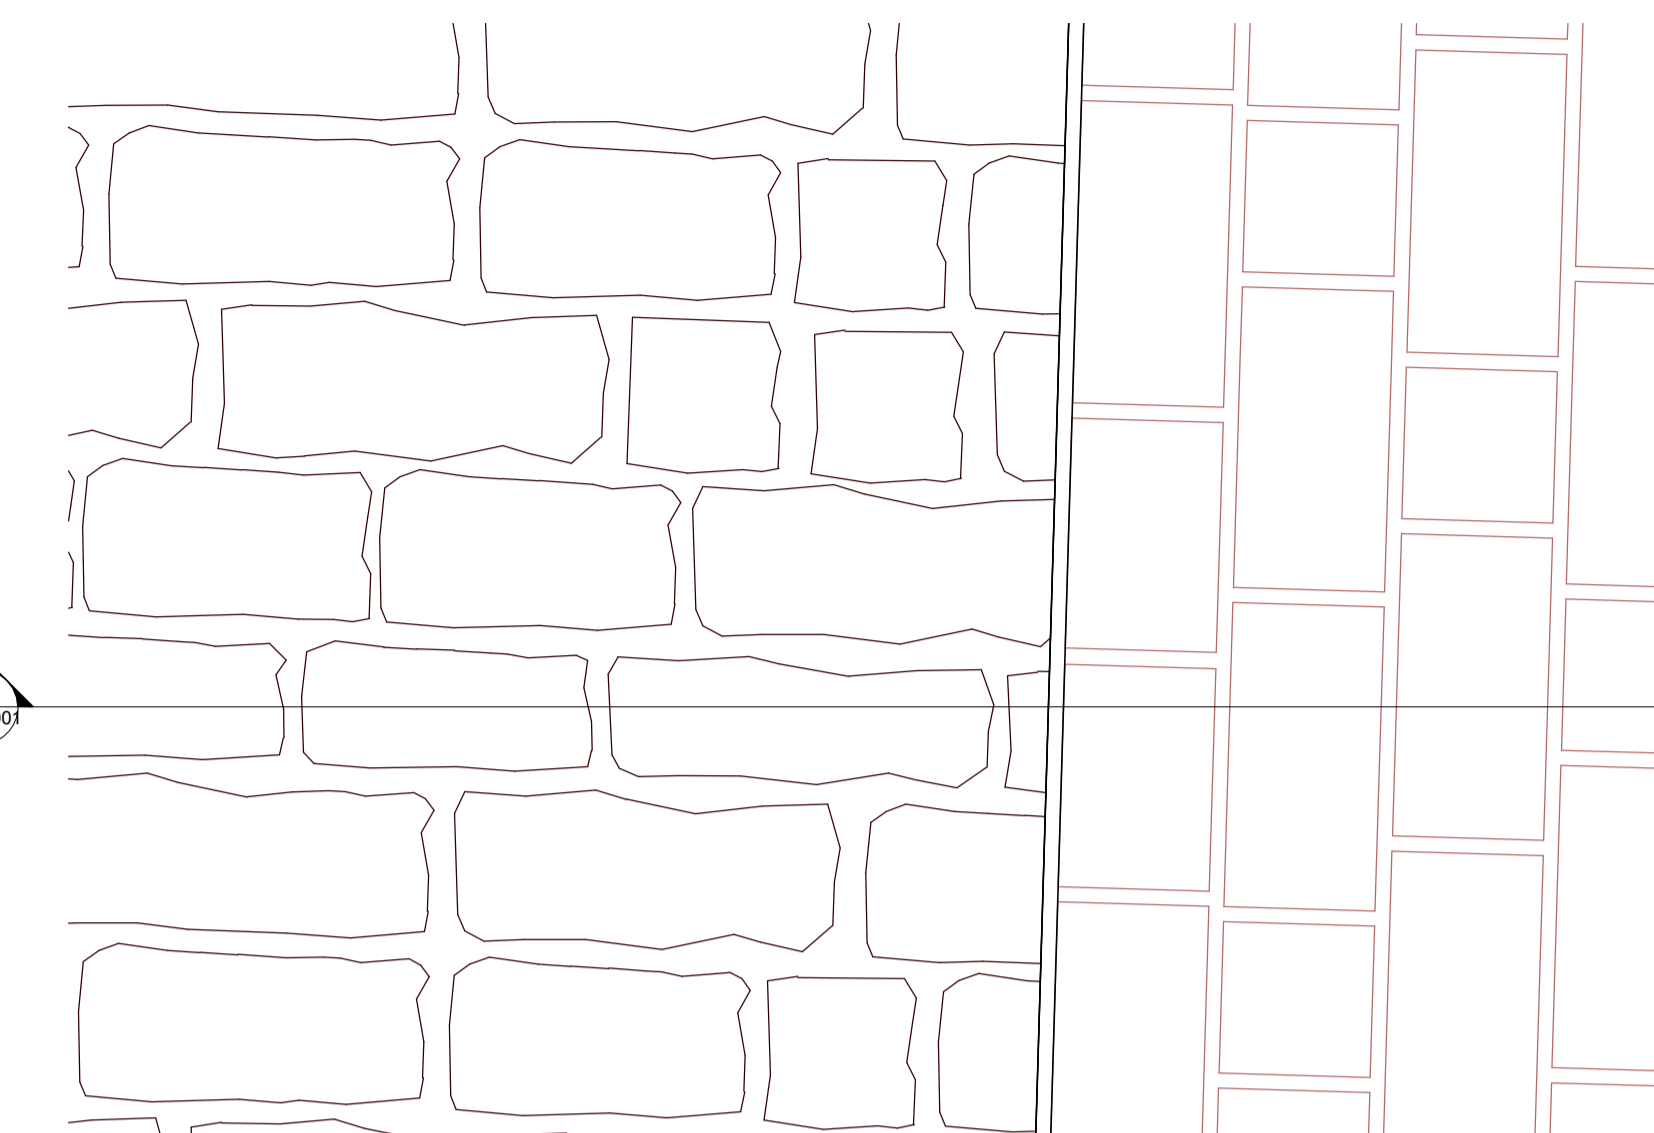

5 Yard Level- Plan Detail ECD Feature Band - T1-T3
1:5

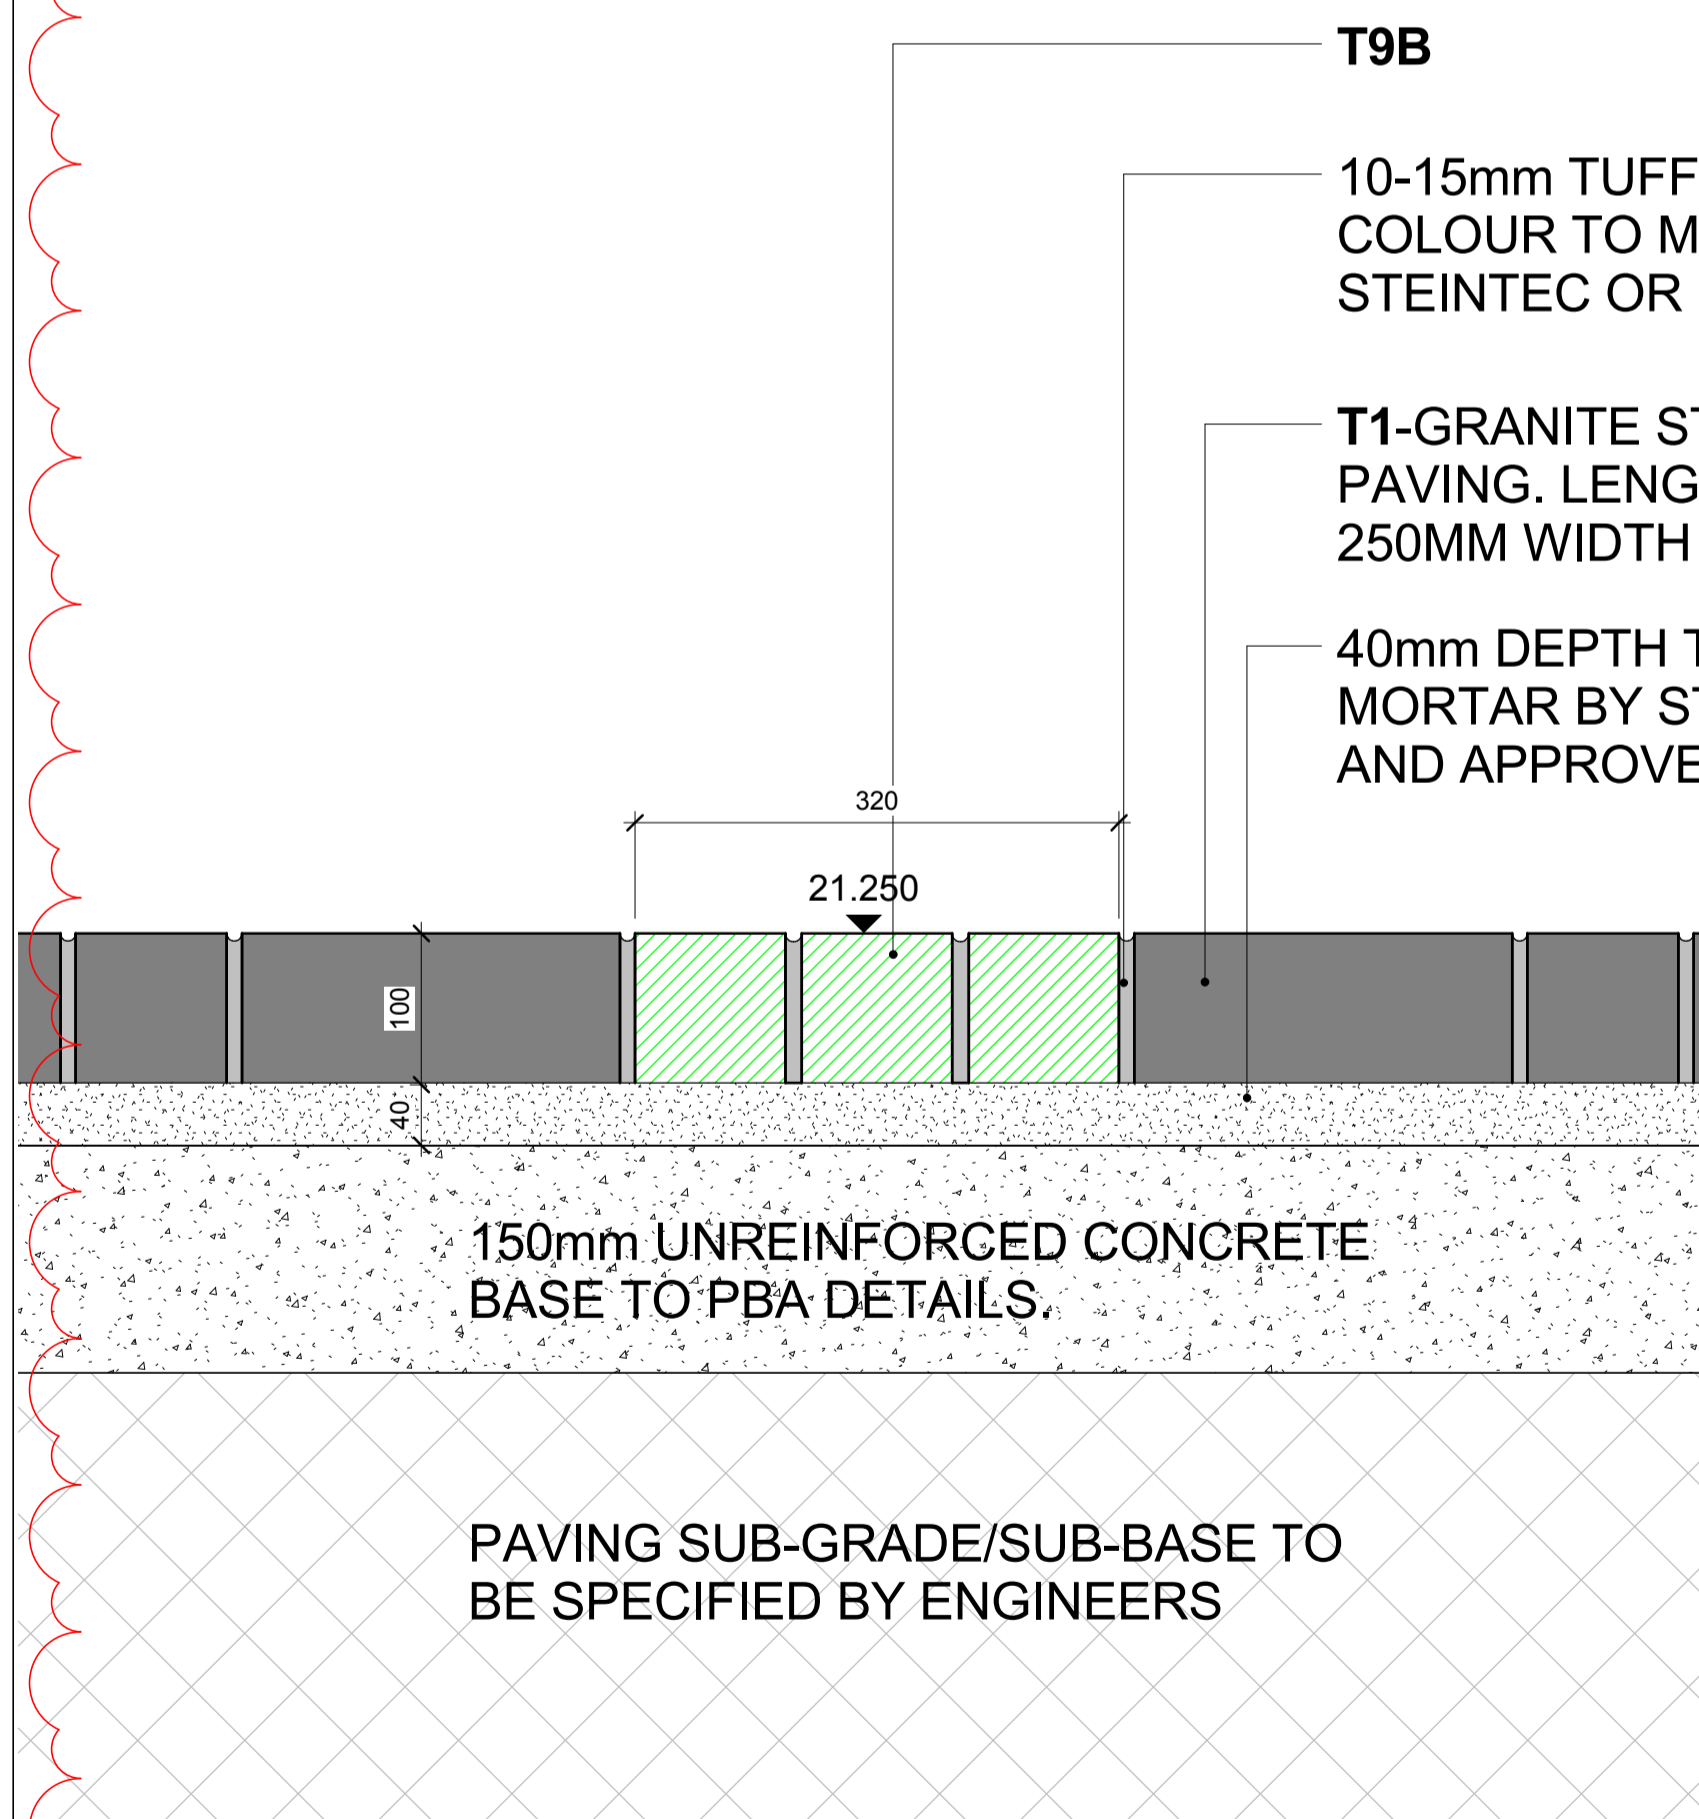

2 Yard Level- Section Detail -T1-T9B
1:5


T9B
 10-15mm TUFFGROUT MORTAR JOINT. COLOUR TO MATCH PAVING. BY STEINTEC OR EQUAL AND APPROVED
T1-GRANITE STONE SETTS PAVING. LENGTH BETWEEN 100-250MM WIDTH X 100MM DEPTH
 40mm DEPTH TUFFBED BEDDING MORTAR BY STEINTEC OR EQUAL AND APPROVED

150mm UNREINFORCED CONCRETE BASE TO PBA DETAILS.

PAVING SUB-GRADE/SUB-BASE TO BE SPECIFIED BY ENGINEERS

T7-Sea black paving zone to mark original ECD Viaduct footprint. Two rows border around periphery

T1-GRANITE STONE SETTS PAVING. LENGTH BETWEEN 100-250MM WIDTH X 100MM DEPTH

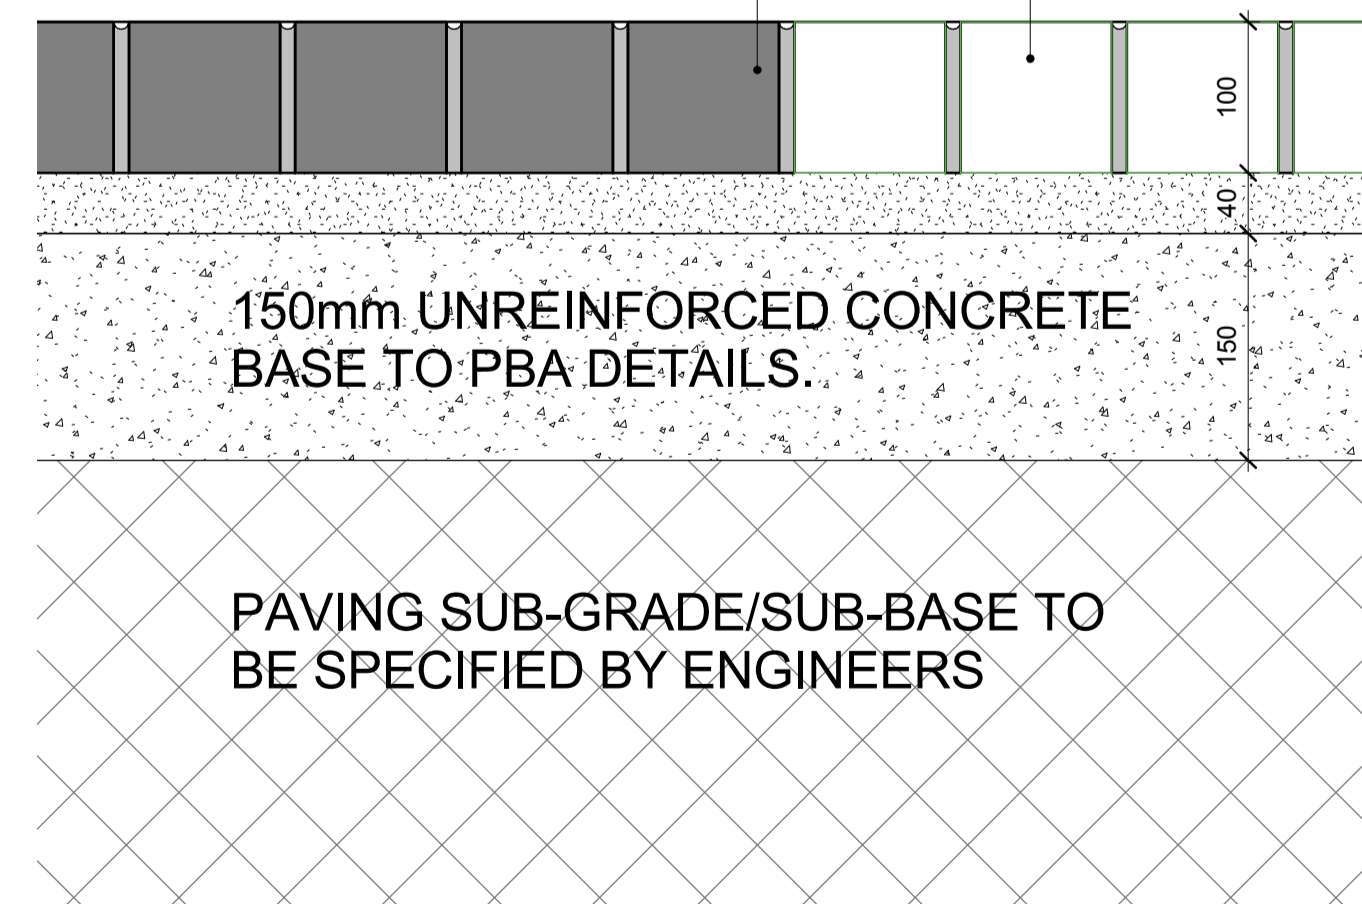

4 Yard Level -Section Detail ECD Feature Band-T1-T7
1:5


150mm UNREINFORCED CONCRETE BASE TO PBA DETAILS.

PAVING SUB-GRADE/SUB-BASE TO BE SPECIFIED BY ENGINEERS

T1-GRANITE STONE SETTS PAVING. LENGTH BETWEEN 100-250MM WIDTH X 100MM DEPTH

T3-LIGHTLY SAWN RECLAIMED GRANITE SETTS - SOURCE FROM SITE

40mm DEPTH TUFFBED BEDDING MORTAR BY STEINTEC OR EQUAL AND APPROVED

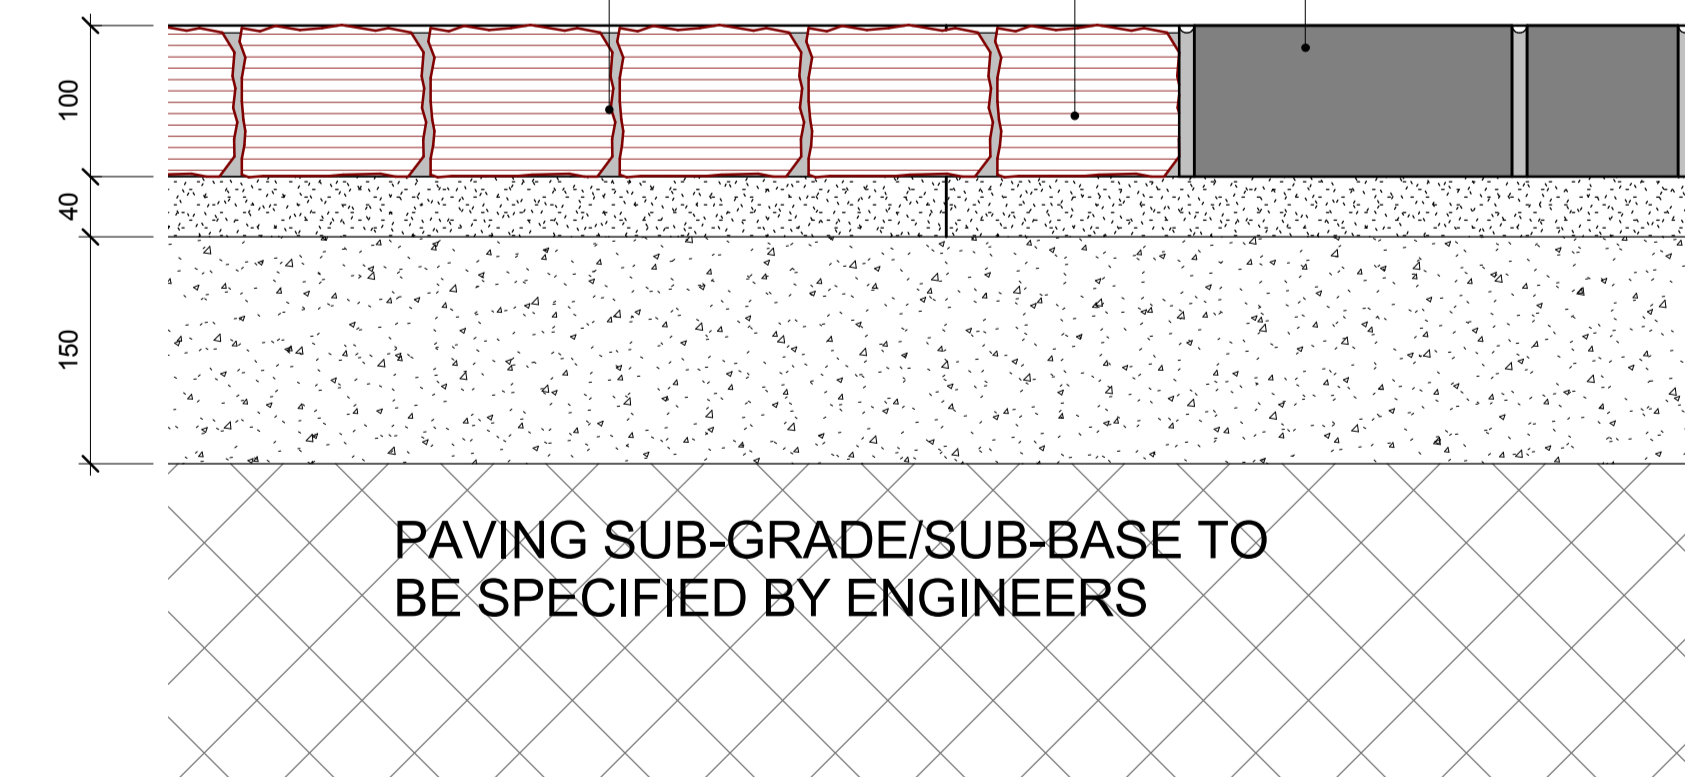


PAVING SUB-GRADE/SUB-BASE TO BE SPECIFIED BY ENGINEERS

6 Yard Level -Section Detail ECD Feature Band-T1-T3
1:5

PLEASE NOTE ALL DRAINAGE LEVELS-FALLS TO PBA DETAILS.

005	TM	MWB	26.05.17	Updated as per BAMC comments
004	dgw	mwb	16-02-17	notes scale updated for clarity.
rev	by	chkd	date	description

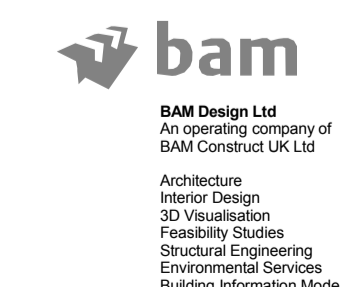

project COAL DROPS YARD


title External Paving - Typical Details - Sheet 01

purpose of issue CONSTRUCTION


scale 1:5 @ A1
 date 20.11.2015
 site 01727 #M4200
 design@bam.co.uk
 www.bam.co.uk

drawn SS
 checked MWB
 consultant Role CISFB
 BAM job no. 4389
 rev S4

005

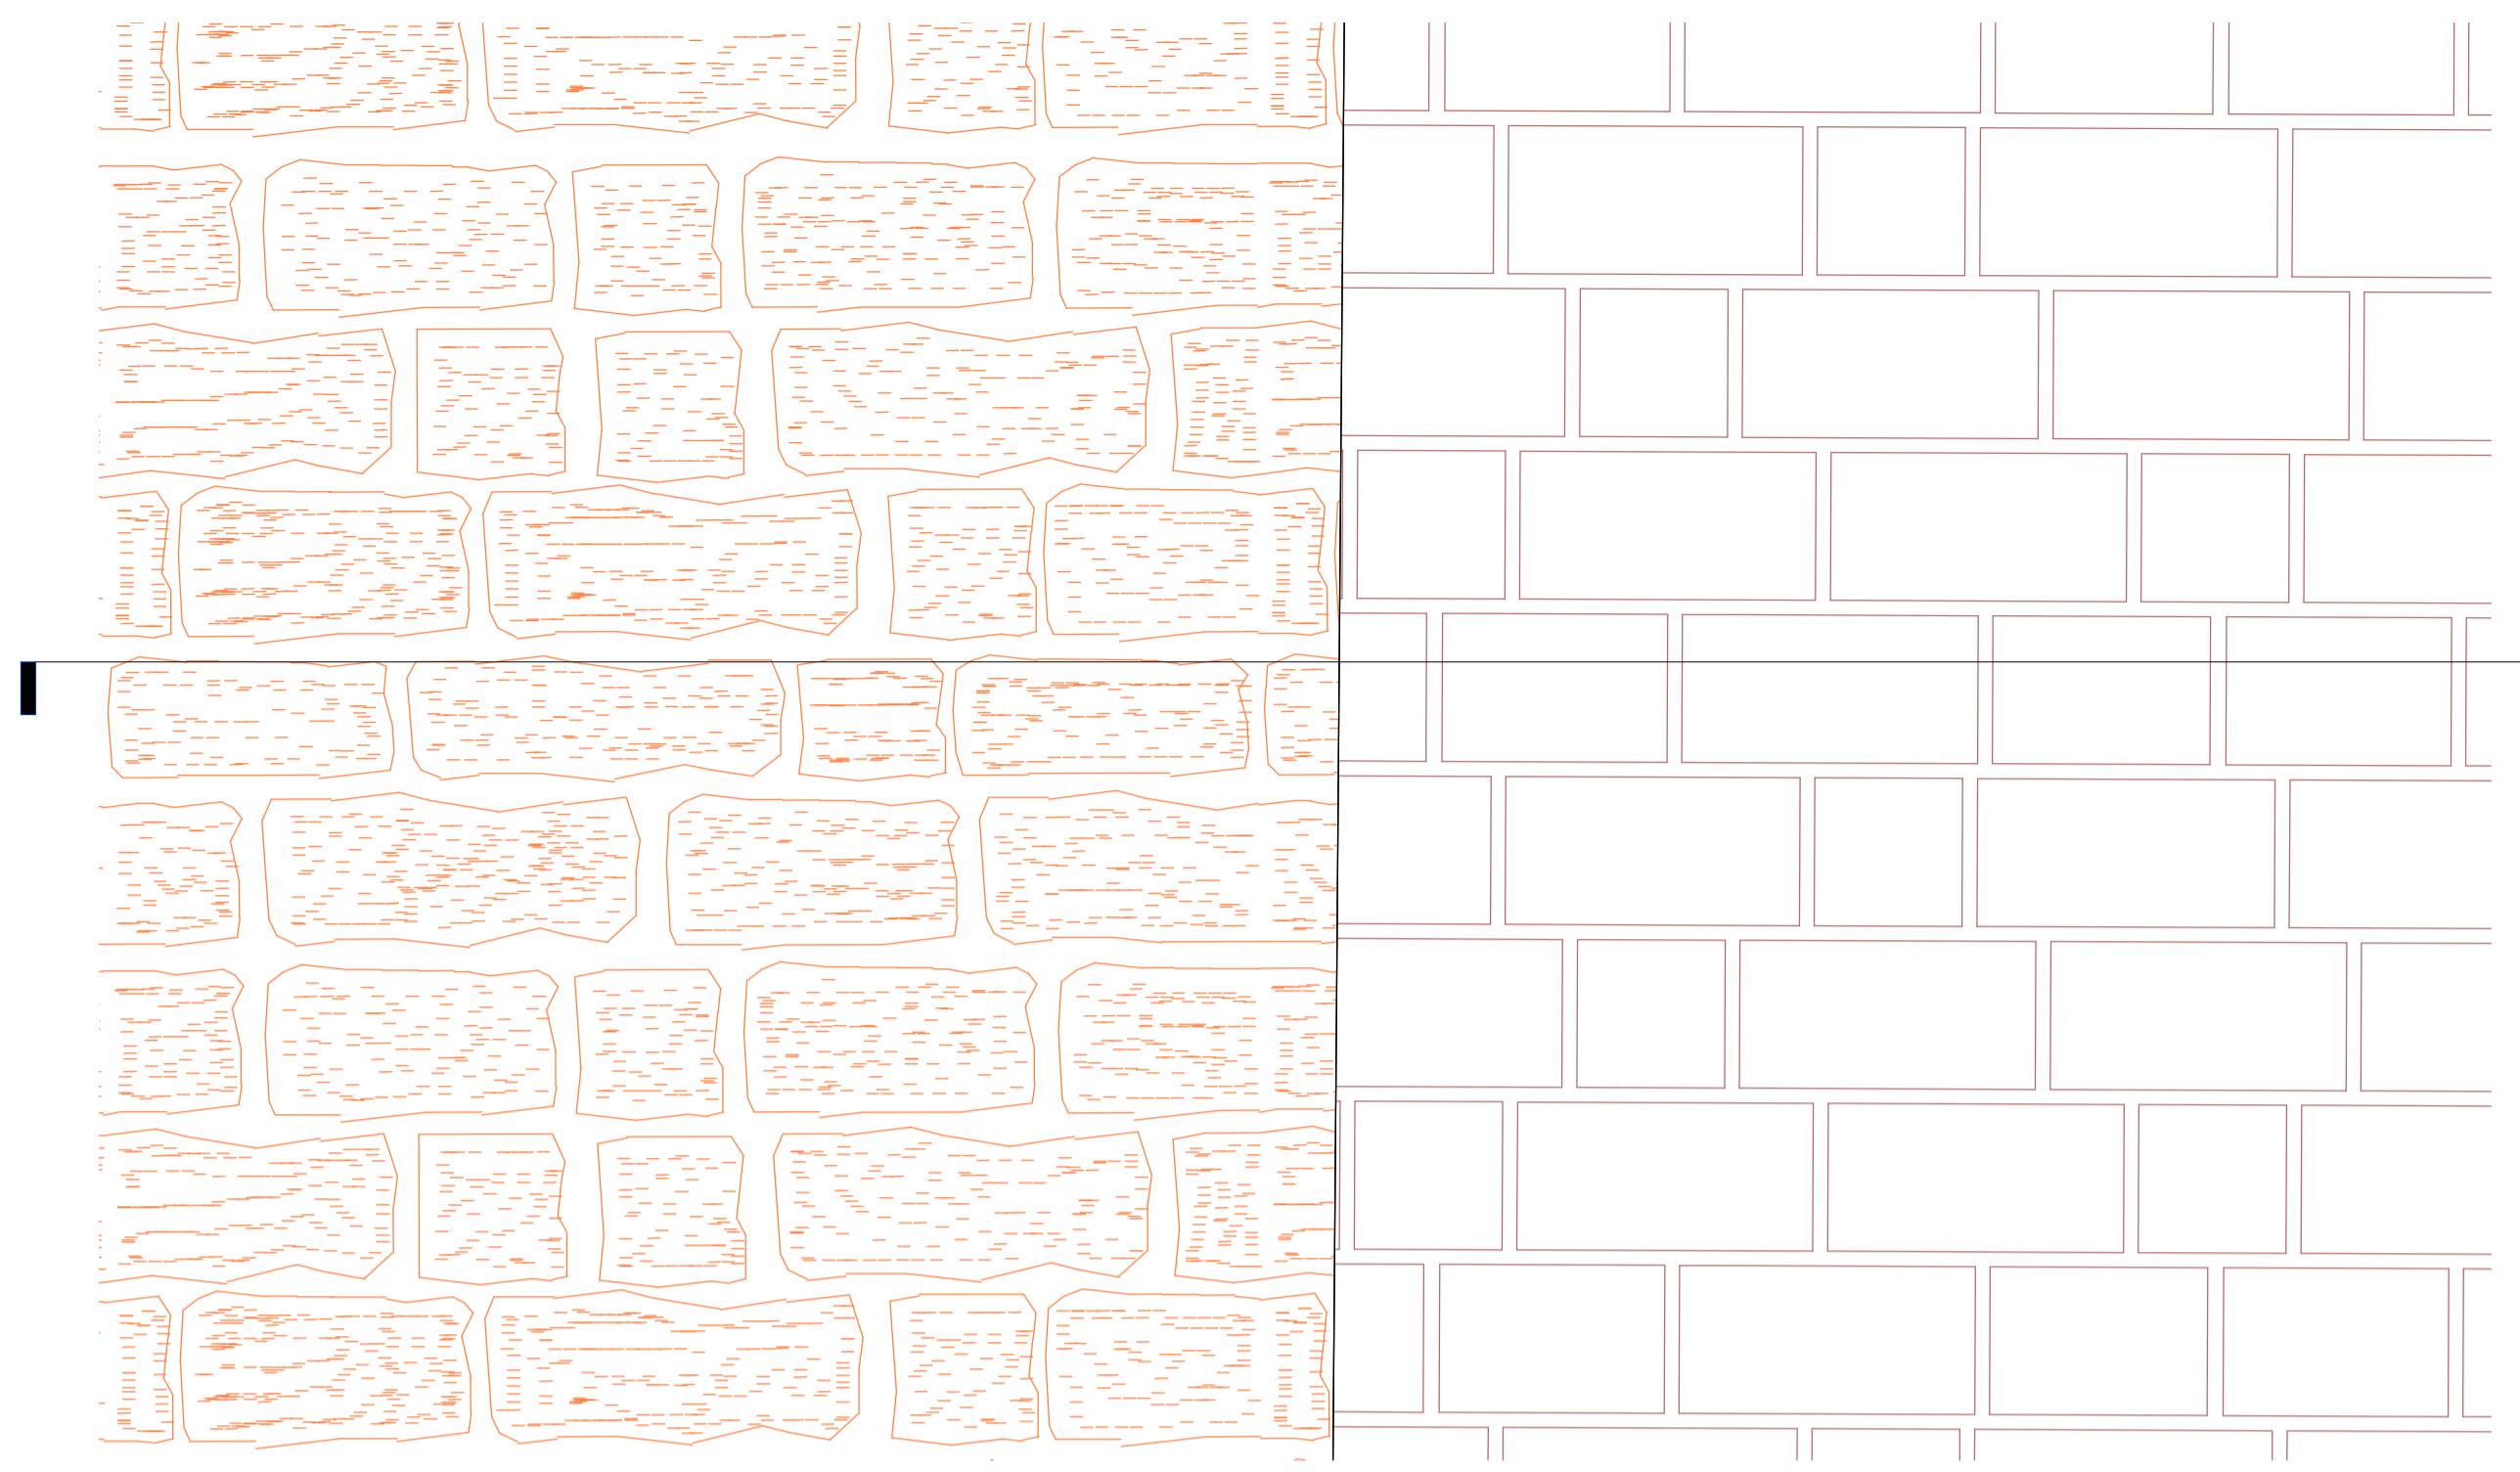

1 Yard level-Plan Detail WRA -T5-T1
 1:5

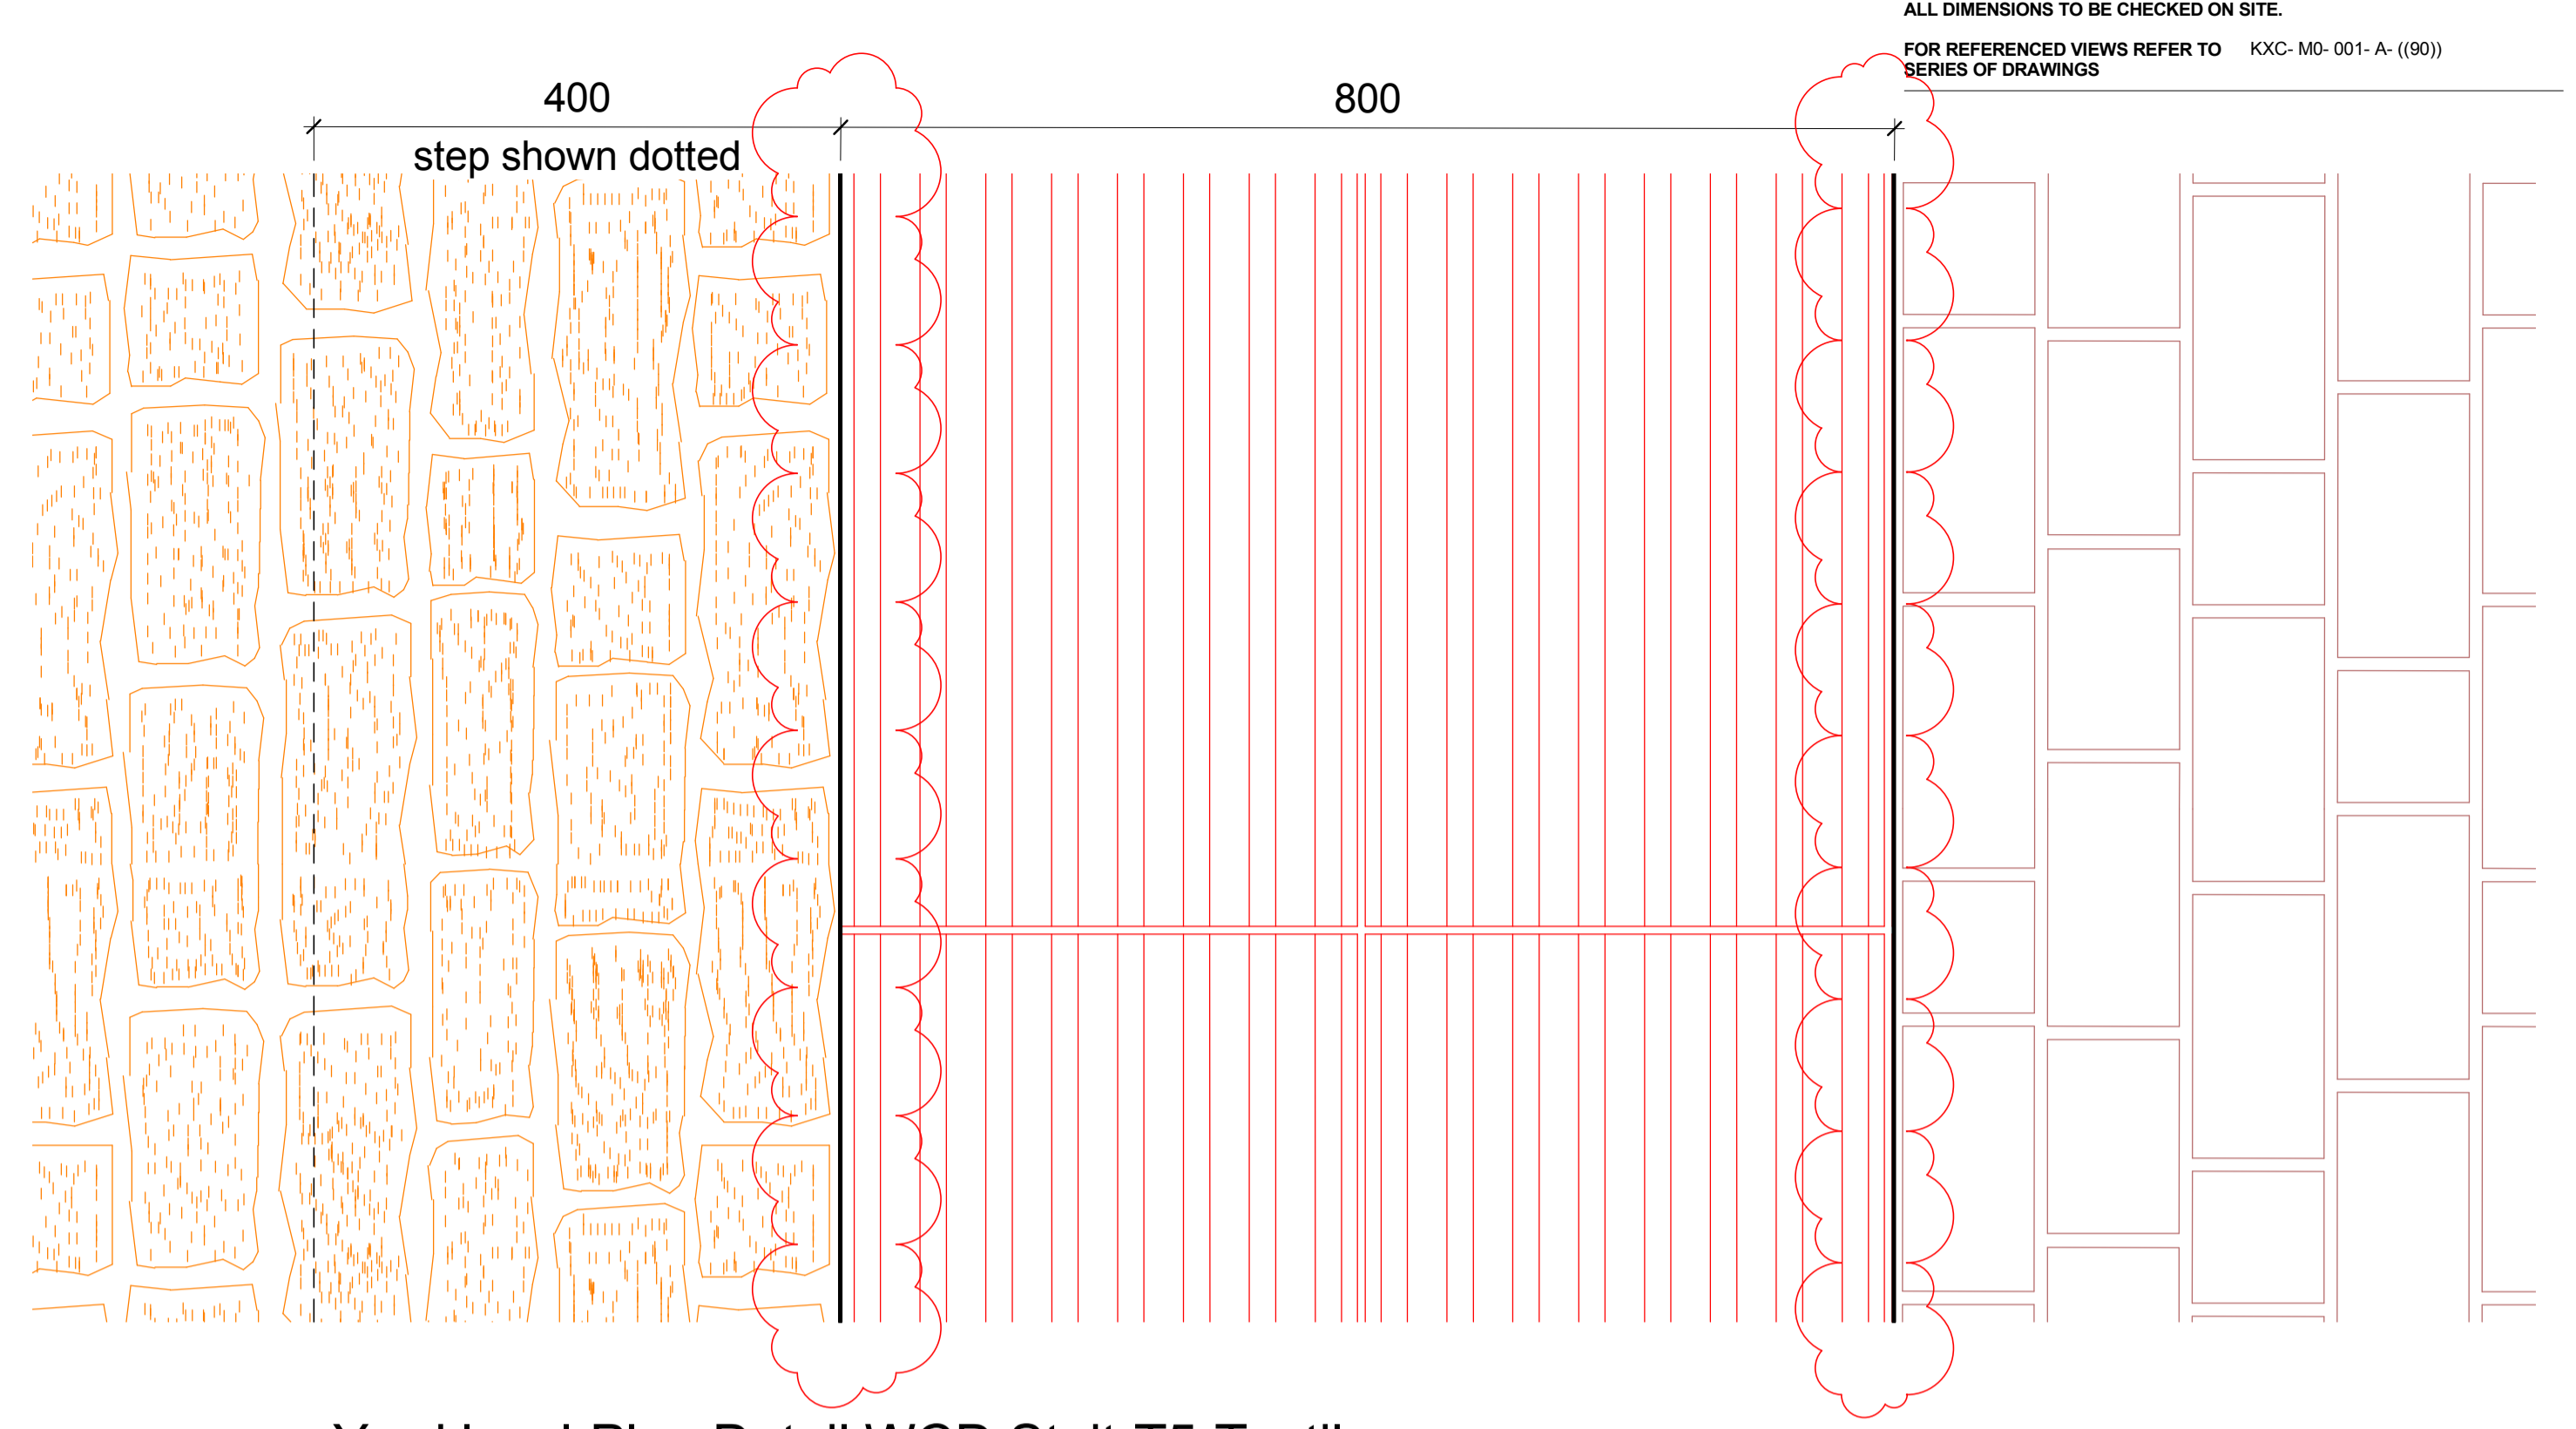

3 Yard level-Plan Detail WCD Stait-T5-Tactile
 1:5

T1-GRANITE STONE SETTS PAVING. LENGTH BETWEEN 100-250MM WIDTH X 100MM DEPTH

T5 : ROUGH RECLAIMED GRANITE SETS LENGTHS BETWEEN 100-250mm x 80-125mm Width 100mm DETH.

10-15mm TUFFGROUT MORTAR JOINT. COLOURED TO MATCH PAVING. BY STEINTEC OR EQUAL AND APPROVED

40mm DEPTH TUFFBED BEDDING MORTAR BY STEINTEC OR EQUAL AND APPROVED


T5 : ROUGH RECLAIMED GRANITE SETS LENGTHS BETWEEN 100-250mm x 80-125mm Width 100mm DETH.

40/80mm DEPTH TUFFBED BEDDING MORTAR BY STEINTEC OR EQUAL AND APPROVED


10-15mm TUFFGROUT MORTAR JOINT. COLOURED TO MATCH PAVING. BY STEINTEC OR EQUAL AND APPROVED

T1-GRANITE STONE SETTS PAVING. LENGTH BETWEEN 100-250MM WIDTH X 100MM DEPTH

T8-TACTILE GRANITE CORDUROY PAVING OF MILLED GRANITE SETTS TO MATCH SURROUNDING PAVING

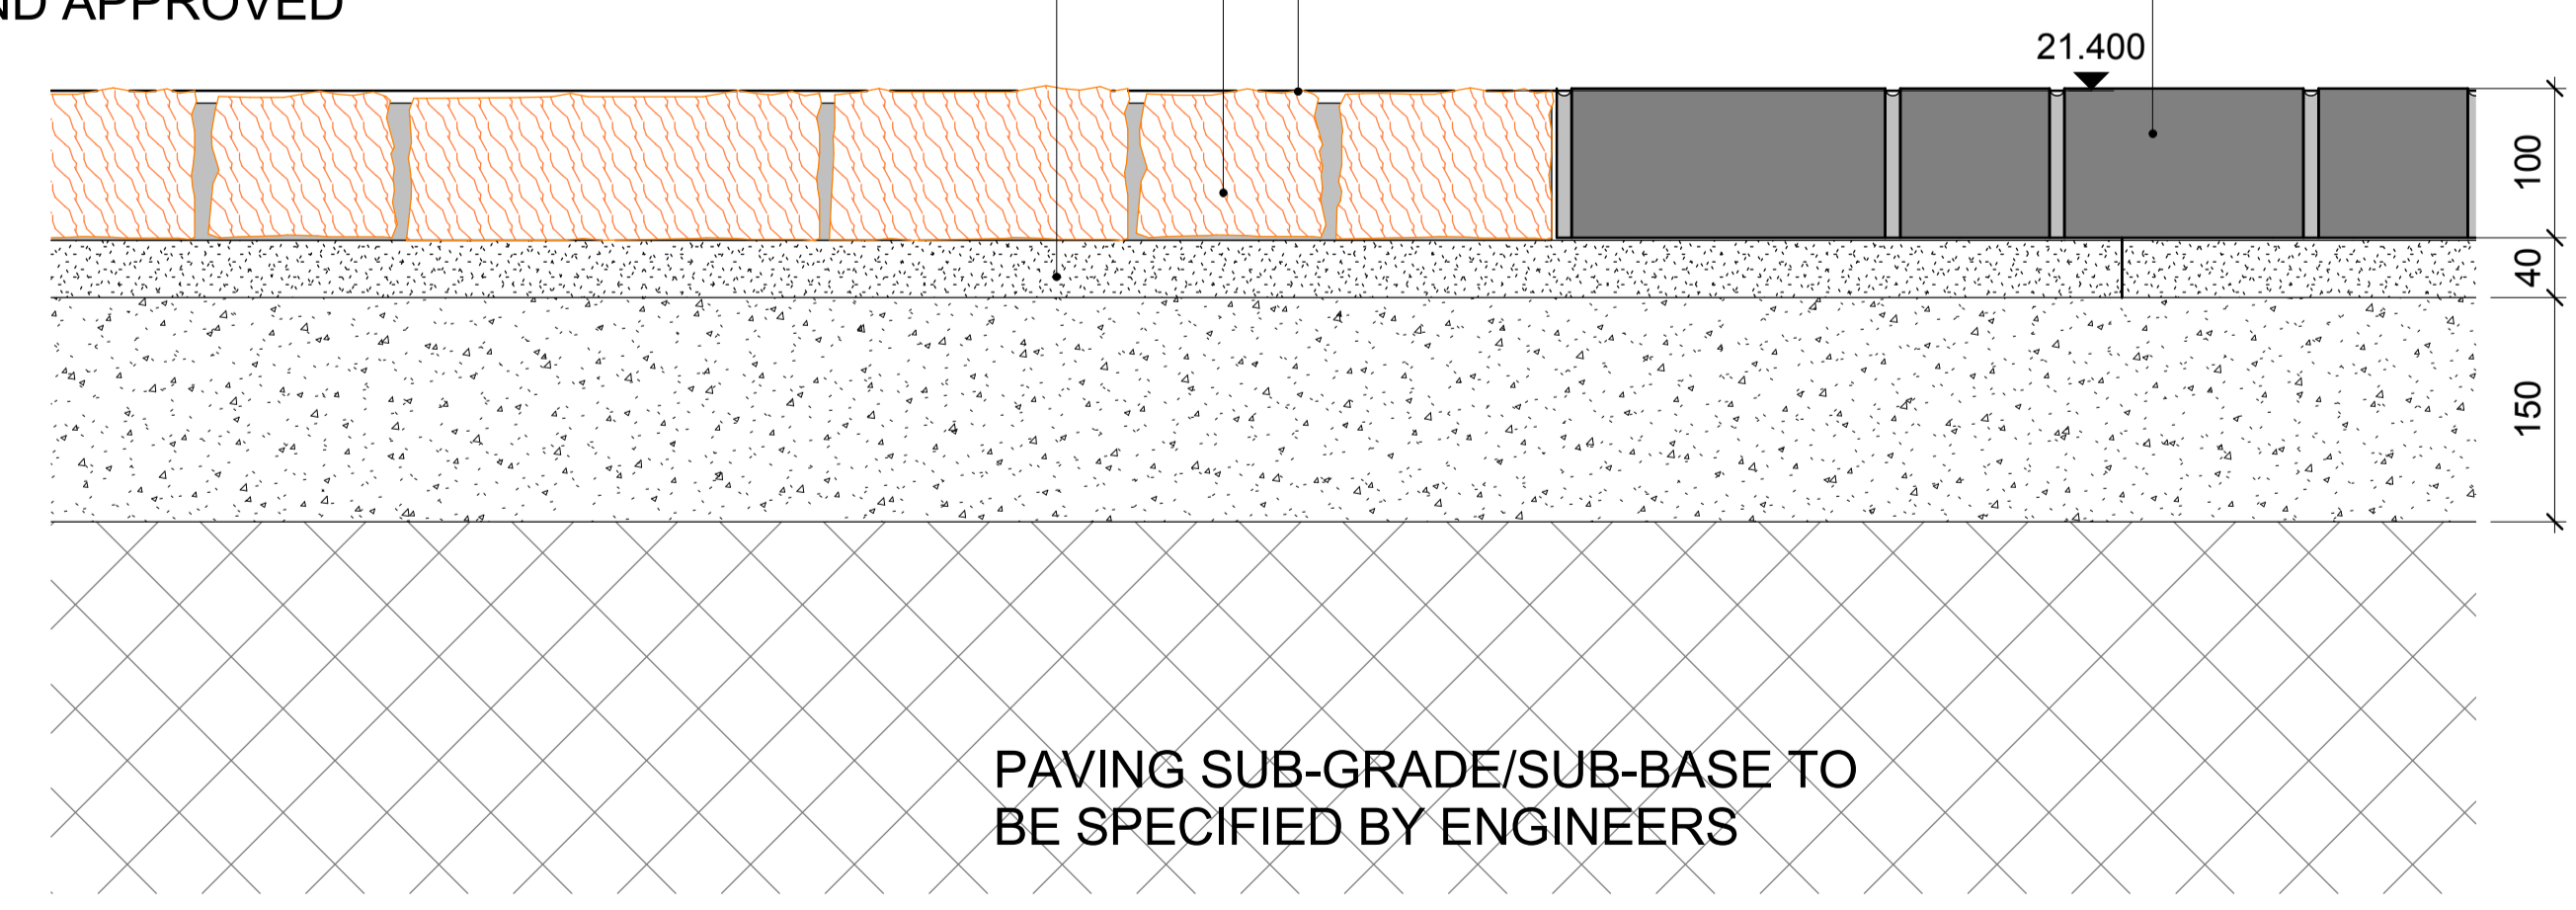

2 Yard level-Section Detail WRA -T5-T10
 1:5

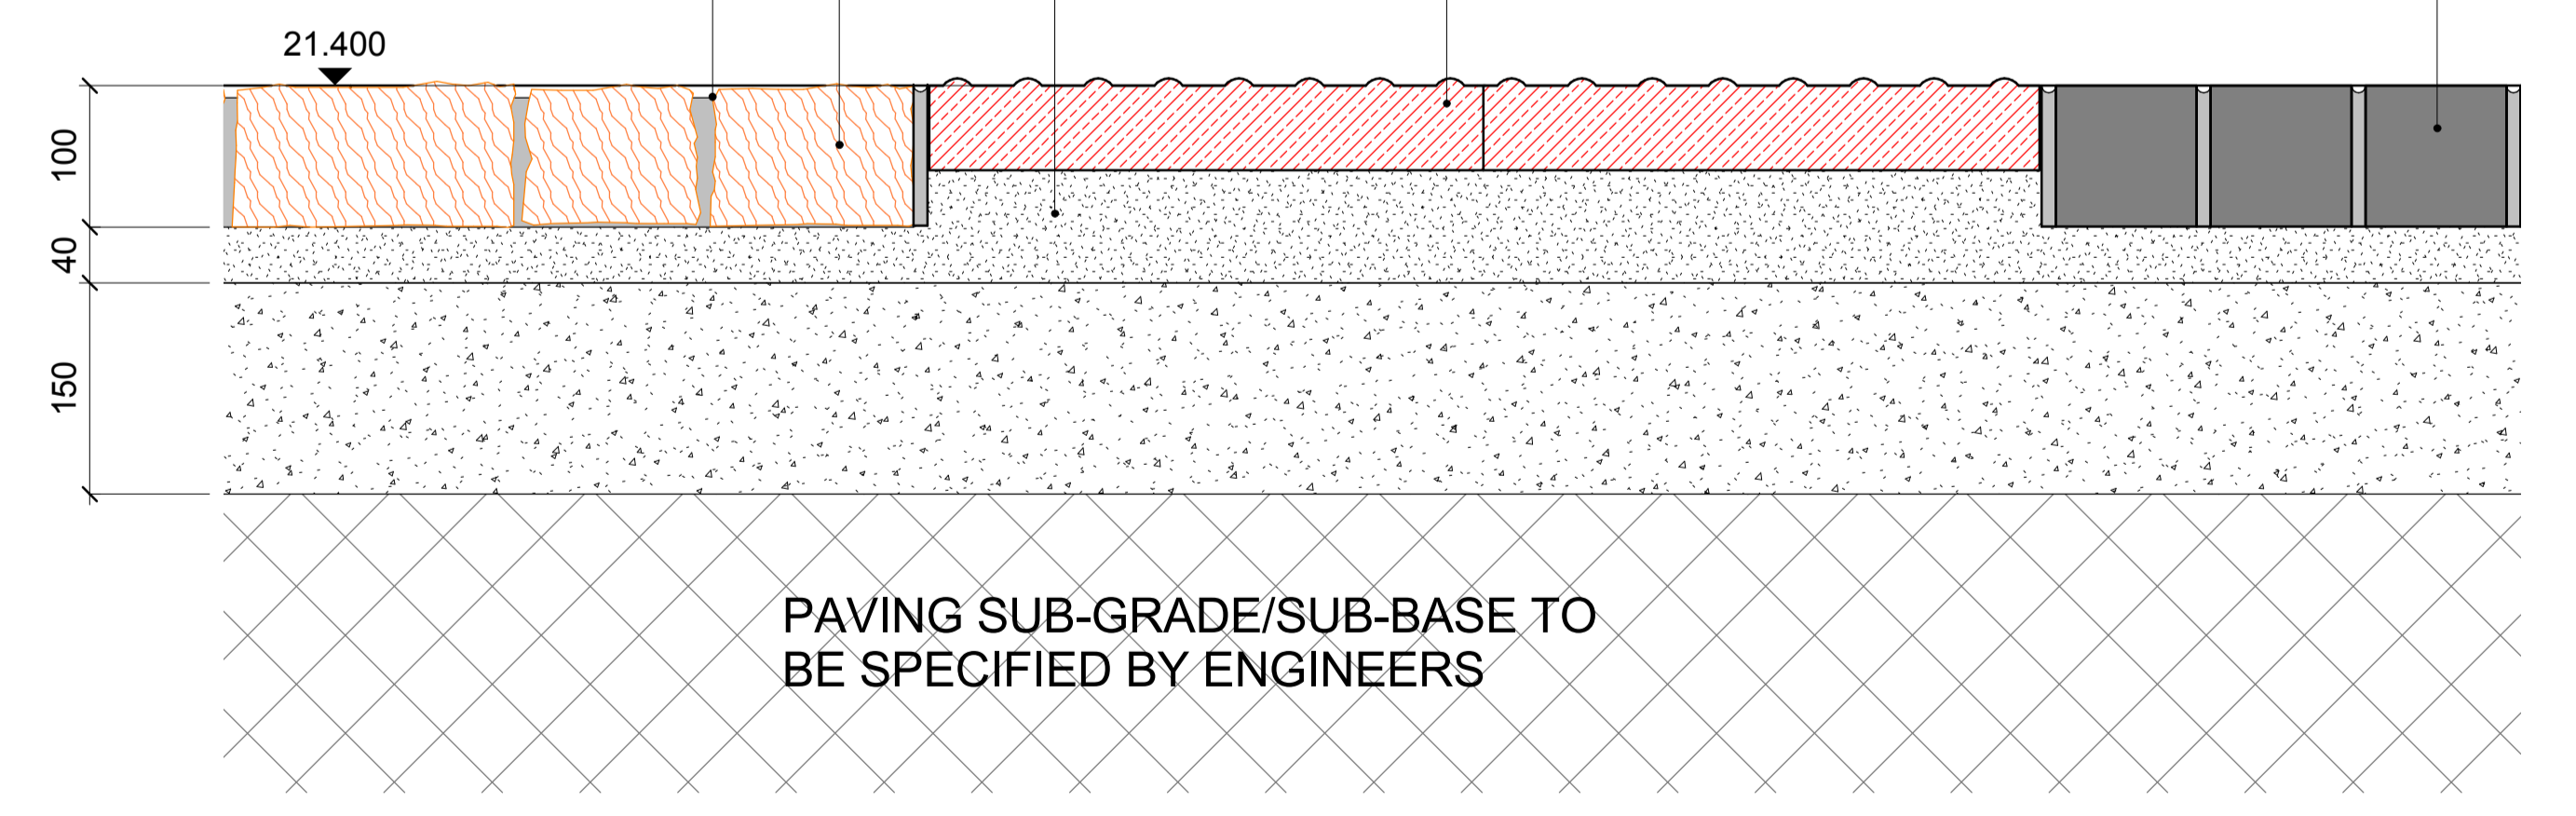

4 Yard level-Section Detail WCD Stait-T5-Tactile
 1:5

Status Code (as defined in BS1192)
 D3 - Issued for contractor design
 D4 - Issued for manufacture/procurement

Work In Progress (WIP)
 S0 - Initial Status or WIP

Shared
 S1 - Issued for co-ordination
 S2 - Issued for information
 S3 - Issued for internal review
 S4 - Issued for construction approval

Documentation (Pre-construction)
 D1 - Issued for costing
 D2 - Issued for tender

Documentation (Contractual)
 A - Issued for construction
 B - Issued for construction but with comments
 C - Comprehensive revision required

Archive
 AB - Record Drawing

rev	by	chkd	date	description
004	TM	MWB	26.05.17	Updated as per BAMC comments
003	dgw	mwb	16-02-17	scale changed notes added for clarity.
002	SS	MWB	27.01.16	Updated to meet BAMC Comments
001	SS	MWB	21.12.15	General Paving Layout Updated to meet HS and BAMC Comments



bam
 BAM Design Ltd
 An operating company of
 BAM Construct UK Ltd

Architecture
 Interior Design
 3D Visualisation
 Feasibility Studies
 Structural Engineering
 Environmental Services
 Building Information Modelling

Centrium Business Park
 Griffiths Way, St Albans
 Hertfordshire, AL1 2RD
 01727 894200
 design@bam.co.uk
 www.bam.co.uk

project COAL DROPS YARD

title External Paving - Typical Details - Sheet 02

purpose of issue CONSTRUCTION

scale 1:5 @ A1

date 20.11.2015

site KXC-M0- 001-BD4389-A-(90)-5002

drawn SS

checked MWB


design 4389

role C/SFB

content

rev 004

2
90-5003

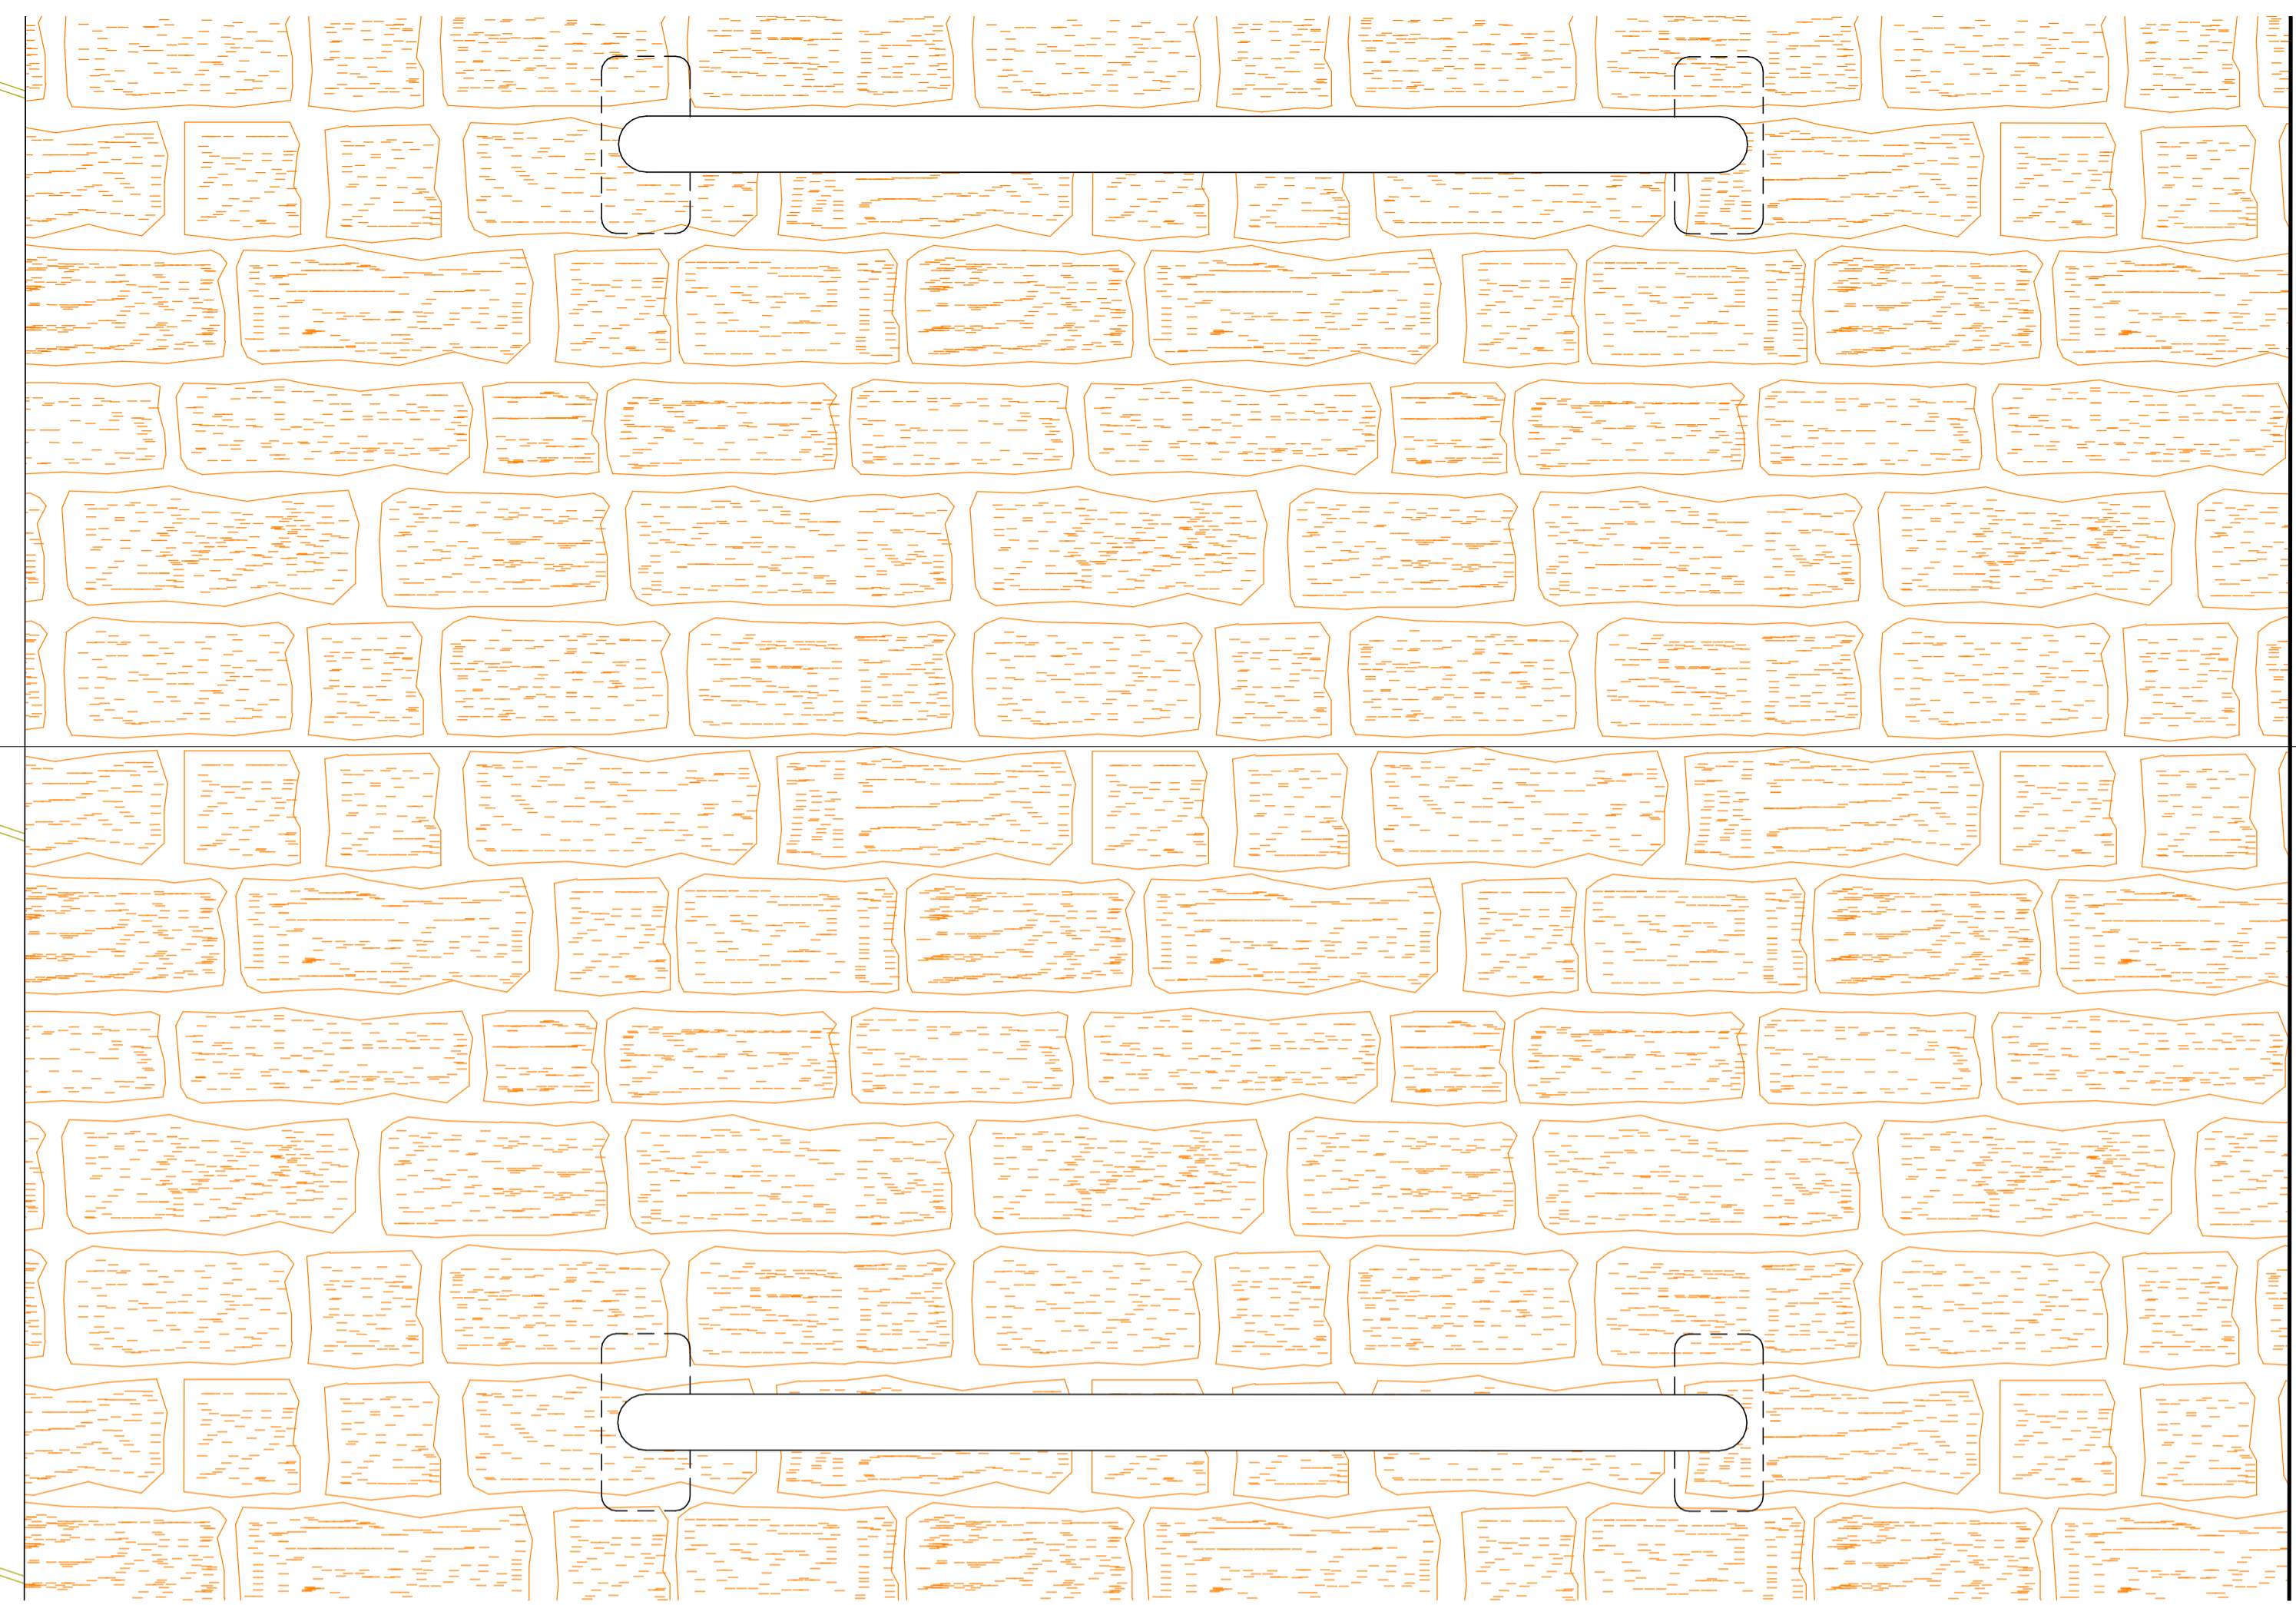

1 Mezzanine Level-Plan Detail Stable Street-T5-T11
1:5

T11-YORK SRONE PAVERS TO MATCH KINGS CROSS STANDARDS. 50MM DEEP. TILE DESIGN AND ZIES TBC BY LANDSCAPE DESIGNERS.


REF WATERPROOFING DETAILS ARCH 23-5227-5229

HYDROTECH
6mm Hydrotech monolithic membrane 6125 on alumasc bitumen primer with Hydroguard 40 and second coat of Hydrotech 6125 with Flex-Flash reinforcement. REF. ARCH SPEC {J31-353-05}

T5 : ROUGH RECLAIMED GRANITE SETS LENGTHS BETWEEN 100-250mm x 80-125mm Width 100mm DETH.

10-15mm TUFFGROUT MORTAR JOINT. COLOURED TO MATCH PAVING. BY STEINTEC OR EQUAL AND APPROVED

40/90mm DEPTH TUFFBED BEDDING MORTAR BY STEINTEC OR EQUAL AND APPROVED

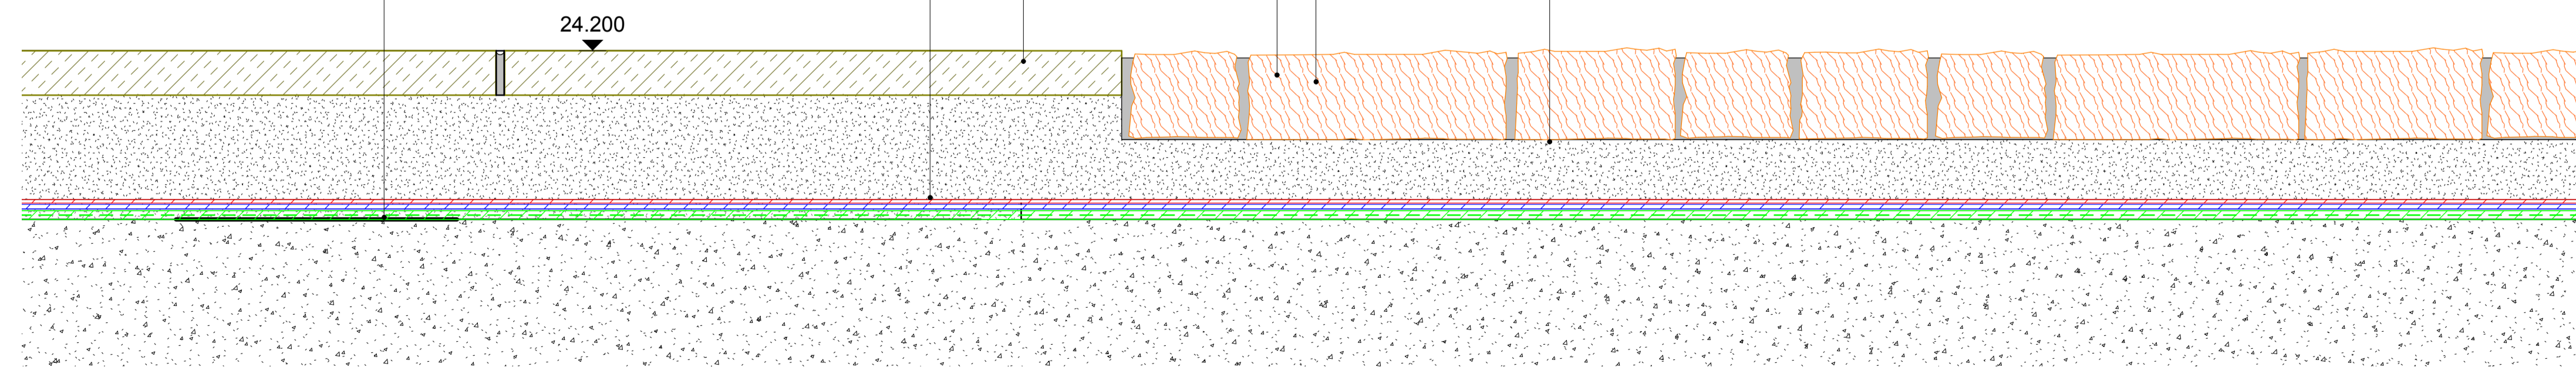

2 Mezzanine Level-section Detail Stable Street-T5-T11
1:5

Status Code (as defined in BS1192)
D3 - Issued for contractor design
D4 - Issued for manufacture/procurement

Work In Progress (WIP)
S0 - Initial Status or WIP

Shared
S1 - Issued for co-ordination
S2 - Issued for information
S3 - Issued for internal review
S4 - Issued for construction approval




Documentation (Pre-construction)
D1 - Issued for costing
D2 - Issued for tender

Documentation (Contractual)
A - Issued for construction
B - Issued for construction but with comments
C - Comprehensive revision required

Archive
AB - Record Drawing

rev	by	chkd	date	description
004	TM	MWB	26.05.17	Added fan paving details
003	dgw	mwb	16-02-17	scale updated with notes for clarity
002	SS	MWB	27.01.16	Updated to meet BAMC Comments
001	SS	MWB	21.12.15	General Paving Layout Updated to meet HS and BAMC Comments

DO NOT SCALE FROM THIS DRAWING.
ALL DIMENSIONS TO BE CHECKED ON SITE.
FOR REFERENCED VIEWS REFER TO SERIES OF DRAWINGS

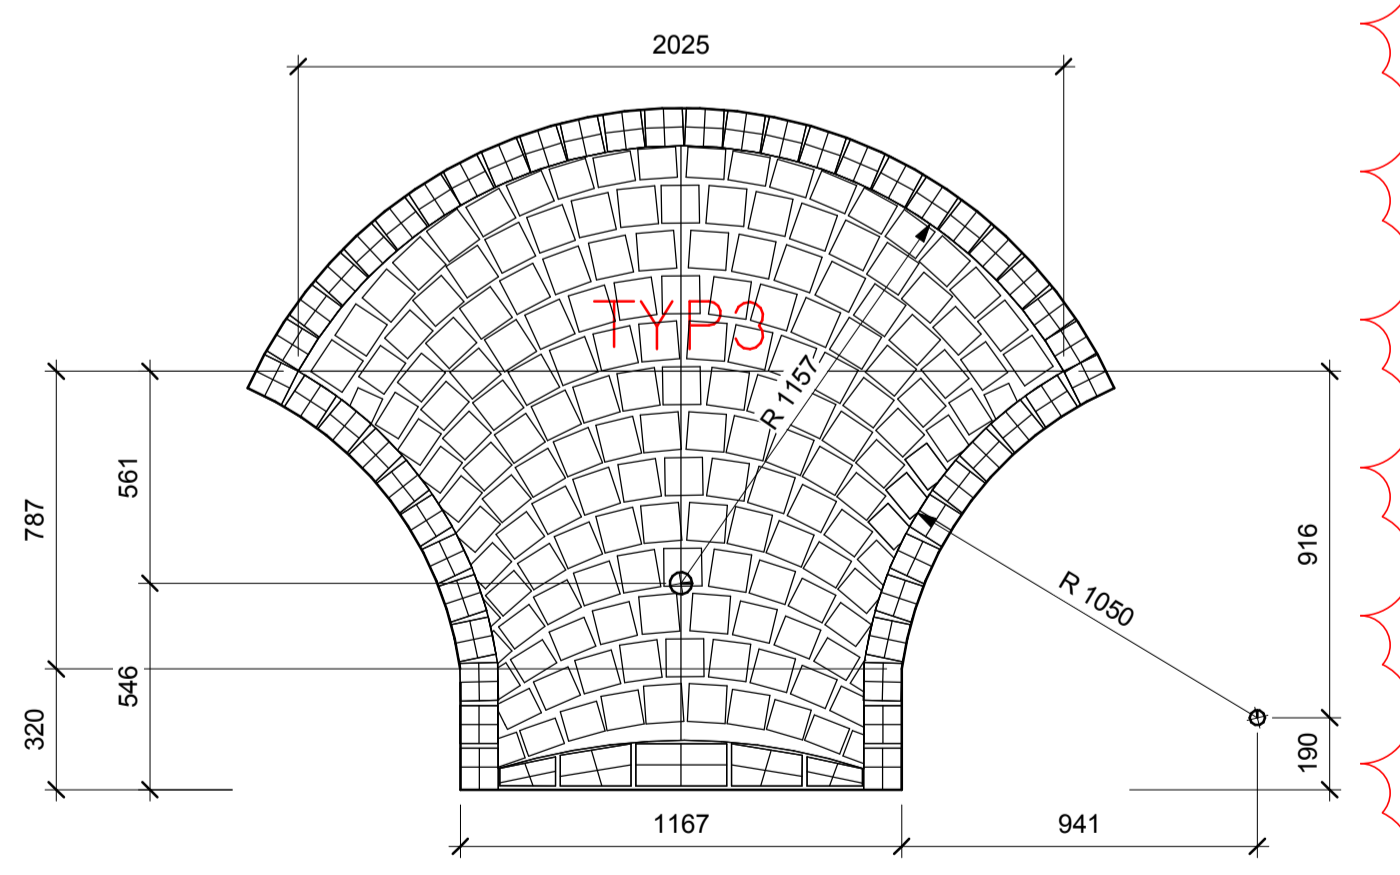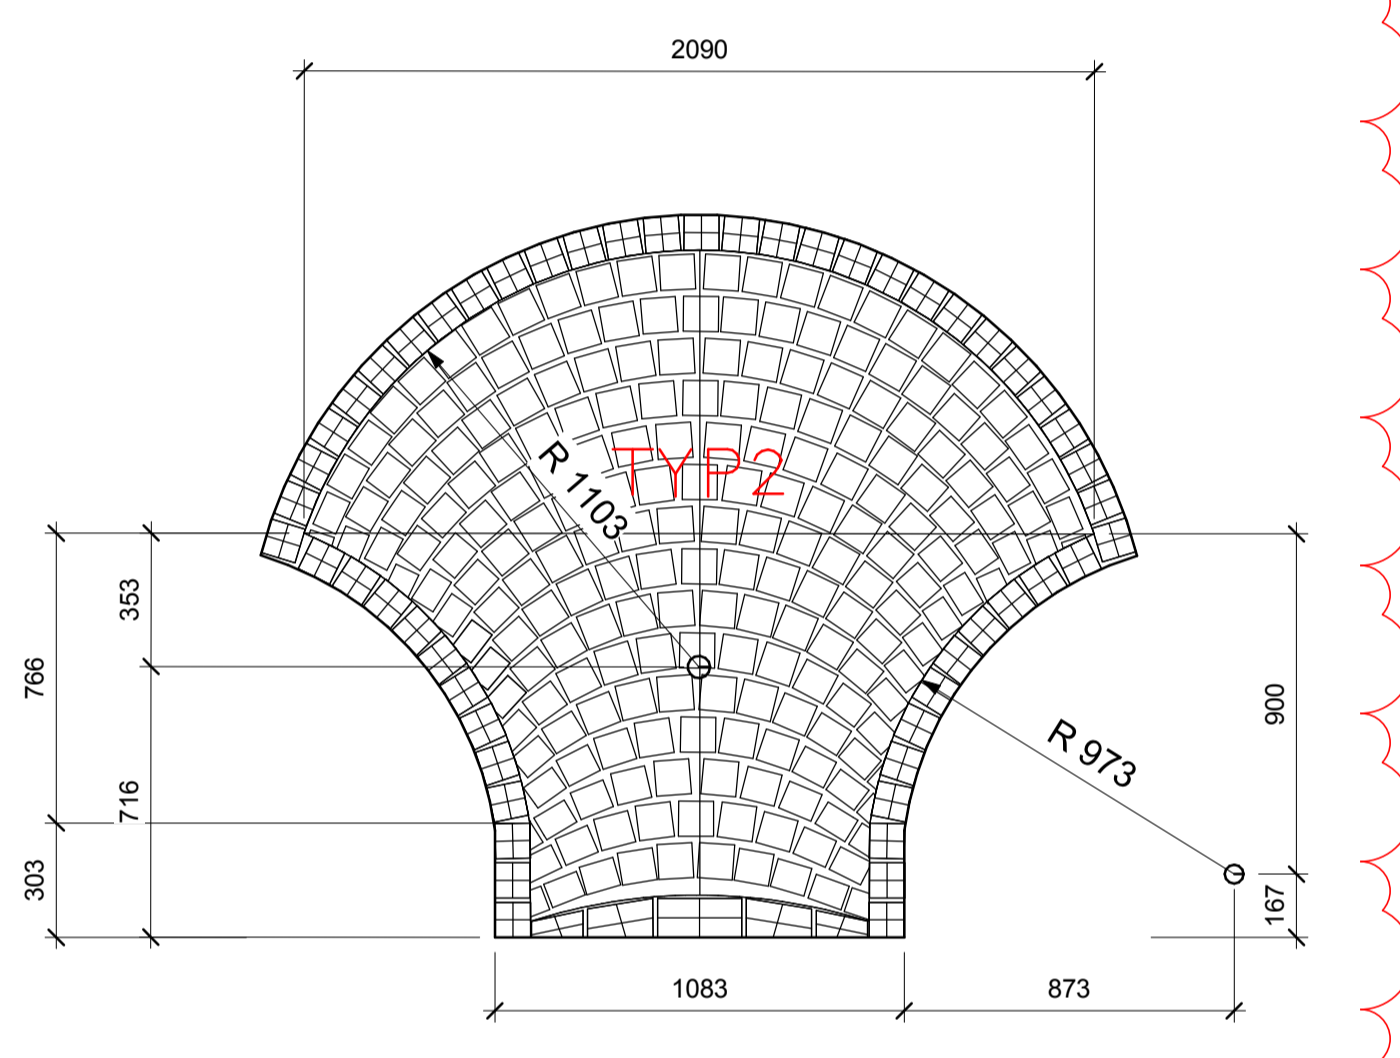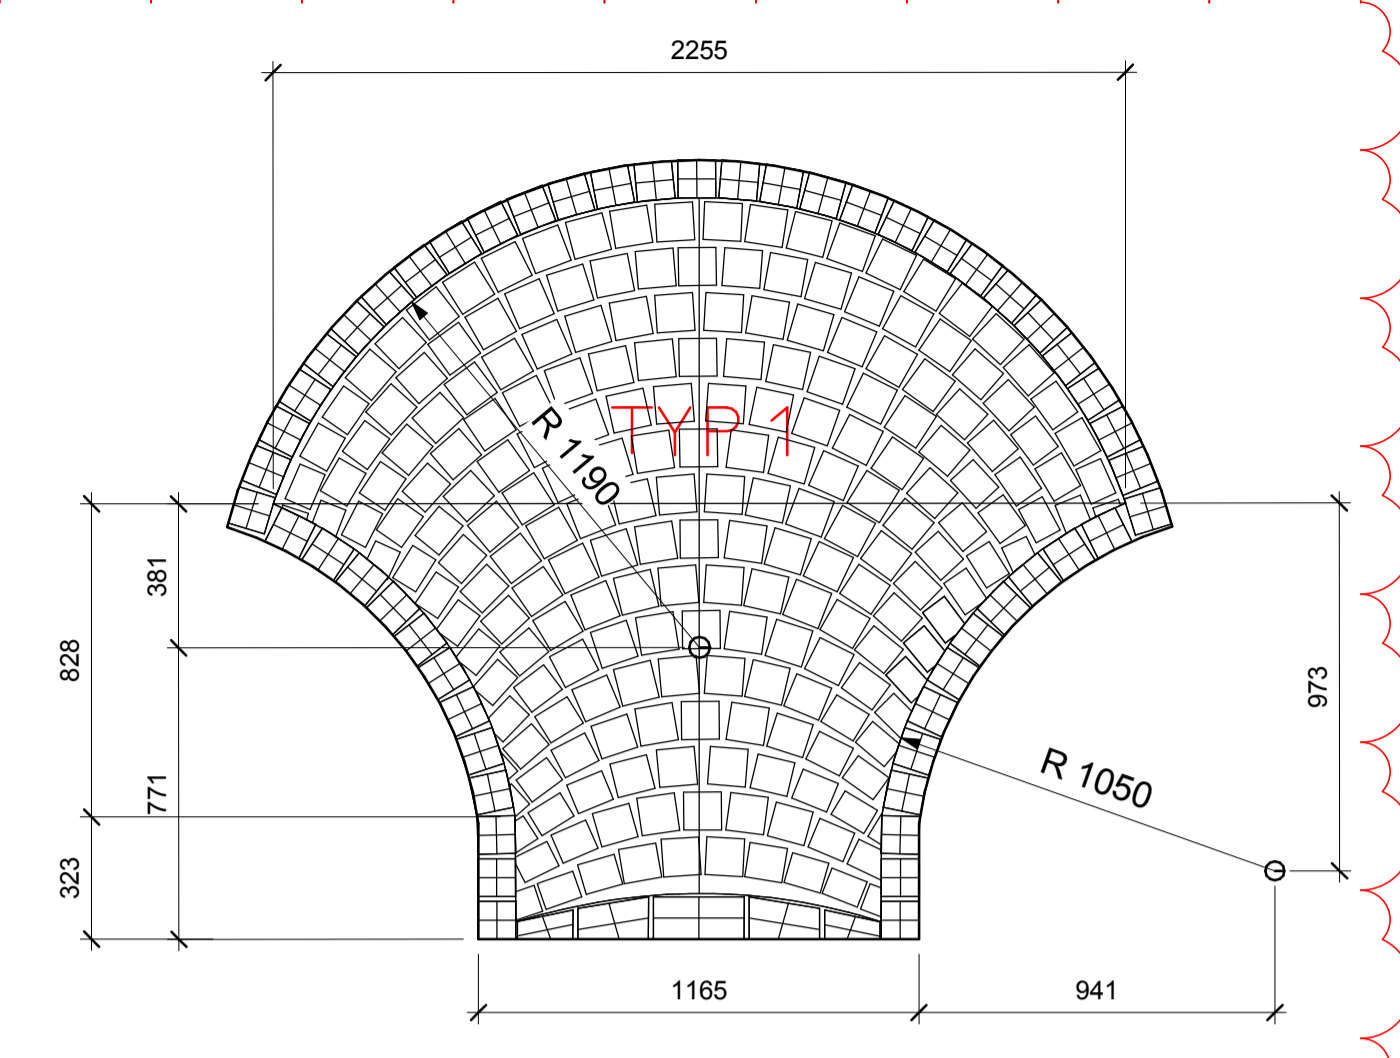

90 - External Paving Layout - Fan paving setting out



bam
BAM Design Ltd
An operating company of
BAM Construct UK Ltd
Architecture
Interior Design
3D Visualisation
Feasibility Studies
Structural Engineering
Environmental Services
Building Information Modelling

Centium Business Park
Coffin's Way, St Albans
Herts SG8 4JH, AL1 2RD
01727 894200
design@bam.co.uk
www.bam.co.uk

project **COAL DROPS YARD**

title **External Paving - Typical Details - Sheet 03**

purpose of issue **CONSTRUCTION**

scale **As indicated @ A1** draw **SS** BAM job no. **4389** dfg status **S4**




date **20.11.2015** checked **MWB** rev **004**

site **KXC-M0- 001-BD4389-A- (90)-5003** dfg / doc ref

DO NOT SCALE FROM THIS DRAWING.
 ALL DIMENSIONS TO BE CHECKED ON SITE.
 FOR REFERENCED VIEWS REFER TO SERIES OF DRAWINGS KXC-M0-001-A-(90)

ROUGH RECLAIMED GRANITE SETTS - SOURCE FROM SITE.
 CONTRACTOR TO CONFIRM MIX AVAILABILITY.
 BAND 1 120-250mm x 80-100mm WIDE x APPROX. 100mm DEEP.
 BAND 2 120-250mm x 101-115mm WIDE x APPROX. 100mm DEEP.
 BAND 3 120-250mm x 116-125mm WIDE x APPROX. 100mm DEEP.

STAINLESS STEEL SQUARE TREE SURROUND
 10MM THICK 800X800MM ON PLAN
 DRAINAGE MATT COLLAR AROUND
 BASE OF TREE TRUNK
 DECORATIVE GRAVEL MULCH
 100MM SQUARE METAL CAP TO
 AERATION PIPE
 T11-YORK STONE PAVERS TO MATCH
 KINGS CROSS STANDARDS . 50MM DEEP.
 600MM WIDE x RANDOM LENGTH x 50mm
 DEPTH

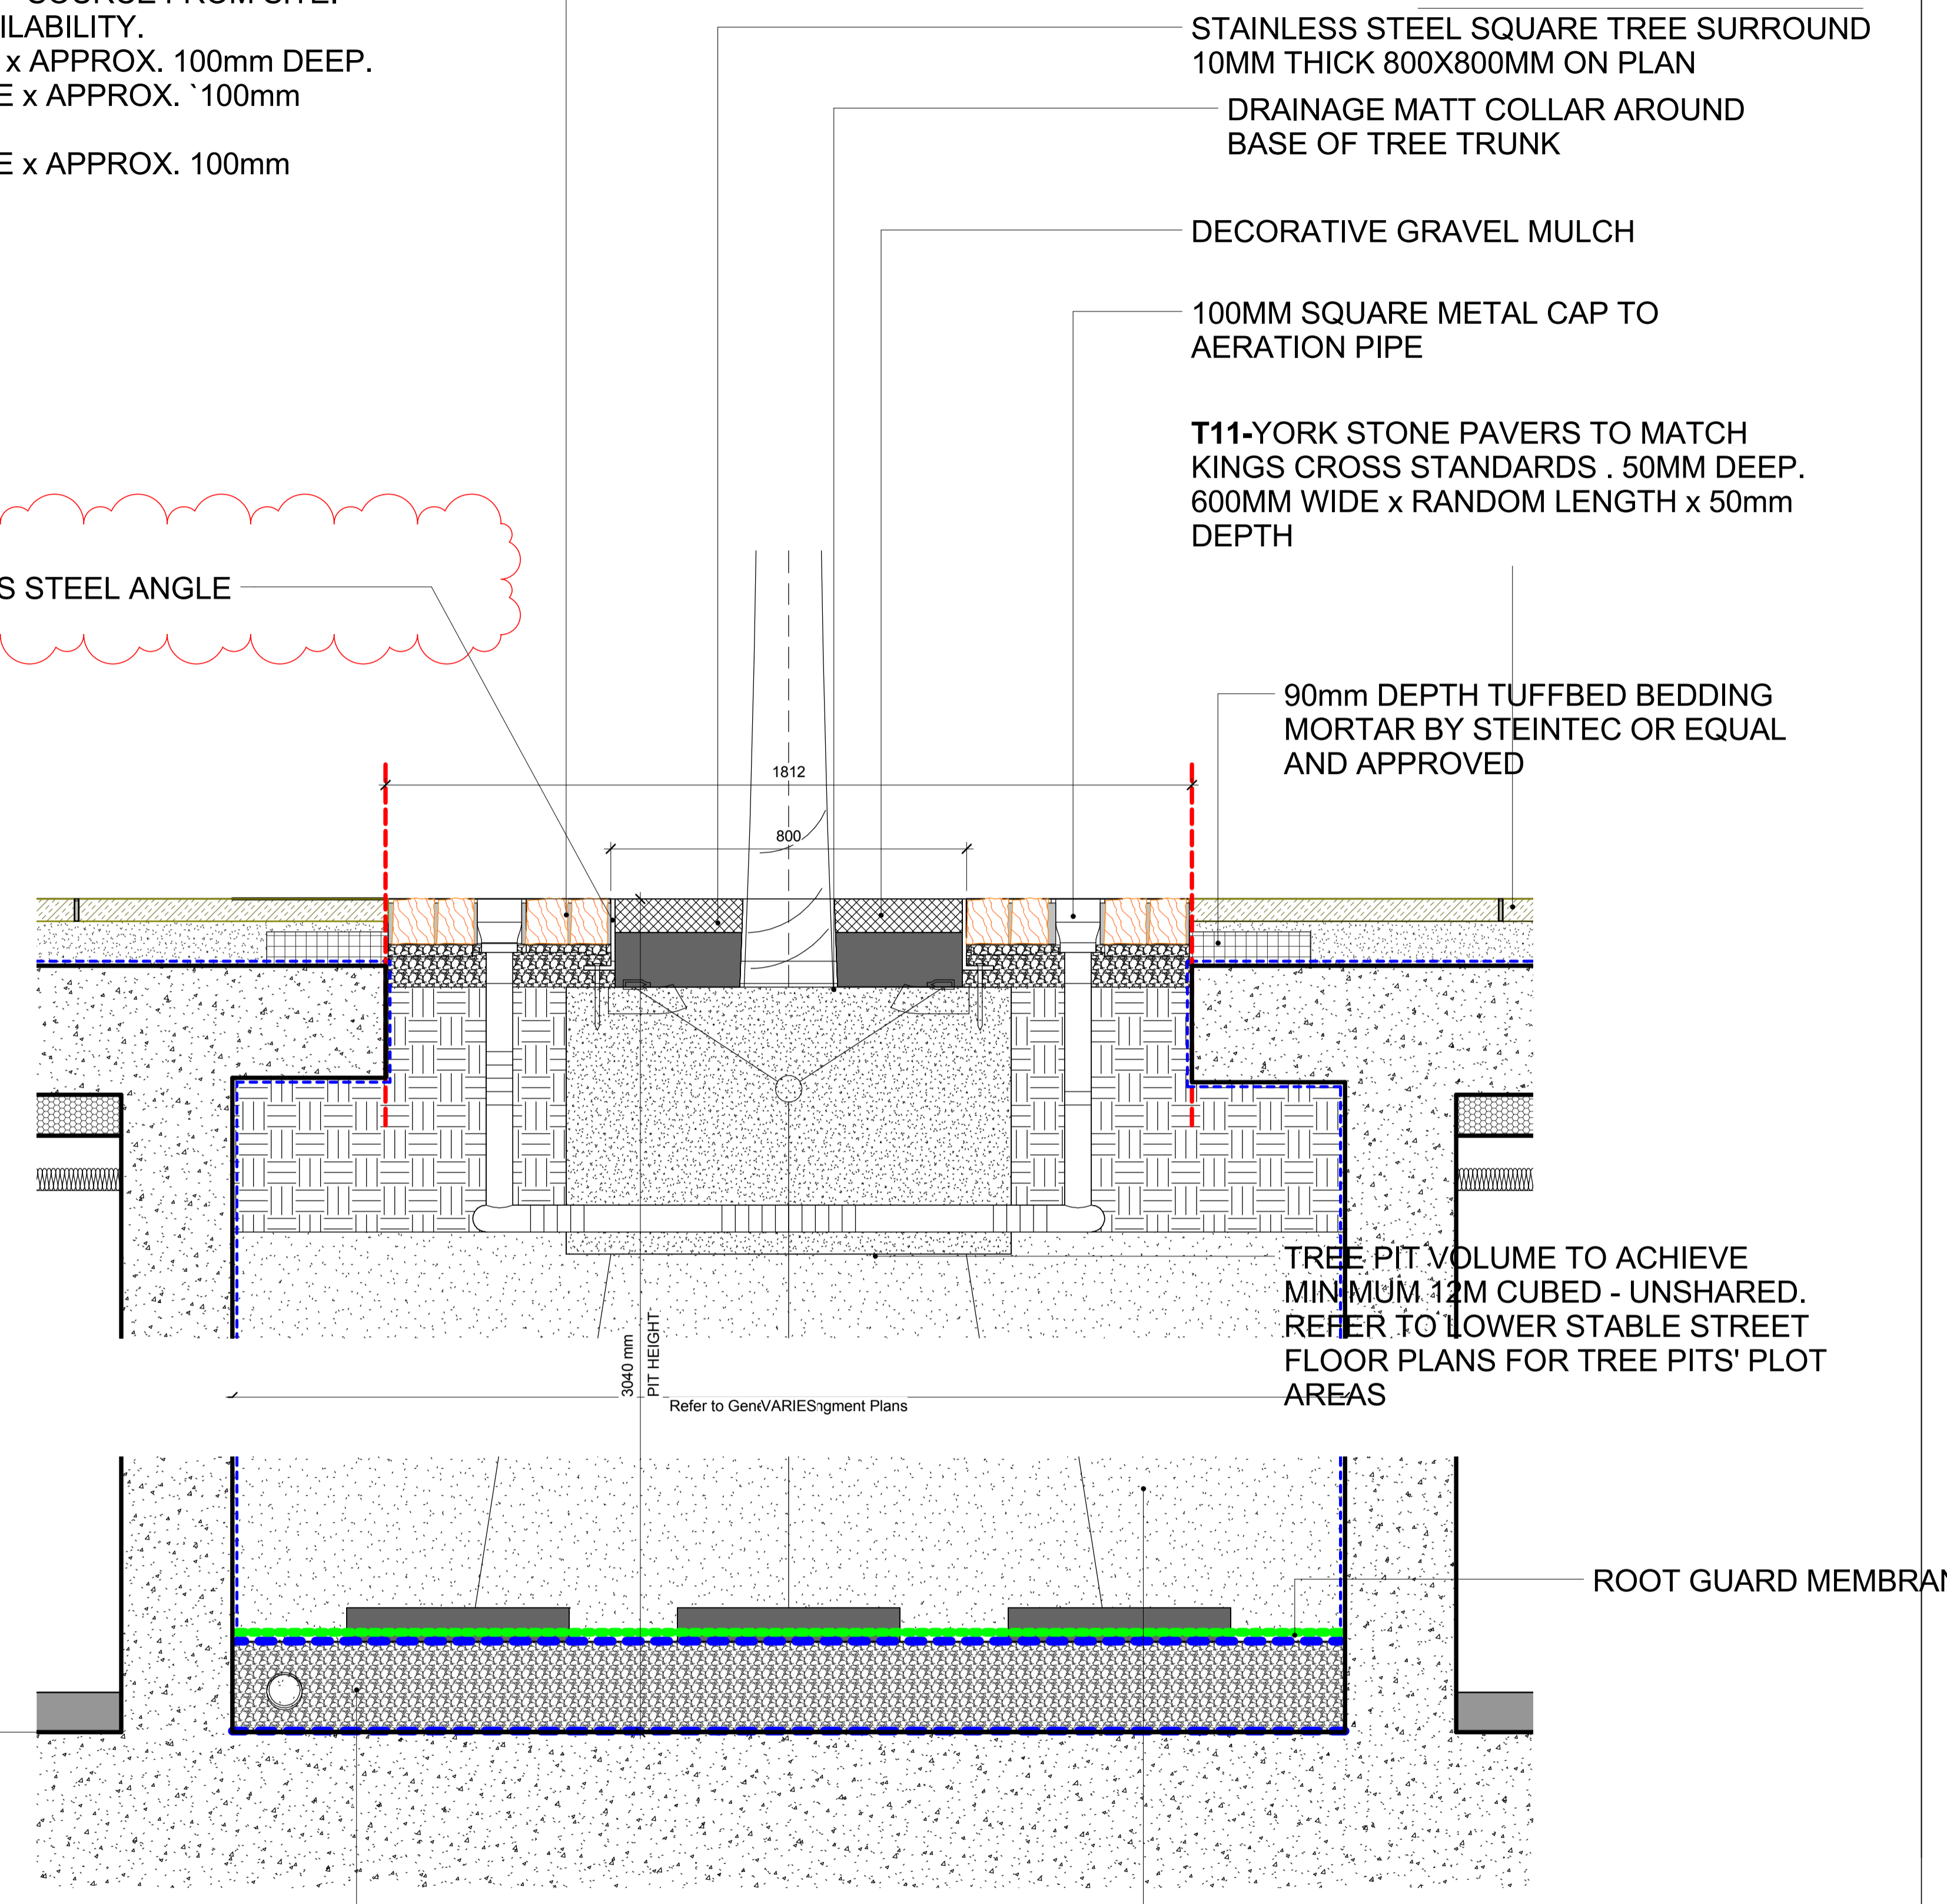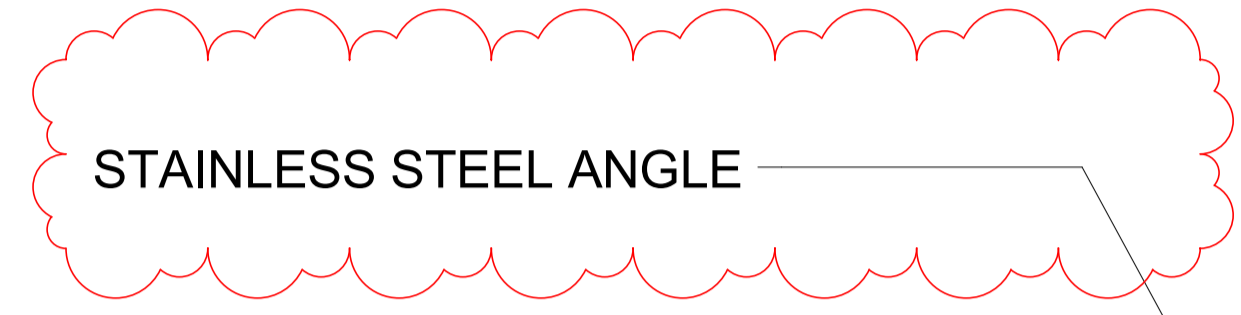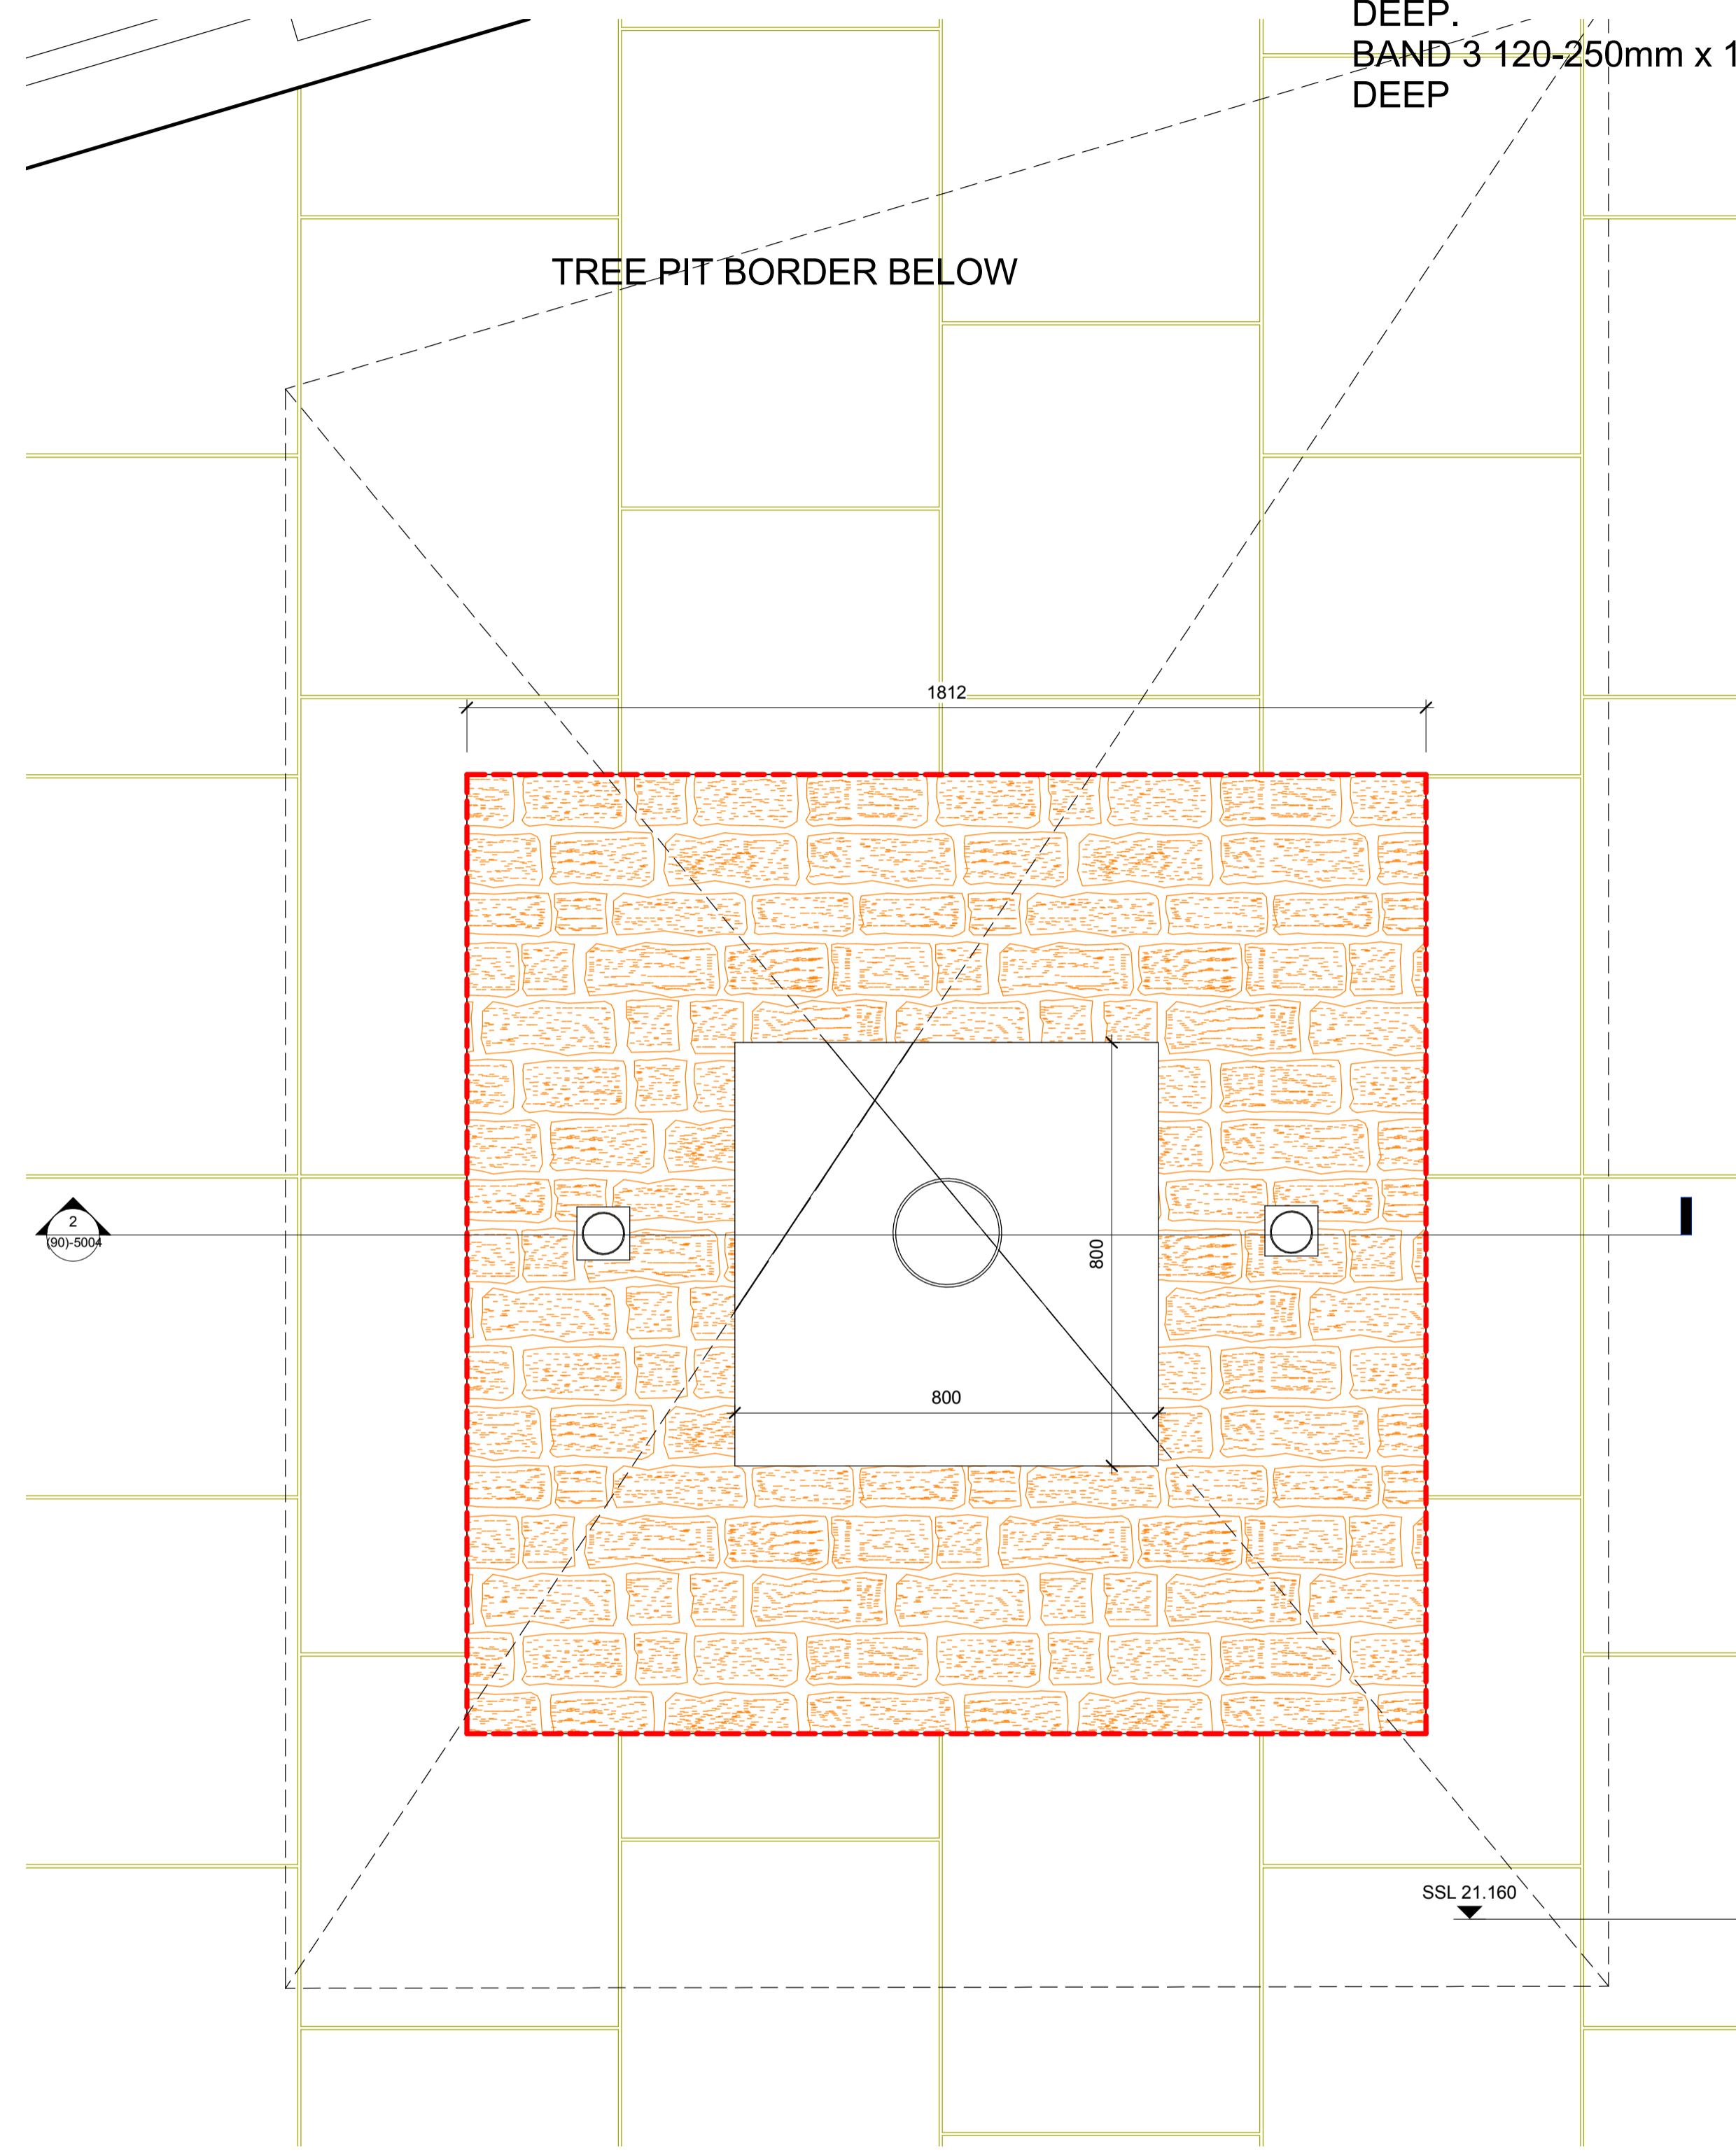

TREE PIT VOLUME TO ACHIEVE
 MINIMUM 12M CUBED - UNSHARED.
 REFER TO LOWER STABLE STREET
 FLOOR PLANS FOR TREE PITS' PLOT
 AREAS

ROOT GUARD MEMBRANE

TOPSOIL BACKFILL TO BE SPECIFIED BY
 LANDSCAPE SUBCONTRACTOR

1 LAYER I.C.I. TERRAM 1000
 GEOTEXTILE ON 100mm PEA
 SHINGLE ON GEOTEXTILE ON
 LOOSEND FORMATION

1 M1 Mezzanine Level- External Paving -Tree Pit
 1 : 10

2 M1 Mezzanine Level- External Paving -Tree Pit
 1 : 10

Status Code (as defined in BS1192)
 S0 - Initial Status or WIP
 S1 - Issued for co-ordination
 S2 - Issued for information
 S3 - Issued for internal review
 S4 - Issued for construction approval

Work In Progress (WIP)
 D3 - Issued for contractor design
 D4 - Issued for manufacture/procurement

Shared
 A - Issued for construction
 B - Issued for construction but with comments
 C - Comprehensive revision required

Documentation (Contractual)
 AB - Record Drawing

Documentation (Pre-construction)
 D1 - Issued for costing
 D2 - Issued for tender

no	by	chkd	date	description
005	TM	MWB	26.05.17	Updated as per BAMC comments
004	DGW	MWB	16-02-17	Drawing sheet amended and view for clarity.
003	SS	MWB	15.07.16	Drawing Updated to Construction
002	SS	MWB	27.01.16	Updated to meet BAMC Comments
001	SS	MWB	21.12.15	General Paving Layout Updated to meet HS and BAMC Comments



bam
 BAM Design Ltd
 An operating company of
 BAM Construct UK Ltd
 Architecture
 Interior Design
 3D Visualisation
 Feasibility Studies
 Structural Engineering
 Environmental Services
 Building Information Modelling

Centrium Business Park
 Giffords Way, St Albans
 Hertfordshire, AL1 2FD
 01727 894200
 design@bam.co.uk
 www.bam.co.uk

project COAL DROPS YARD

title External Paving - Typical Details
 - Sheet 04

scale 1 : 10 @ A1

date 20.11.2015

site identification project

design@bam.co.uk

drawn SS

checked MWB

consulted

Role CISFB

Content



BAM job no. 4389

rev. S4

purpose of issue



CONSTRUCTION

005

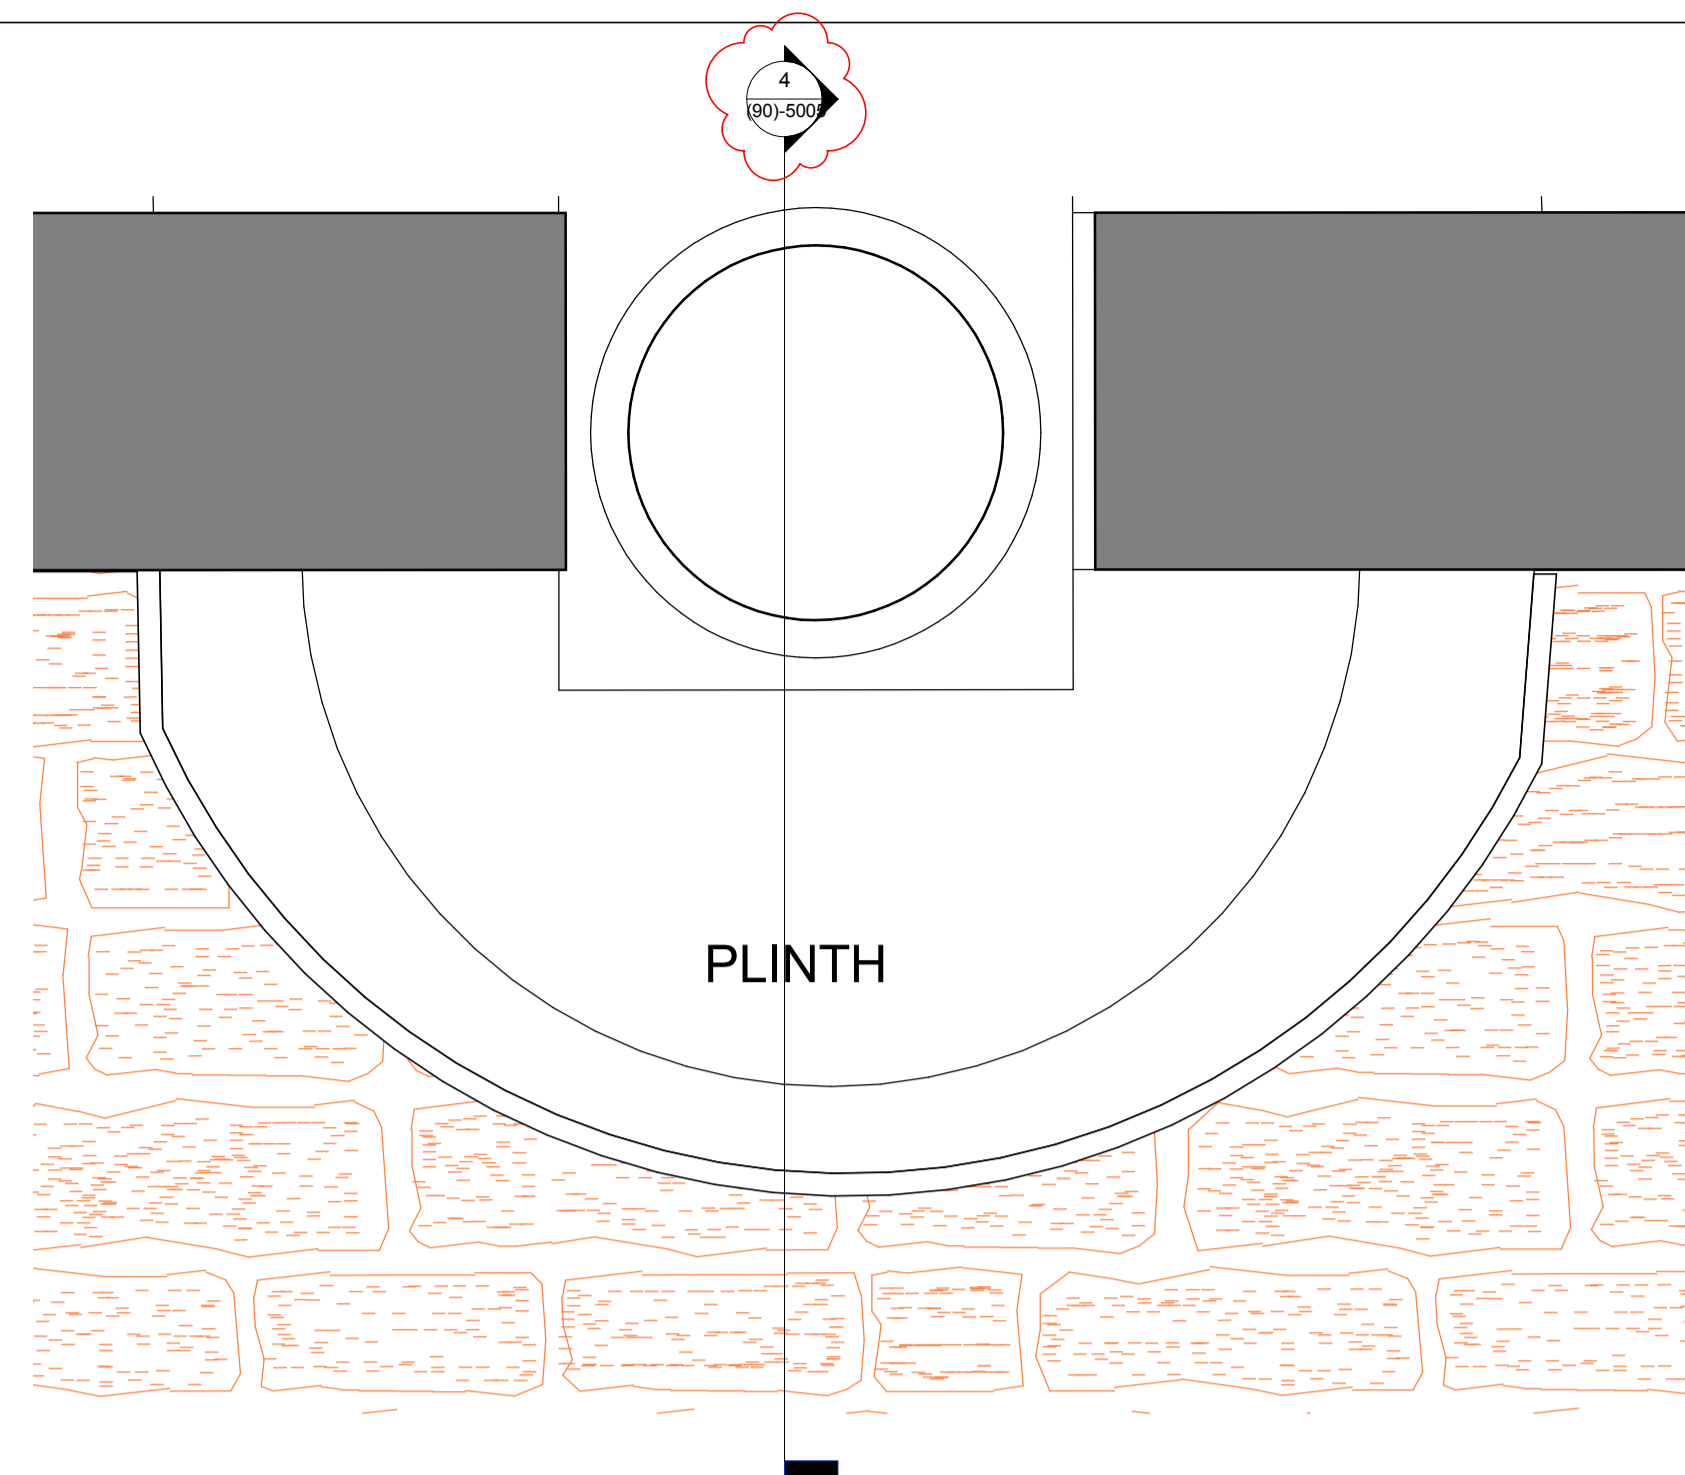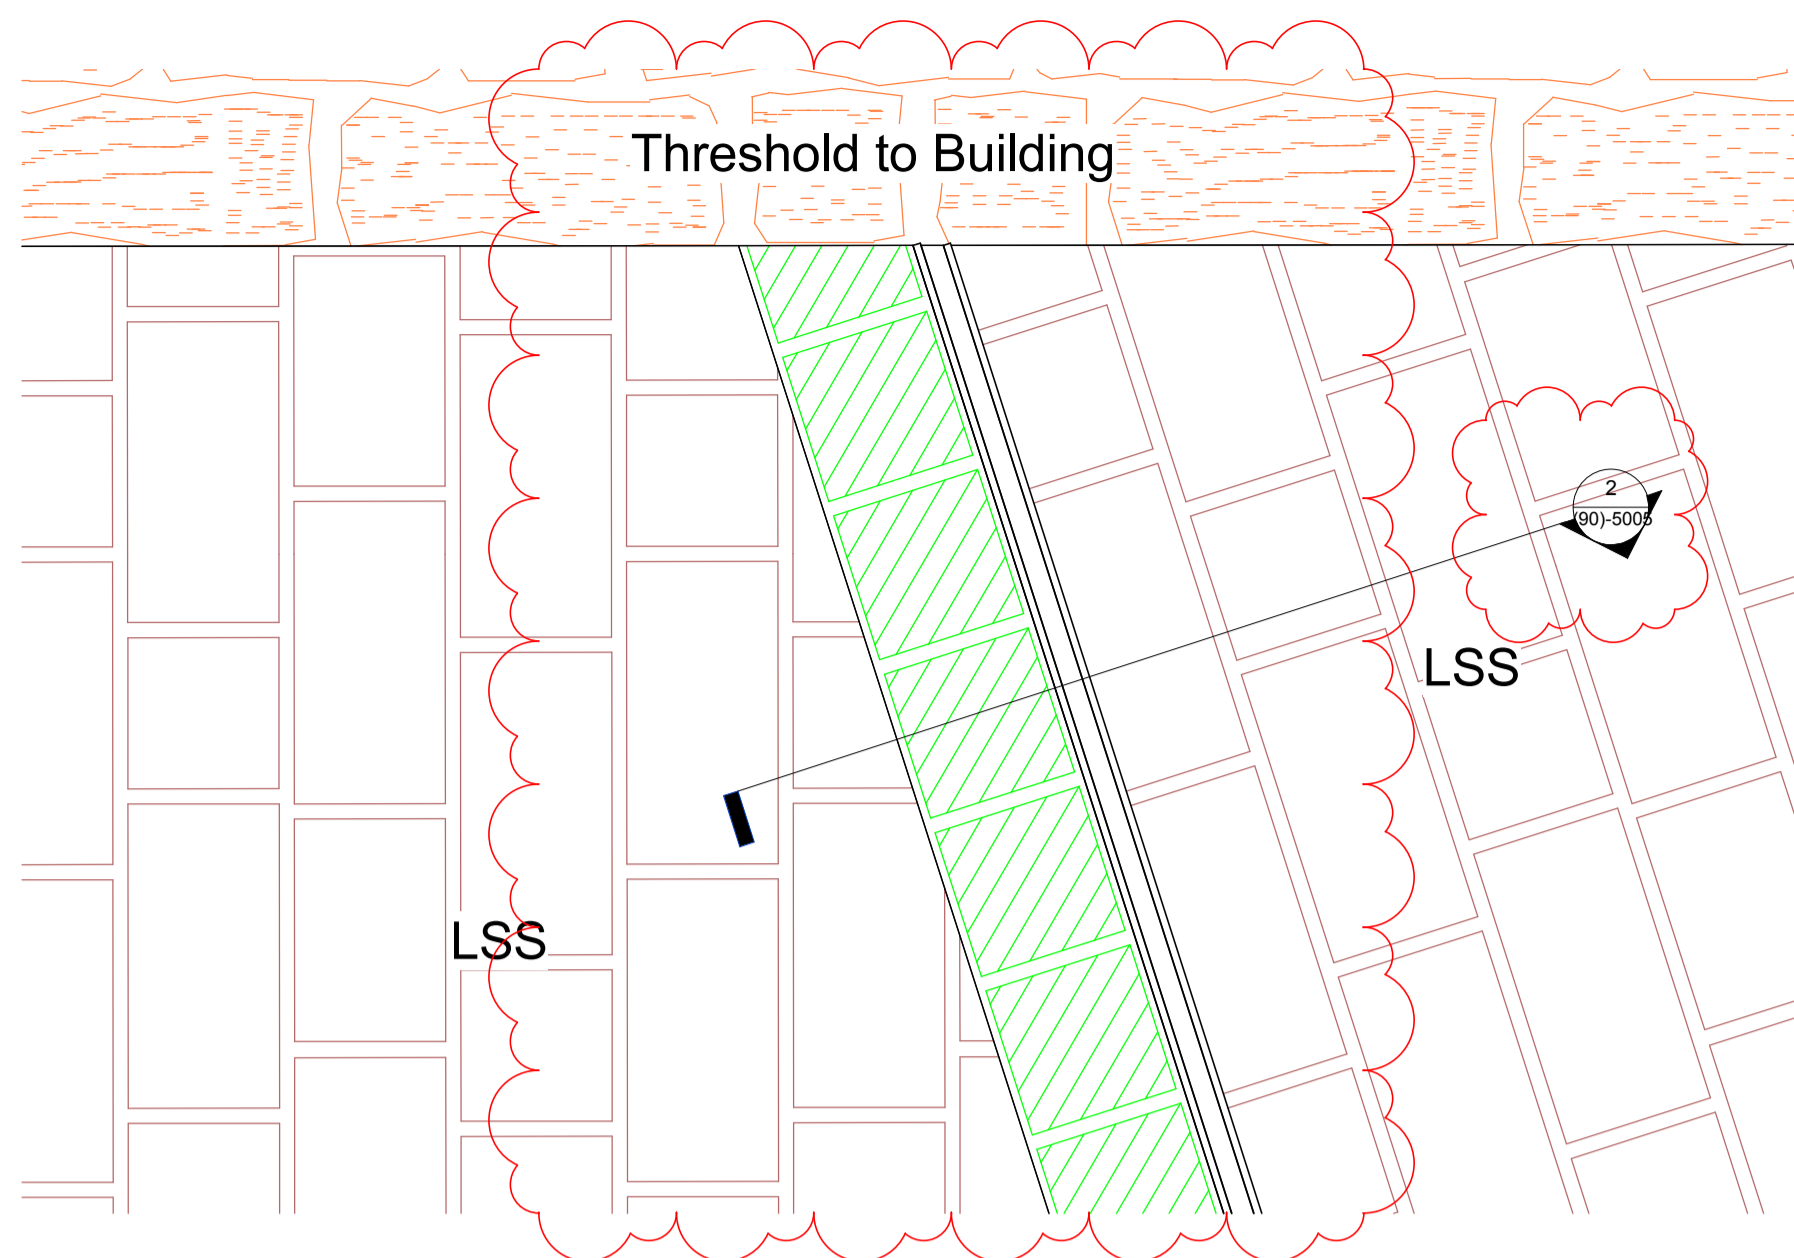

1 Yard Level- Plan Detail slot drain - T1-T9
 1:5

3 Yard Level- Plan Detail ECD Plinth - T5
 1:5

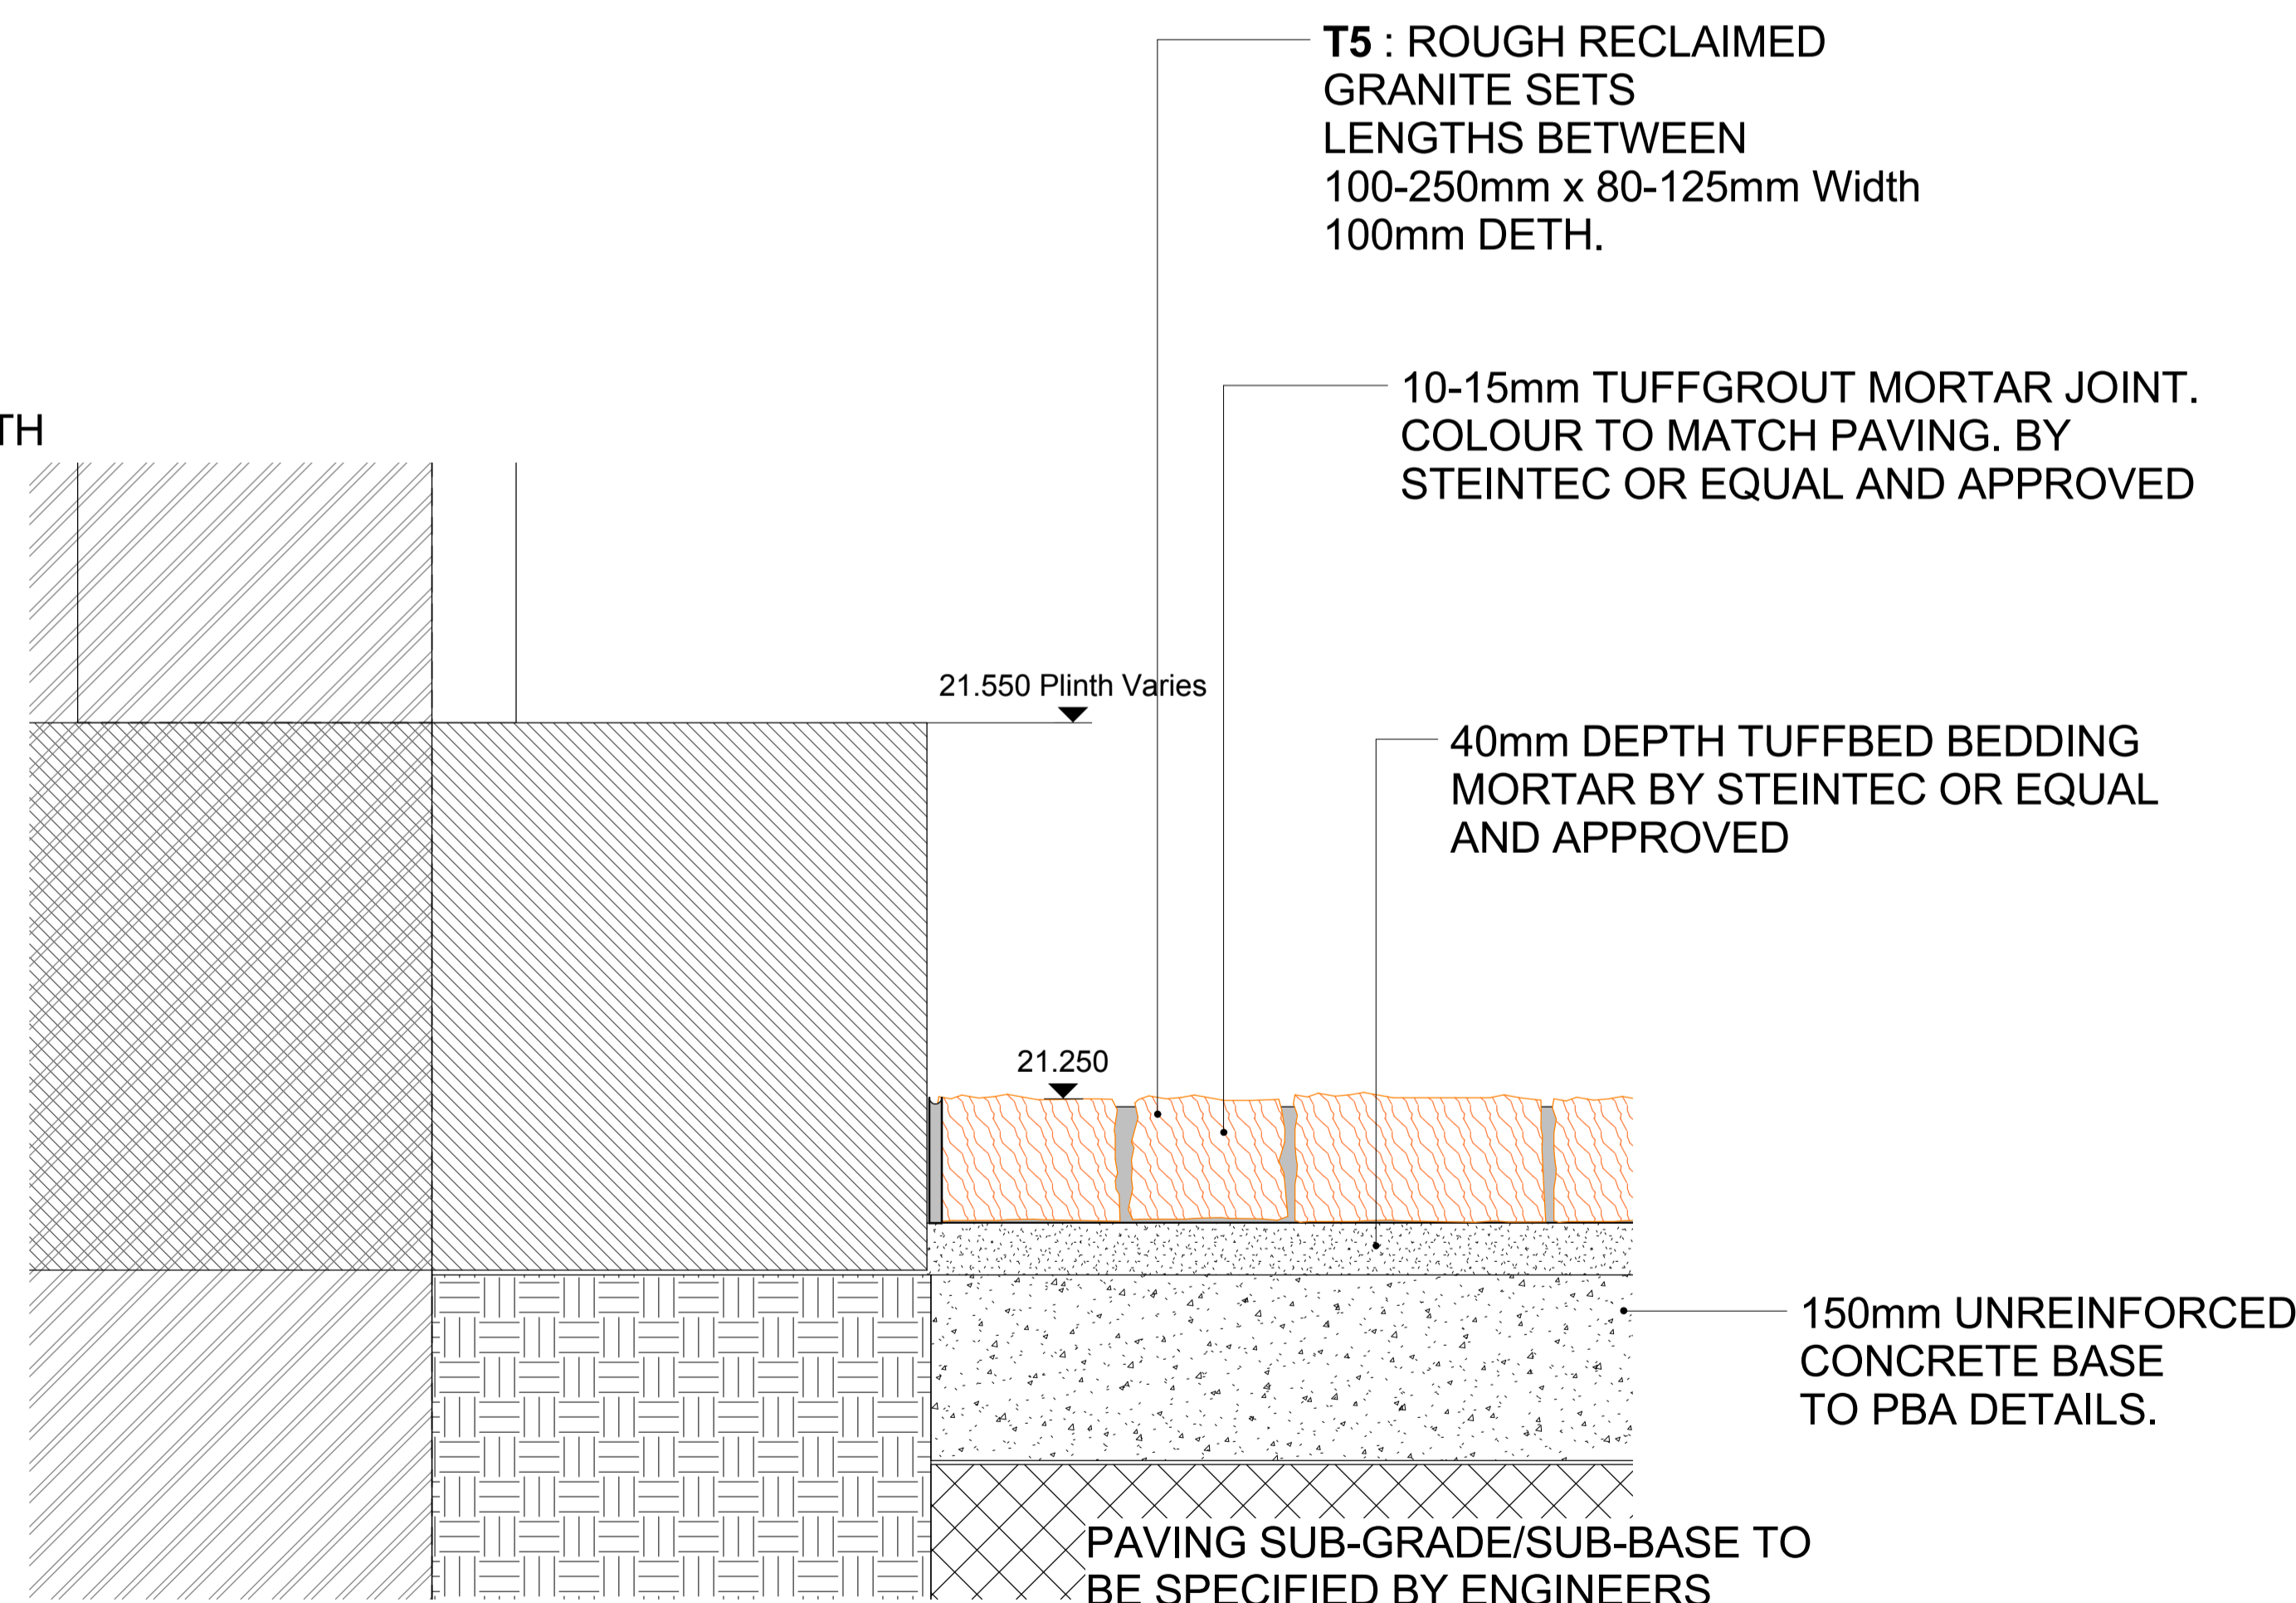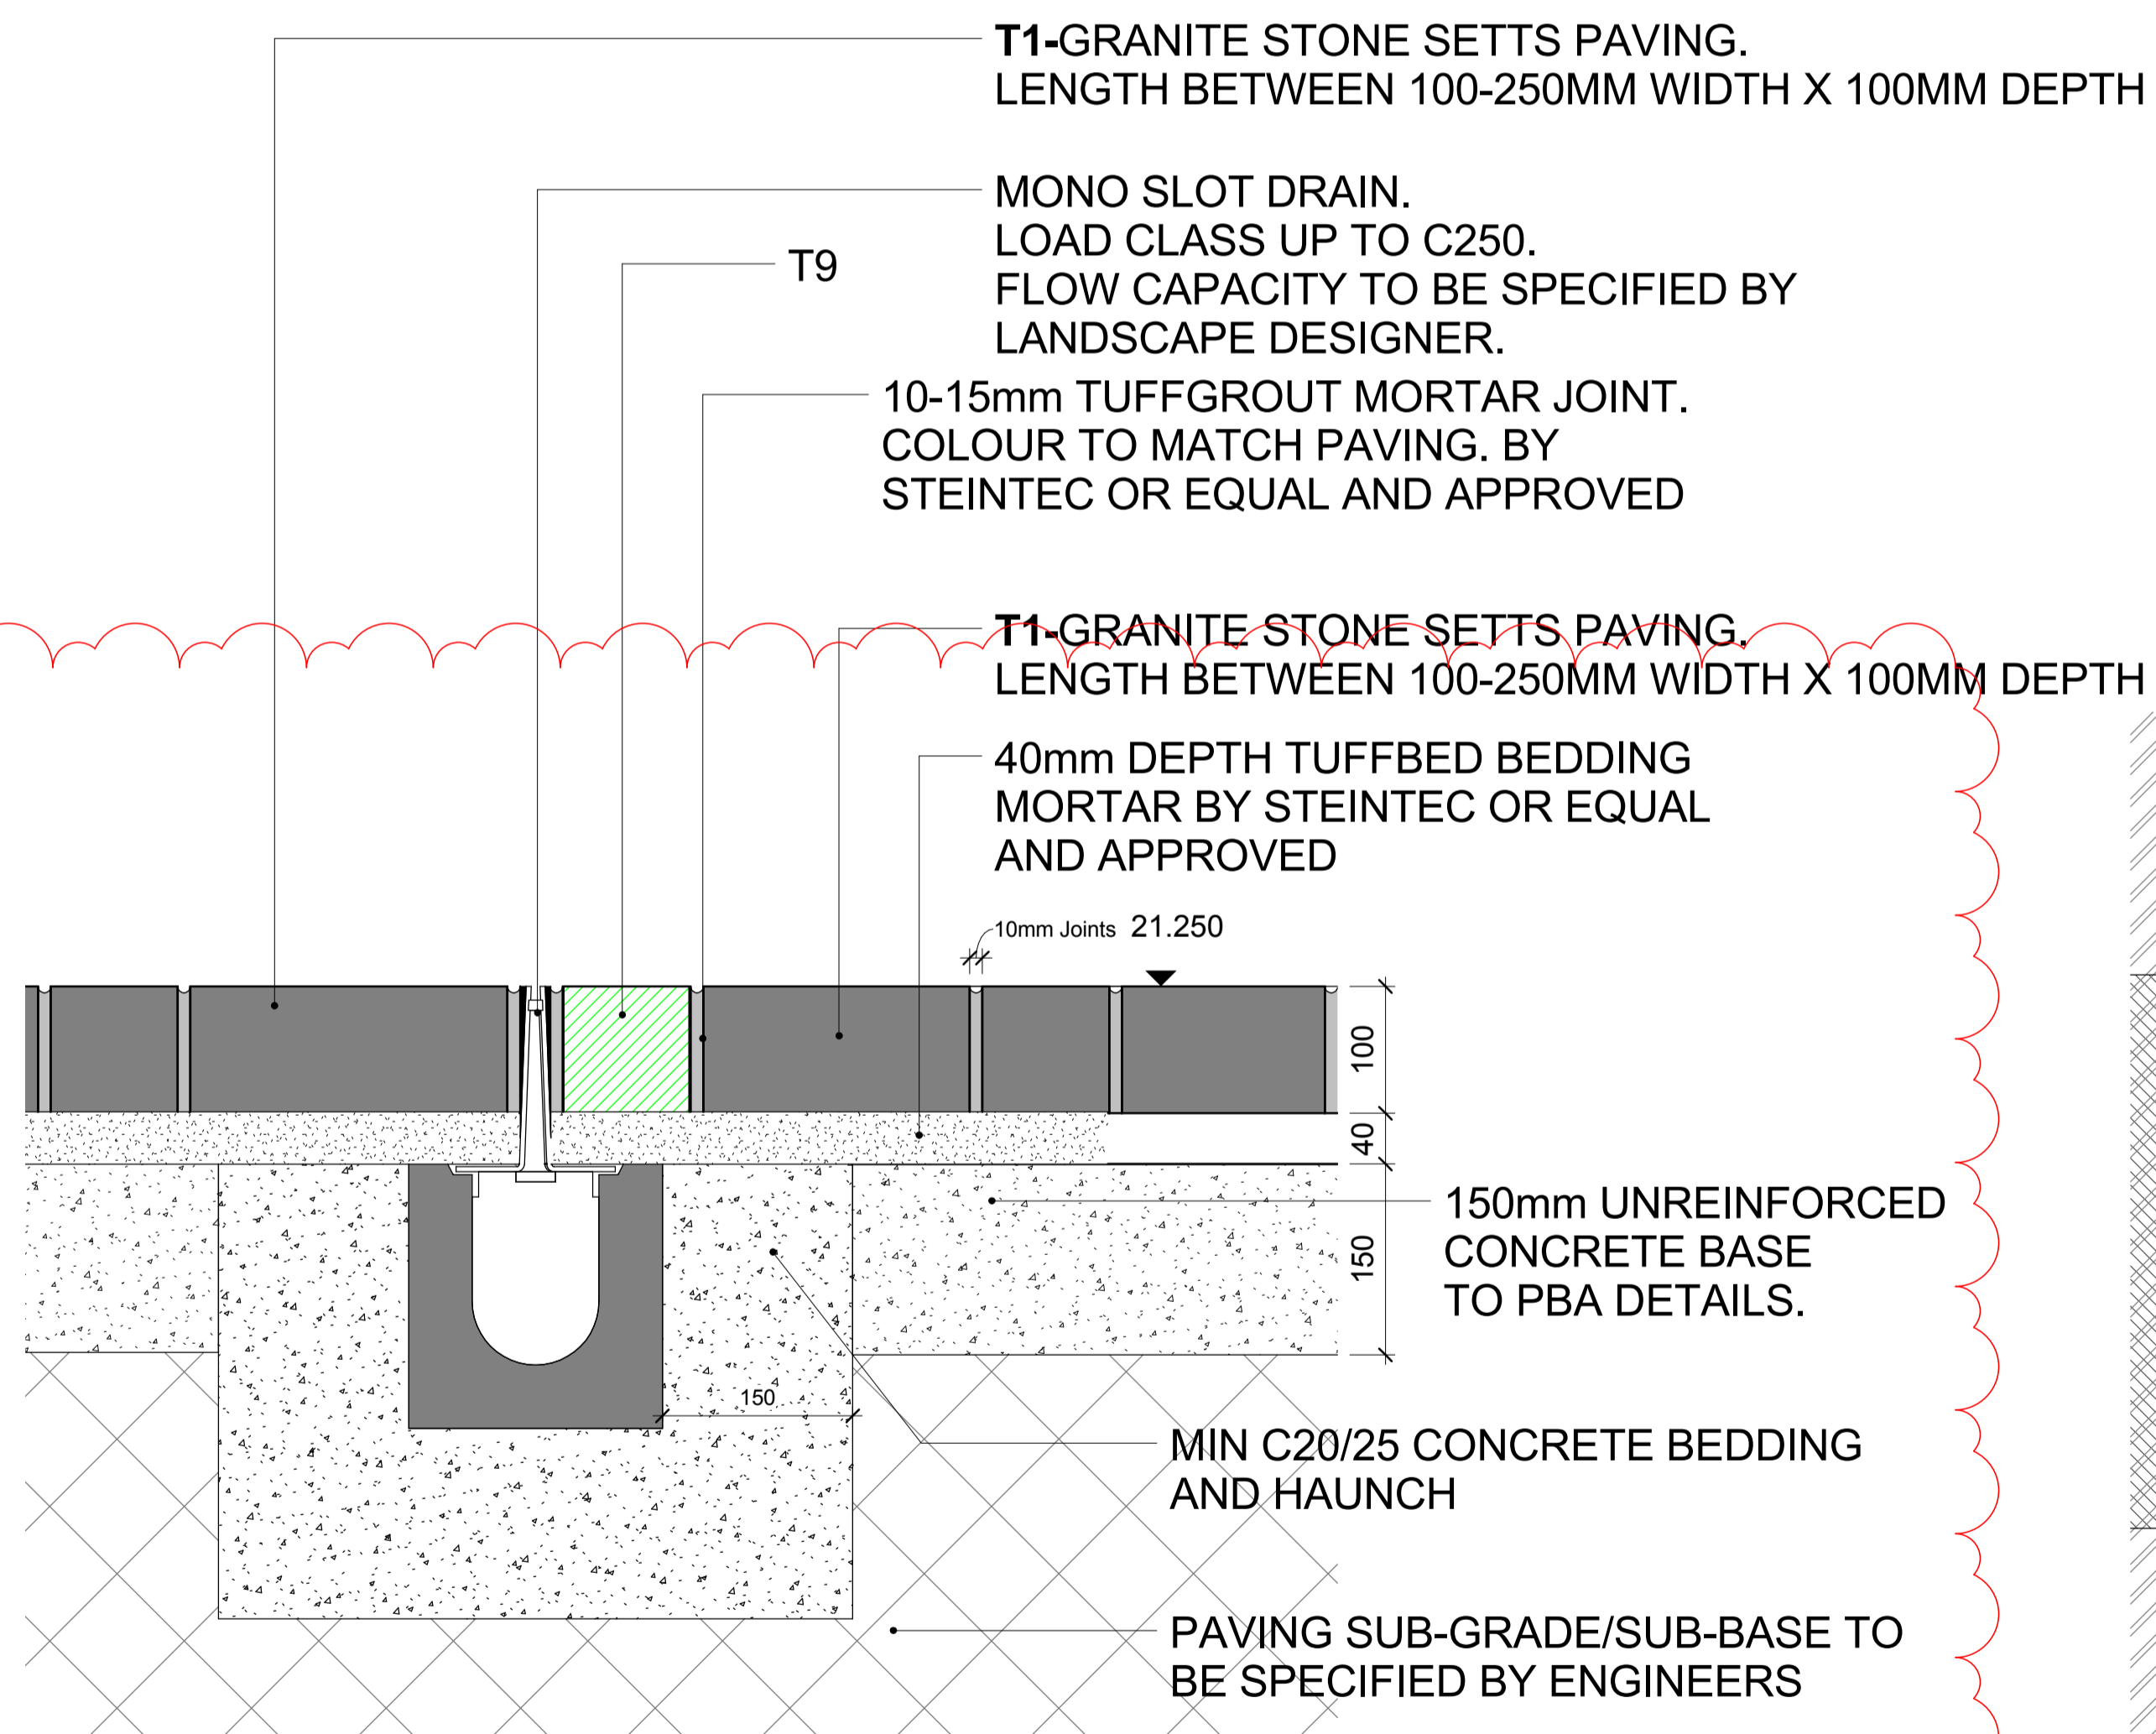

2 Yard Level- Section Detail LSS Slot Drain-T1-T9
 1:5

4 Yard Level- Section Detail ECD Plinth - T5
 1:5

Status Code (as defined in BS1192)	Documentation (Contractual)
D3 - Issued for contractor design	A - Issued for construction
D4 - Issued for manufacture/procurement	B - Issued for construction but with comments
Work In Progress (WIP)	C - Comprehensive revision required
S0 - Initial Status or WIP	Archive
Shared	AB - Record Drawing
S1 - Issued for co-ordination	
S2 - Issued for information	
S3 - Issued for internal review	
S4 - Issued for construction approval	
Documentation (Pre-construction)	
D1 - Issued for costing	
D2 - Issued for tender	

rev	by	chkd	date	description
002	TM	MB	26.05.17	Updated as per BAMC comments



bam
 BAM Design Ltd
 An operating company of
 BAM Construct UK Ltd
 Architecture
 Interior Design
 3D Visualisation
 Feasibility Studies
 Structural Engineering
 Environmental Services
 Building Information Modelling

Centrium Business Park
 Giffords Way, St Albans
 Hemel Hempstead, AL1 2RD
 01727 894200
 design@bam.co.uk
 www.bam.co.uk

project COAL DROPS YARD

title External Paving -Typical details
 -Sheet 05

purpose of issue CONSTRUCTION

scale 1:5 @ A1

drawn DGW

date 02/17/17

checked MWB

site plotification project

consultant

role CISFB

content

rev

002

BAM job no. 4389