


# RAISED GROUND FLOOR PLAN

- KEY TO ACCOMMODATION:**
- 1. - HALL
  - 2. - BALCONY
  - 3. - BEDROOM
  - 4. - LIVING AREA
  - 5. - COURTYARD
  - 6. - BEDROOM
  - 7. - STORAGE
  - 8. - BATH/SHOWER ROOM
  - 9. - KITCHEN
  - 10. - VOID
  - 11. - BICYCLE STORE

- KEY TO LANDSCAPING:**
- GRASS
  - GREY CERAMIC TILE
  - POT-PLANT

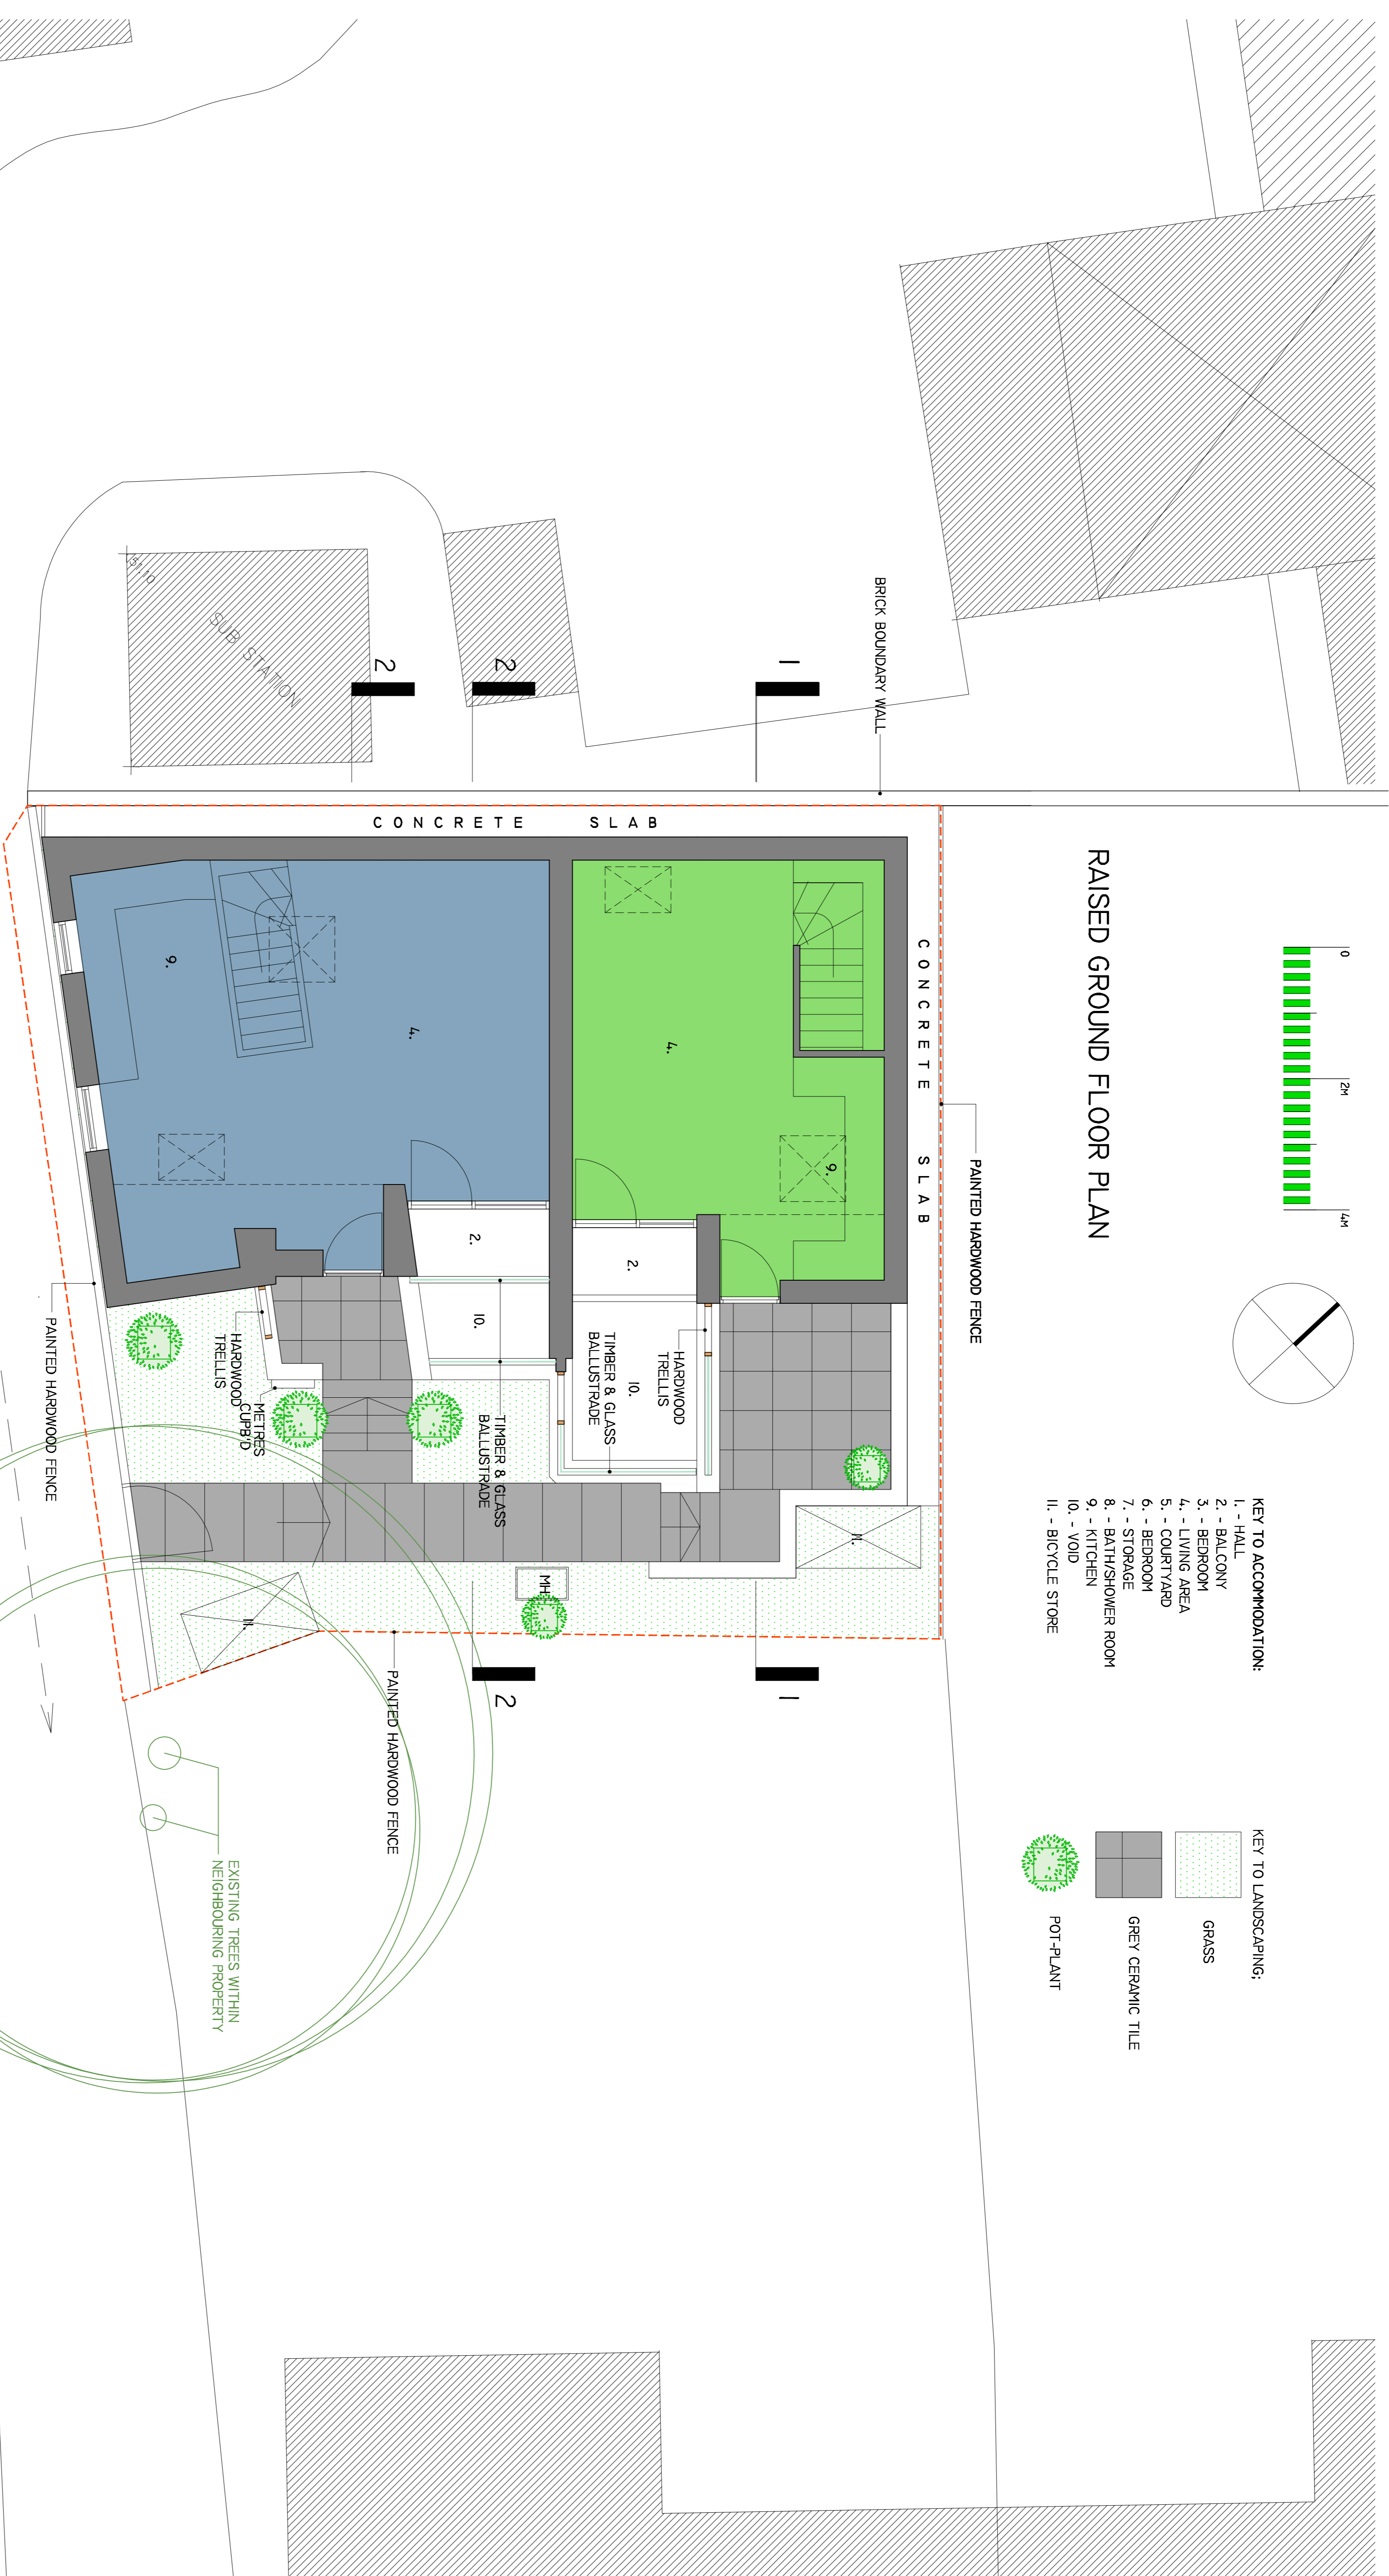

REV	ISSUE STATUS	PROJECT	DATE
A	Second bicycle store added	PROPOSED NEW HOUSES, REAR OF 1 FROGNAL, LONDON.	SEP 12
B	Amendments and dimensions added and revised around entrance to site		
C	AS BUILT details added	AS BUILT RAISED GROUND FLOOR PLAN	
D	AS BUILT details added		
E	Bicycle store re-tracked		

**AS BUILT**

1/50