




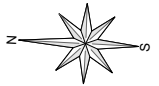
THIS DRAWING IS FOR AESTHETIC DESIGN INFORMATION PURPOSES ONLY & DOES NOT CONTAIN ANY INFORMATION FOR CONSTRUCTION, PERMITS OR COMPLIANCE TO BUILDING REGULATIONS.

REFER TO DRAWINGS OF EXECUTIVE ARCHITECT OR DESIGN & BUILD CONTRACTOR FOR ALL INFORMATION.

DO NOT SCALE OFF THIS DRAWING EXCEPT FOR PLANNING PURPOSES. USE FIGURED DIMENSIONS ONLY OR CONSULT THE ARCHITECT. ALL DIMENSIONS TO BE CHECKED ON SITE BY CONTRACTOR & EXECUTIVE ARCHITECT. ARCHITECT TO BE INFORMED OF ANY VARIATIONS THAT MAY OCCUR BEFORE COMMENCEMENT OF WORK.

**KEY:**  
 S - INTERNAL WINDOW SILL HEIGHT  
 H - INTERNAL WINDOW SILL TO HEAD HEIGHT  
 FFL - TOP OF FINISHES  
 SSL - TOP OF STRUCTURAL SLAB LEVEL

-  EXISTING FABRIC
-  FABRIC FOR REMOVAL
-  PROPOSED FABRIC
- X +55.350 EXISTING LEVEL
- X +55.500 PROPOSED LEVEL
- ASSUMED / UNABLE TO SURVEY



PLANNING ISSUE

A 19/07/17 WIDER OPENING TO RECEPTION ROOM REMOVED. TO KEEP AS EXISTING.

REV.	DATE	DESCRIPTION


36-37 CHESTER TERRACE  
LONDON

INTERNAL ROOM ELEVATIONS  
GROUND FLOOR


DRNG No PL-40 A	SCALE 1:25/1:50 @ A1 1:50/1:100 @ A3	DATE APR-17
--------------------	--	----------------




105 JERMYN STREET  
LONDON SW1Y 6EE  
T 020 7451 0955 mail@stanhopegate.co.uk  
www.stanhopegatearchitecture.com

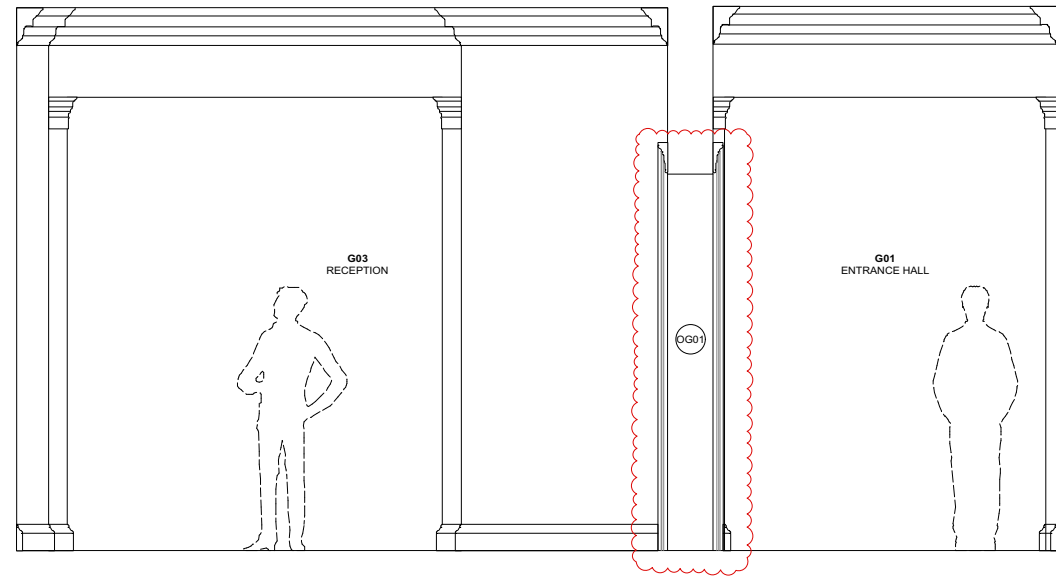

1 GROUND FLOOR  
SCALE 1:25 ELEVATION A  
PL-40

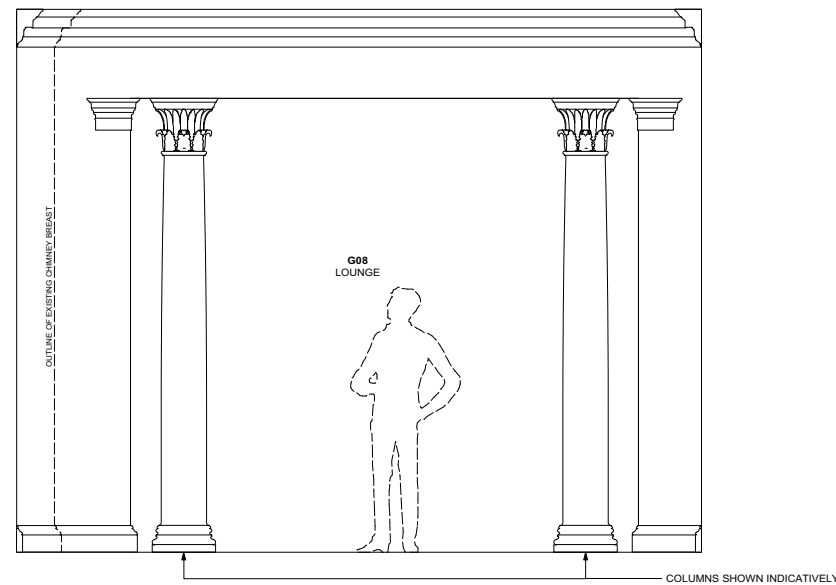

2 GROUND FLOOR  
SCALE 1:25 ELEVATION B  
PL-40

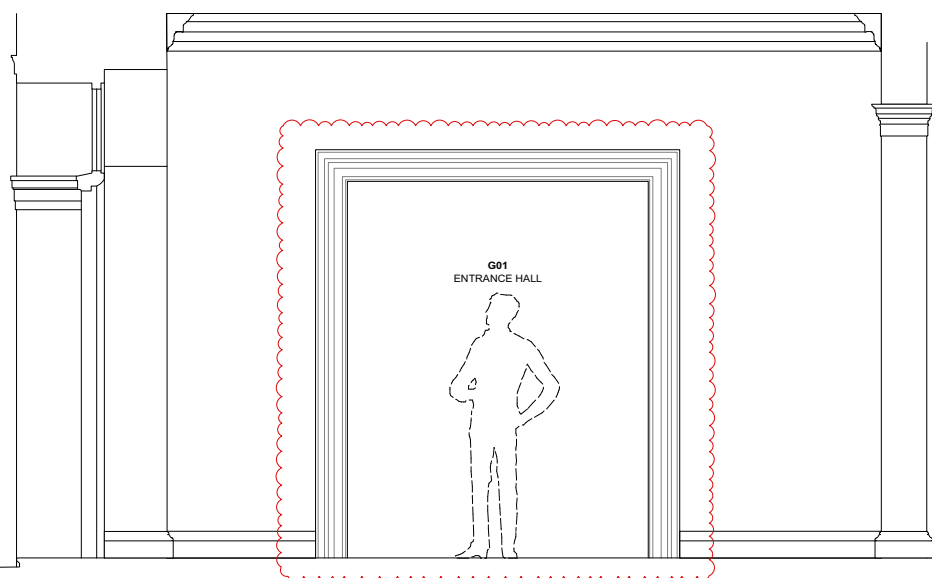


3 GROUND FLOOR  
SCALE 1:25 ELEVATION C  
PL-40



PHOTOGRAPH OF THE MORNING ROOM (FRONT GROUND FLOOR) No 14 CHESTER TERRACE, 1915, ILLUSTRATING THE USE OF COLUMNS TO SEPARATE THE FRONT ROOM. HISTORIC ENGLAND ARCHIVE.

**NOTE:** PROPOSED COLUMNS SHOWN INDICATIVELY, EXAMPLE OF STYLE USED BY ROBERT ADAM DURING THE TIME PERIOD CHESTER TERRACE WAS BUILT.

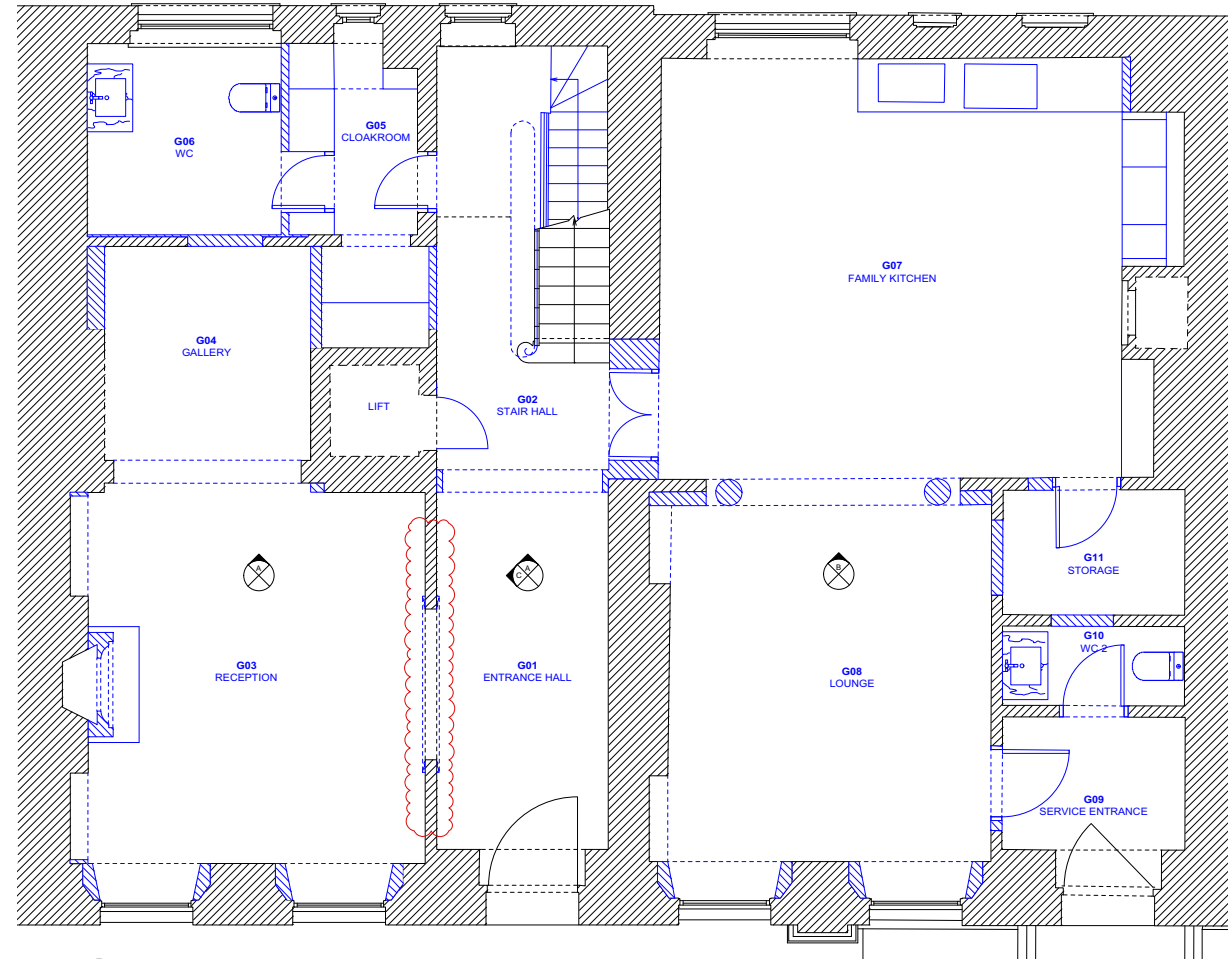

4 PROPOSED GROUND FLOOR  
SCALE 1:50 PLAN  
PL-40