




notes

- The contractor is responsible for checking dimensions, tolerances and references. Any discrepancy to be verified with the Architect before proceeding with the works.
- Where an item is covered by drawings to different scales the larger scale drawing is to be worked to.
- Do not scale drawing. Figured dimensions to be worked to in all cases.

CDM Regulations 2007

ALL current drawings and specifications for the project must be read in conjunction with the Designer's Hazard and Environmental Assessment Record.

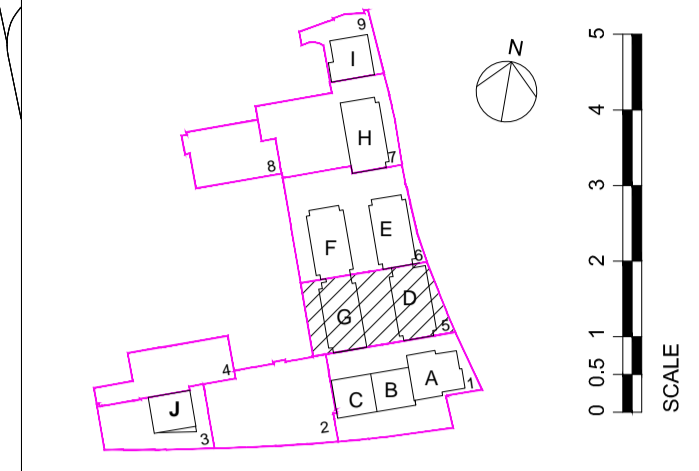

- Turf**
Medallion® turf by Rolawn or similar approved
- Wildflower turf**
Wildflower Landscape Turf by Wildflowerturf or similar approved
- Wildflower turf of shady area**
Premium (Hillier) Wildflower turf by Wildflowerturf or similar approved
- Proposed trees**
- Existing tree retained**
- Existing tree root protection zone**
- Climber**

date	rev	revision/author/checker
19.07.17	E	Street trees on York Way omitted MF/HS
30.06.17	D	Issued as record drawing HSAJ
17.03.15	C	issued for QA correction.HS
24.10.14	B	CONSTRUCTION Issue
02.05.14	A	General amendments to planting plan and schedule
03.04.14	-	First Issue for DT Co-ordination & Comment

purpose of issue
CONSTRUCTION

project
MAIDEN LANE

drawing
**EXTERNAL WORKS:
PLANTING PLAN 5
BLOCK D, F, G (South)**

drawing no	rev
AA1692C/3.1/234	E
drawn PW	checked AJ
scale @ A1 1/100	date APR 2014