


1 WCD - M1 - East Elevation - Zone 01
 1 : 100

Status Code (as defined in BS1192)
 S0 - Initial Status or WIP
 S1 - Issued for co-ordination
 S2 - Issued for information
 S3 - Issued for internal review
 S4 - Issued for construction approval
 D1 - Issued for costing
 D2 - Issued for tender

Documentation (Contractual)
 A - Issued for construction
 B - Issued for construction but with comments
 C - Comprehensive revision required
 AB - Record Drawing

Documentation (Pre-construction)
 D3 - Issued for contractor design
 D4 - Issued for manufacture/procurement

no	by	date	description
003	JSG IAW	31/05/17	Updates to reflect Status C comments received 01/12/16.
002	TM MWB	31/10/16	UPDATED AS CLOUDED

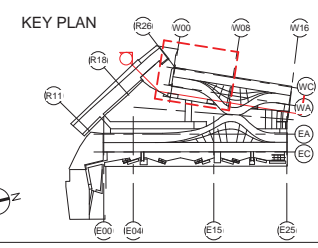

bam
 B&M Design Ltd
 An operating company of
 B&M Construct UK Ltd
 Architecture
 Interior Design
 3D Visualisation
 Feasibility Studies
 Structural Engineering
 Environmental Services
 Building Information Modelling

Centrium Business Park
 Griffiths Way, St Albans
 Hertfordshire, AL1 2RD
 01277 884200
 design@bam.co.uk
 www.bam.co.uk

project COAL DROPS YARD

title Proposed East Elevation - West
 Coal Drop Sheet 01

scale 1 : 100 @ A1
 date 06/30/16
 site plot/location project
 KXC-M1- 001-BD4389-A- 20-313


drawn TM
 checked DGW
 consultant C/S/F/B
 role C/S/F/B
 content

BAM job no.
 4389

purpose of issue
 CONSTRUCTION

dig status
 S4

rev
 003

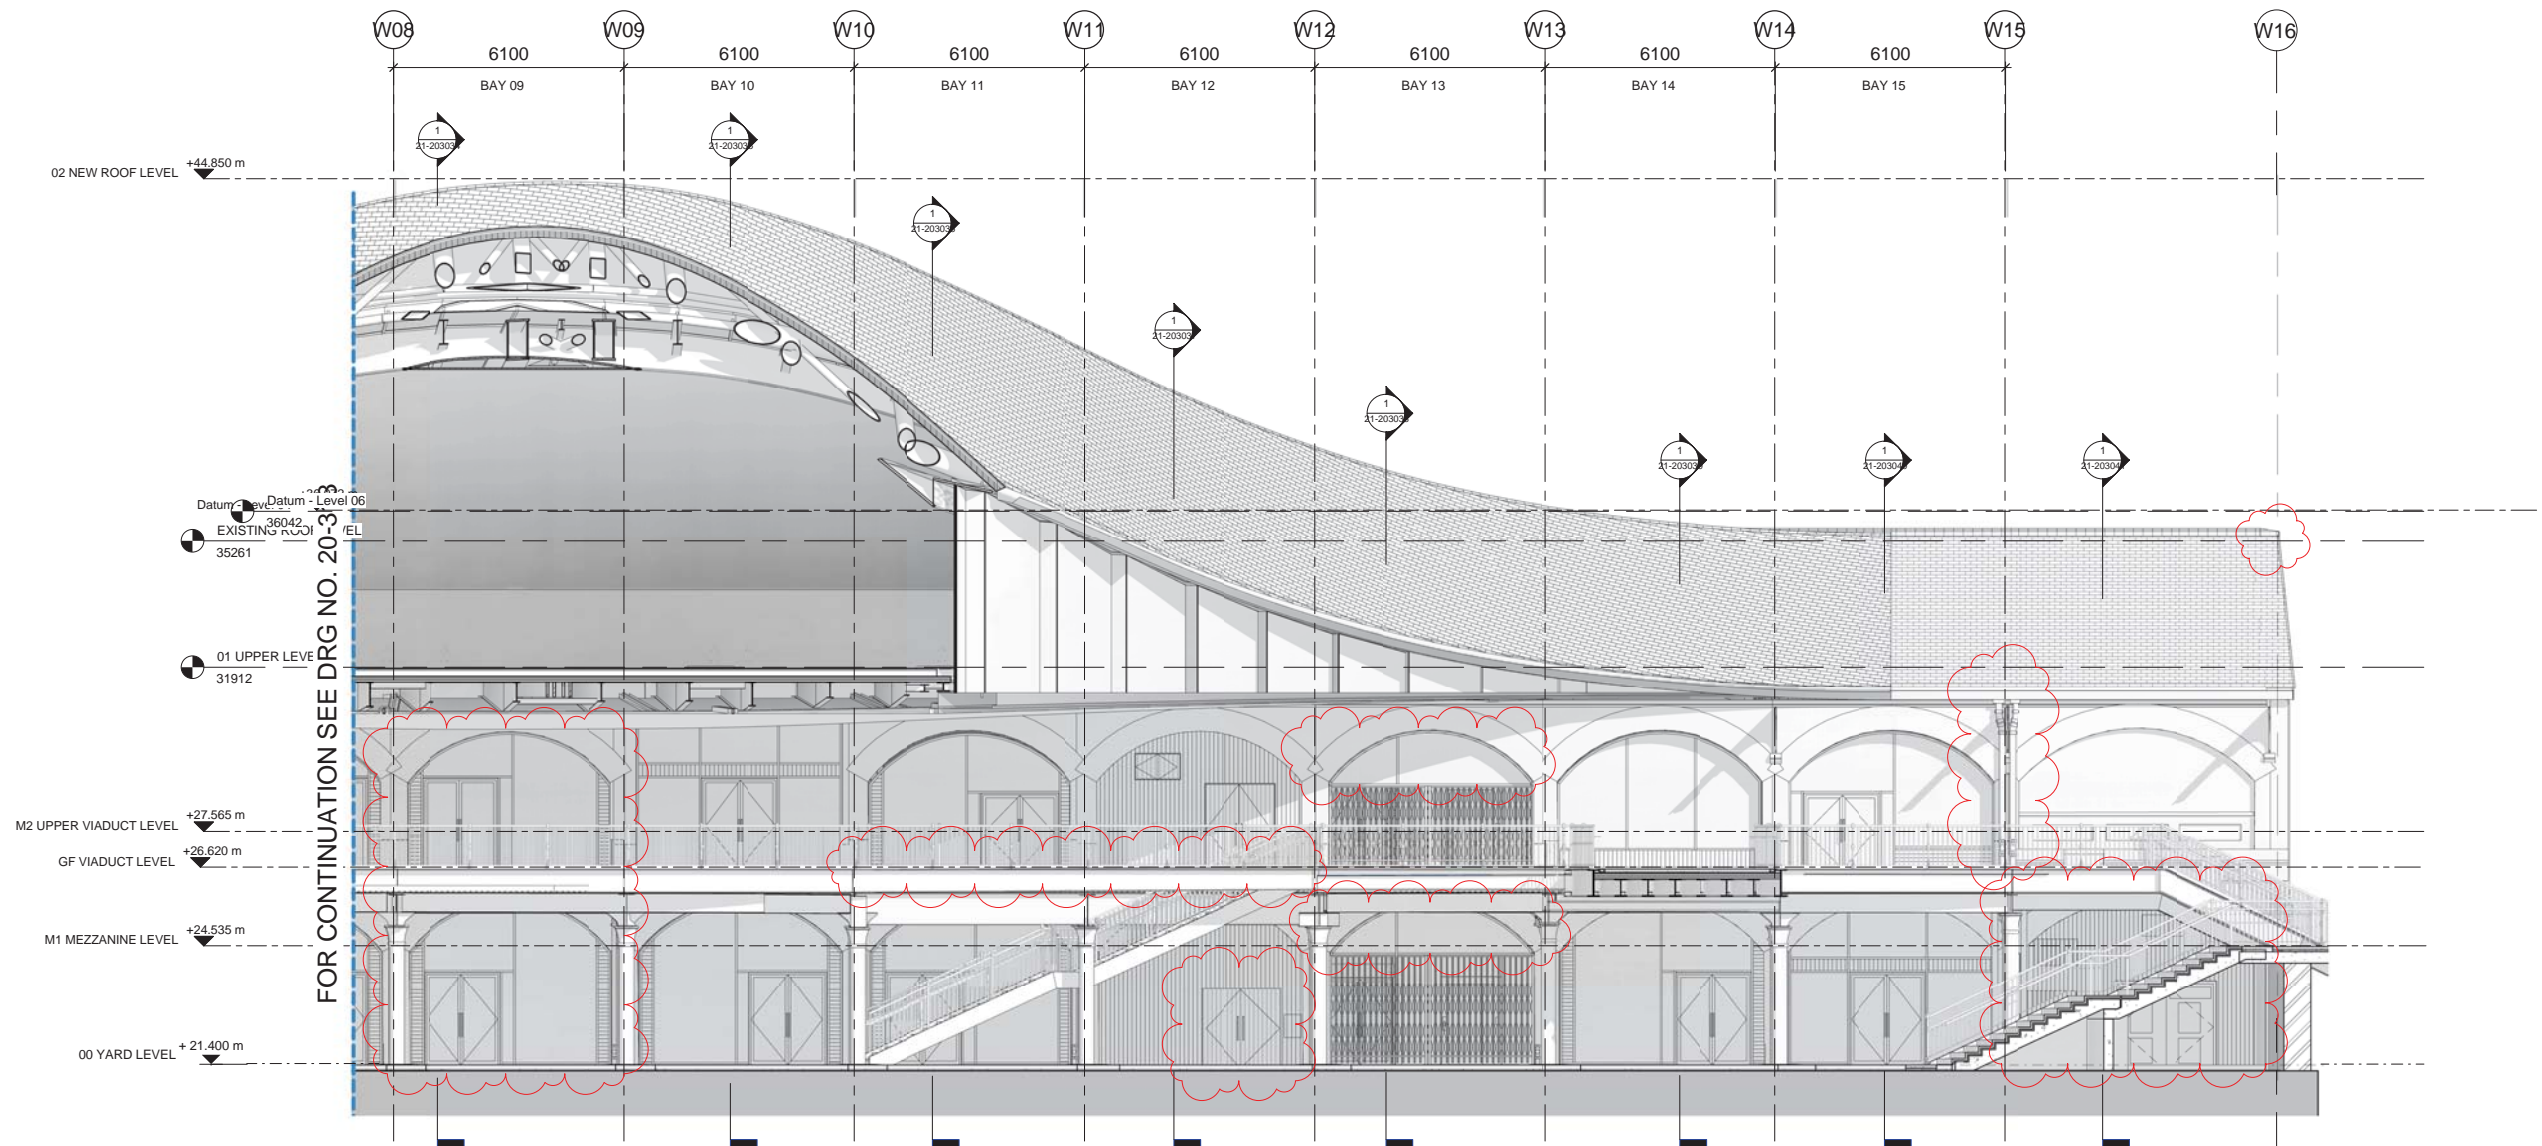


1 WCD - M1 - East Elevation - Zone 02
 1 : 100

Status Code (as defined in BS1192)
 S0 - Initial Status or WIP
 S1 - Issued for co-ordination
 S2 - Issued for information
 S3 - Issued for internal review
 S4 - Issued for construction approval
 D1 - Issued for costing
 D2 - Issued for tender

Documentation (Contractual)
 A - Issued for construction
 B - Issued for construction but with comments
 C - Comprehensive revision required
 AB - Record Drawing

Documentation (Pre-construction)
 D3 - Issued for contractor design
 D4 - Issued for manufacture/procurement

no	by	date	description
003	JSG	IAW	31/05/17 Updates to reflect Status C comments received 24/11/16.
002	TM	MWB	31/10/16 UPDATED AS CLOUDED

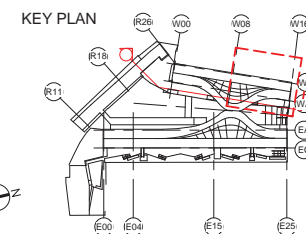

bam
 B&M Design Ltd
 An operating company of
 BAM Construct UK Ltd
 Architecture
 Interior Design
 3D Visualisation
 Feasibility Studies
 Structural Engineering
 Environmental Services
 Building Information Modelling

Centrium Business Park
 Giffords Way, St Albans
 Hertfordshire, AL1 2RD
 01272 884300
 design@bam.co.uk
 www.bam.co.uk

project COAL DROPS YARD


title Proposed East Elevation - West
 Coal Drop Sheet 02

scale 1 : 100 @ A1
 date 06/30/16
 site plot/location project
 KXC-M1- 001-BD4389-A- 20-314

drawn TM
 checked DGW
 consultant Role C/SFB
 4389

BAM job no. dig status
 003

purpose of issue
CONSTRUCTION

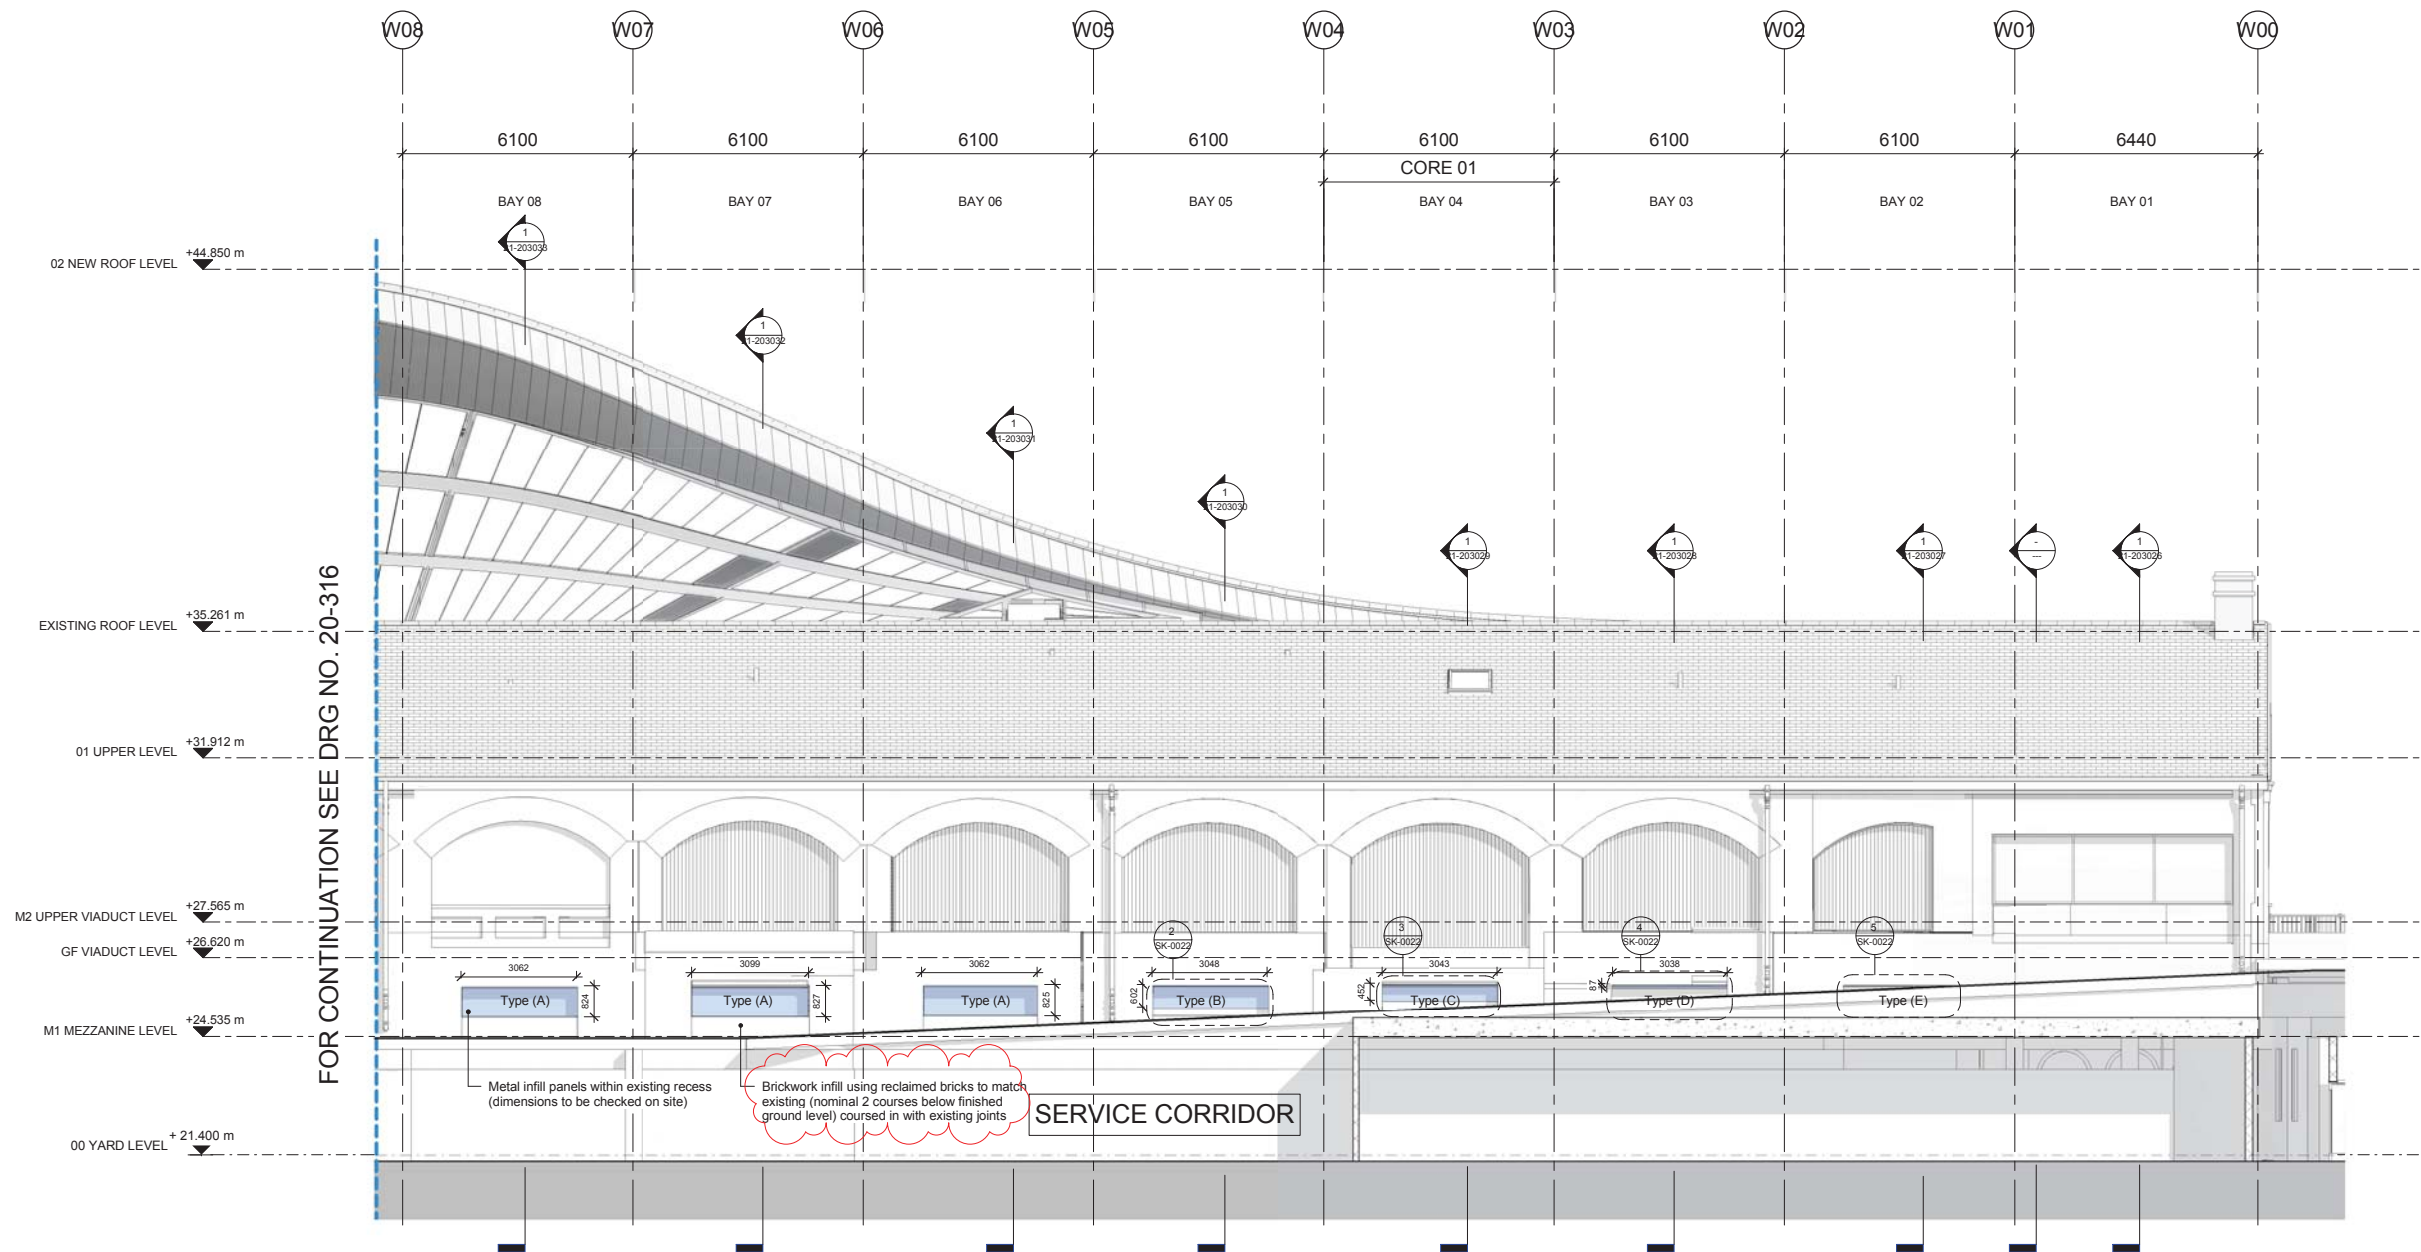

1 WCD - M1 - West Elevation - Zone 01
 1 : 100


Status Code (as defined in BS1192)
 S0 - Initial Status or WIP
 S1 - Issued for co-ordination
 S2 - Issued for information
 S3 - Issued for internal review
 S4 - Issued for construction approval
 D1 - Issued for costing
 D2 - Issued for tender

Documentation (Contractual)
 A - Issued for construction
 B - Issued for construction but with comments
 C - Comprehensive revision required

Archive
 AB - Record Drawing

Documentation (Pre-construction)
 D3 - Issued for contractor design
 D4 - Issued for manufacture/procurement

rev	by	date	description
004	I/AW	11.01.17	Updated to BAMC comments - brick infill note
003	I/AW	01.12.16	Metal cover panels to cast iron beams indicated
002	T/M	31.10.16	UPDATED AS CLOUDED

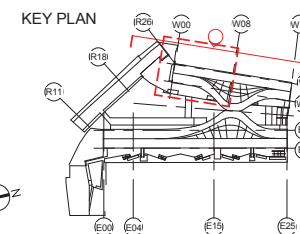

bam
 B&M Design Ltd
 An operating company of
 BAM Construct UK Ltd
 Architecture
 Interior Design
 3D Visualisation
 Feasibility Studies
 Structural Engineering
 Environmental Services
 Building Information Modelling

Centrium Business Park
 Griffiths Way, St Albans
 Hertfordshire, AL1 2PD
 01277 864200
 design@bam.co.uk
 www.bam.co.uk

project COAL DROPS YARD

title Proposed West Elevations -
 West Coal Drop Sheet 01

scale 1 : 100 @ A1

date 06/30/16

site plot/location project

checked DGW

consultant Role CISFS Content

drawn TM

BAM job no. 4389


purpose of issue CONSTRUCTION

rev. S4

004

design@bam.co.uk

KXC-M1- 001-BD4389-A- 20-315

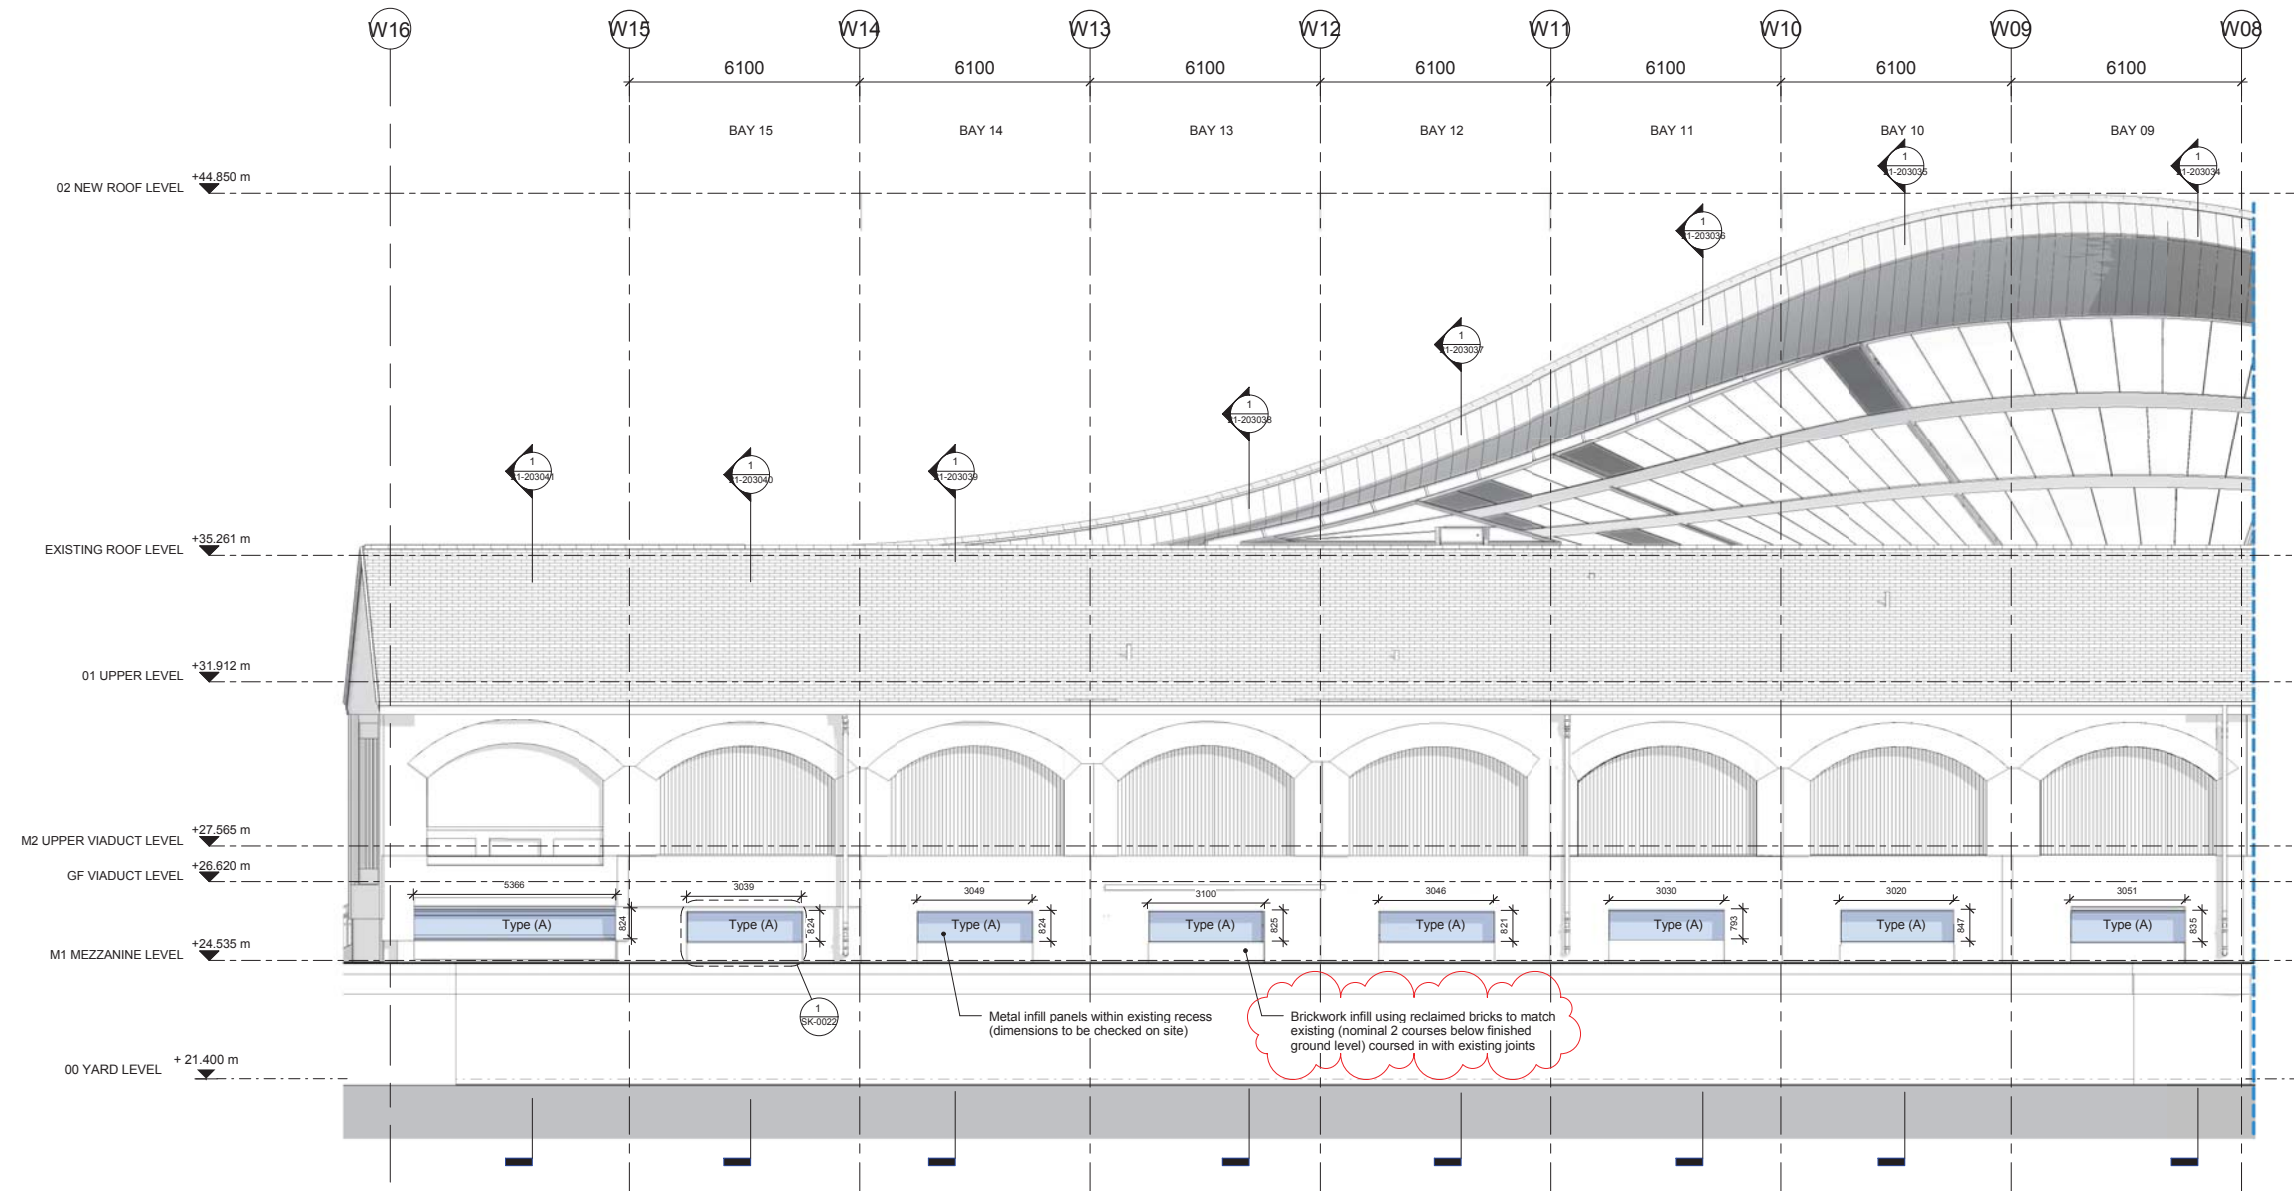

1 WCD - M1 - West Elevation - Zone 02
 1 : 100


Status Code (as defined in BS1192)
 S0 - Initial Status or WIP
 S1 - Issued for co-ordination
 S2 - Issued for information
 S3 - Issued for internal review
 S4 - Issued for construction approval
 D1 - Issued for costing
 D2 - Issued for tender

Documentation (Contractual)
 A - Issued for construction
 B - Issued for construction but with comments
 C - Comprehensive revision required

Archive
 AB - Record Drawing

Documentation (Pre-construction)
 D3 - Issued for contractor design
 D4 - Issued for manufacture/procurement

no.	by	date	description
003	JAW	11.01.17	Updated to BAMC comments - brick infill note
002	JAW	01.12.16	Metal cover panels to cast iron beams indicated

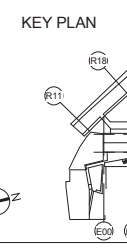

bam
 BAM Design Ltd
 An operating company of
 BAM Construct UK Ltd
 Architecture
 Interior Design
 3D Visualisation
 Feasibility Studies
 Structural Engineering
 Environmental Services
 Building Information Modelling

Centrium Business Park
 Griffiths Way, St Albans
 Hertfordshire, AL1 2PD
 01272 884200
 design@bam.co.uk
 www.bam.co.uk

project COAL DROPS YARD

title Proposed West Elevations -
 West Coal Drop Sheet 02

scale 1 : 100 @ A1

date 06/30/16

site plot/location project

drawn TM

checked DGW

Role CISFS Content

BAM job no. 4389


purpose of issue CONSTRUCTION

rev. S4

003

design@bam.co.uk

KXC-M1- 001-BD4389-A- 20-316

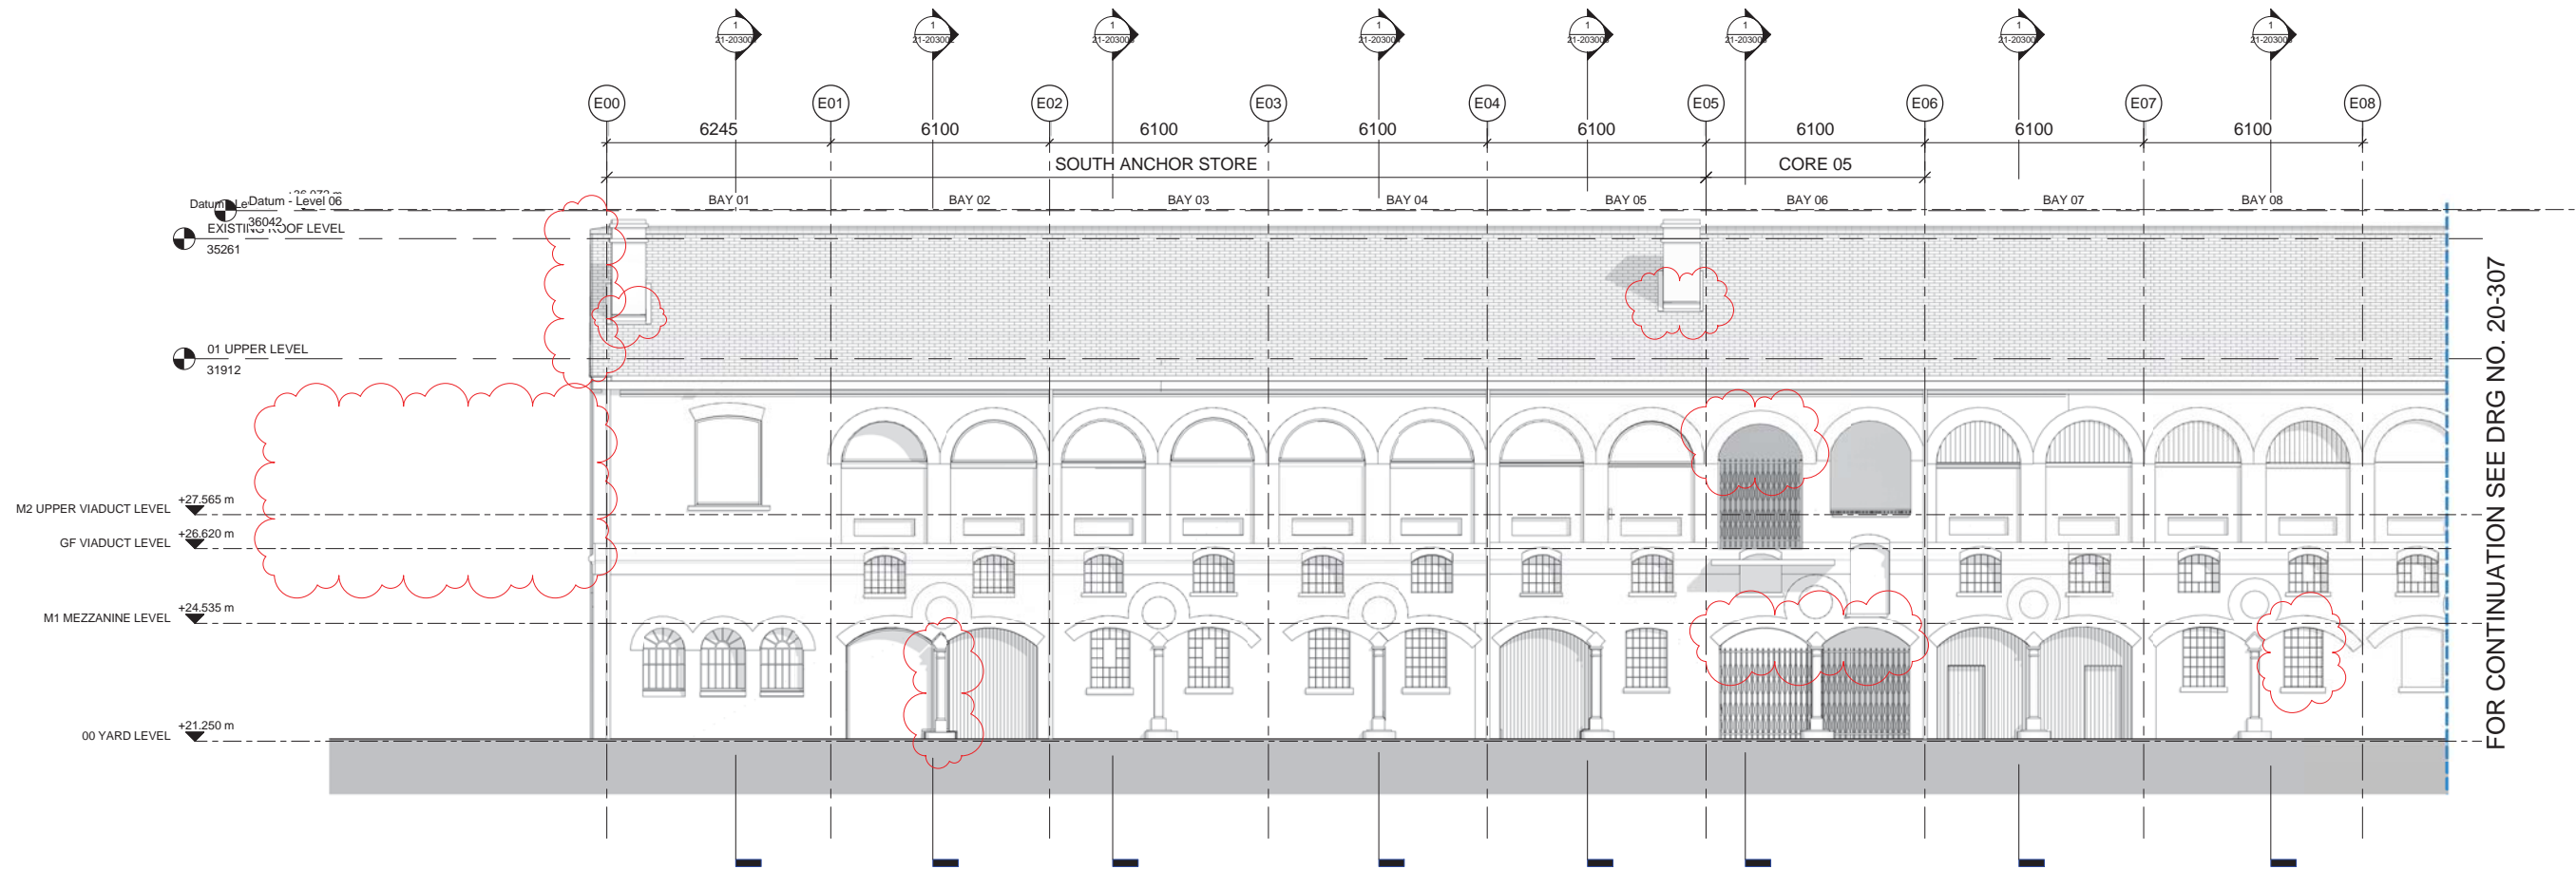

1 ECD - M2 - East Elevation - Zone 01
 1 : 100

FOR CONTINUATION SEE DRG NO. 20-307


Status Code (as defined in BS1192)
 S0 - Initial Status or WIP
 S1 - Issued for co-ordination
 S2 - Issued for information
 S3 - Issued for internal review
 S4 - Issued for construction approval
 D1 - Issued for costing
 D2 - Issued for tender

Documentation (Contractual)
 A - Issued for construction
 B - Issued for construction but with comments
 C - Comprehensive revision required

Archive
 AB - Record Drawing

Documentation (Pre-construction)
 D3 - Issued for contractor design
 D4 - Issued for manufacture/procurement

no	by	date	description
003	JSG	IAW	31/05/17 Updates to reflect Status C comments received 24/11/16.
002	TM	MWB	31/10/16 UPDATED AS CLOUDED

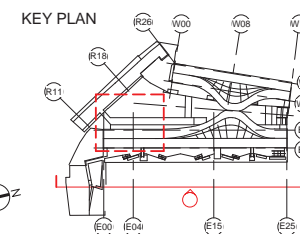

bam
 B&M Design Ltd
 An operating company of
 BAM Construct UK Ltd
 Architecture
 Interior Design
 3D Visualisation
 Feasibility Studies
 Structural Engineering
 Environmental Services
 Building Information Modelling

Centrium Business Park
 Griffiths Way, St Albans
 Hertfordshire, AL1 2RD
 01727 884300
 design@bam.co.uk
 www.bam.co.uk

project COAL DROPS YARD

title Proposed East Elevation - East Coal Drop Sheet 01

scale 1 : 100 @ A1

date 06/30/16

site plot/location project

drawn TM

checked DGW

consultant Role C/SFB


BAM job no. 4389

purpose of issue CONSTRUCTION

rev. S4

003

project KXC-M2- 001-BD4389-A- 20-306

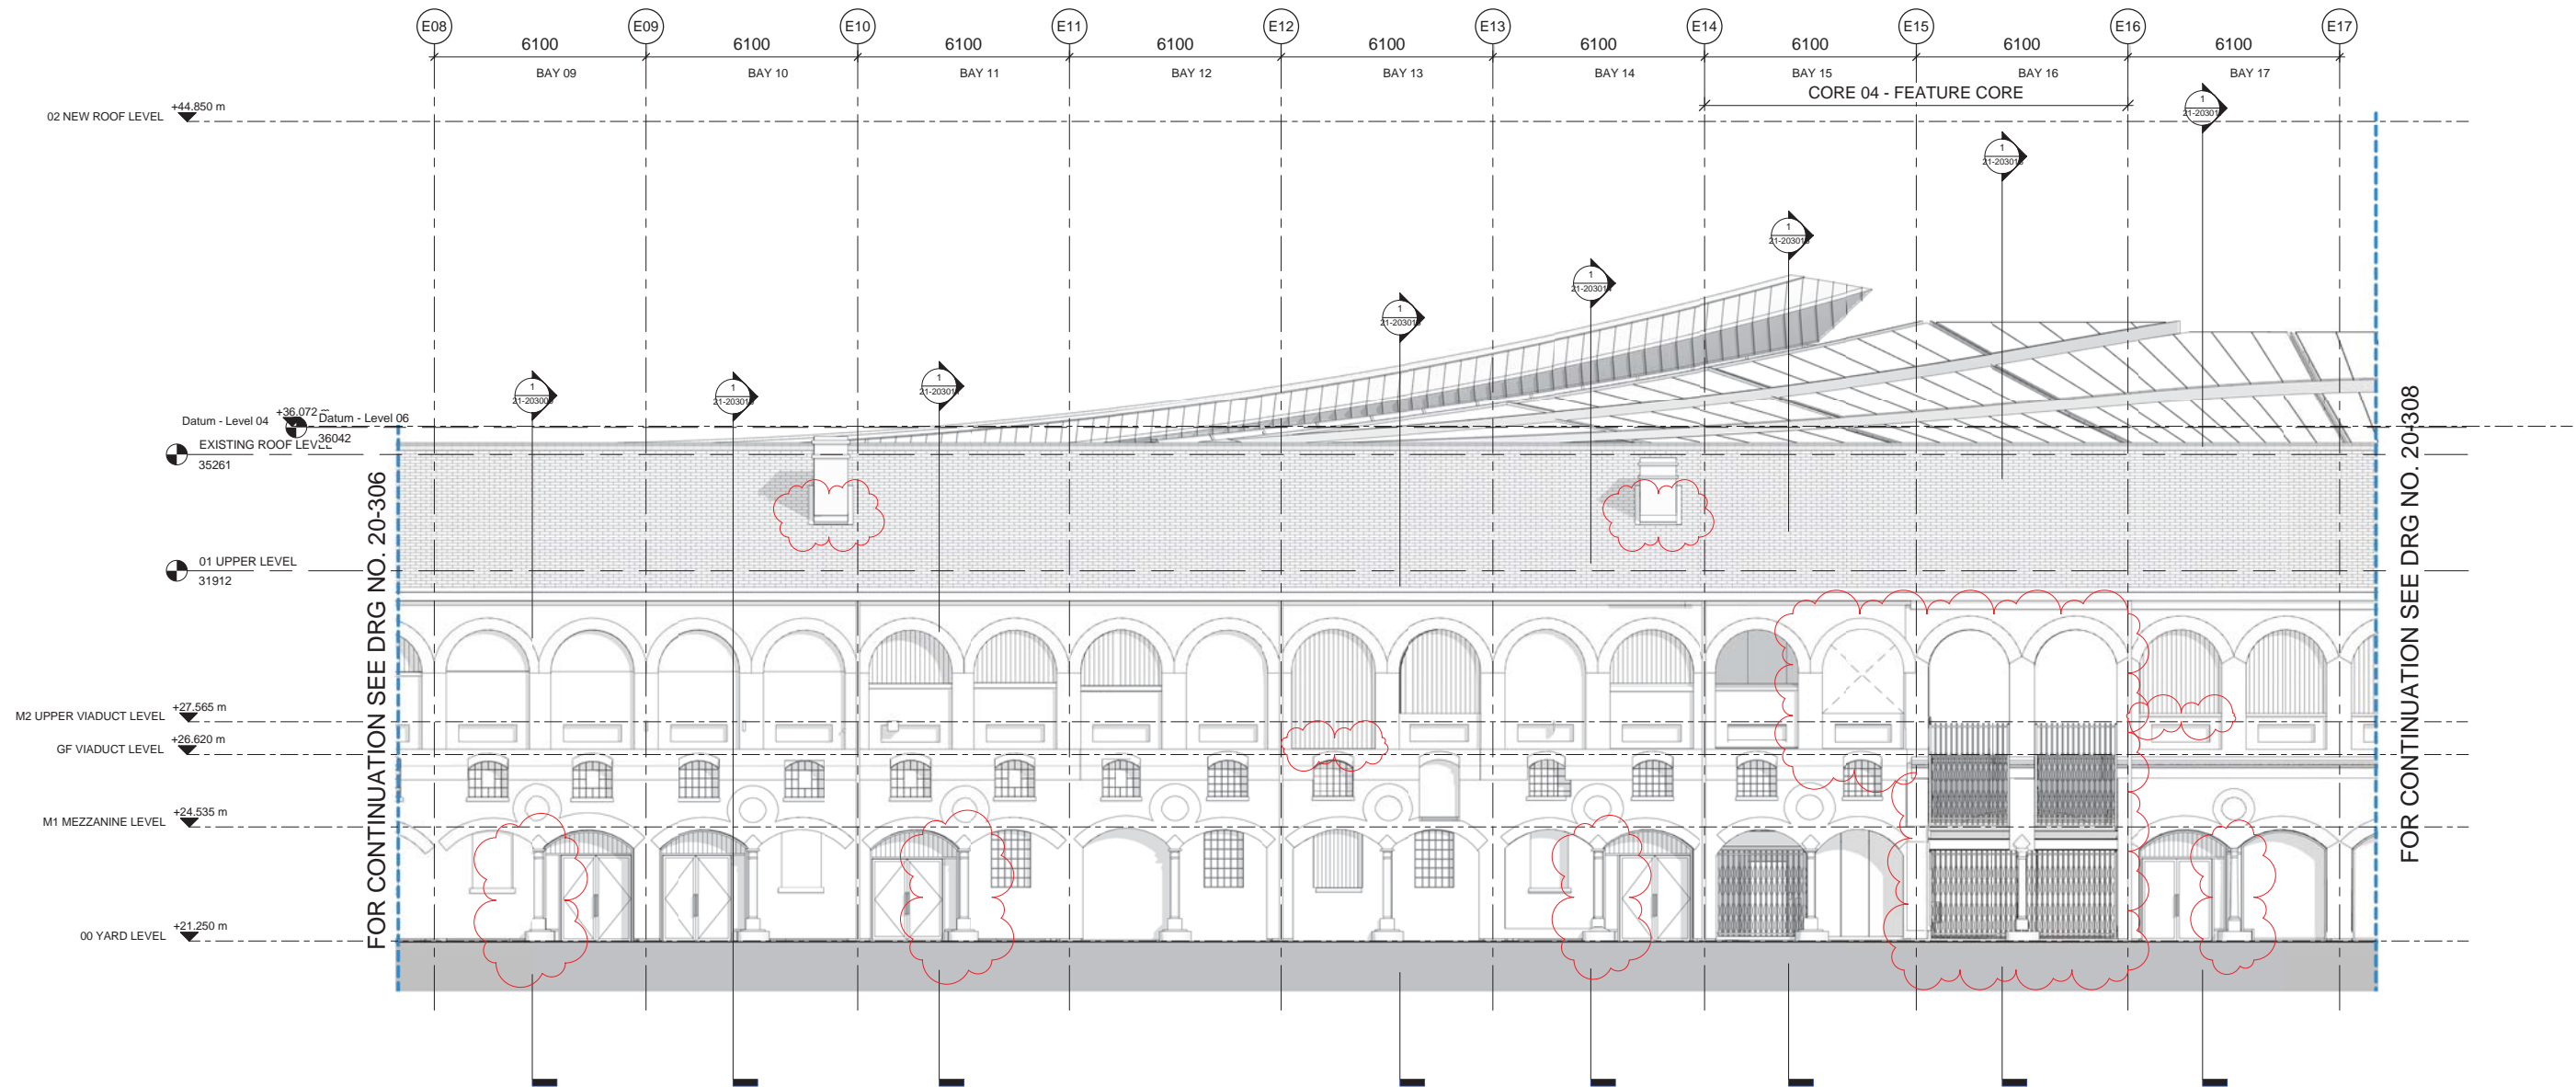

1 ECD - M2 - East Elevation - Zone 02
 1 : 100


Status Code (as defined in BS1192)
 S0 - Initial Status or WIP
 S1 - Issued for co-ordination
 S2 - Issued for information
 S3 - Issued for internal review
 S4 - Issued for construction approval
 D1 - Issued for costing
 D2 - Issued for tender

Documentation (Contractual)
 A - Issued for construction
 B - Issued for construction but with comments
 C - Comprehensive revision required

Archive
 AB - Record Drawing

Documentation (Pre-construction)
 D3 - Issued for contractor design
 D4 - Issued for manufacture/procurement

no	by	date	description
003	JSG	IAW	31/05/17 Updates to reflect Status C comments received 24/11/16.
002	TM	MWB	31/10/16 UPDATED AS CLOUDED

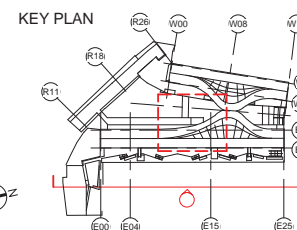

bam
 B&M Design Ltd
 An operating company of
 BAM Construct UK Ltd
 Architecture
 Interior Design
 3D Visualisation
 Feasibility Studies
 Structural Engineering
 Environmental Services
 Building Information Modelling

Centrium Business Park
 Griffiths Way, St Albans
 Hertfordshire, AL1 2RD
 01277 884300
 design@bam.co.uk
 www.bam.co.uk

project COAL DROPS YARD

title Proposed East Elevation - East Coal Drop Sheet 02

purpose of issue CONSTRUCTION

scale 1 : 100 @ A1

date 06/30/16

site plot/location project

design@bam.co.uk

drawn TM

checked DGW


consultant Role C/S/F/B

BAM job no. 4389

rev. S4

003

001-BD4389-A-20-307

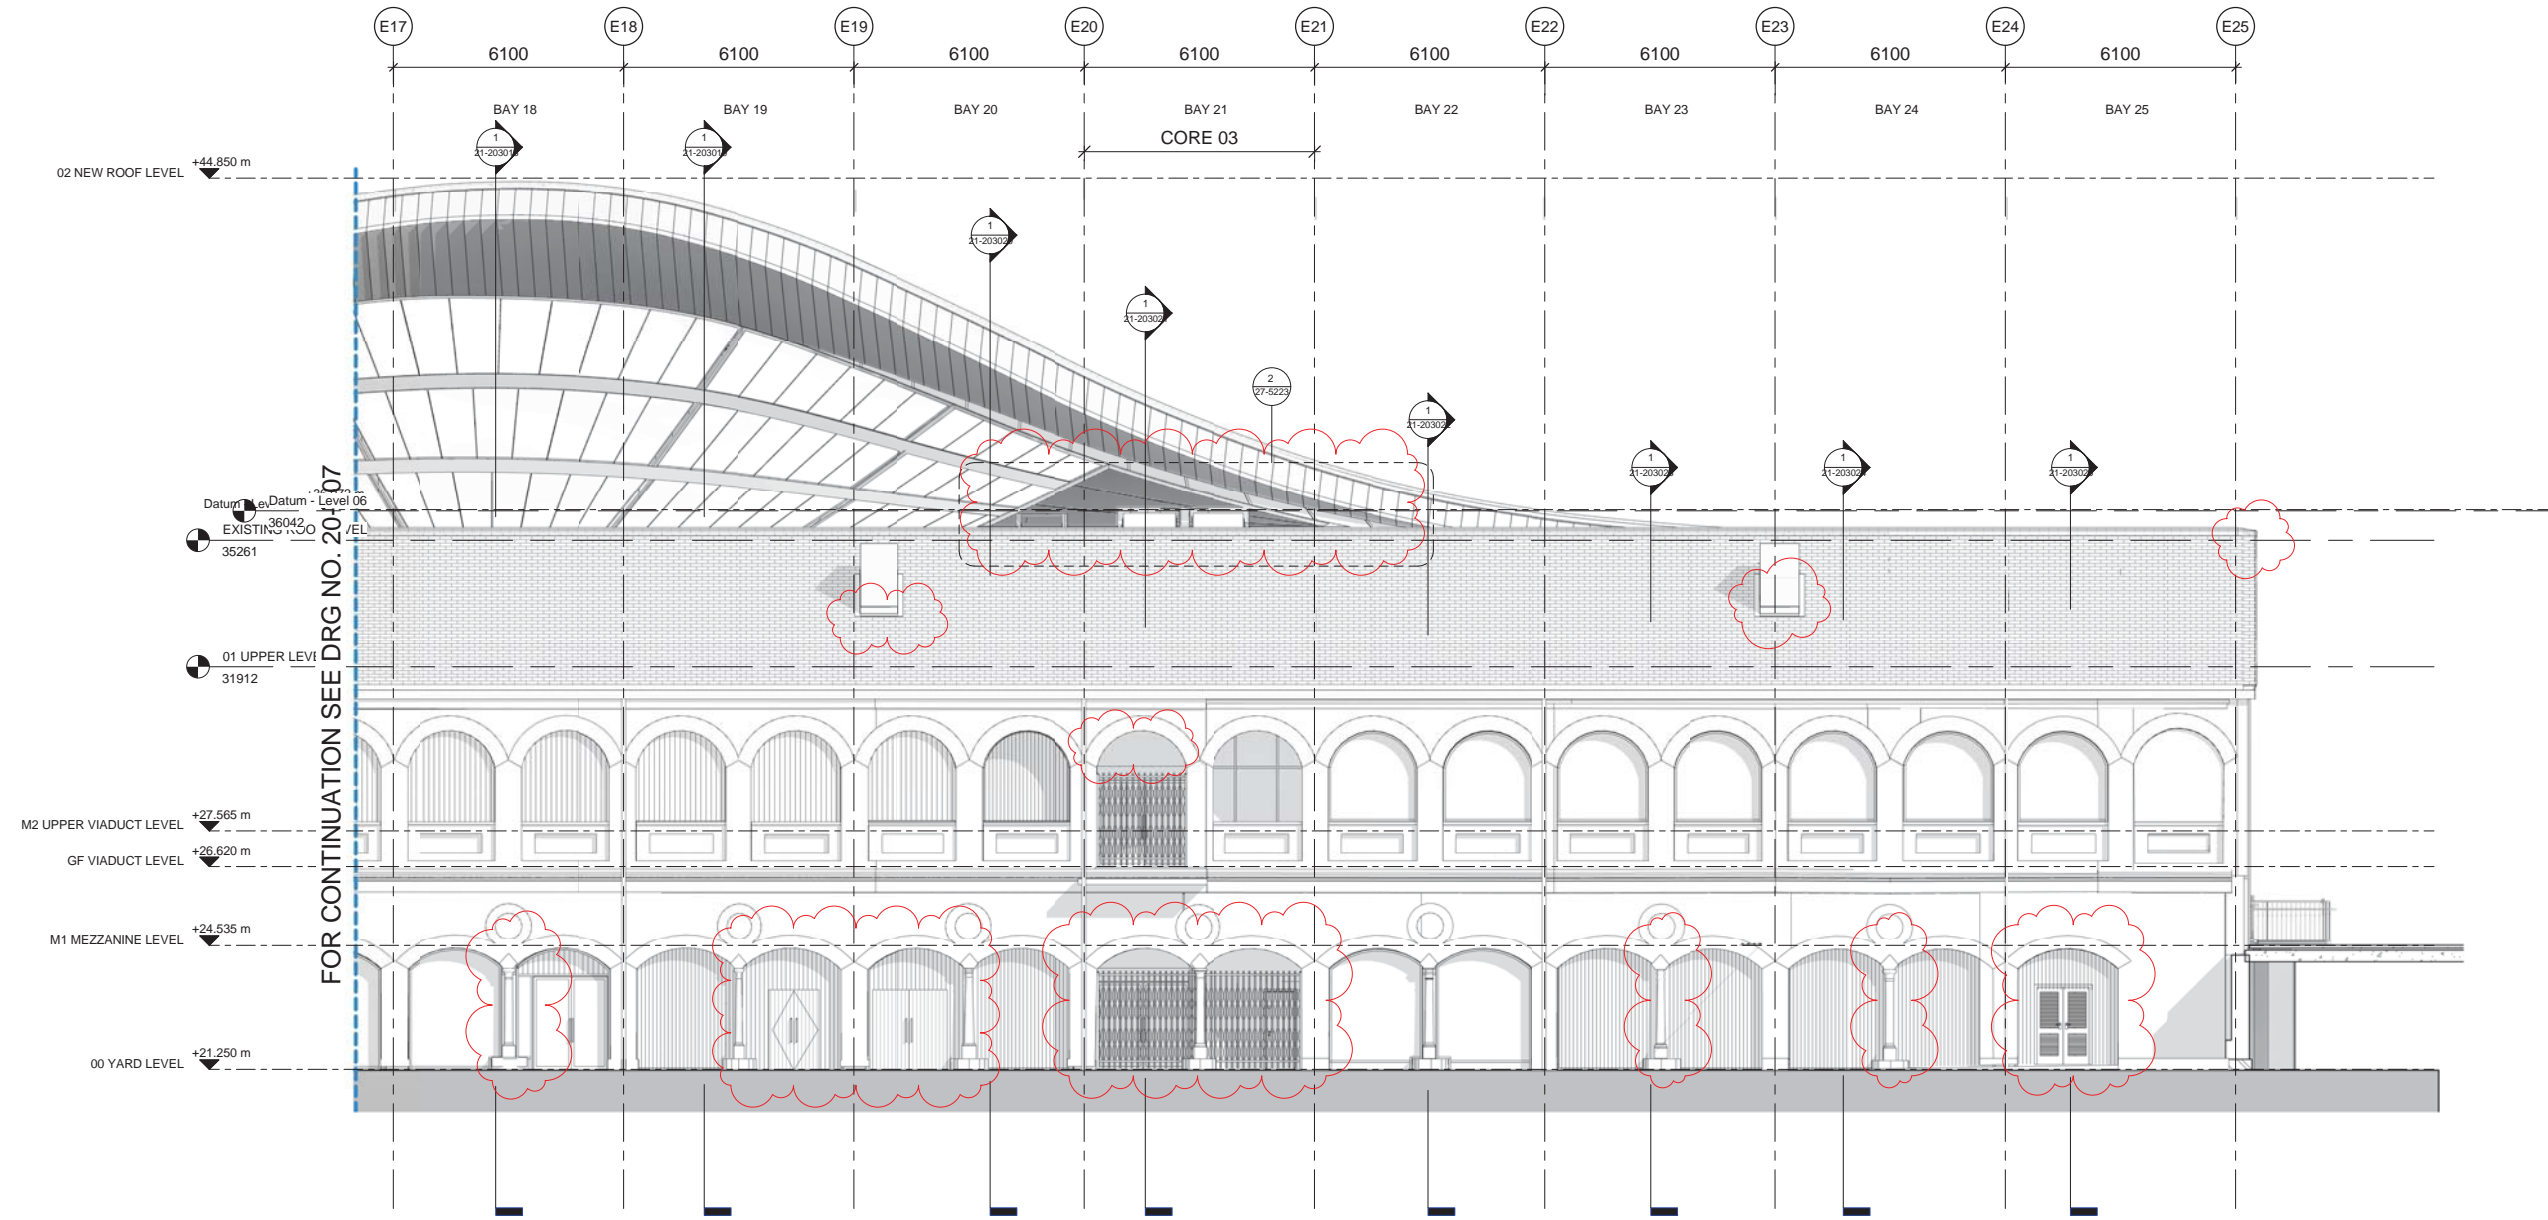


1 ECD - M2 - East Elevation - Zone 03
 1 : 100

Status Code (as defined in BS1192)
 S0 - Initial Status or WIP
 S1 - Issued for co-ordination
 S2 - Issued for information
 S3 - Issued for internal review
 S4 - Issued for construction approval
 D1 - Issued for costing
 D2 - Issued for tender

Documentation (Contractual)
 A - Issued for construction
 B - Issued for construction but with comments
 C - Comprehensive revision required
 AB - Record Drawing

Documentation (Pre-construction)
 D3 - Issued for contractor design
 D4 - Issued for manufacture/procurement

no	by	date	description
003	JSG IAW	31/05/17	Updates to reflect Status C comments received 24/11/16.
002	TM MWB	31/10/16	UPDATED AS CLOUDED

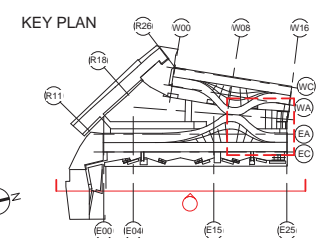

bam
 BAM Design Ltd
 An operating company of BAM Construct UK Ltd
 Architecture
 Interior Design
 3D Visualisation
 Feasibility Studies
 Structural Engineering
 Environmental Services
 Building Information Modelling

Centrium Business Park
 Griffiths Way, St Albans
 Hertfordshire, AL1 2RD
 01277 884300
 design@bam.co.uk
 www.bam.co.uk

project COAL DROPS YARD

title Proposed East Elevation - East Coal Drop Sheet 03

scale 1 : 100 @ A1

date 06/30/16

site plot/location project

drawn TM

checked DGW

consultant Role CIS/FS

BAM job no. 4389


purpose of issue CONSTRUCTION

rev. S4

003

design@bam.co.uk

KXC-M2- 001-BD4389-A- 20-308

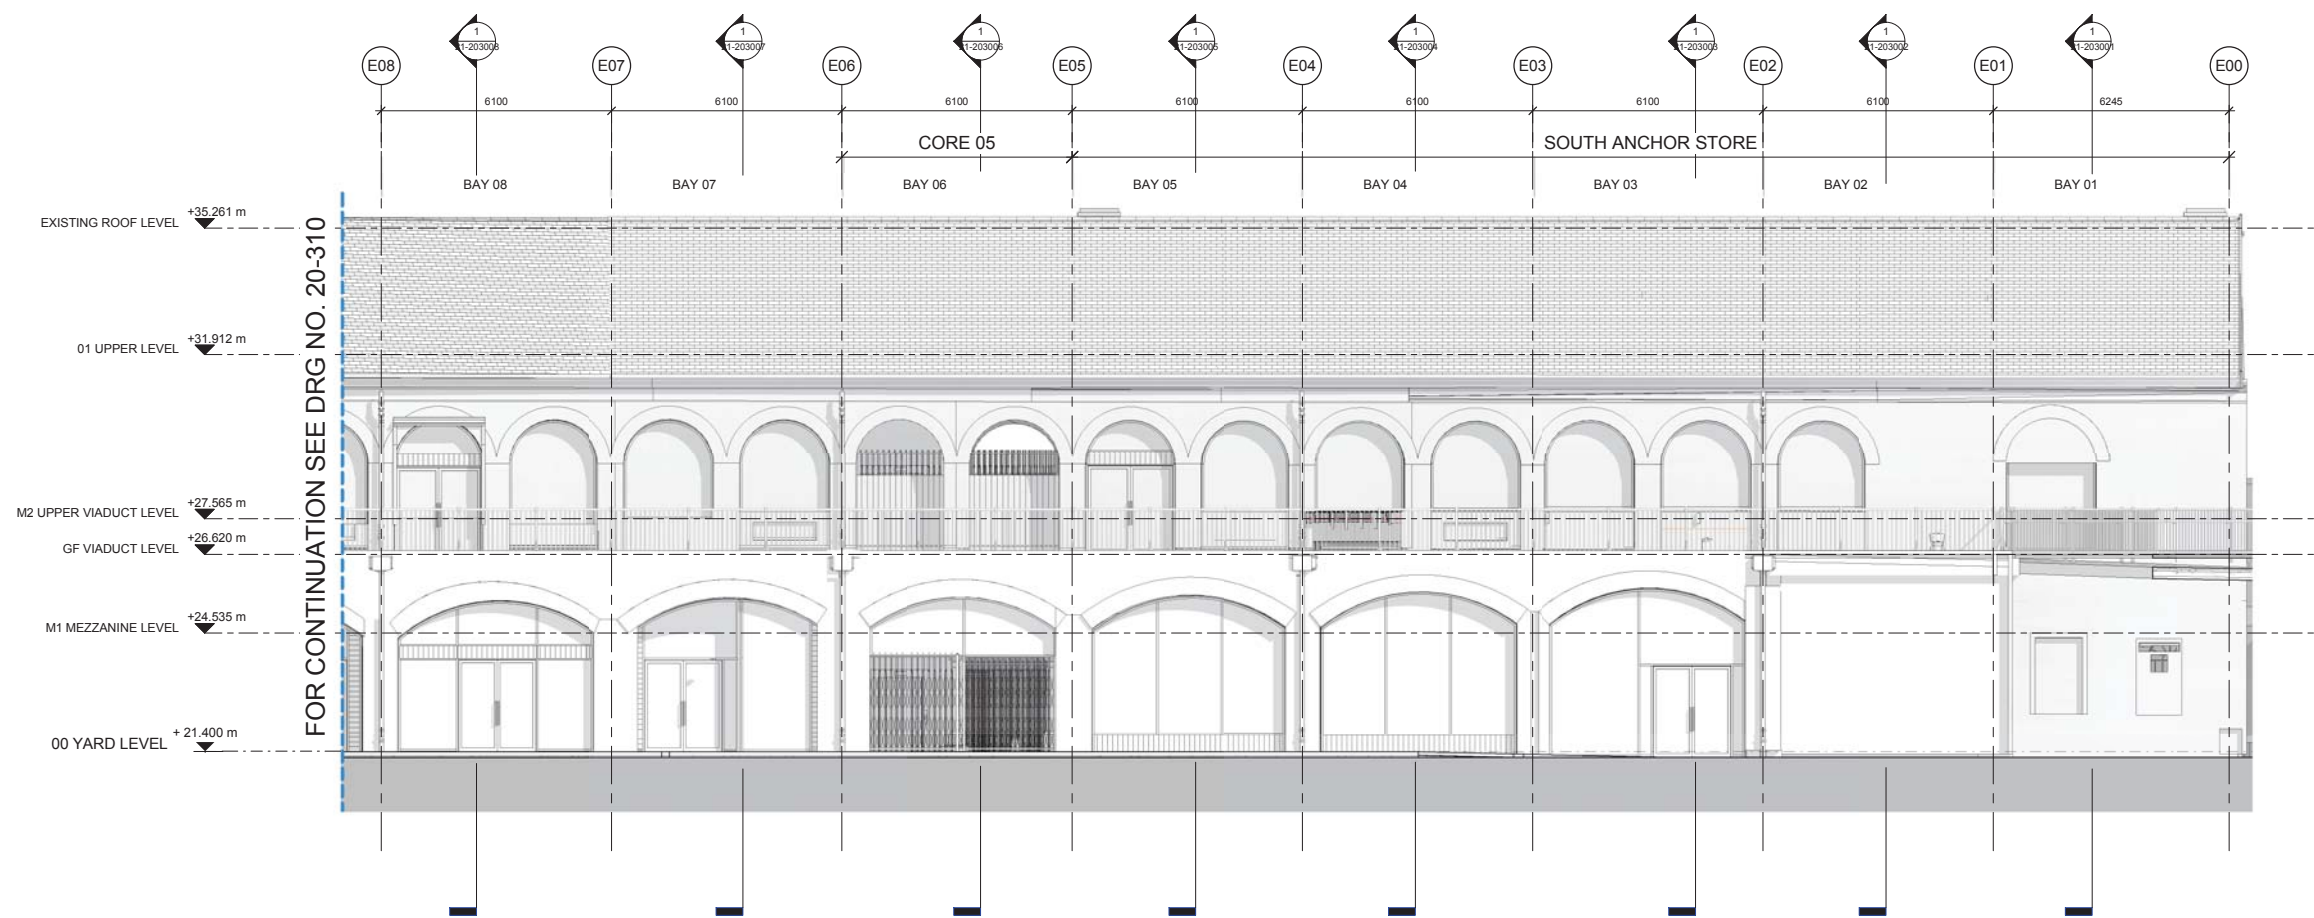

1 ECD - M2 - West Elevation - Zone 01
 1 : 100


Status Code (as defined in BS1192)
 S0 - Initial Status or WIP
 S1 - Issued for co-ordination
 S2 - Issued for information
 S3 - Issued for internal review
 S4 - Issued for construction approval
 D1 - Issued for costing
 D2 - Issued for tender

Documentation (Contractual)
 A - Issued for construction
 B - Issued for construction but with comments
 C - Comprehensive revision required
 AB - Record Drawing

Documentation (Pre-construction)
 D3 - Issued for contractor design
 D4 - Issued for manufacture/procurement

Archive

KEY PLAN

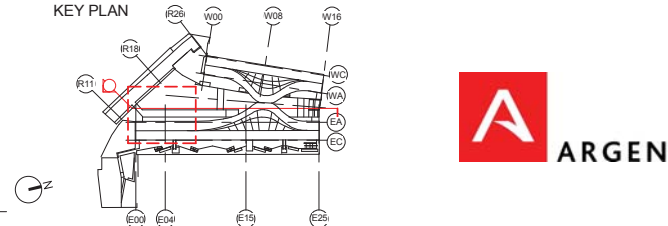

bam
 B&M Design Ltd
 An operating company of
 BAM Construct UK Ltd
 Architecture
 Interior Design
 3D Visualisation
 Feasibility Studies
 Structural Engineering
 Environmental Services
 Building Information Modelling

Centrium Business Park
 Griffiths Way, St Albans
 Hertfordshire, AL1 2RD
 01727 884200
 design@bam.co.uk
 www.bam.co.uk


project COAL DROPS YARD

title Proposed West Elevations -
 East Coal Drop Sheet 01

purpose of issue CONSTRUCTION

scale 1 : 100 @ A1 drawn TM BAM job no. dig status
 date 06/30/16 checked DGW 4389 S4
 site plot/location project Consultant Role CISFS Content rev.
 drg / doc ref KXC-M2- 001-BD4389-A- 20-309 001

rev by chd date description

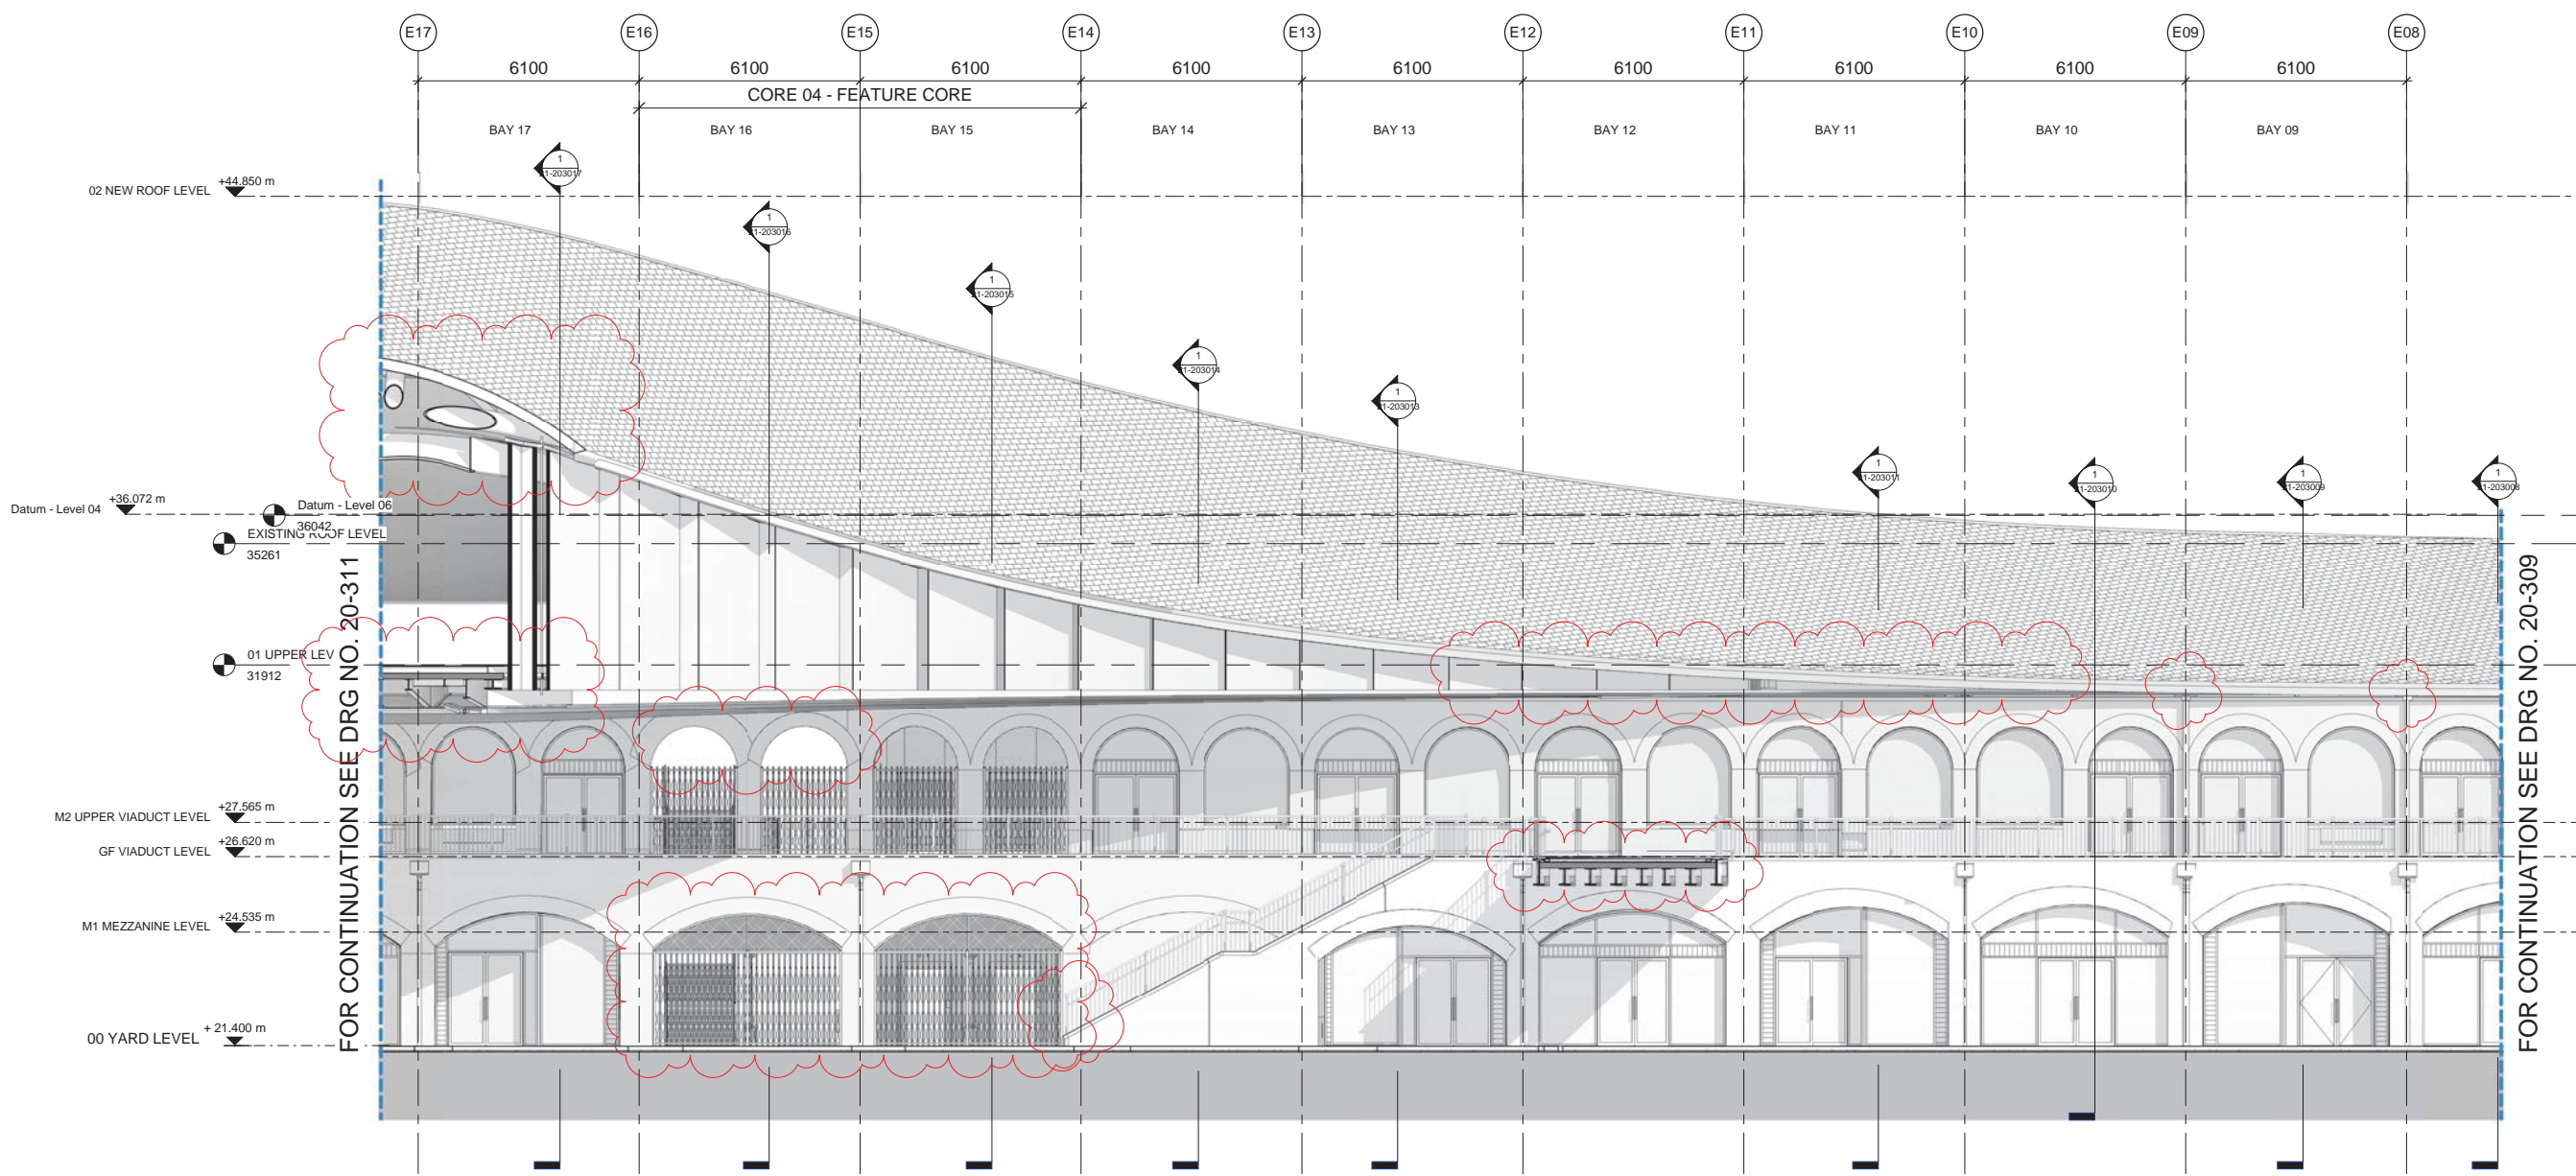

FOR CONTINUATION SEE DRG NO. 20-311

FOR CONTINUATION SEE DRG NO. 20-309

1 ECD - M2 - West Elevation - Zone 02
 1 : 100


Status Code (as defined in BS1192)
 S0 - Initial Status or WIP
 S1 - Issued for co-ordination
 S2 - Issued for information
 S3 - Issued for internal review
 S4 - Issued for construction approval
 D1 - Issued for costing
 D2 - Issued for tender

Documentation (Contractual)
 A - Issued for construction
 B - Issued for construction but with comments
 C - Comprehensive revision required

Archive
 AB - Record Drawing

Documentation (Pre-construction)
 D3 - Issued for contractor design
 D4 - Issued for manufacture/procurement

no	by	date	description
003	JSG	IAW	31/05/17 Updates to reflect Status C comments received 24/11/16.
002	TM	MWB	31/10/16 UPDATED AS CLOUDED

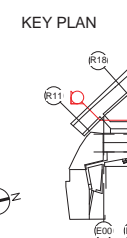

bam
 BAM Design Ltd
 An operating company of
 BAM Construct UK Ltd
 Architecture
 Interior Design
 3D Visualisation
 Feasibility Studies
 Structural Engineering
 Environmental Services
 Building Information Modelling

Centrium Business Park
 Griffiths Way, St Albans
 Hertfordshire, AL1 2RD
 01277 884300
 design@bam.co.uk
 www.bam.co.uk

project COAL DROPS YARD

title Proposed West Elevation - East
 Coal Drop Sheet 02


scale 1 : 100 @ A1
 date 06/30/16
 site plot/location project
 KXC-M2- 001-BD4389-A- 20-310

drawn TM
 checked DGW
 consultant
 4389

BAM job no.
 4389

purpose of issue
 CONSTRUCTION

rev. S4
 003

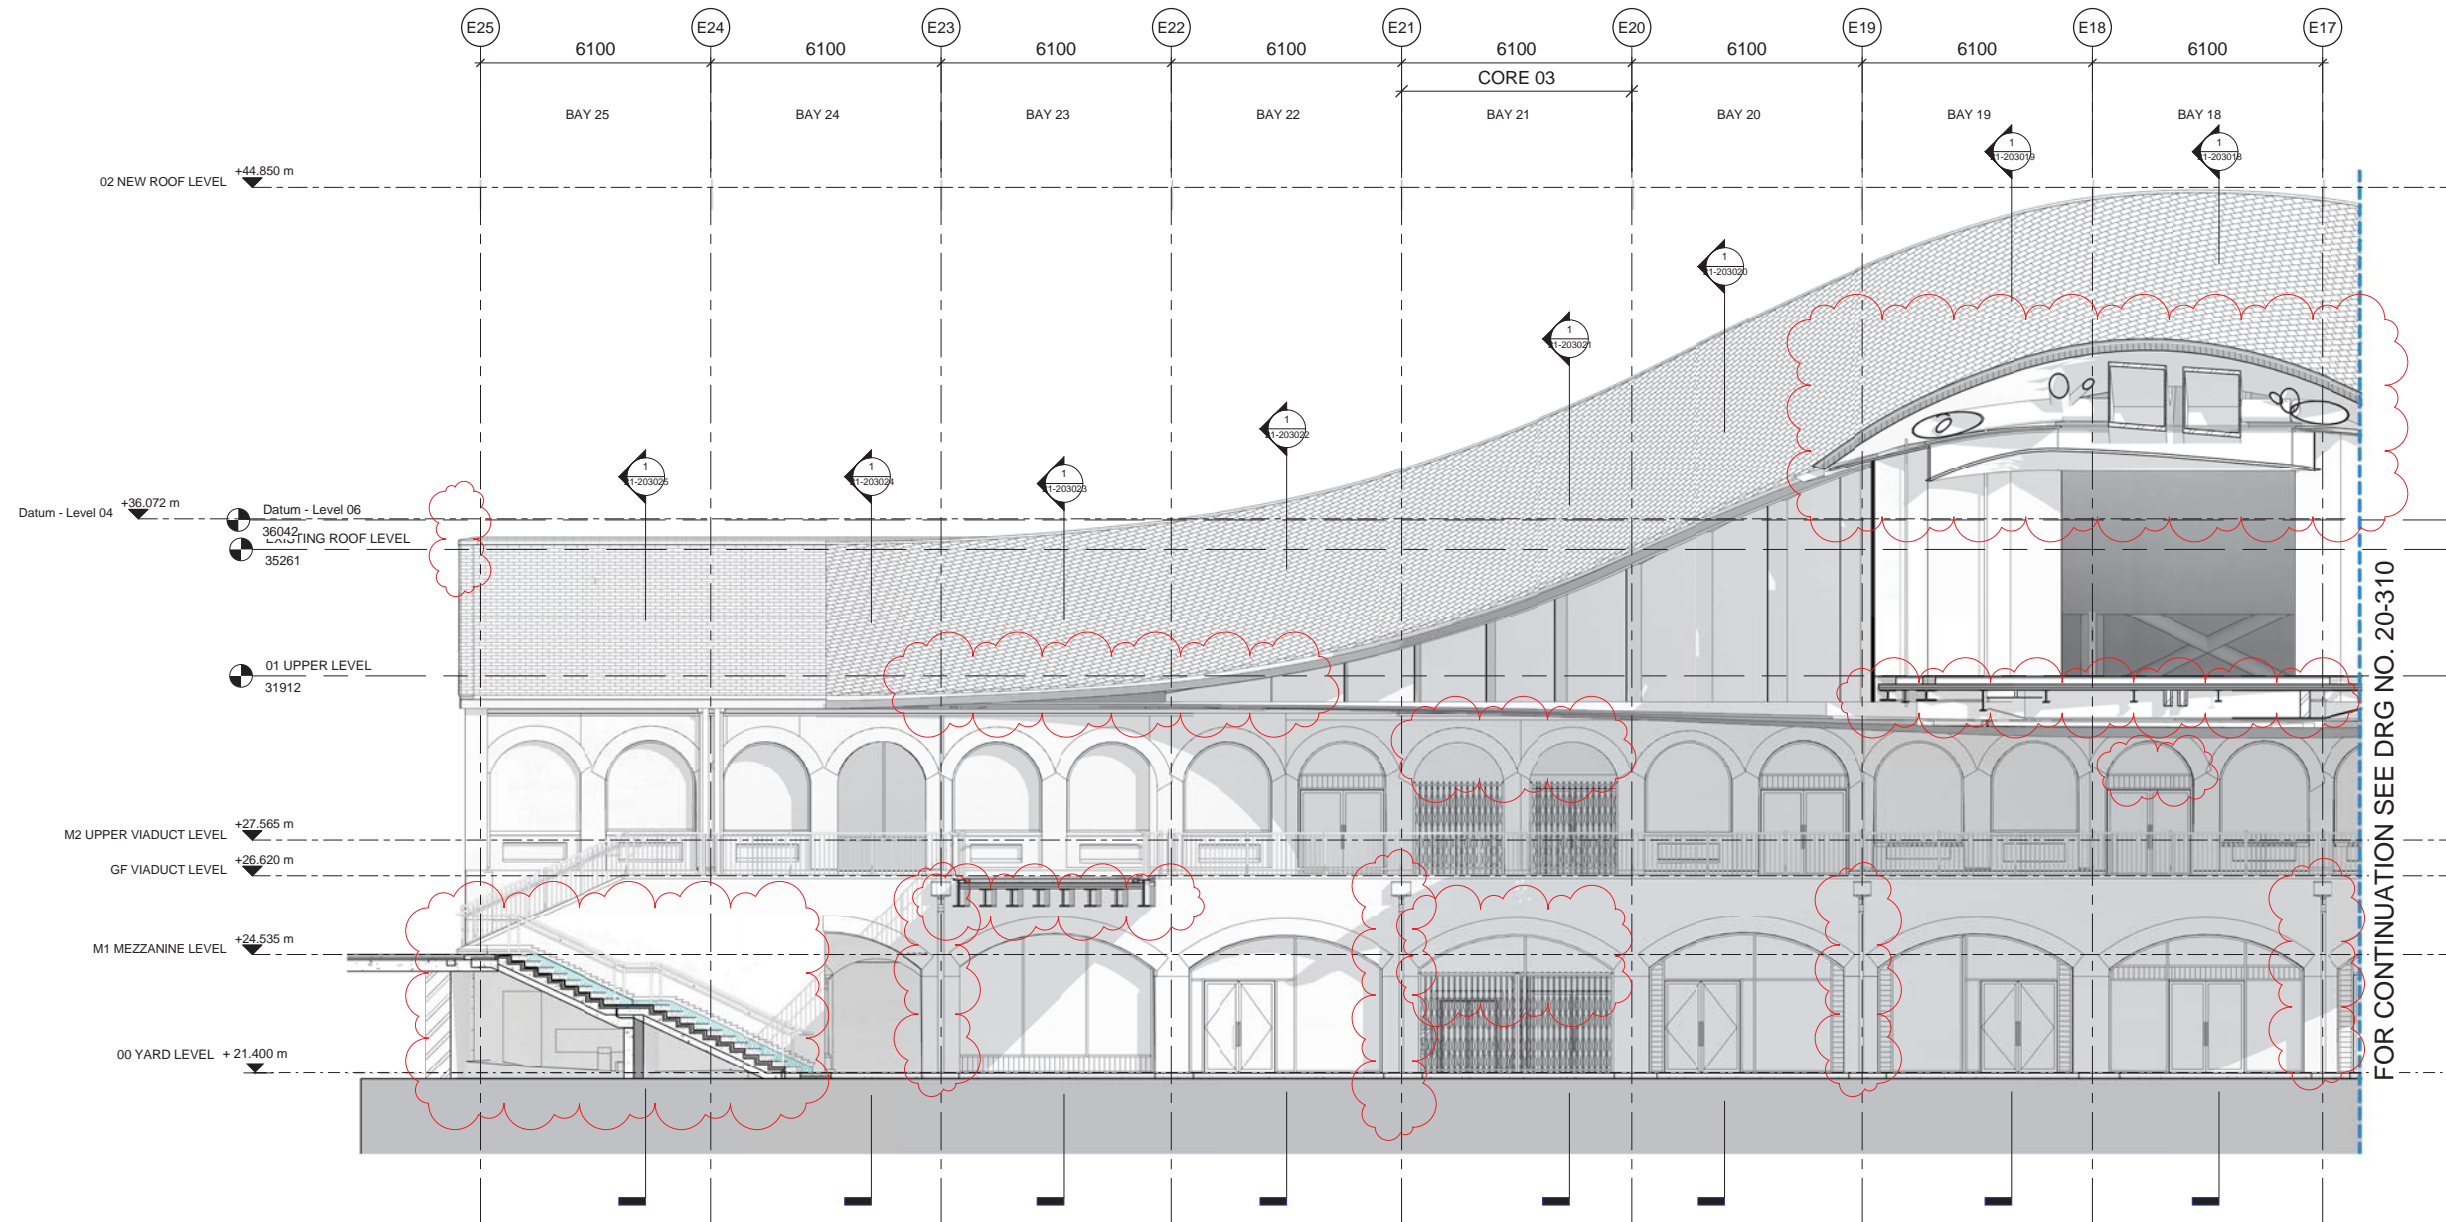


1 ECD - M2 - West Elevation - Zone 03
 1 : 100

Status Code (as defined in BS1192)
 S0 - Initial Status or WIP
 S1 - Issued for co-ordination
 S2 - Issued for information
 S3 - Issued for internal review
 S4 - Issued for construction approval
 D1 - Issued for costing
 D2 - Issued for tender

Documentation (Contractual)
 A - Issued for construction
 B - Issued for construction but with comments
 C - Comprehensive revision required
 AB - Record Drawing

Documentation (Pre-construction)
 D3 - Issued for contractor design
 D4 - Issued for manufacture/procurement

no	by	date	description
003	JSG IAW	31/05/17	Updates to reflect Status C comments received 24/11/16.
002	TM MWB	31/10/16	UPDATED AS CLOUDED

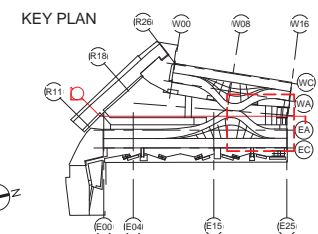

bam
 B&M Design Ltd
 An operating company of
 BAM Construct UK Ltd
 Architecture
 Interior Design
 3D Visualisation
 Feasibility Studies
 Structural Engineering
 Environmental Services
 Building Information Modelling

Centrium Business Park
 Griffiths Way, St Albans
 Hertfordshire, AL1 2RD
 01727 884300
 design@bam.co.uk
 www.bam.co.uk

project COAL DROPS YARD

title Proposed West Elevations -
 East Coal Drop Sheet 03

purpose of issue CONSTRUCTION

scale 1 : 100 @ A1
 date 06/30/16
 site plot/location project
 drawn TM
 checked DGW
 consultant Role C/SFB
 B&M job no. 4389
 dig status S4
 rev 003
 drg / doc ref KXC-M2- 001-BD4389-A- 20-311