



AS INSTALLED FRONT ELEVATION
Scale 1:50

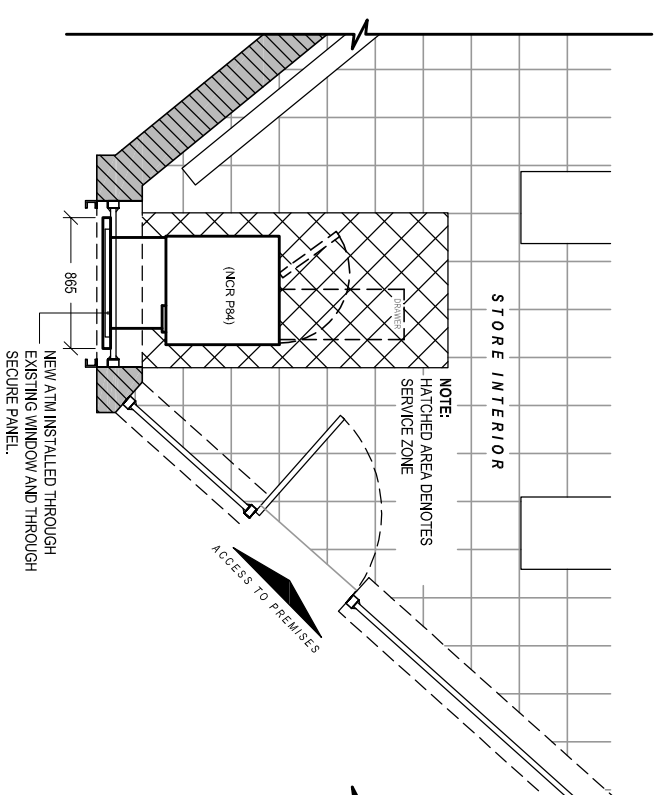

AS INSTALLED PART PLAN
Scale 1:50

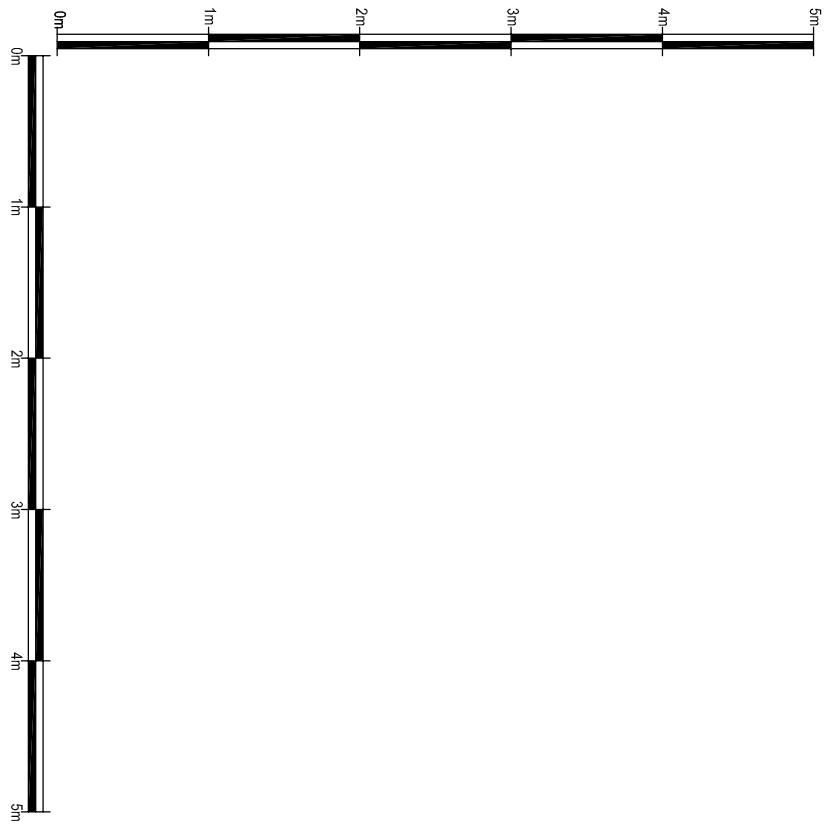

<p>GENERAL NOTES: 1) All dimensions in millimeters unless otherwise stated.</p>			
Date:	Comments:	By:	
<p>Site: METRO NEWS 143 Kings Cross Road London WC1Z 9BN</p>			
<p>Drawing Title: As Installed Elevations and Plans</p>			
Ref:	Date:	Rev:	
NMA-08-2017-10-2	10-08-2017		
Scale:	Paper:	Date Rev:	
1:50	A3		