



**Notes:**  
This drawing is protected by copyright. No part of this document may be reproduced, altered, or transmitted in any form or by any means without permission.  
Do not scale off these drawings for construction purposes. If any discrepancies are found, please contact Proctor Watts Cole Rutter.

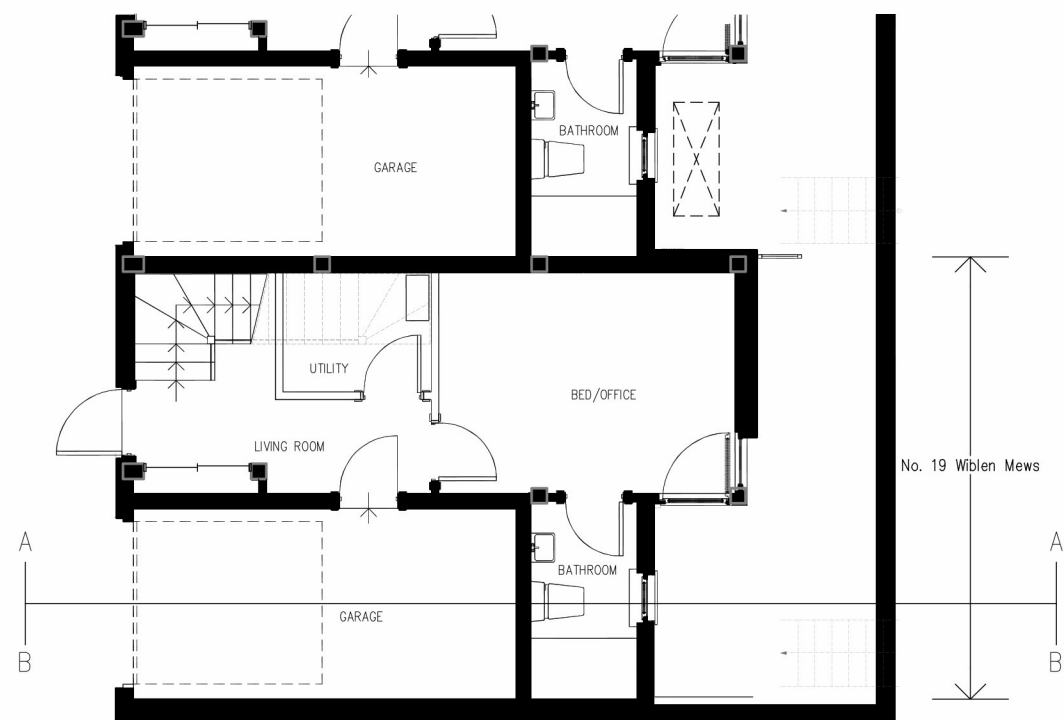

Lower Ground Floor Plan  
Scale 1:100




Ground Floor Plan  
Scale 1:100

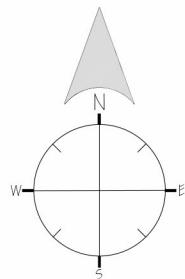


Rev.	Description:	By	Date
-	-	-	-
Client: Four Quarters Construction		Drawn By:	JP
Title: As Built Lower and Ground Floor Plans		Checked By:	-
Project: 19 Wiblin Mews, College Lane, Kentish Town, London		Scale: 1:100@A3	Date: 24 July 2017
Job No: 4672	Dwg No: S01	Revision:	-

**Proctor Watts Cole Rutter**  
Chartered Architects & Town Planners  
Grosvenor House, Bleke Street, Shaftesbury, Dorset, SP7 8AW.  
Phone: 01747 851881 Fax: 01747 851081  
mail@pwcr.co.uk www.pwcr.co.uk



Notes:  
This drawing is protected by copyright. No part of this document may be reproduced, altered, or transmitted in any form or by any means without permission.  
Do not scale off these drawings for construction purposes. If any discrepancies are found, please contact Proctor Watts Cole Rutter.

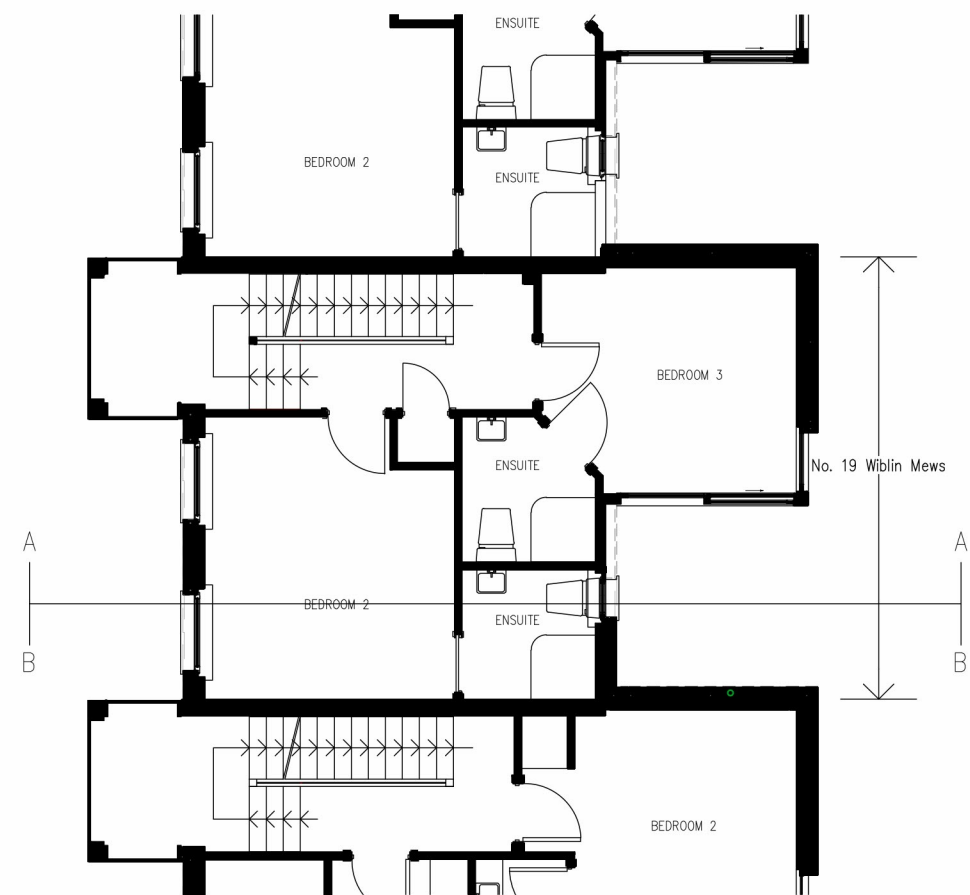

First Floor Plan  
Scale 1:100

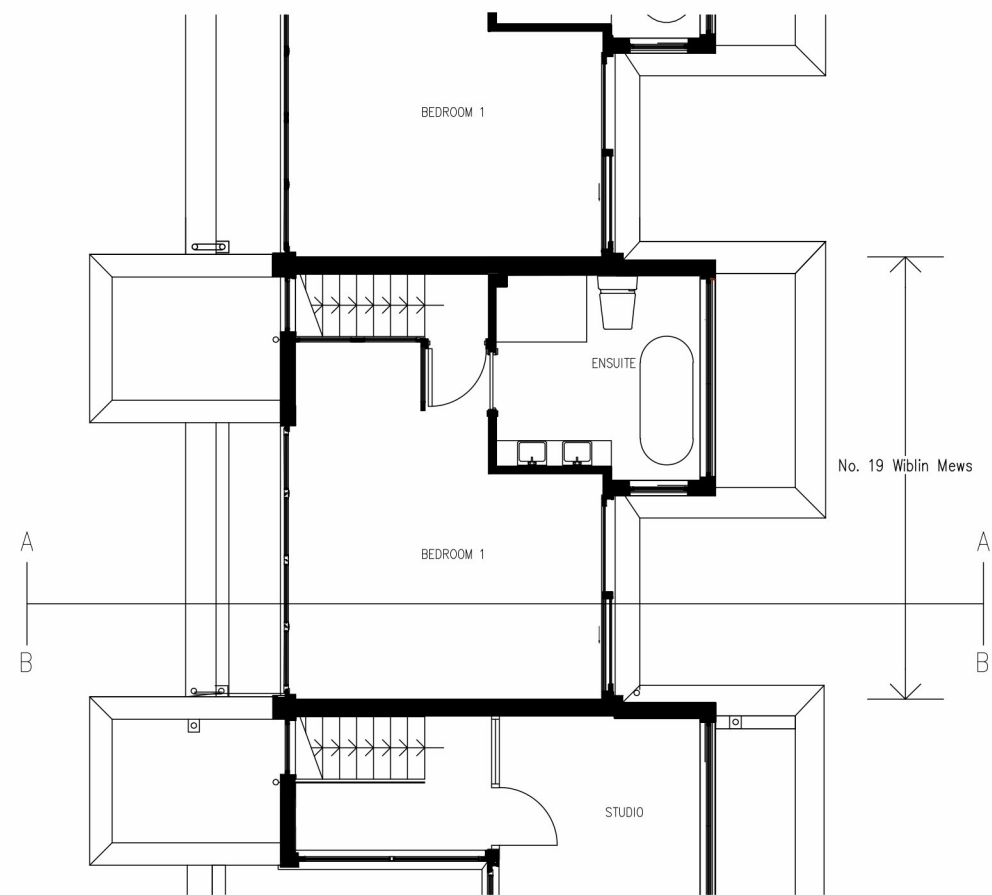

Second Floor Plan  
Scale 1:100

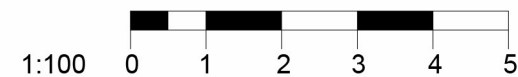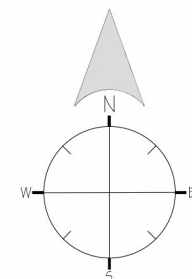

Rev.	Description:	By	Date
-	-	-	-
Client: Four Quarters Construction		Drawn By:	JP
Title: As Built Lower and Ground Floor Plans		Checked By:	-
Project: 19 Wiblin Mews, College Lane, Kentish Town, London		Scale: 1:100@A3	Date: 24 July 2017
Job No: 4672	Dwg No: S02	Revision:	-

Notes:  
This drawing is protected by copyright. No part of this document may be reproduced, altered, or transmitted in any form or by any means without permission.  
Do not scale off these drawings for construction purposes. If any discrepancies are found, please contact Proctor Watts Cole Rutter.




Section A-A  
Scale 1:100




Section B-B  
Scale 1:100



-	-	-	-
Rev.	Description:	By	Date
Client:	Four Quarters Construction	Drawn By:	JP
Title:	As Built Section	Checked By:	-
Project:	19 Wiblin Mews, College Lane, Kentish Town, London	Scale:	1:100@A3
		Date:	24 July 2017
Job No:	4672	Dwg No:	S03
		Revision:	-
 <b>Proctor Watts Cole Rutter</b> Chartered Architects & Town Planners			
Grosvenor House, Bleke Street, Shaftesbury, Dorset, SP7 8AW. Phone: 01747 851881 Fax: 01747 851081 mail@pwcr.co.uk www.pwcr.co.uk			

Notes:  
This drawing is protected by copyright. No part of this document may be reproduced, altered, or transmitted in any form or by any means without permission.  
Do not scale off these drawings for construction purposes. If any discrepancies are found, please contact Proctor Watts Cole Rutter.

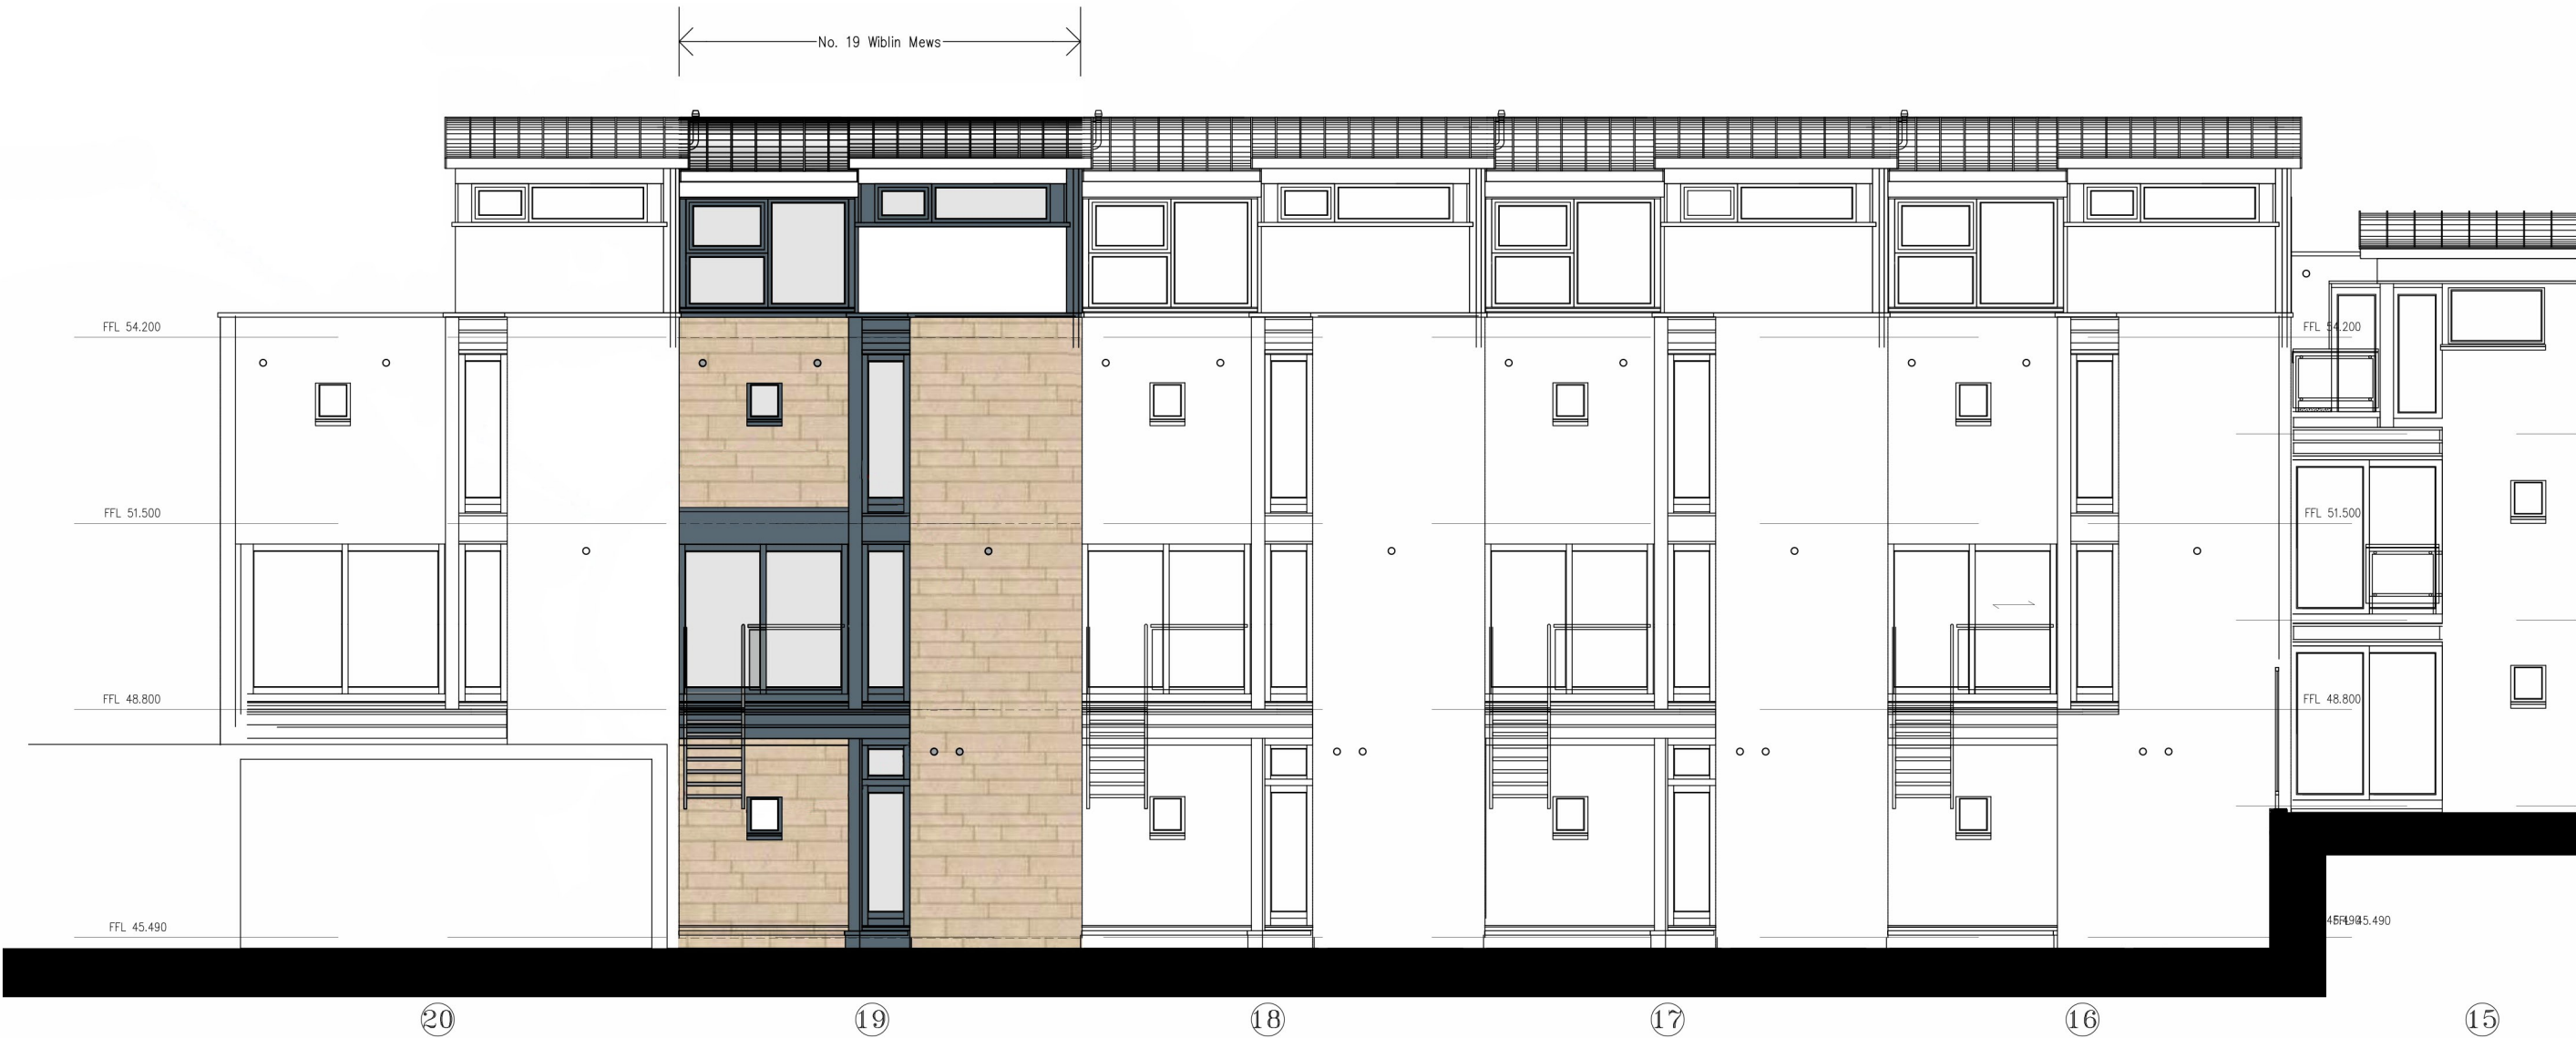


South East Elevation  
Scale 1:100




-	-	-	-
Rev.	Description:	By	Date
	Client: Four Quarters Construction	Drawn By:	JP
	Title: As Built Elevation	Checked By:	-
	Project: 19 Wiblin Mews, College Lane, Kentish Town, London	Scale:	1:100@A3
		Date:	24 July 2017
Job No:	4672	Dwg No:	S04
		Revision:	-

**Notes:**  
This drawing is protected by copyright. No part of this document may be reproduced, altered, or transmitted in any form or by any means without permission.  
Do not scale off these drawings for construction purposes. If any discrepancies are found, please contact Proctor Watts Cole Rutter.

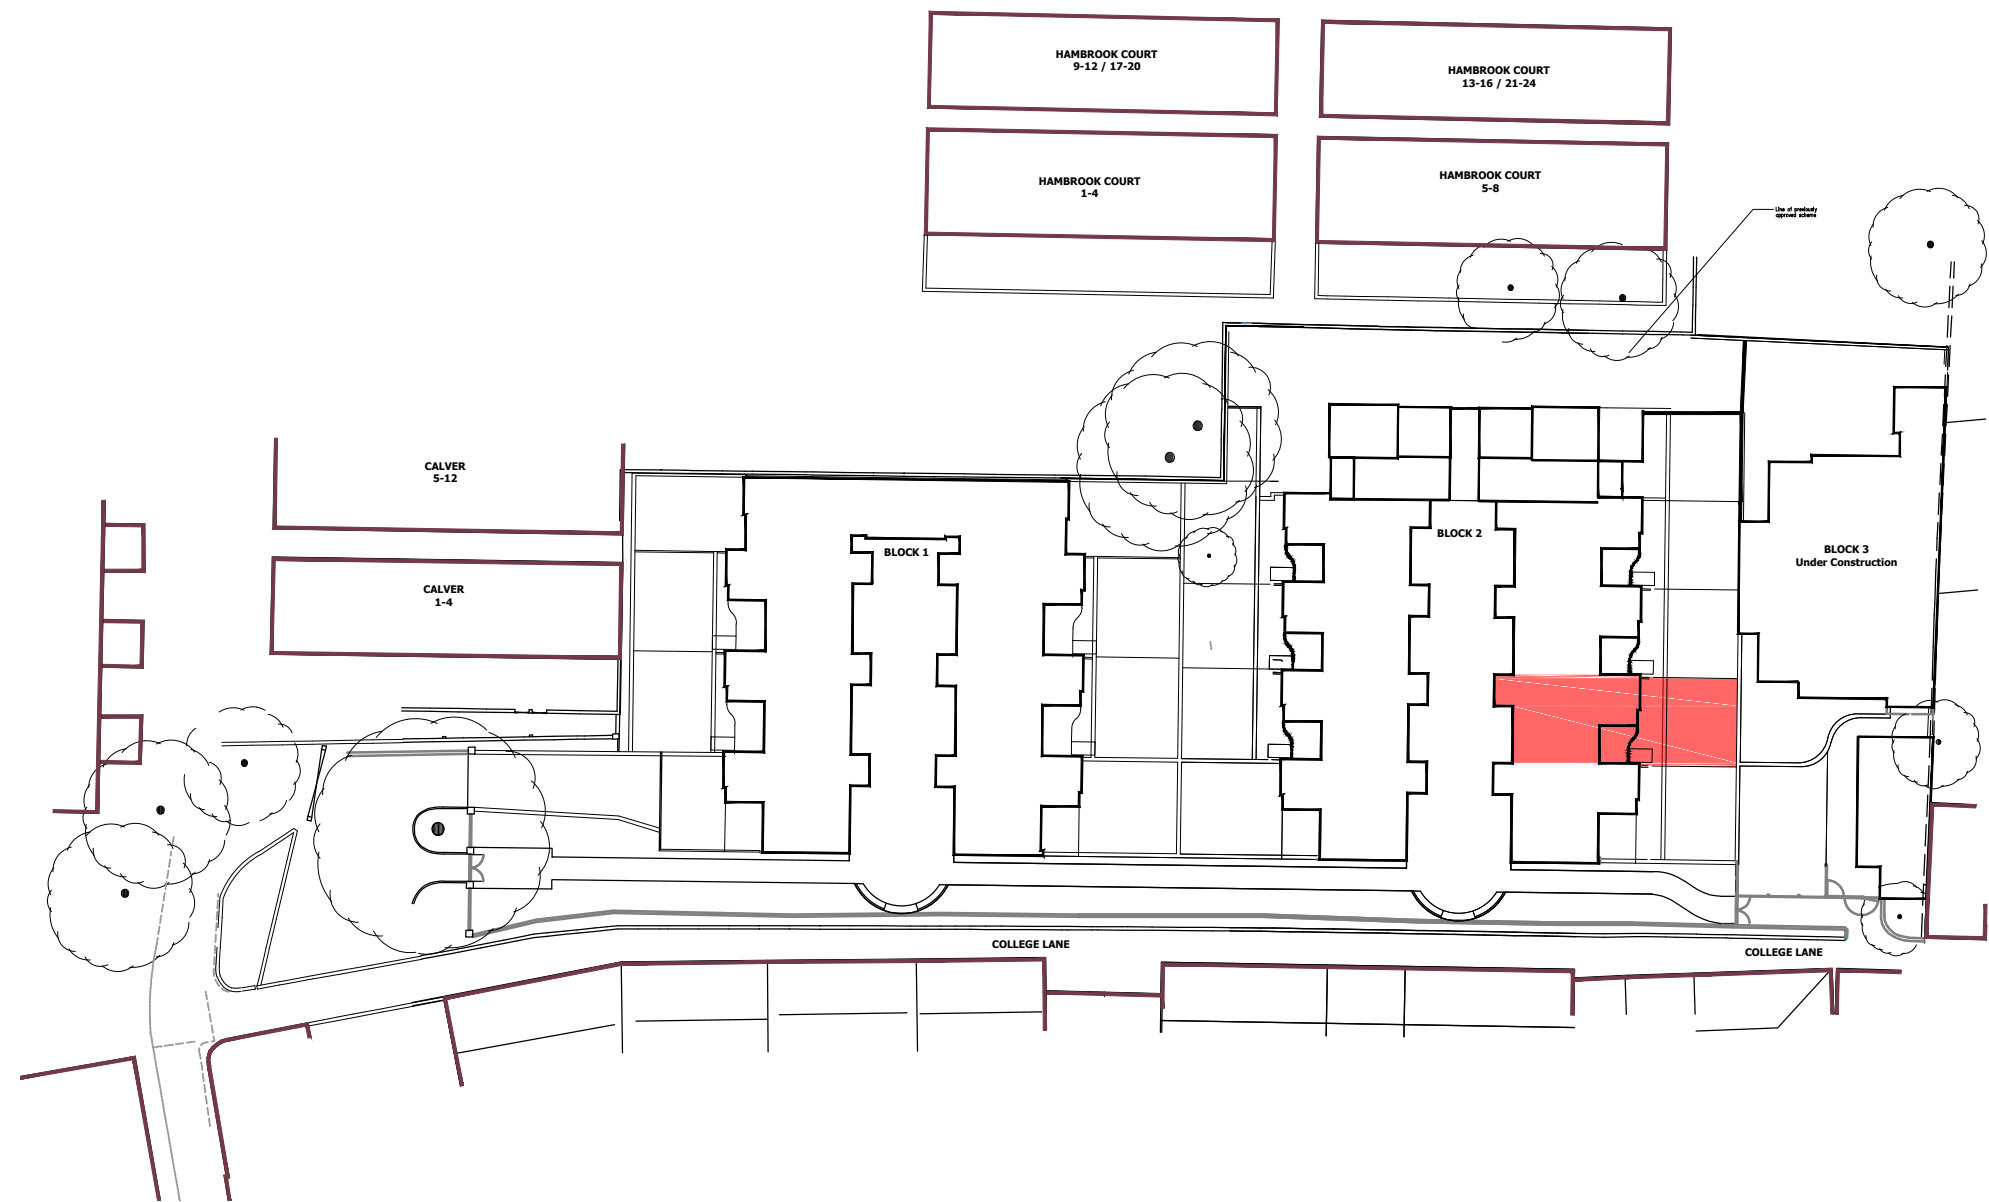

Site Plan  
Scale 1:500

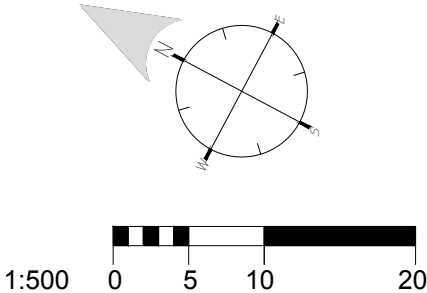

-	-	-	-
Rev.	Description:	By	Date
Client: Four Quarters Construction		Drawn By:	JP
Title: Site Plan		Checked By:	-
Project: New Dwellings At Elm Cottage, East Knoyle		Scale:	1:500@A3
		Date:	24 July 2017
Job No:	Dwg No:	Revision:	
4672	S05	-	

**Proctor Watts Cole Rutter**  
Chartered Architects & Town Planners

Grosvenor House, Bleke Street, Shaftesbury, Dorset, SP7 8AW.  
Phone: 01747 851881 Fax: 01747 851081  
mail@pwcr.co.uk www.pwcr.co.uk