


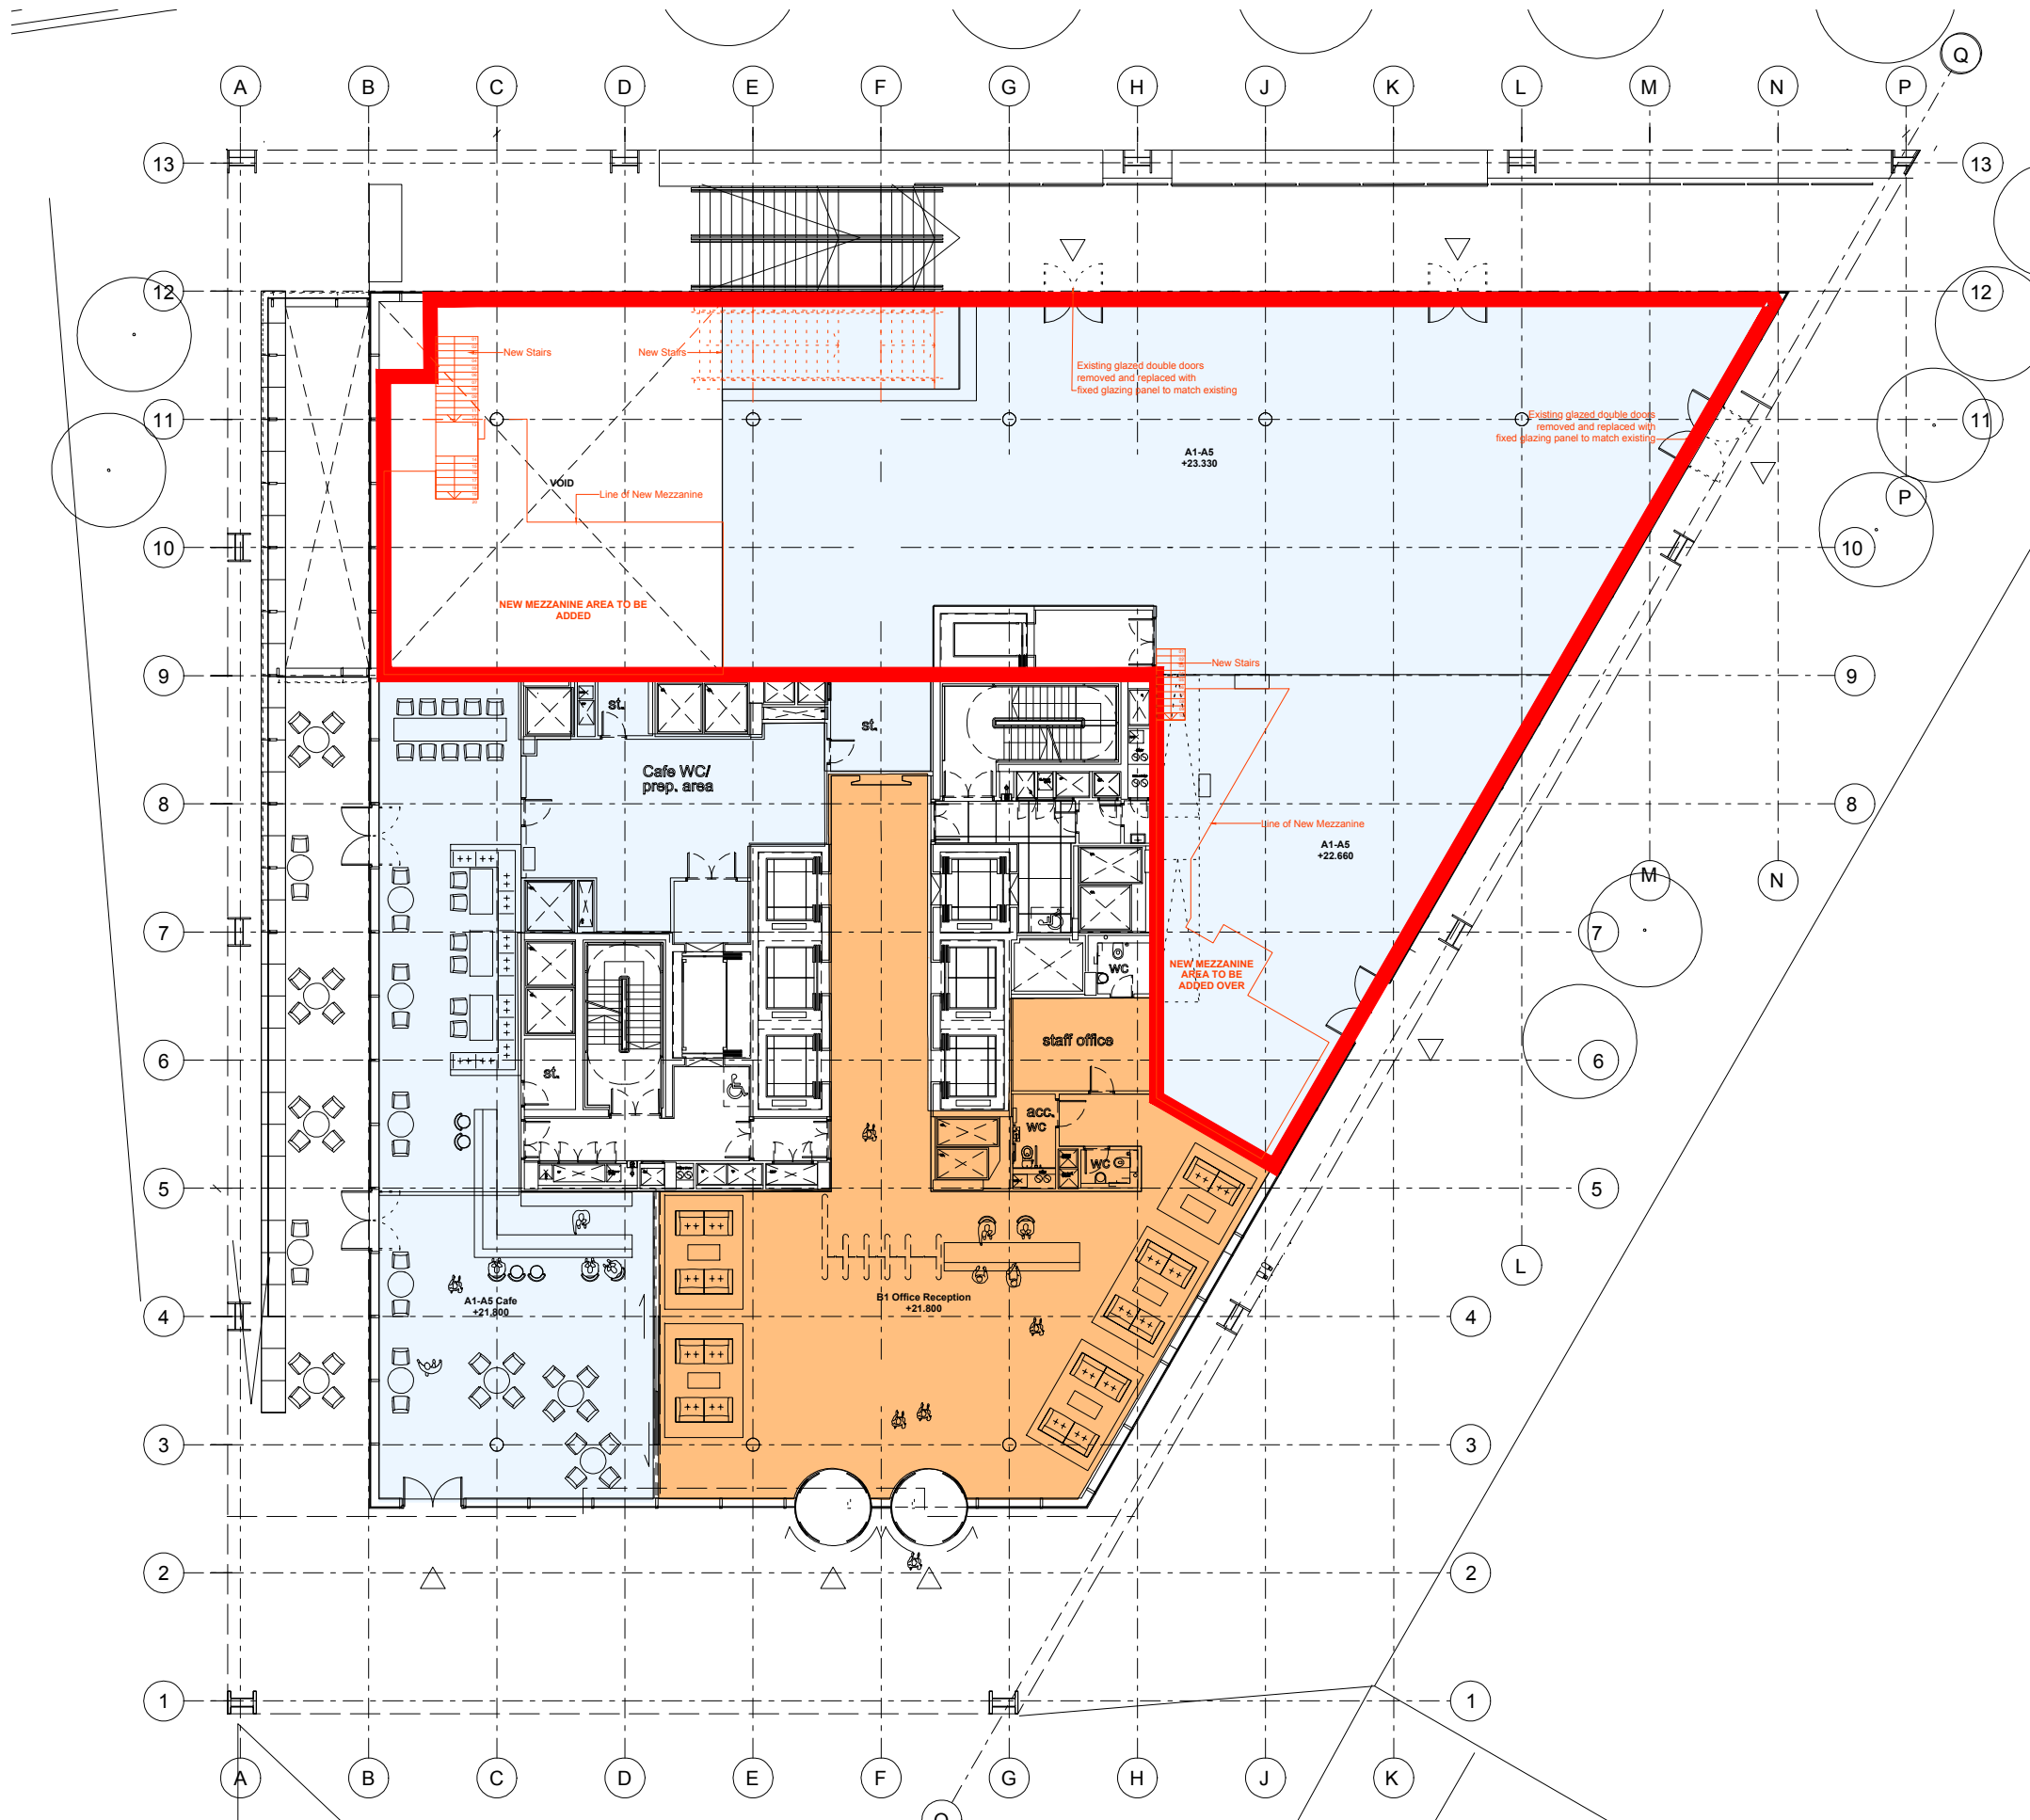

REVISION	DATE	BY	DESCRIPTION
A	26.07.2017	TB	RED LINE AND SCALE BAR ADDED
B	14.08.2017	TB	MINOR AMENDMENT
C	22.08.2017	TB	AMENDED TO ALIGN WITH ORIGINAL PLANNING DRAWINGS
D	31.08.2017	TB	MINOR AMENDMENT

REFERENCE FILES

NOTES


LEGEND

1:250 @ A3




FOR INFORMATION

key plan

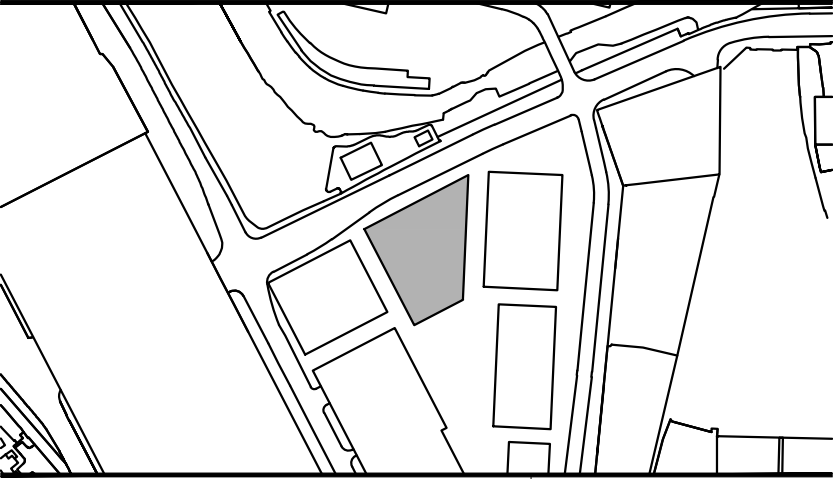

4 PANCRAS
SQUARE
PLANNING

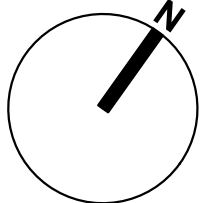

dga architects David Gallagher Associates LLP
Second Floor, Hall House
9 Graphite Square, Vauxhall Walk
London SE11 5EE
Telephone 0207 834 9474
info@dga-architects.co.uk
www.dga-architects.co.uk

CLIENT	ARGENT
PROJECT	4 PANCRAS SQUARE BASE BUILD ALTERATIONS
DRAWING	EXISTING GROUND FLOOR PLAN

JOB NO.	DRAWING NO.	REVISION	DATE DRAWN	DRAWN BY	SCALE
1718	PL_011	D	04.07.2017	TB	1:250@A3

1718-PL_011_D

1:250@A3 EXISTING GROUND FLOOR PLAN