

notes:
Do not scale from this drawing

All dimensions to be checked on site and any discrepancies reported to the Architect/Contract Administrator before proceeding with the works on site, or off-site fabrication

Subject to site survey and inspection




LOCATION PLAN 1:1250




BLOCK PLAN 1:500

AS INSTALLED A/C UNITS

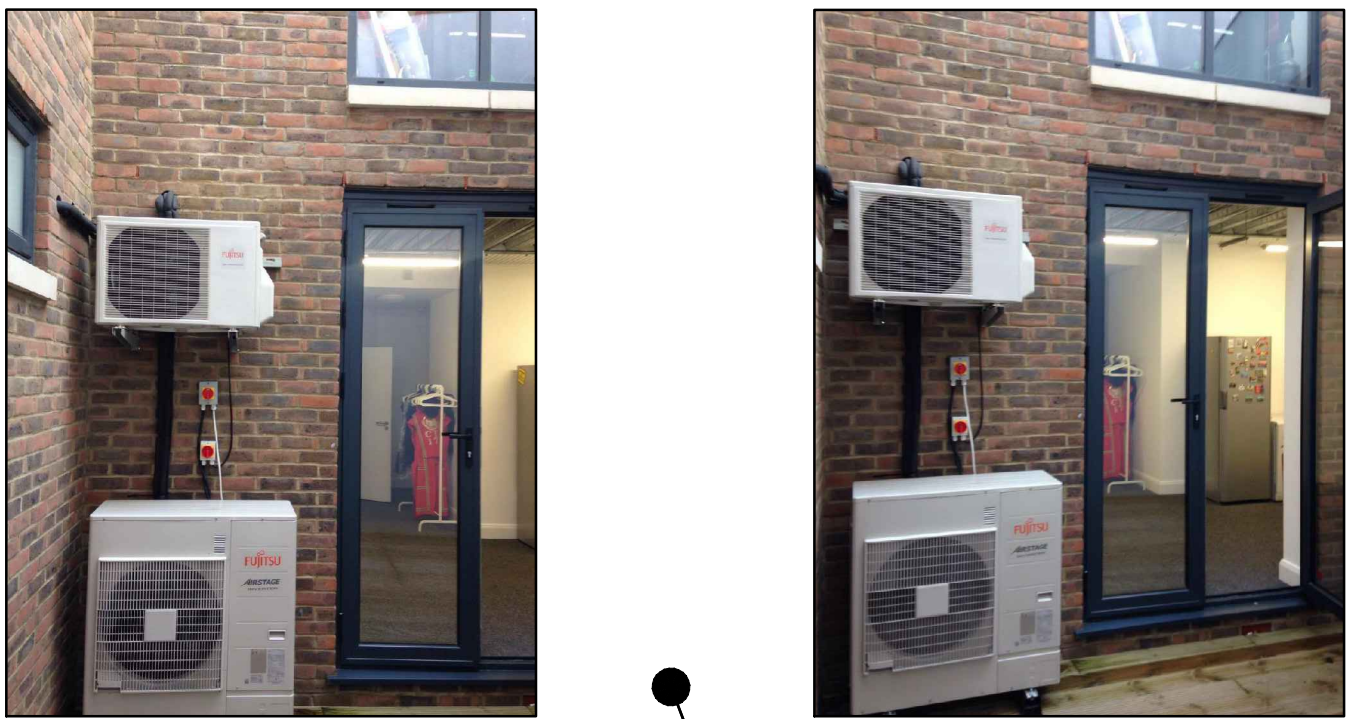

5 to 7 Brecon Mews

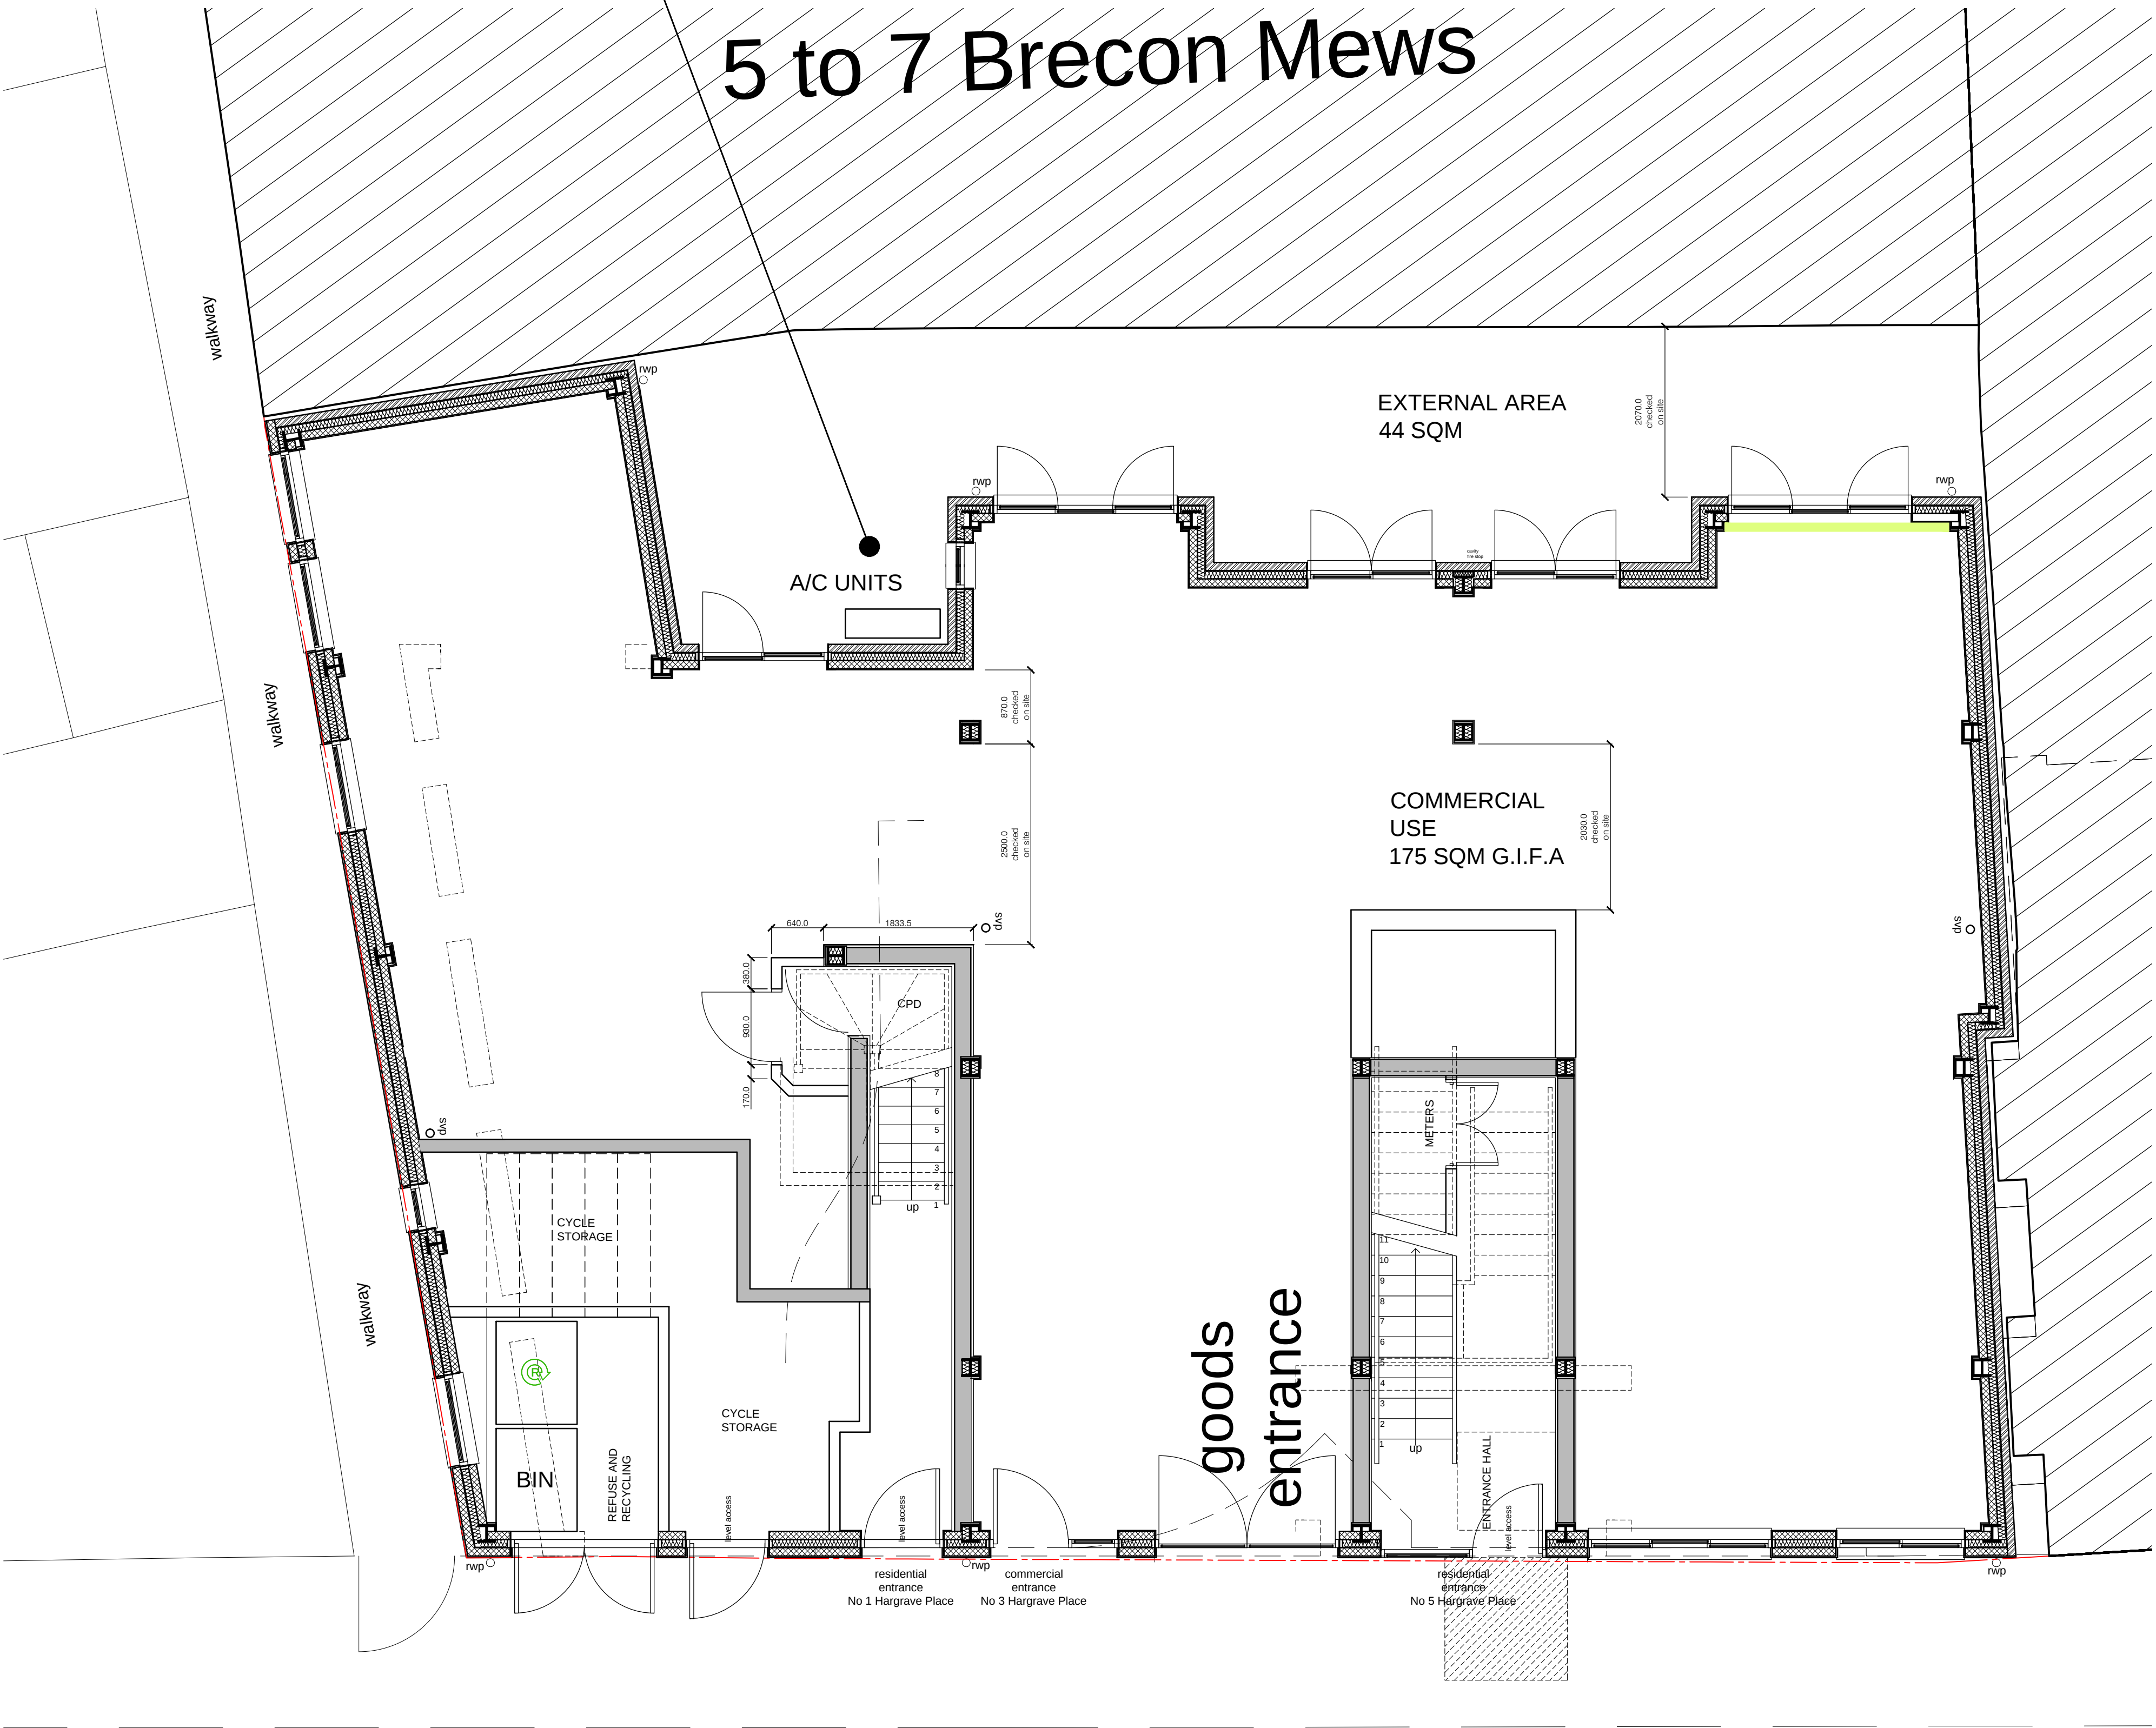

GROUND FLOOR PLAN 1:50

For Approval			
revision	description	date	
ga ltd GENESIS ARCHITECTS LTD 7 St Margarets Road, Stanstead Abbots Ware Hertfordshire SG12 8BP T : 01920 877998 F : 01920 877998 E: genesisarchitects@btconnect.com W: www.genesisarchitects.ltd.uk			
client	Hargrave Developments Ltd		
project	PROPOSED GF A/C UNITS 3 HARGRAVE PLACE LONDON N7 0BP		
title	PROPOSED SITE PLANS GROUND FLOOR PLAN		
date	SEPT 17	scale	AS SHOWN
drawn	IRMB		
drawing no	GAL 200 (PC) 200 /		