

double glazed aluminium framed window



double glazed aluminium framed window

extended chimney

double glazed aluminium framed window

double glazed aluminium framed window

01 AS-BUILT ROOF PLAN  
scale 1:50

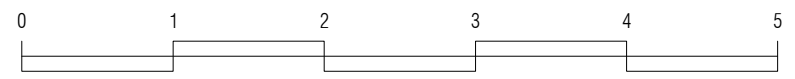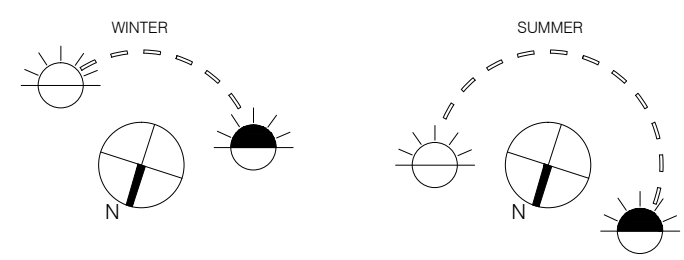

**AS-BUILT**


project  
85 JAMESTOWN ROAD  
NW1 7DB

drawing  
AS-BUILT TOP FLOOR PLAN



number 348-113-B date 24.07.2017  
scale 1:50@A3 revision

**BRIAN O'REILLY ARCHITECTS**

31 Oval Road LONDON NW1 7EA  
Tel: +44 (0)20 7267 1184  
www.brianoreillyarchitects.com  
mail@brianoreillyarchitects.com

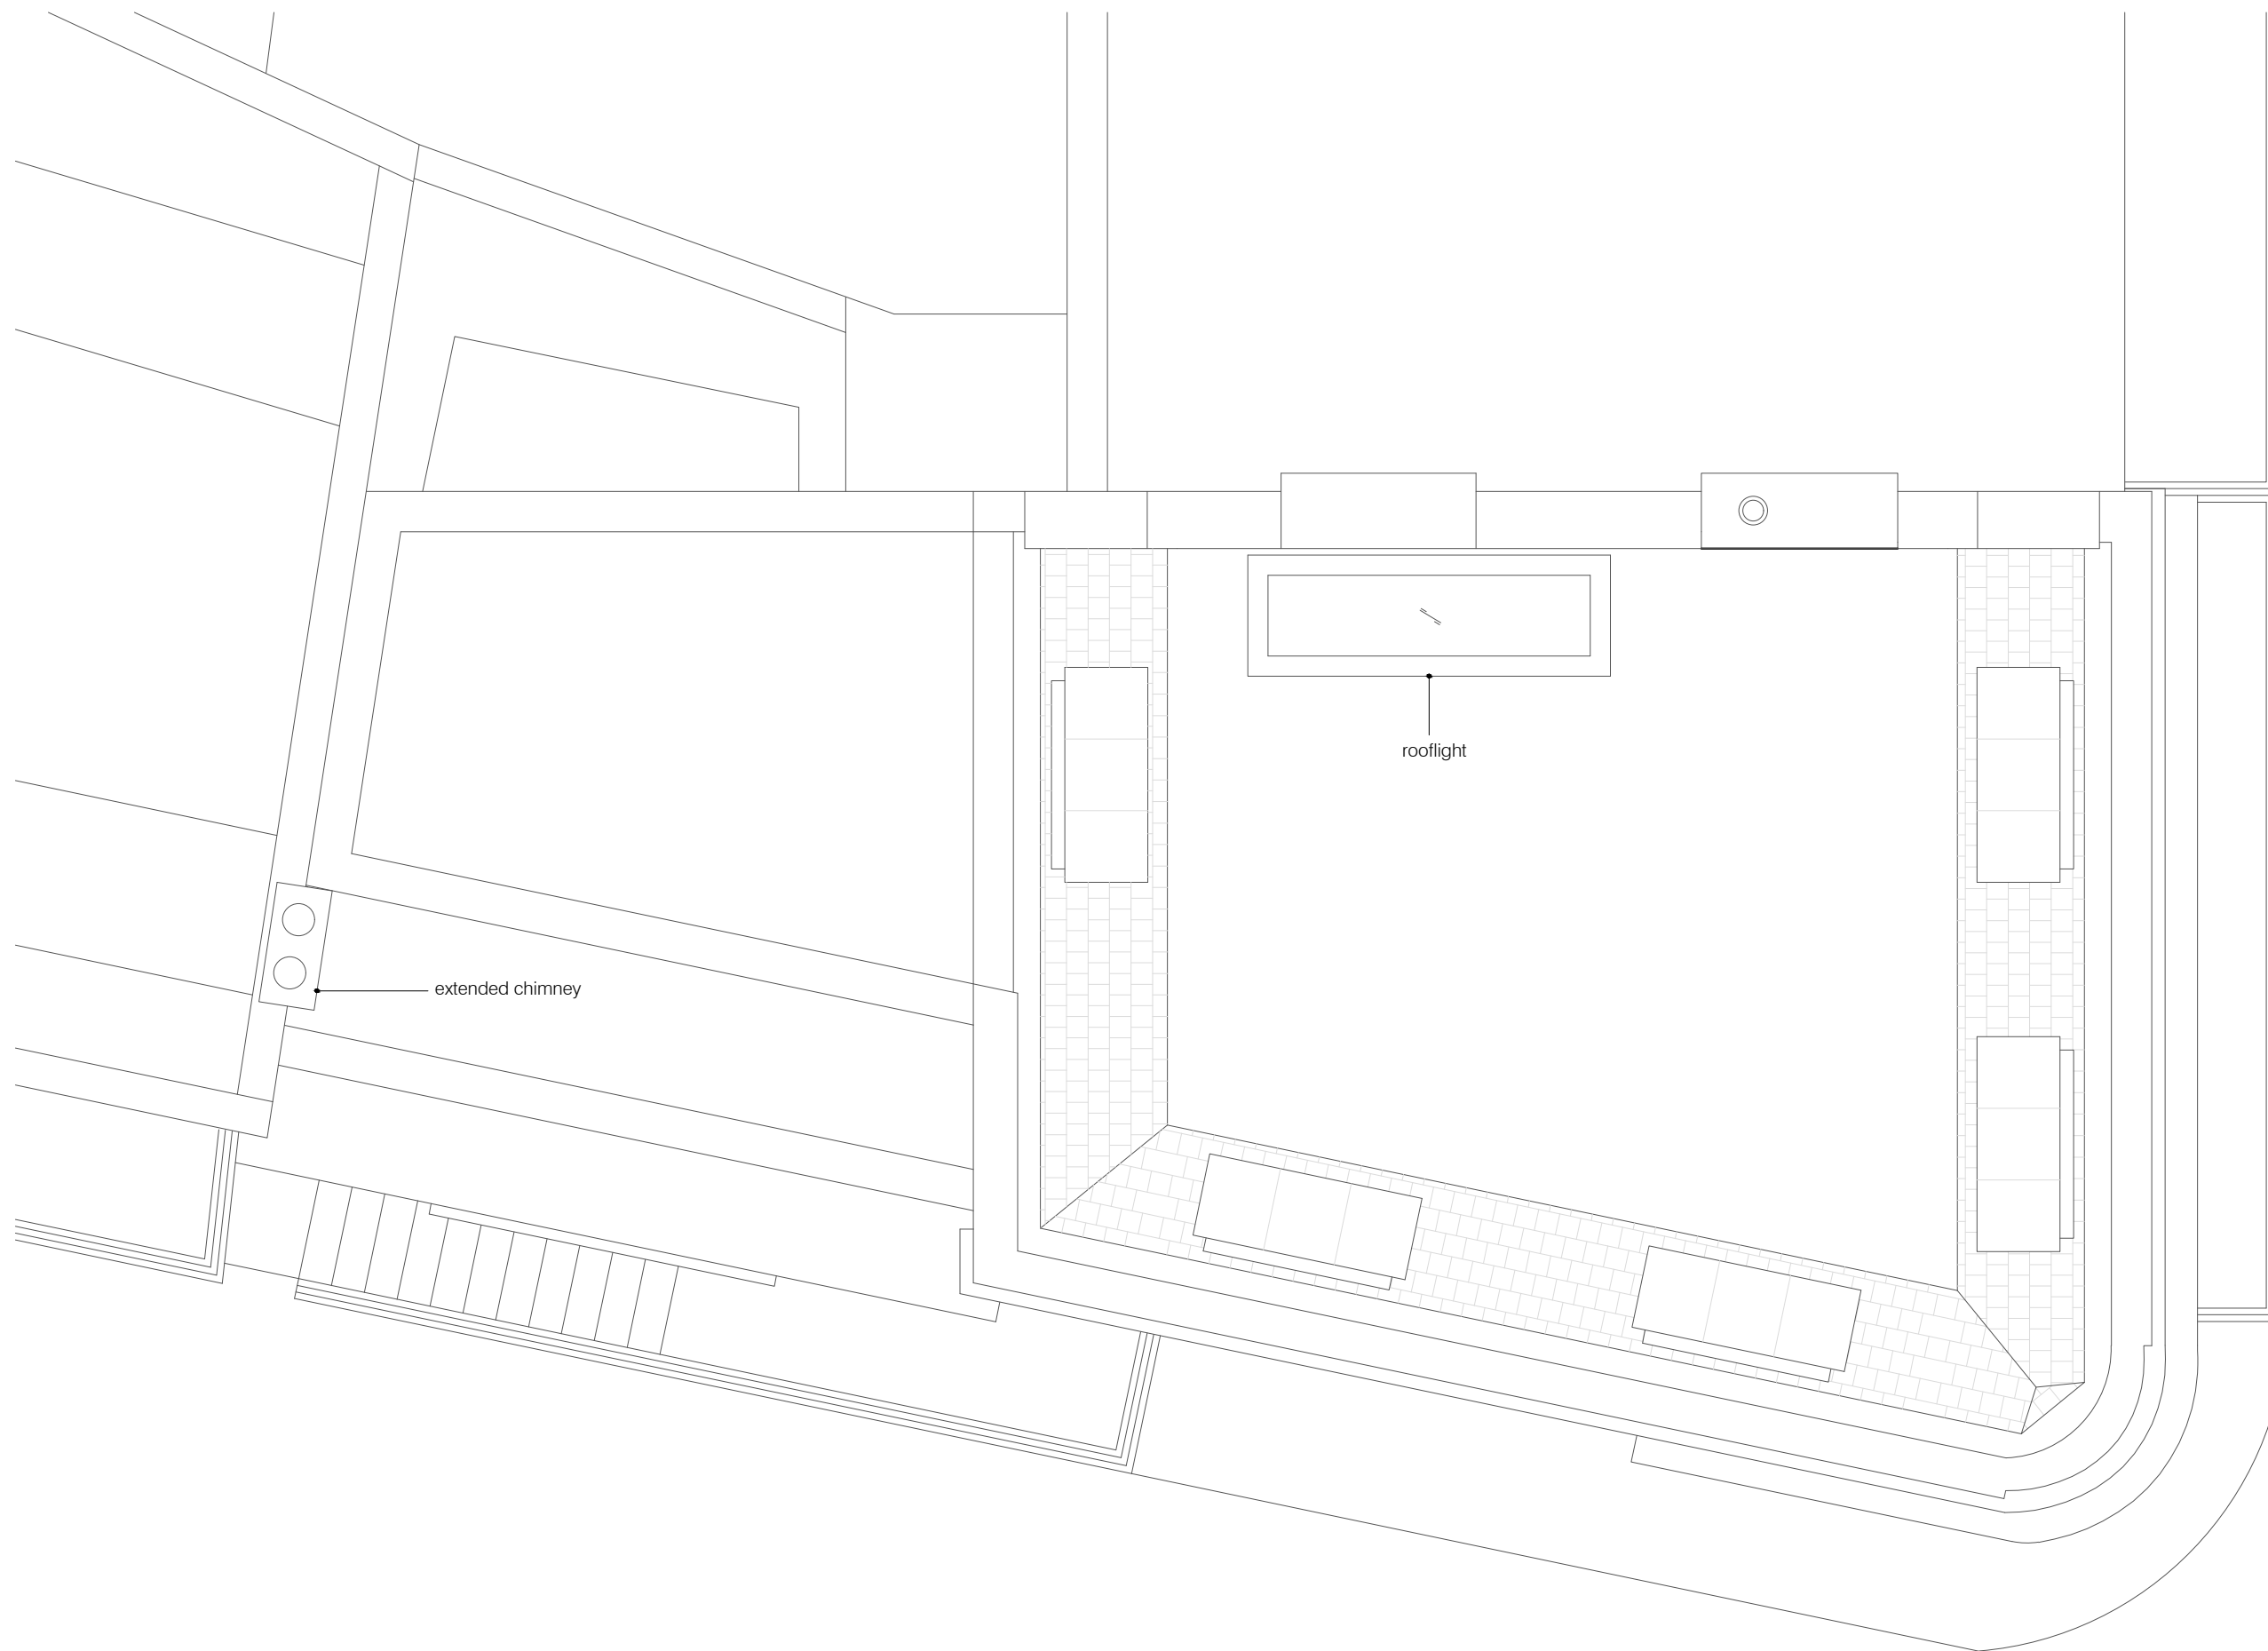

01 AS-BUILT ROOF PLAN  
scale 1:50

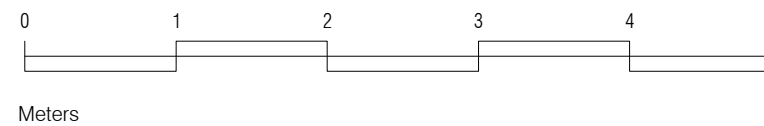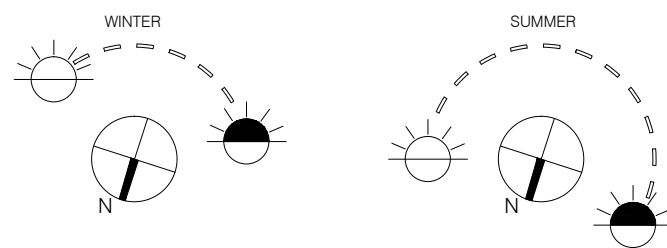

**AS-BUILT**

project  
85 JAMESTOWN ROAD  
NW1 7DB

drawing  
AS-BUILT ROOF PLAN

number	date
348-114-B	24.07.2017
scale	revision
1:50@A3	

**BRIAN O'REILLY ARCHITECTS**

31 Oval Road LONDON NW1 7EA  
Tel: +44 (0)20 7267 1184  
www.brianoreillyarchitects.com  
mail@brianoreillyarchitects.com

83 JAMESTOWN ROAD

85 JAMESTOWN ROAD

OVAL ROAD

These plans are project and site specific and shall only be used for their intended purpose unless otherwise permitted by written consent of Brian O'Reilly Architects.  
Do NOT scale from these drawings.



extended chimney

double glazed aluminium framed window


double glazed aluminium framed window

JAMESTOWN ROAD

ENTRANCE TO FLATS

ENTRANCE TO COFFEE SHOP

01 AS-BUILT FRONT ELEVATION (FROM JAMESTOWN ROAD)  
scale 1:50

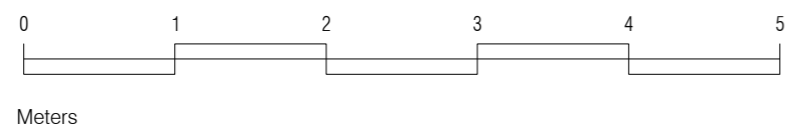

Meters

**AS-BUILT**  
 project  
 85 JAMESTOWN ROAD  
 NW1 7DB  
 drawing  
 AS-BUILT FRONT ELEVATION  
 (FROM JAMESTOWN ROAD)  
 number  
 348-207-B  
 scale  
 1:50@A2  
 date  
 24.07.2017  
 revision  
 1  
**BRIAN O'REILLY ARCHITECTS**  
 31 Oval Road LONDON NW1 7EA  
 Tel: +44 (0)20 7267 1184  
 www.brianoreillyarchitects.com  
 mail@brianoreillyarchitects.com

JAMESTOWN ROAD ——— 85 JAMESTOWN ROAD ——— 18 OVAL ROAD



01 AS-BUILT ELEVATION (FROM OVAL ROAD)  
scale 1:50

