


No 12

No 11

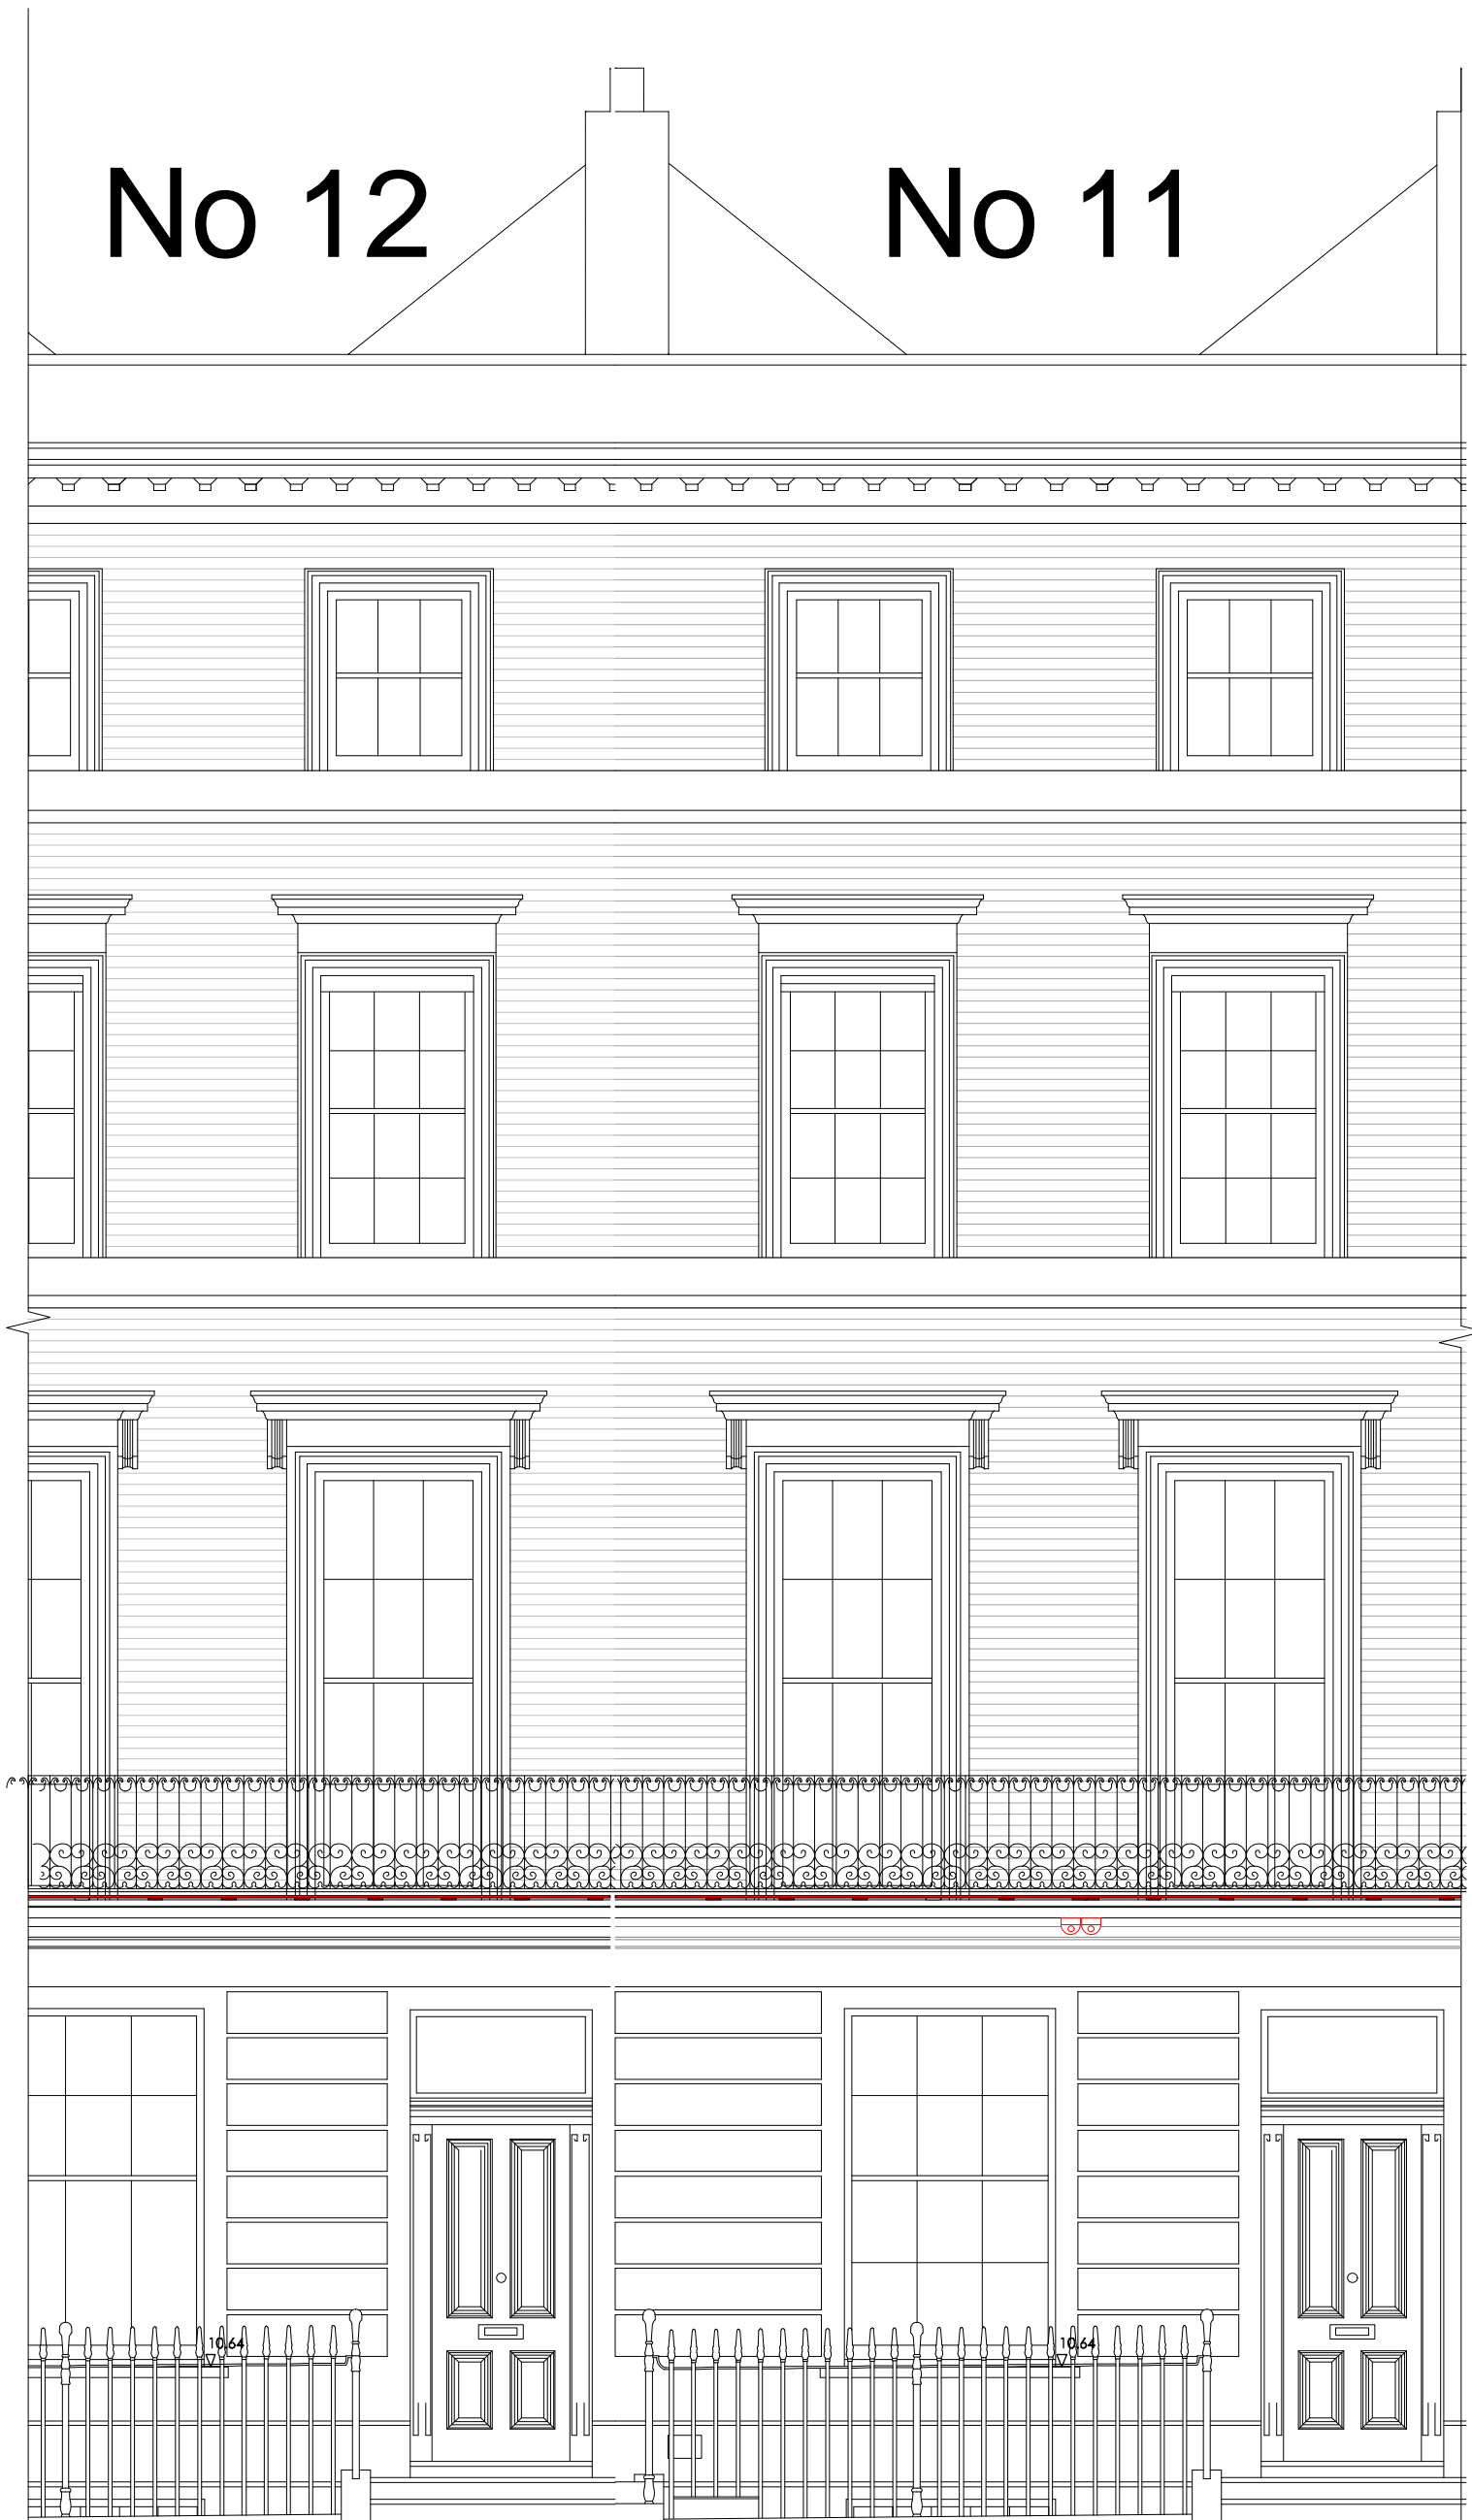

Rev. : a. Title description amended 13/09/2017  
 b. Amended to Planner's letter of 14Sep17 18/09/2017


**“Installation of 4x pairs of CCTV security cameras mounted on the underside of the balconies at Nos. 1 , 6, 11 and 17 Regents Park Terrace, connected by a black cable duct running along the top of the balcony terrace from Nos. 1 to 17”**

**ELEVATIONS**

**11 & 12 Regent's Park Terrace NW1**  
**Proposed CCTV installation indicated in RED**

Scale 1: 50 @ A3

**drwg No 1704 - 11**

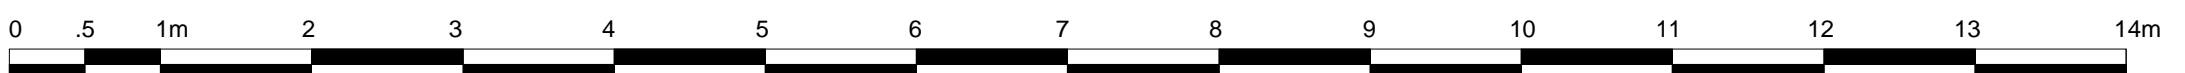

Paper Scale 1: 50 @ A3