
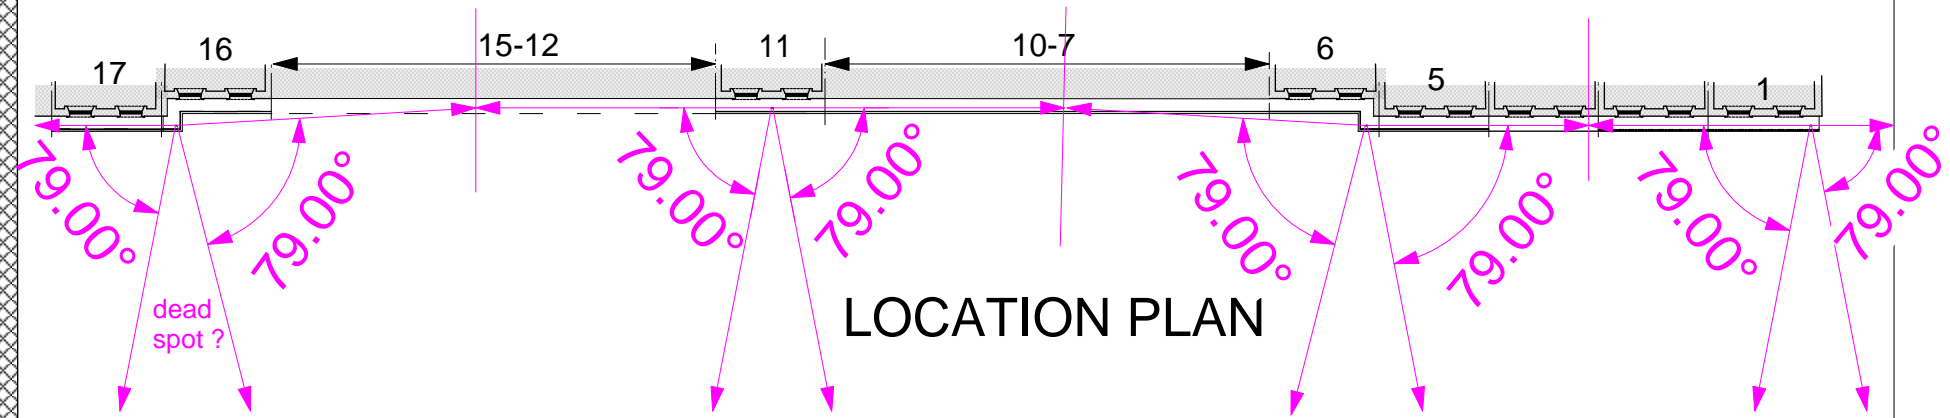


No 6 or 16 (reversed)

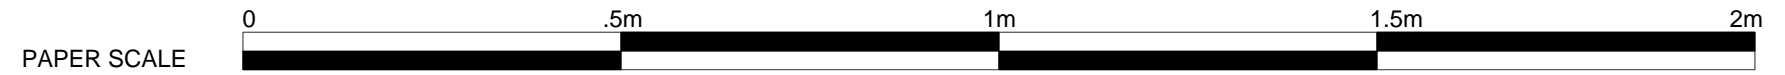


LOCATION PLAN

No 5 or 17 (reversed)

No 11 or No 1


CORNER BALCONY
DETAIL

cameras under

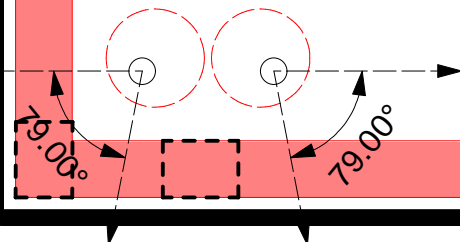

682

75x15 waterproof trunking
on 100x75x15 stools @ 400 c/c

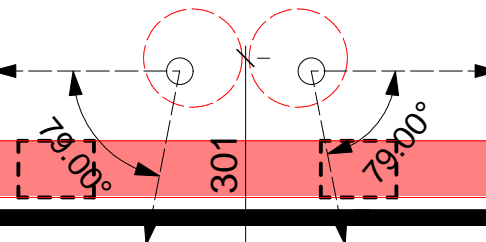

face of rendered wall below

balcony edge

Part Balcony Plan @ 1:10

“Installation of 4x pairs of CCTV security cameras mounted on the underside of the balconies at Nos.1 , 6, 11 and 17 Regents Park Terrace, connected by a black cable duct running along the top of the balcony terrace from Nos. 1 to 17”

1-17 REGENT'S PARK TERRACE NW1
Camera Location Details

Rev. : a. Title description amended 13/09/2017
b. Amended to Planner's letter of 14Sep17 18/09/2017

Proposed work shown in RED

Scale 1: 10 @ A3

drwg No 1704 -C- 04