



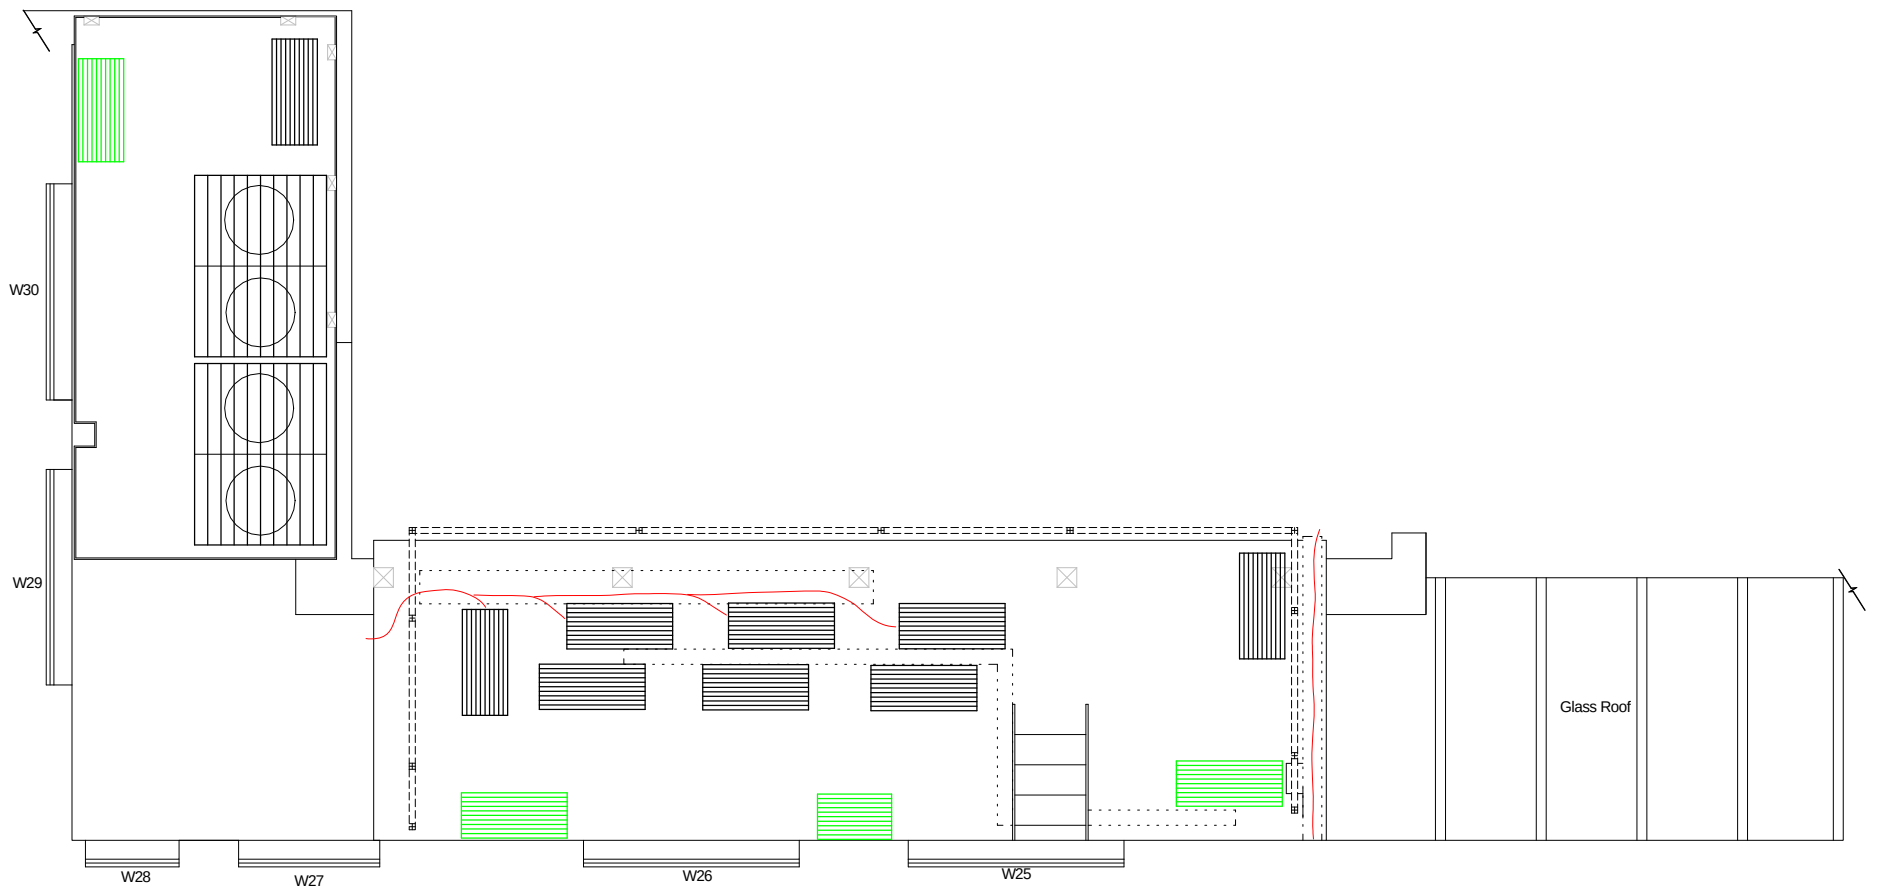


Existing External Platform Plan (First Floor Level)

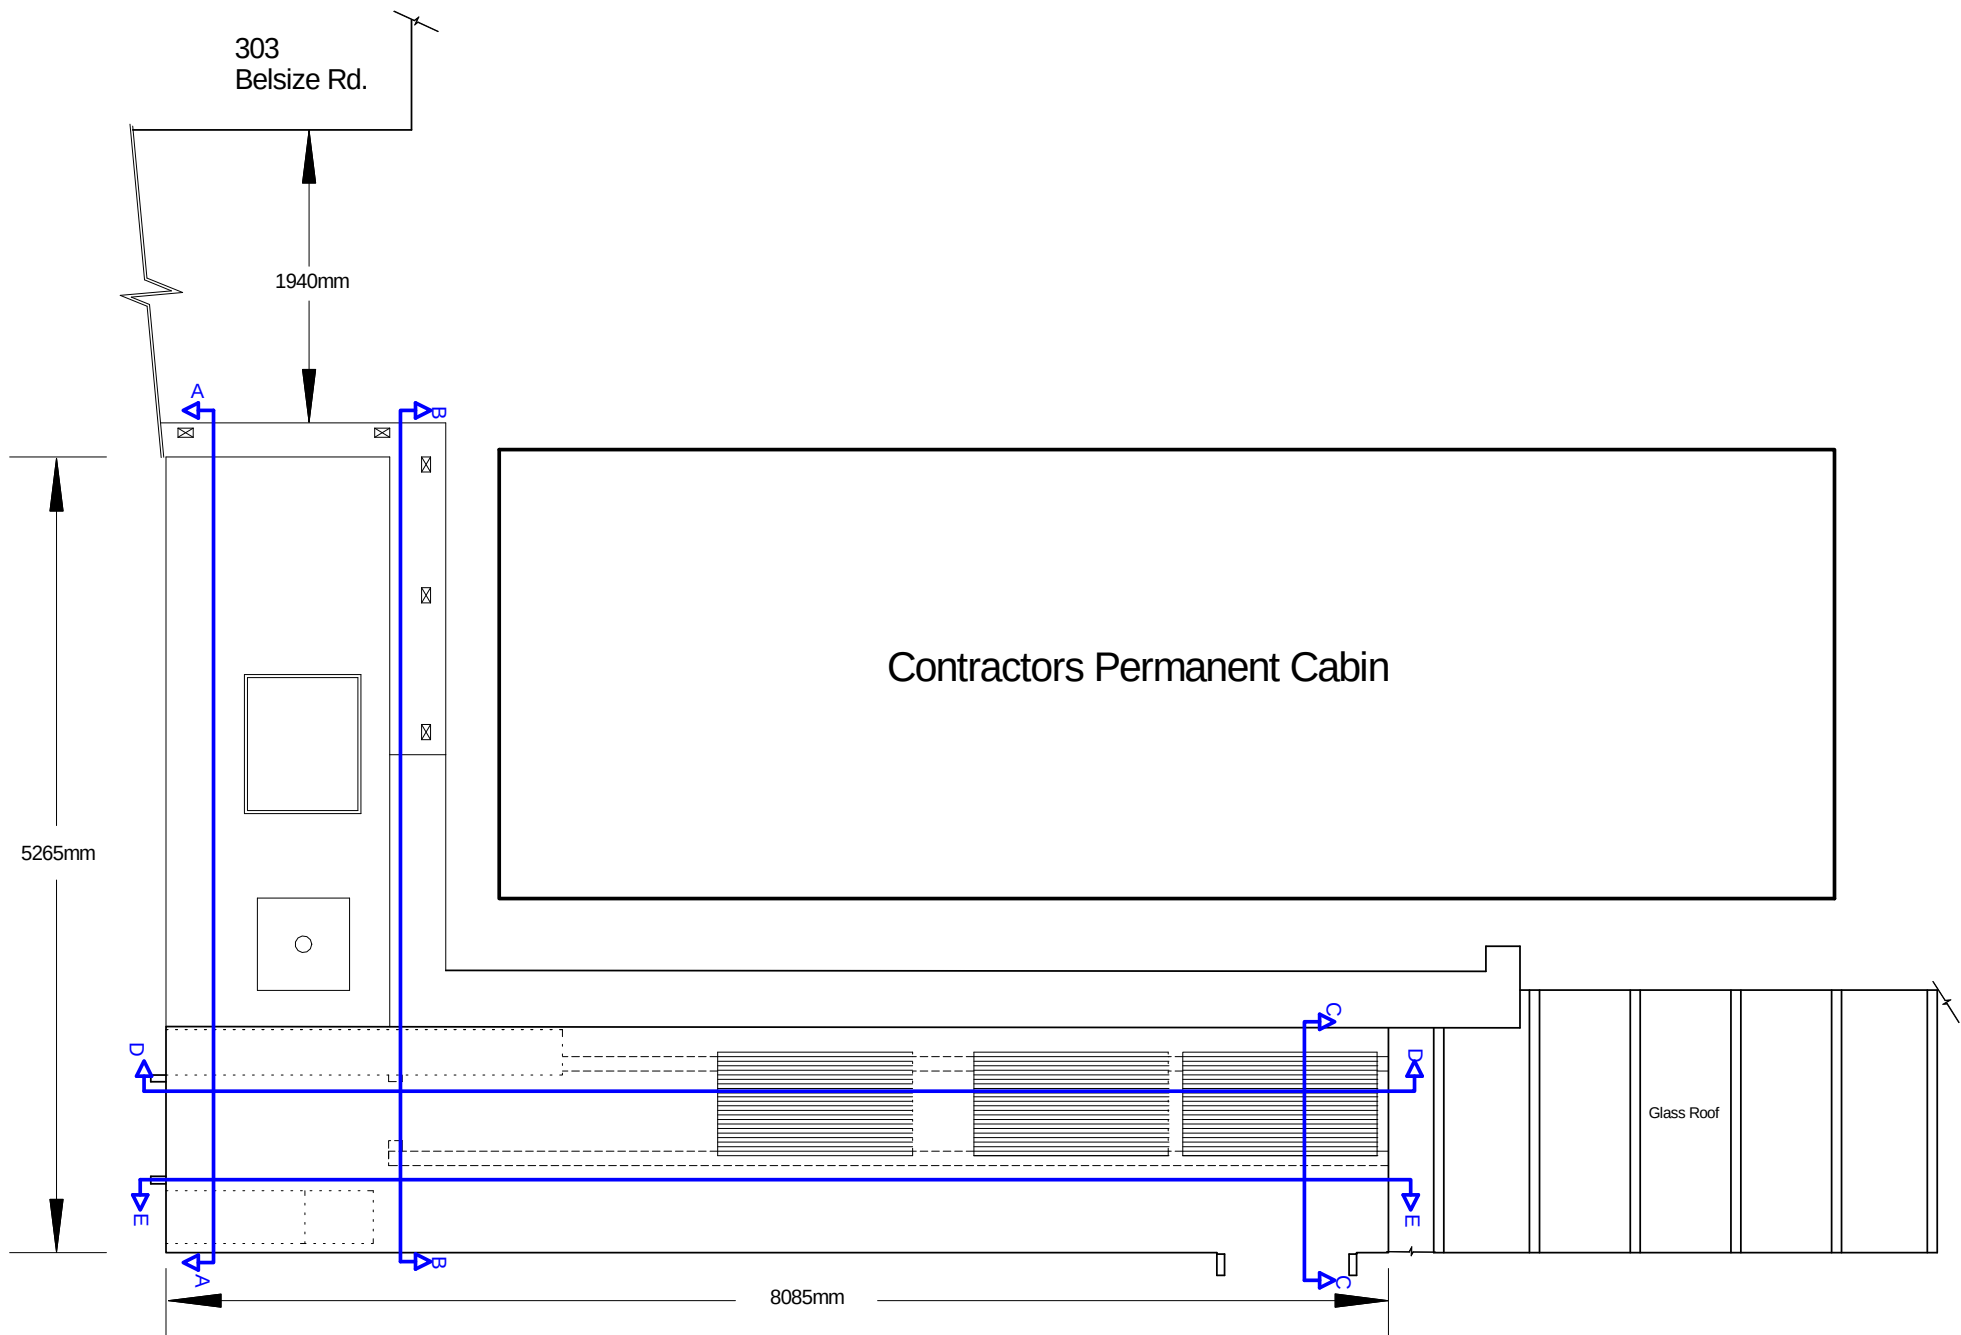


Existing External Platform Plan (Mezzanine Level)

KEY	
	= Ducting/Cable Trays
	= Ducting/Cable Trays
	= Stanchions/Railings
	= Platform Columns
	= Floor Mounted Units
	= Wall Mounted Units
	= Cable Runs

Note:-
Exact location of units at 1F are indicative only

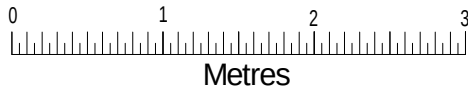


 chartered building surveyors Tel: 020 8905 7505 Fax: 020 8205 5374 Symal House, 423 Edgware Road, London, NW9 0HU	Client: Silverstone Properties Ltd.	Date: Sept. 2017	Scale: 1:50@ A3
	Location: 252 Omni House, Belsize Road, NW6 4BT	Dwg. No.: 17-035-03	
	Title: External Platform at Variable Levels - As Existing		

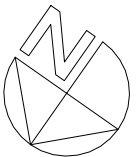

South Elevation

East Elevation


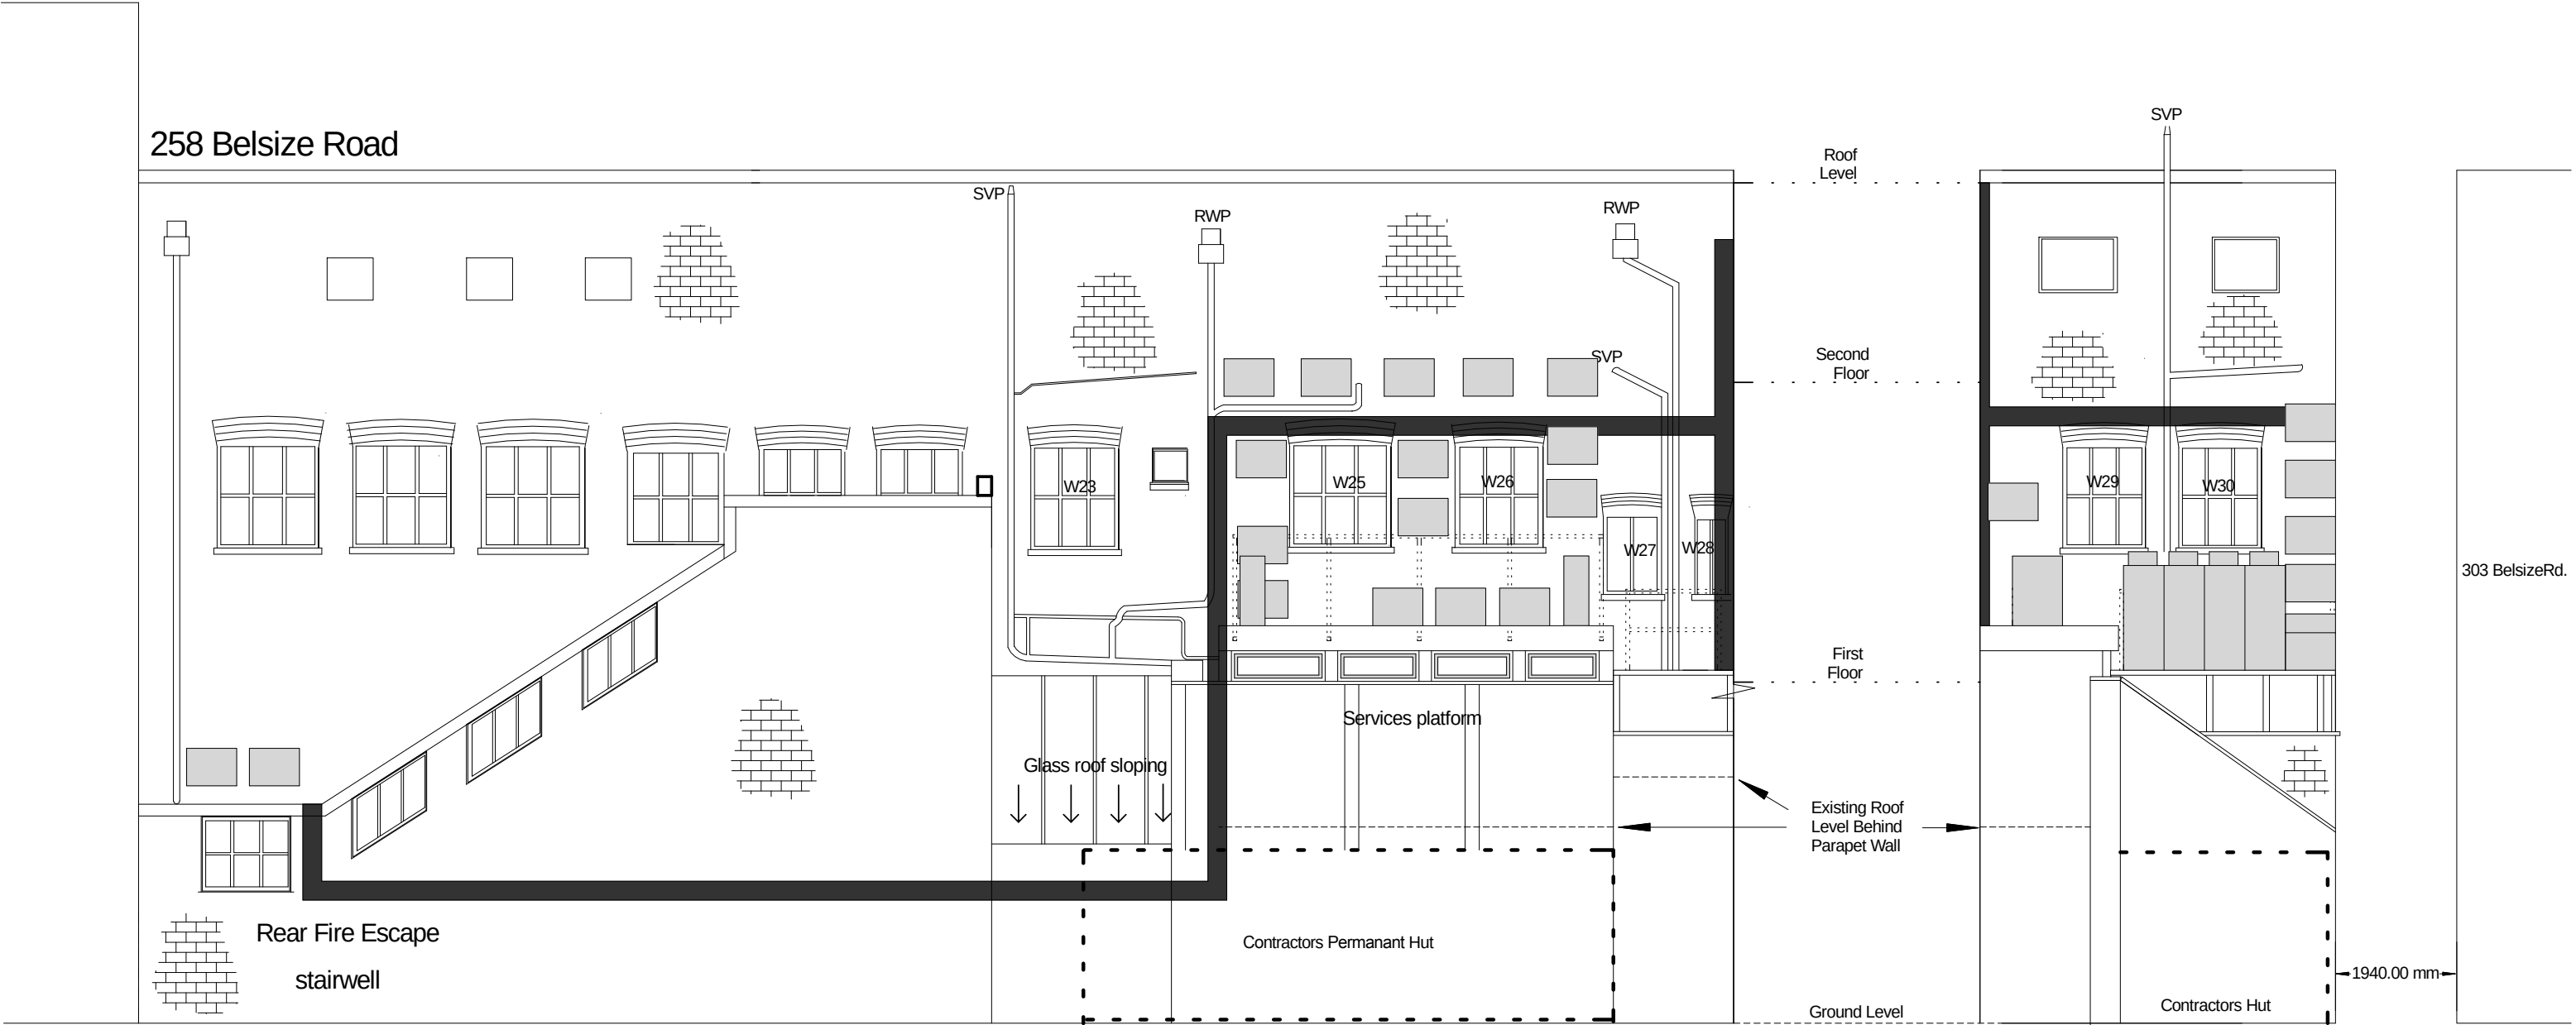


South and East Elevation - As Existing



Key

- Existing cable tray- Serving AC Units
- Existing AC Units

 chartered building surveyors Tel: 020 8905 7505 Fax: 020 8205 5374 Symal House, 423 Edgware Road, London, NW9 0HU		Client: Silverstone Properties Ltd.	Date: Sept. 2017	Scale: 1:100 @ A3
		Location: Omni House, 252 Belsize Road, NW6 4BT	Dwg. No.: 17-035-04	
		Title: South and East Elevation - As Existing		

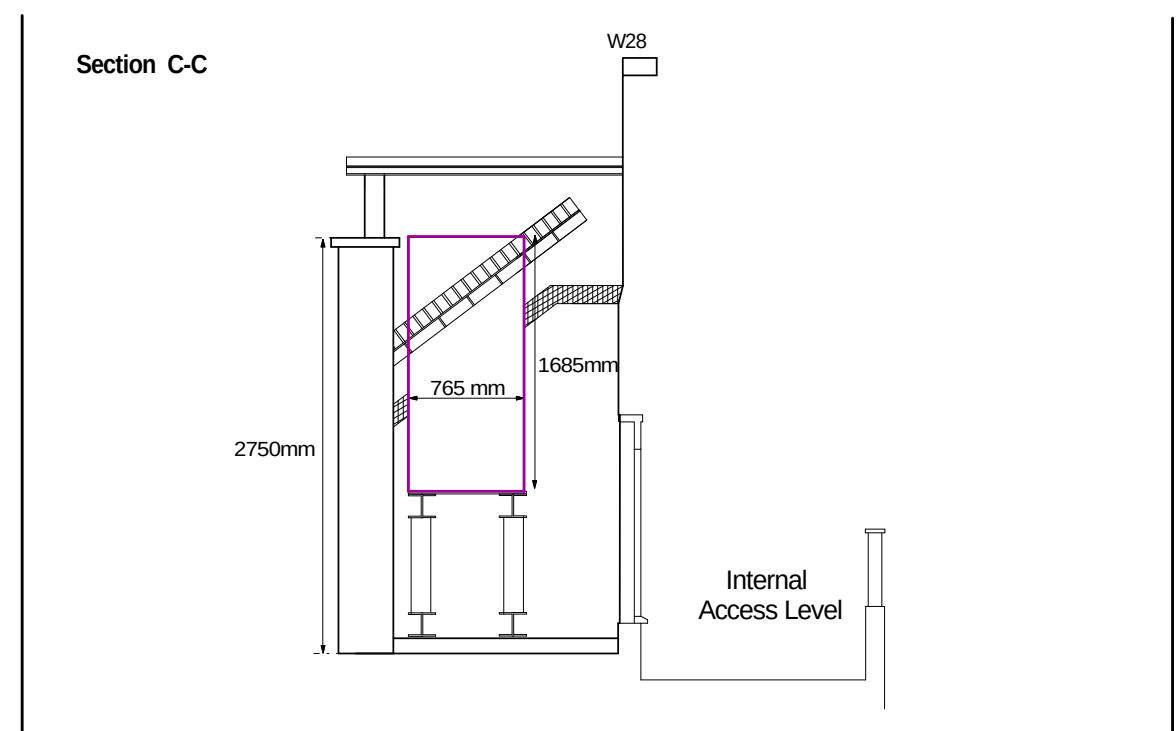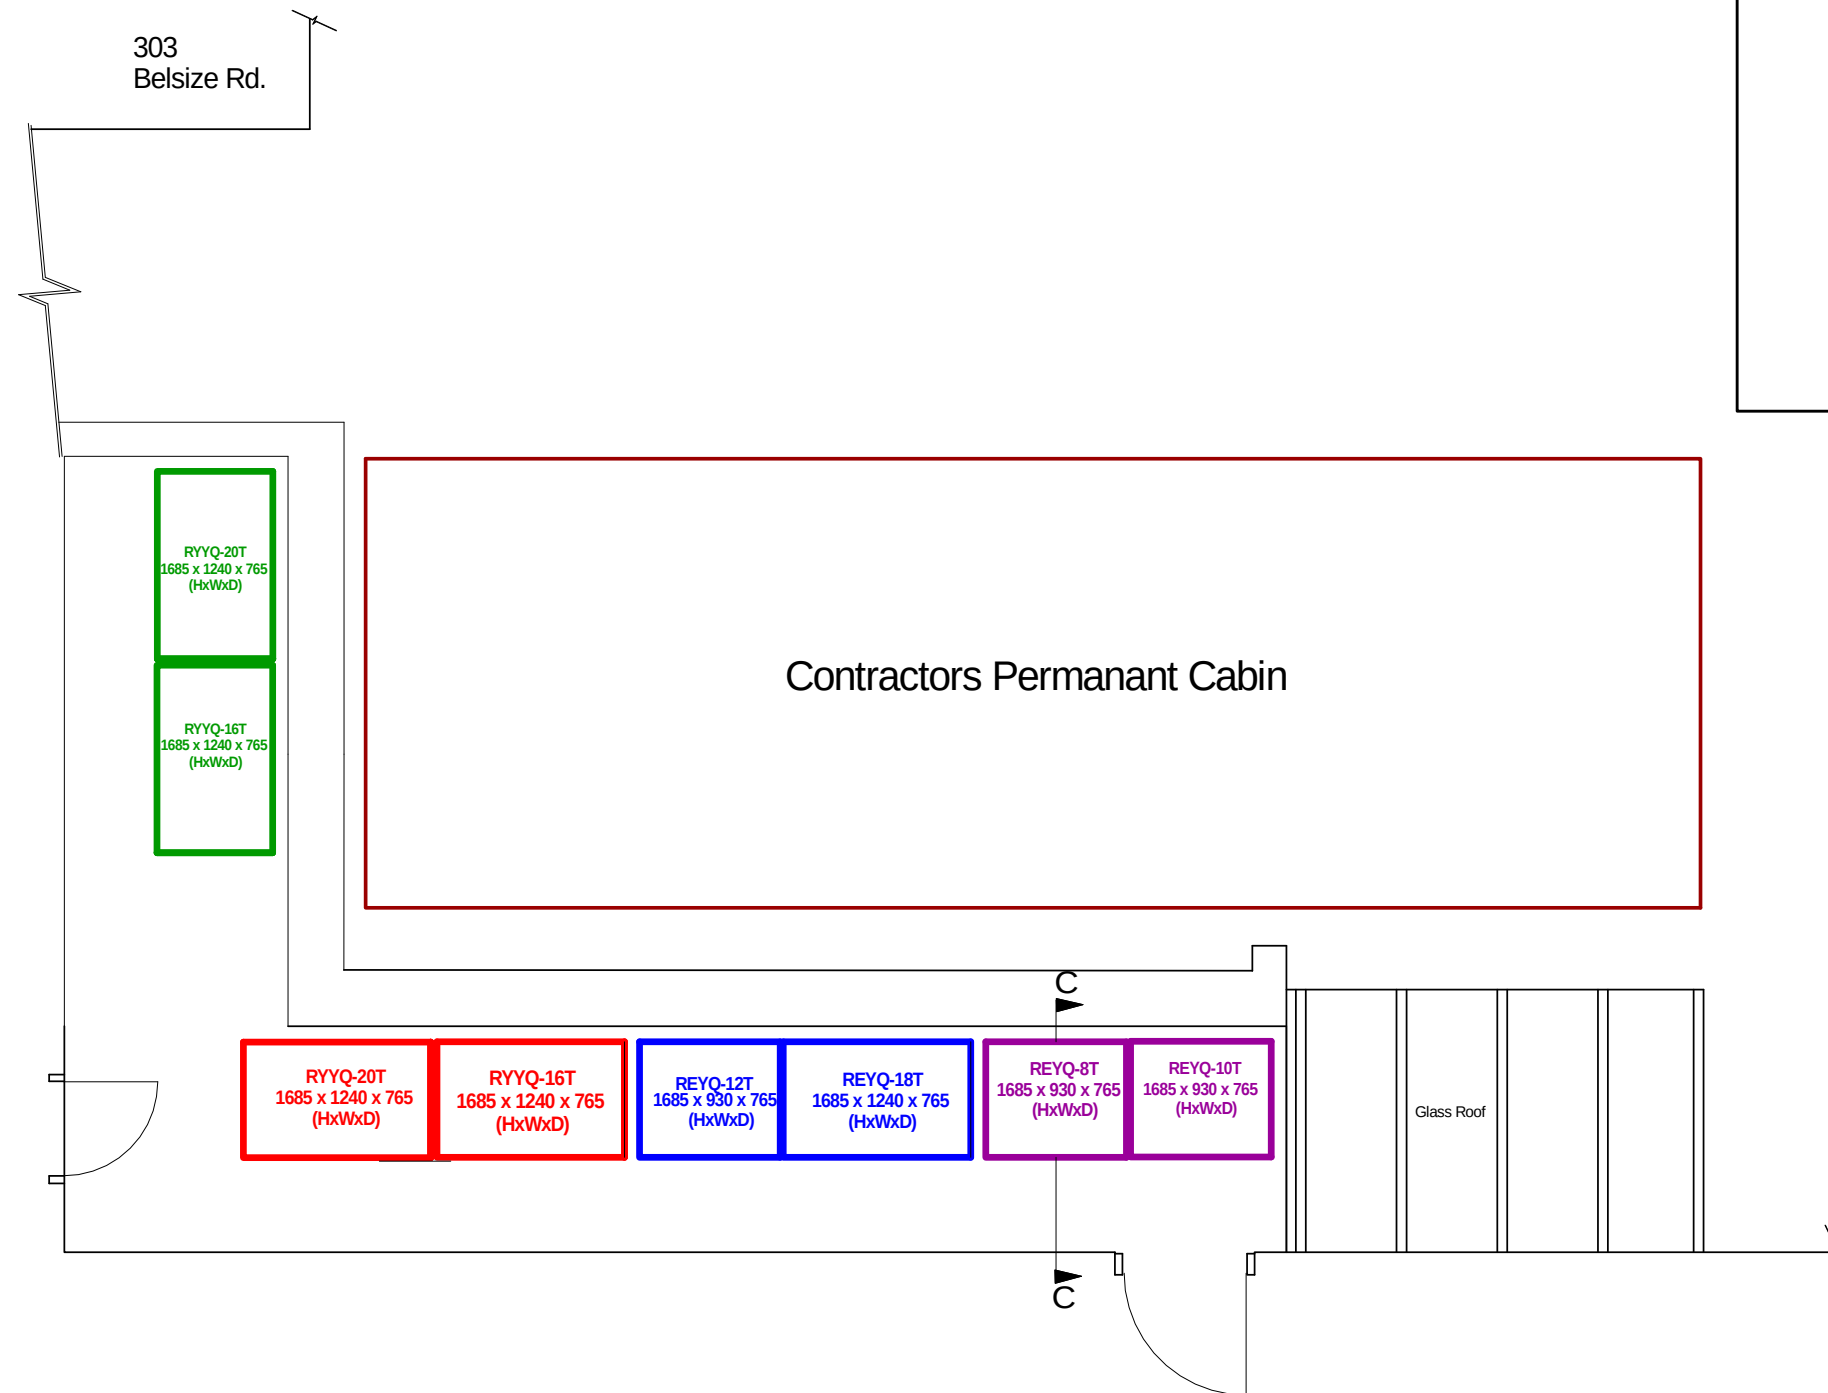

External Platform Plan (Mezzanine Level)

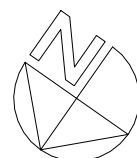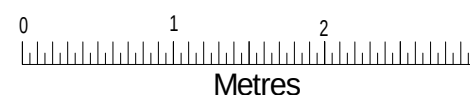


 chartered building surveyors Tel: 020 8905 7505 Fax: 020 8205 5374 Symal House, 423 Edgware Road, London, NW9 0HU		Client:	Silverstone Properties Ltd.	Date:	Sept. 2017	Scale:	1:50@ A3
		Location:	252 Omni House, Belsize Road, NW6 4BT	Dwg. No.: 17-035-05			
		Title:	External Platform at Roof Level - Proposed Layout				

Proposed Works Overview

- Metal platforms removed from site
- All existing heat pumps on platforms and walls removed
- Pipework serving heat pumps removed and disposed of
- Roof lowered and parapet raised to form concealed area

South Elevation

East Elevation

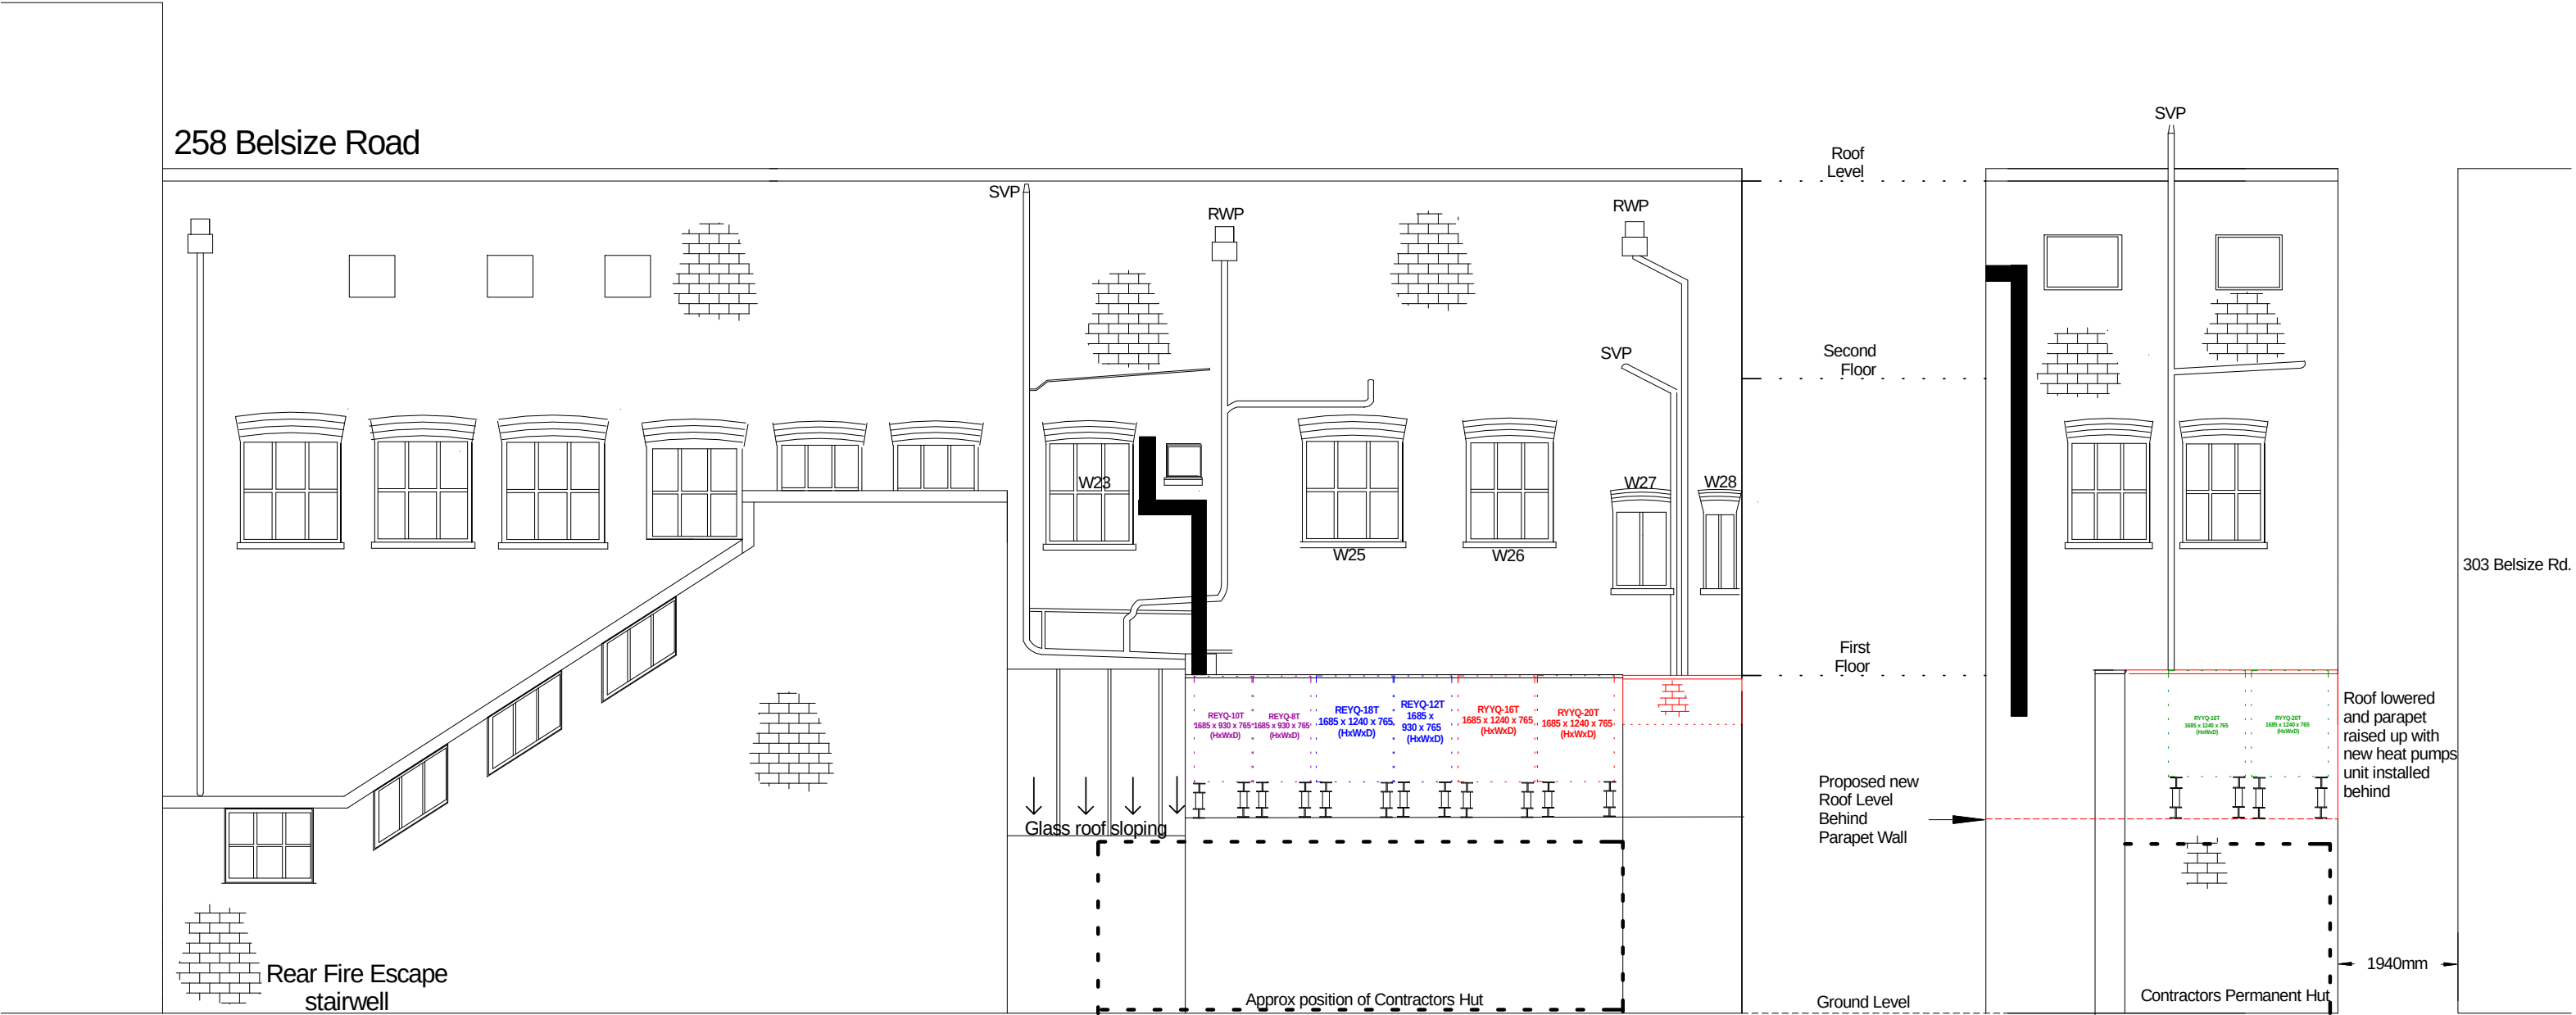





South and East Elevation - As Proposed

Key		Note			
	Proposed Changes In Height	New AC Units located behind parapet wall which has been omitted for clarity			
	Proposed pipe work runs				
Silverstone Properties Ltd.		Date:	Sept. 2017	Scale:	1:100 @ A3
Omni House, 252 Belsize Road, NW6 4BT		Dwg. No.: 17-035-06			
South and East Elevation - As Proposed					





chartered building surveyors
Tel: 020 8905 7505
Fax: 020 8205 5374
Symal House, 423 Edgware Road,
London, NW9 0HU

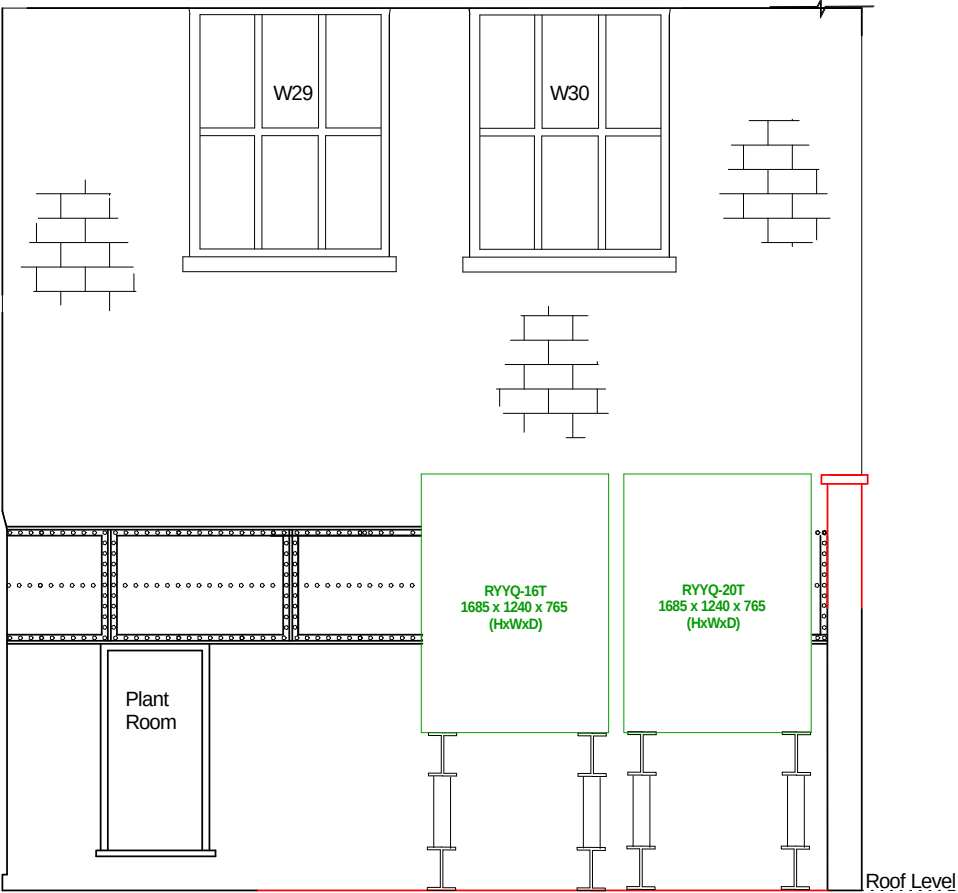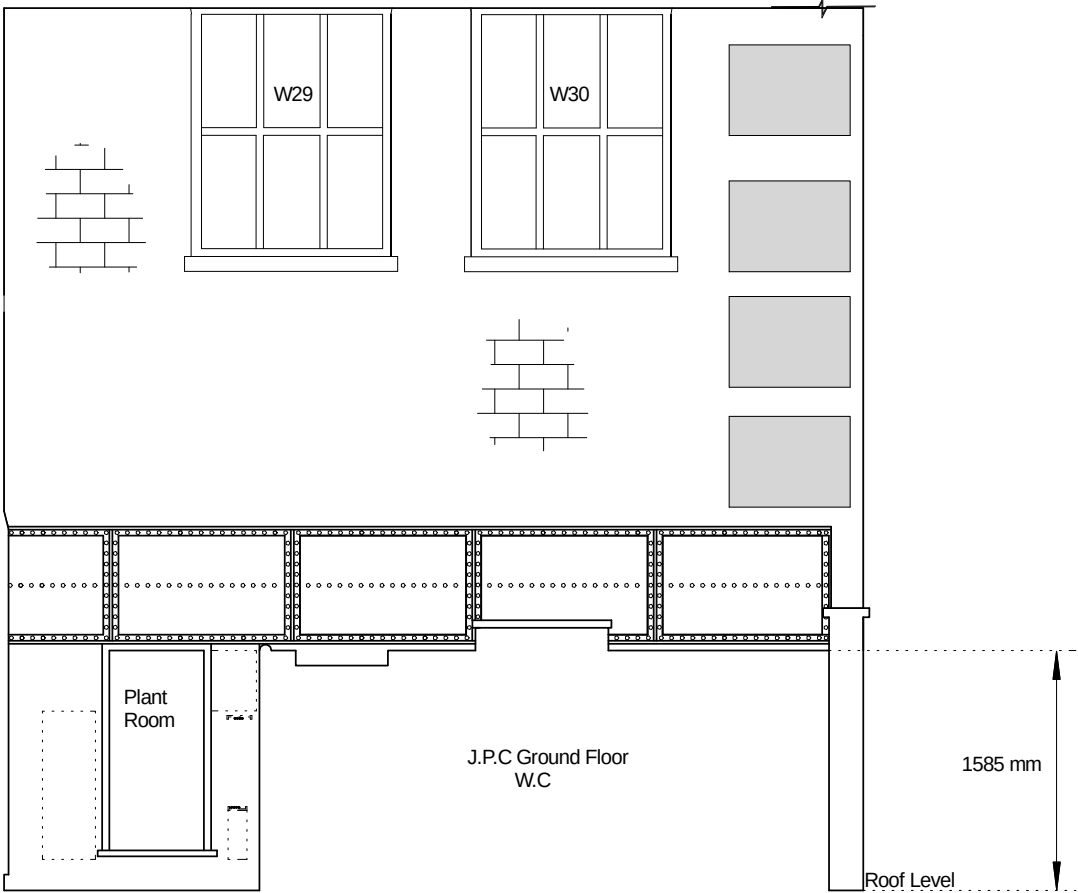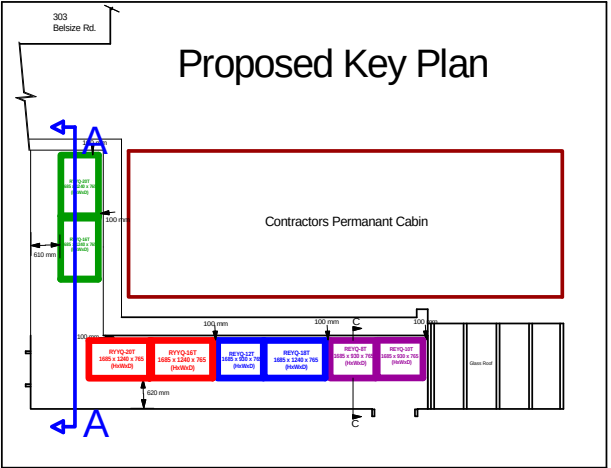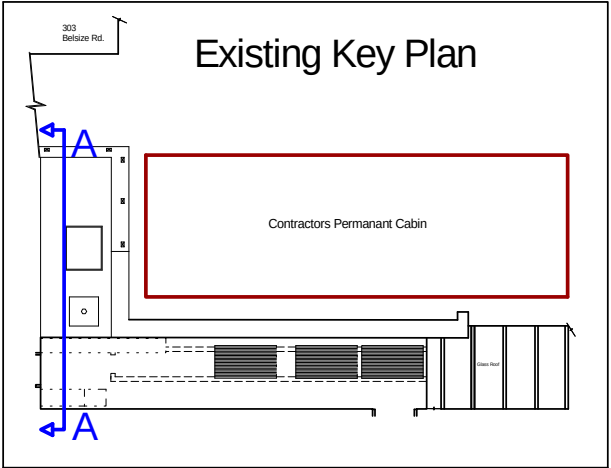

As Existing

As Proposed

Section A-A



chartered building surveyors
Tel: 020 8905 7505
Fax: 020 8205 5374
Symal House, 423 Edgware Road,
London, NW9 0HU

Client: Silverstone Properties Ltd.
Location: 252 Omni House, Belsize Road, NW6 4BT
Title: External Platform Sections A-A


Key

- All Changes Shown in Red
- Existing AC Units

Date: Sept. 2017 Scale: 1:50 @ A3






Dwg. No.: 17-035-07

Section B-B

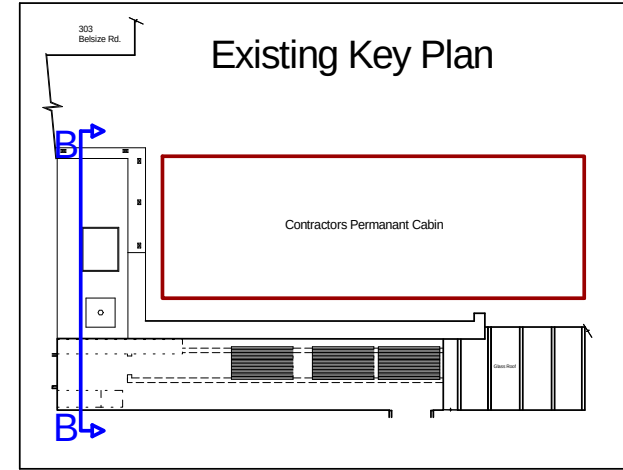

As Existing

As Proposed

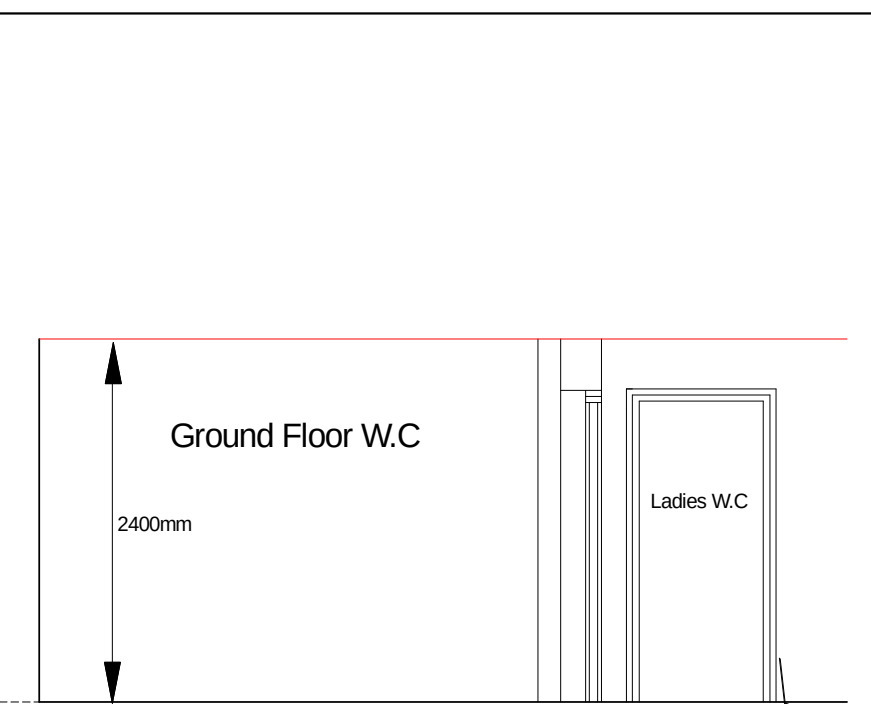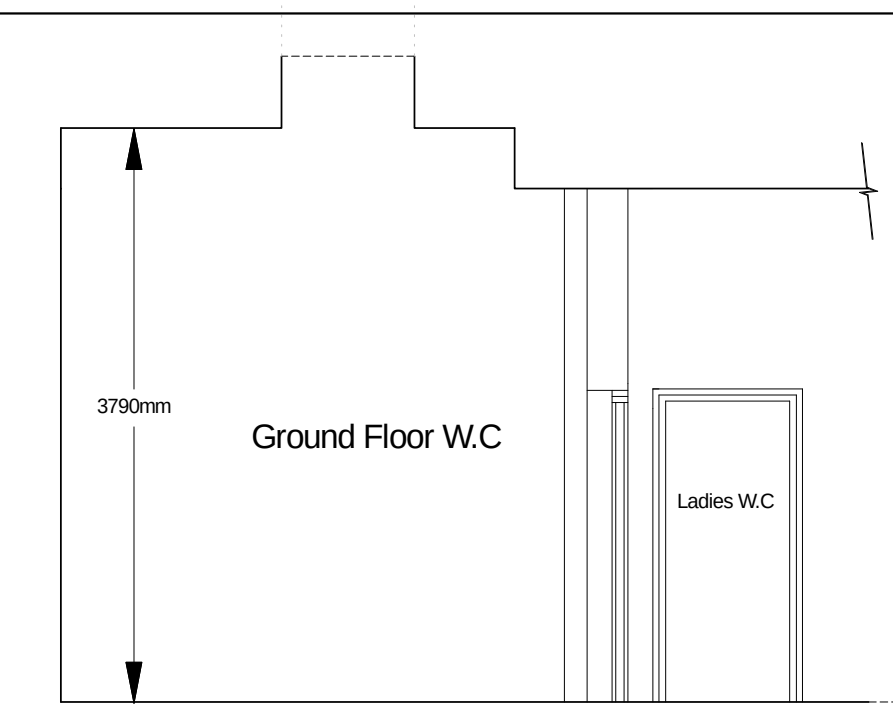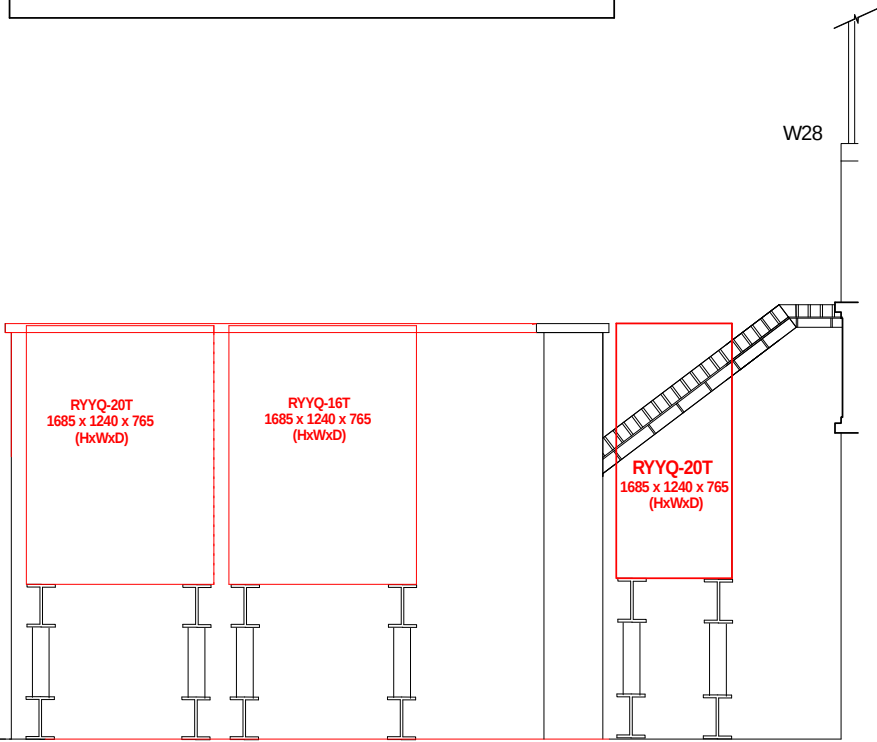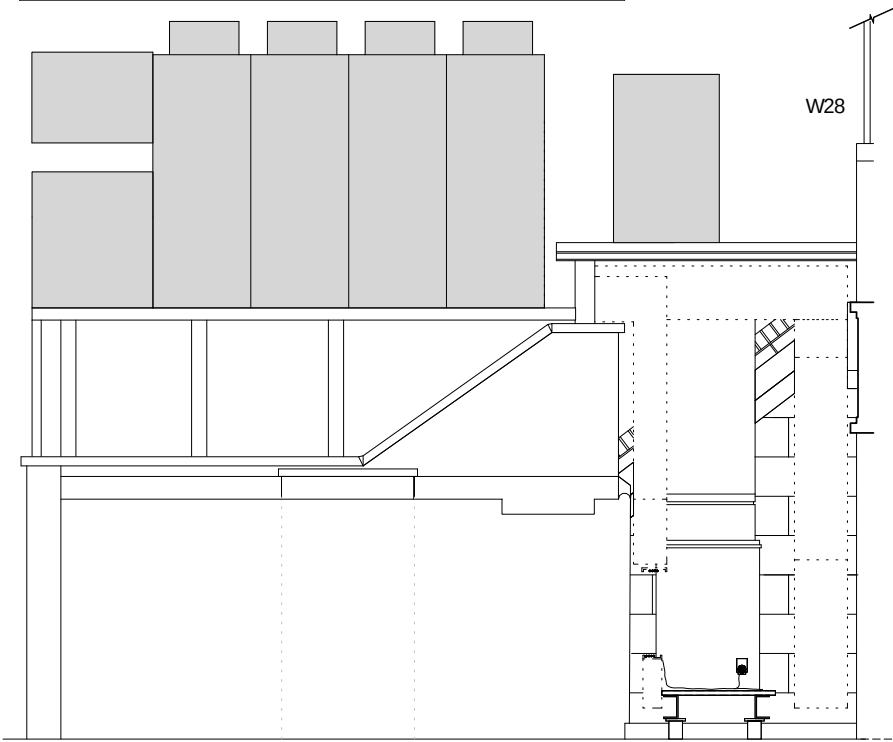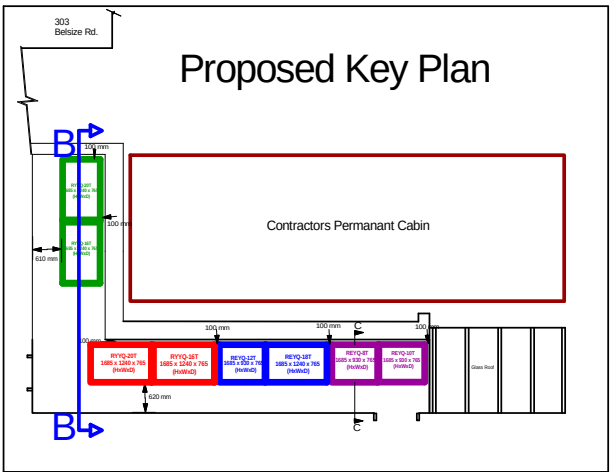

Key

- All Changes Shown in Red
- Existing AC Units






RICS
chartered building surveyors
Tel: 020 8905 7505
Fax: 020 8205 5374
Symal House, 423 Edgware Road,
London, NW9 0HU


Client:	Silverstone Properties Ltd.
Location:	252 Omni House, Belsize Road, NW6 4BT
Title:	Section B-B As Existing & As Proposed

Date:	Sept. 2017	Scale:	1:50 @ A3
--------------	------------	---------------	-----------

Dwg. No.: 17-035-08

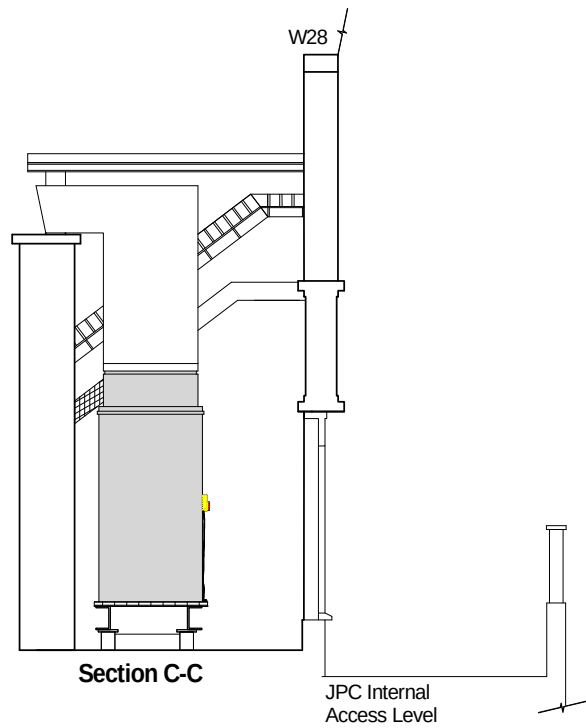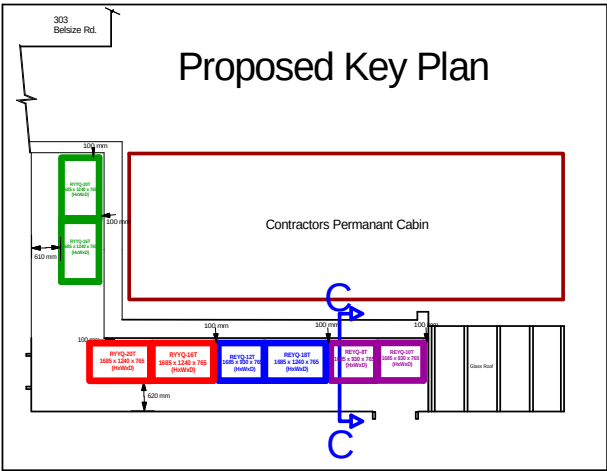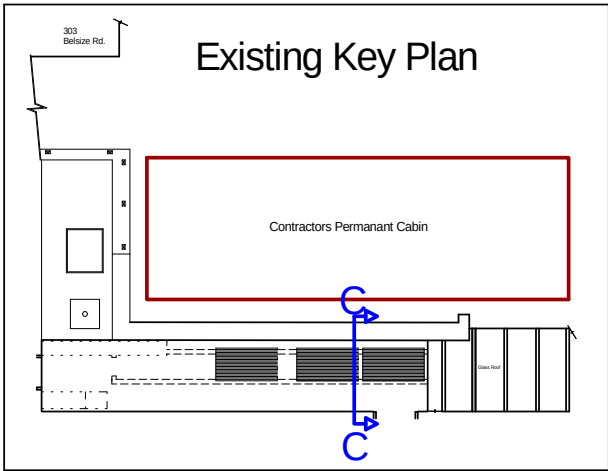

As Existing

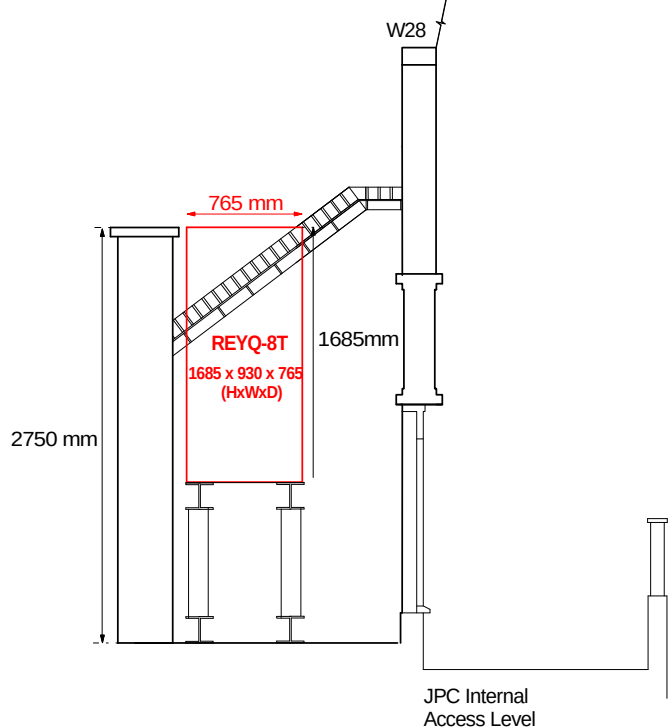





As Proposed

Section C-C

Key			
All Changes Shown in Red			
Existing AC Units			



 chartered building surveyors Tel: 020 8905 7505 Fax: 020 8205 5374 Symal House, 423 Edgware Road, London, NW9 0HU		Client:	Silverstone Properties Ltd.	Date:	Sept. 2017	Scale:	1:50 @ A3
		Location:	252 Omni House, Belsize Road, NW6 4BT	Dwg. No.:	17-035-09		
		Title:	Section C-C As Existing & As Proposed				

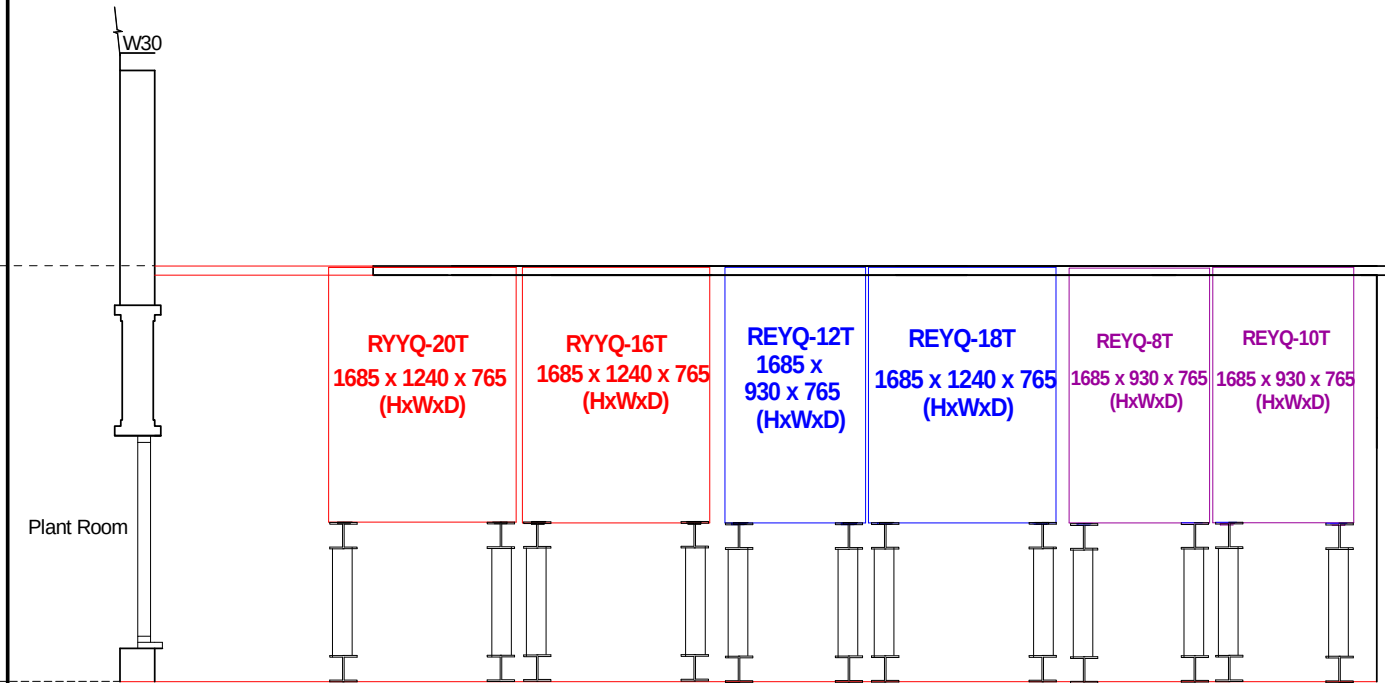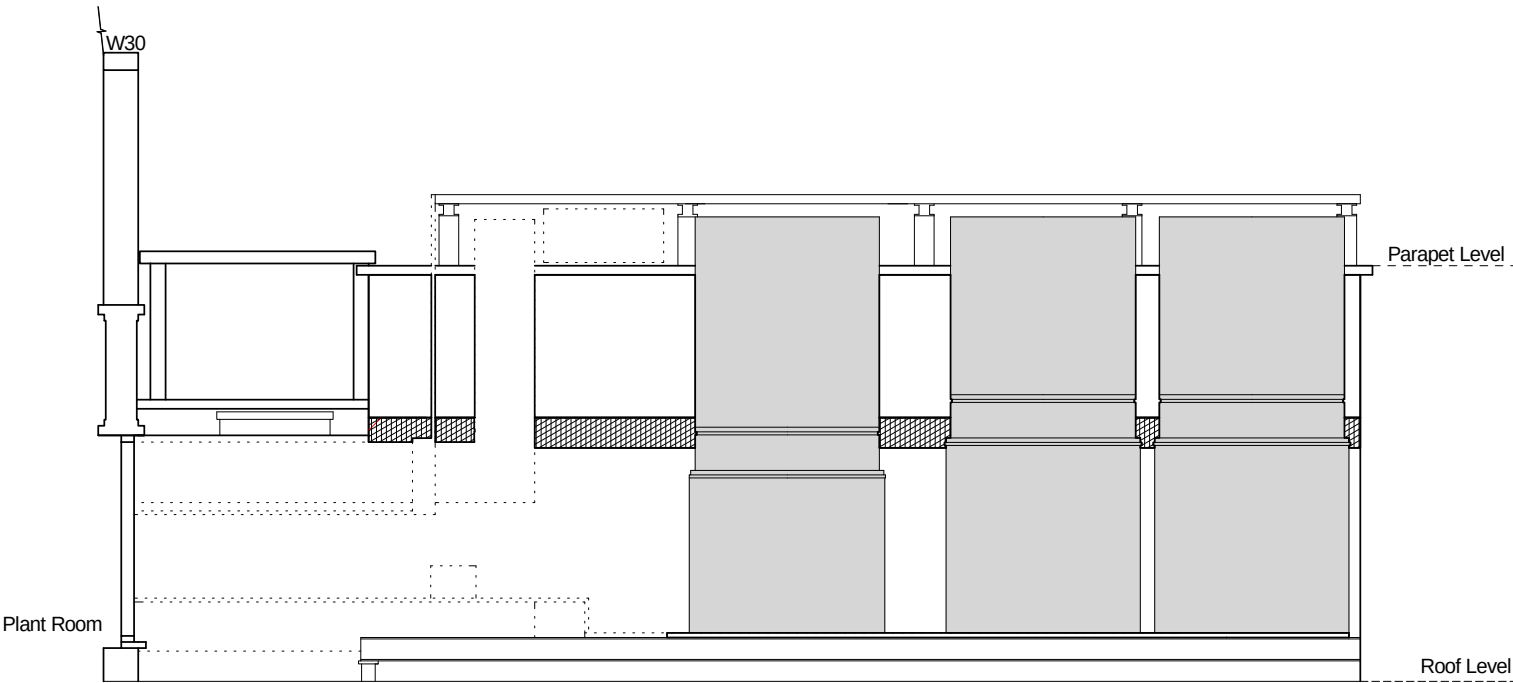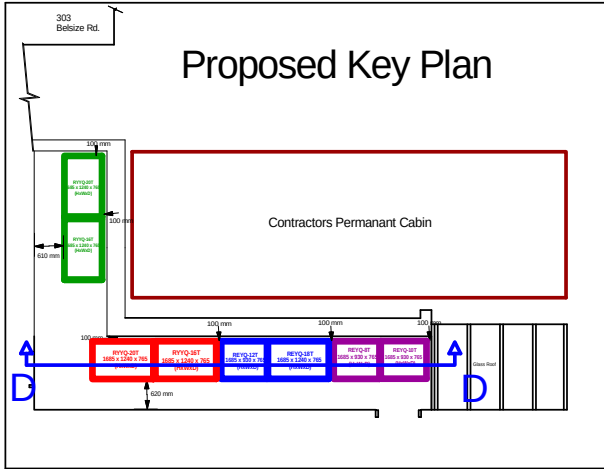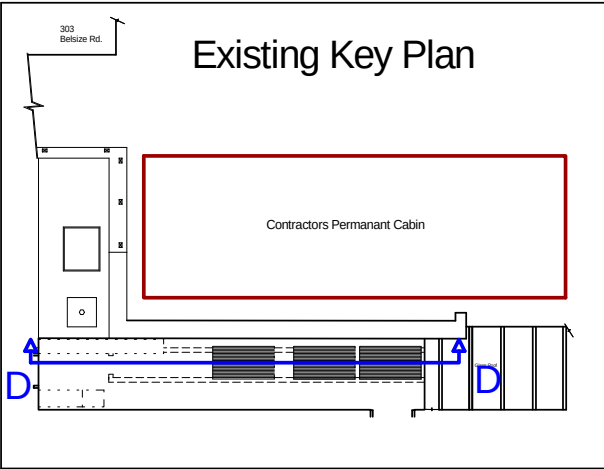

As Existing

As Proposed

Section D-D

Key

Proposed Roof level

Existing AC Units

Client:

Silverstone Properties Ltd.

Location:

252 Omni House, Belsize Road, NW6 4BT

Title:

Section D-D As Existing & Proposed

Date:

Sept. 2017

Scale:

1:50 @ A3

Dwg. No.:

17-035-10



RICS

chartered building surveyors

Tel: 020 8905 7505

Fax: 020 8205 5374

Symal House, 423 Edgware Road,

London, NW9 0HU

Client:

Silverstone Properties Ltd.

Location:

252 Omni House, Belsize Road, NW6 4BT

Title:

Section D-D As Existing & Proposed

Date:

Sept. 2017

Scale:

1:50 @ A3

Dwg. No.:

17-035-10