


NO COLUMNS ON ARCHIVE
S.E. DRAWING HERE : TBC
ON SITE. COLUMNS BELOW

PART ORIGINAL STRUCTURAL G.A. OF
GROUND FLOOR: IN ORT HOUSE ARCHIVE

KEY

- R.C. COLUMNS: VARY IN SIZE
- ⋯ R.C. WALLS BELOW
- LIFT/STAIR WELL WALLS 150mm THICK
- - - EXPANSION JOINT

POSSIBLE ORIGINAL
ARCHED COL
HOLES TO
FRONT

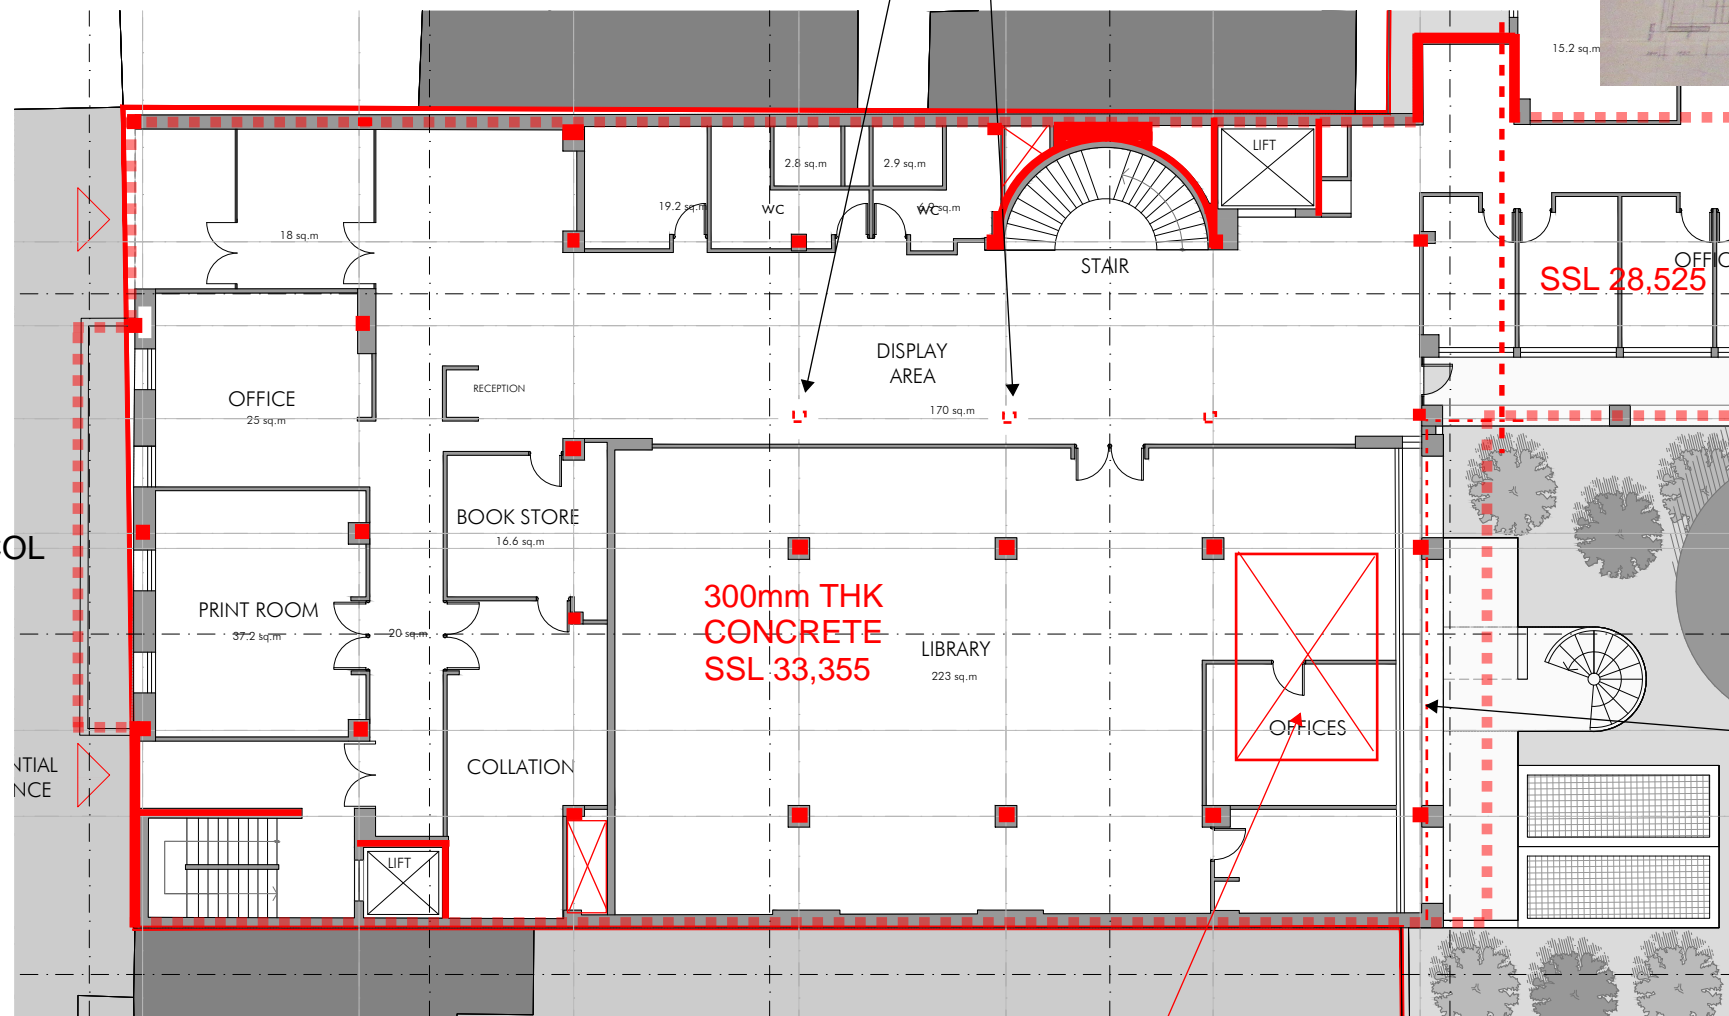

SSL 28,525

300mm THK
CONCRETE
SSL 33,355

OUTLINE OF EXISTING
STRUCTURE OVER
AND 250mm STEP
DOWN IN SLAB

SITE ACCESS VOID: FILLED IN
WITH PRECAST CONCRETE
PLANKS

conisbee
Consulting Structural Engineers
Consulting Civil Engineers

1-5 Offord St
London N1 1DH
Tel 020 7700 6666
Fax 020 7700 6686
design@conisbee.co.uk
www.conisbee.co.uk

Project
ORT HOUSE
120-126 ALBERT STREET, NW1
Title
**EXISTING STRUCTURE MARK-UP
GROUND FLOOR LEVEL**

Rev	Date	Description	Drawn	Check
Drawing Status		Project No		
INFORMATION		170251		
Date	Drawn	Drawing No		
JUN 2017	HH	SK-S-001		
Scale	Engineer	Revision		
1:200@A3	HH	-		