



EXISTING A/C UNITS DO NOT REQUIRE PERMISSION AS THEY ARE LOCATED INTERNALLY

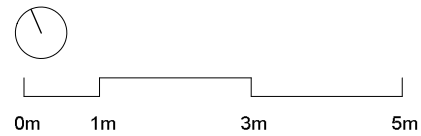

A/C - EXTRACT APPLICATION

Notes


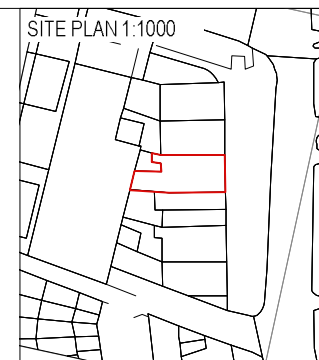


REV	DATE	DESCRIPTION	BY	CHK
01	10.03.16	ISSUED FOR PLANNING	MC	JH
-	29.06.15	ISSUED FOR PLANNING	MC	JH

Project 21 Swain's Lane			
Drawing GA Ground Floor Plan : Existing			
Job Number 15009	Drawing Number 0100	Rev 01	
Drawn MC	Date 18.05.15	Status Planning	Scale @ A3 1 : 100
Do not scale from this drawing. All dimensions are to be checked on site. This drawing is to be read in conjunction with all consultants information.			


Holland Harvey Architects
The Church
33a Wadeson street
London E2 9DR
hello@hollandharvey.com
+44 208 123 7454

Client
Gail's Bakery

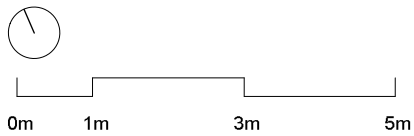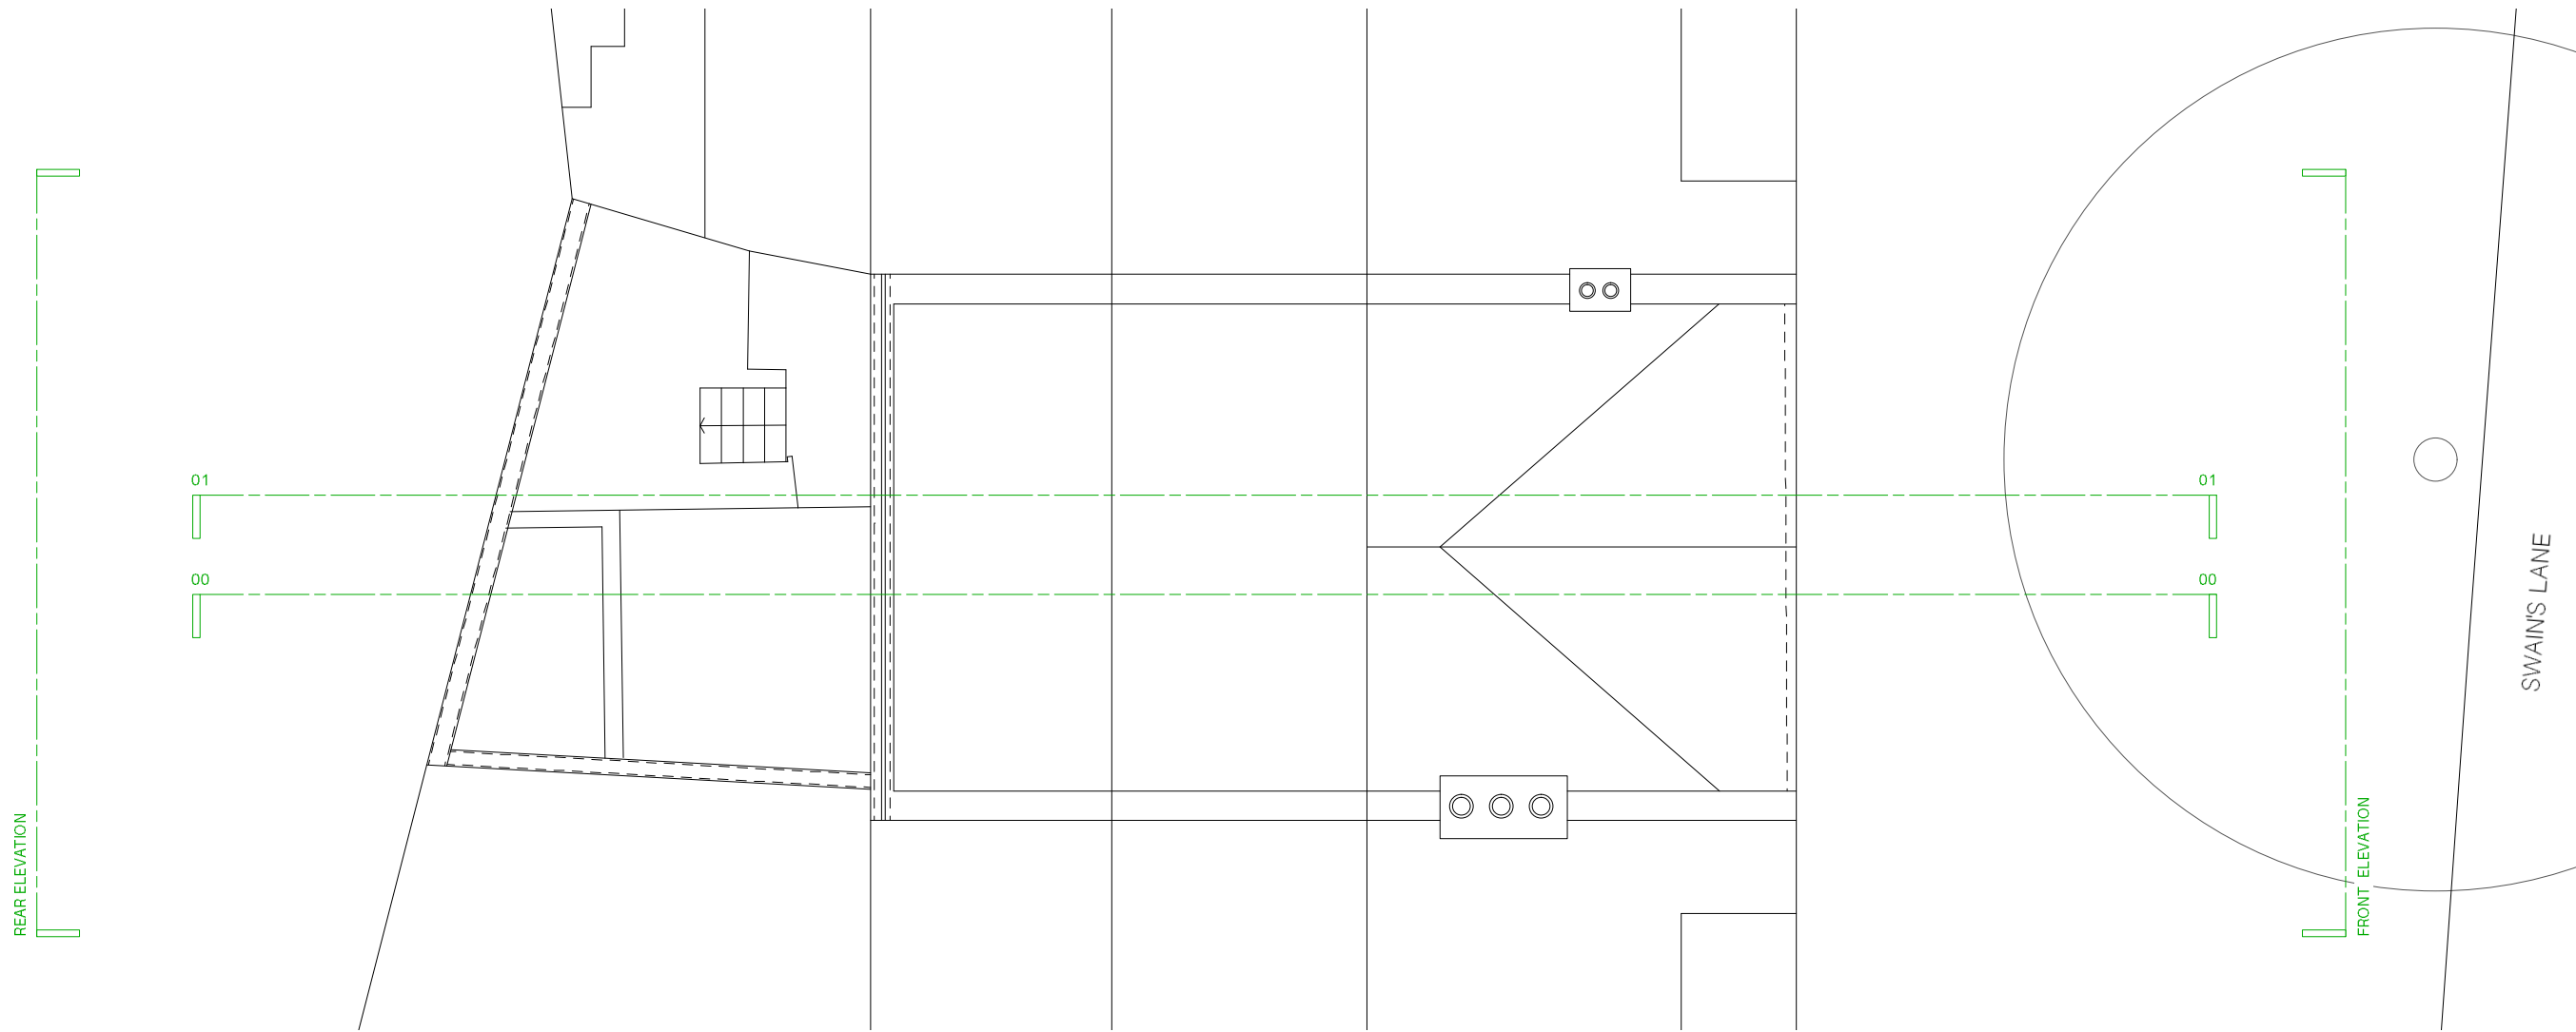

A/C - EXTRACT APPLICATION

Notes

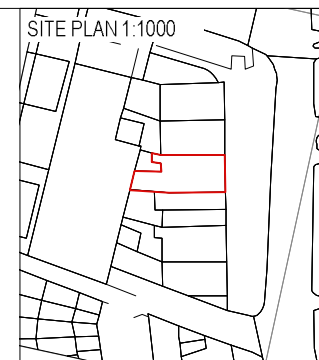


REV	DATE	DESCRIPTION	BY	CHK
01	10.03.16	ISSUED FOR PLANNING	MC	JH
-	29.06.15	ISSUED FOR PLANNING	MC	JH

Project 21 Swain's Lane			
Drawing GA Roof Plan : Existing			
Job Number 15009	Drawing Number 0101	Rev 01	
Drawn MC	Date 18.05.15	Status Planning	Scale @ A3 1 : 100
Do not scale from this drawing. All dimensions are to be checked on site. This drawing is to be read in conjunction with all consultants information.			




Holland Harvey Architects
The Church
33a Wadeson street
London E2 9DR
hello@hollandharvey.com
+44 208 123 7454

Client
Gail's Bakery

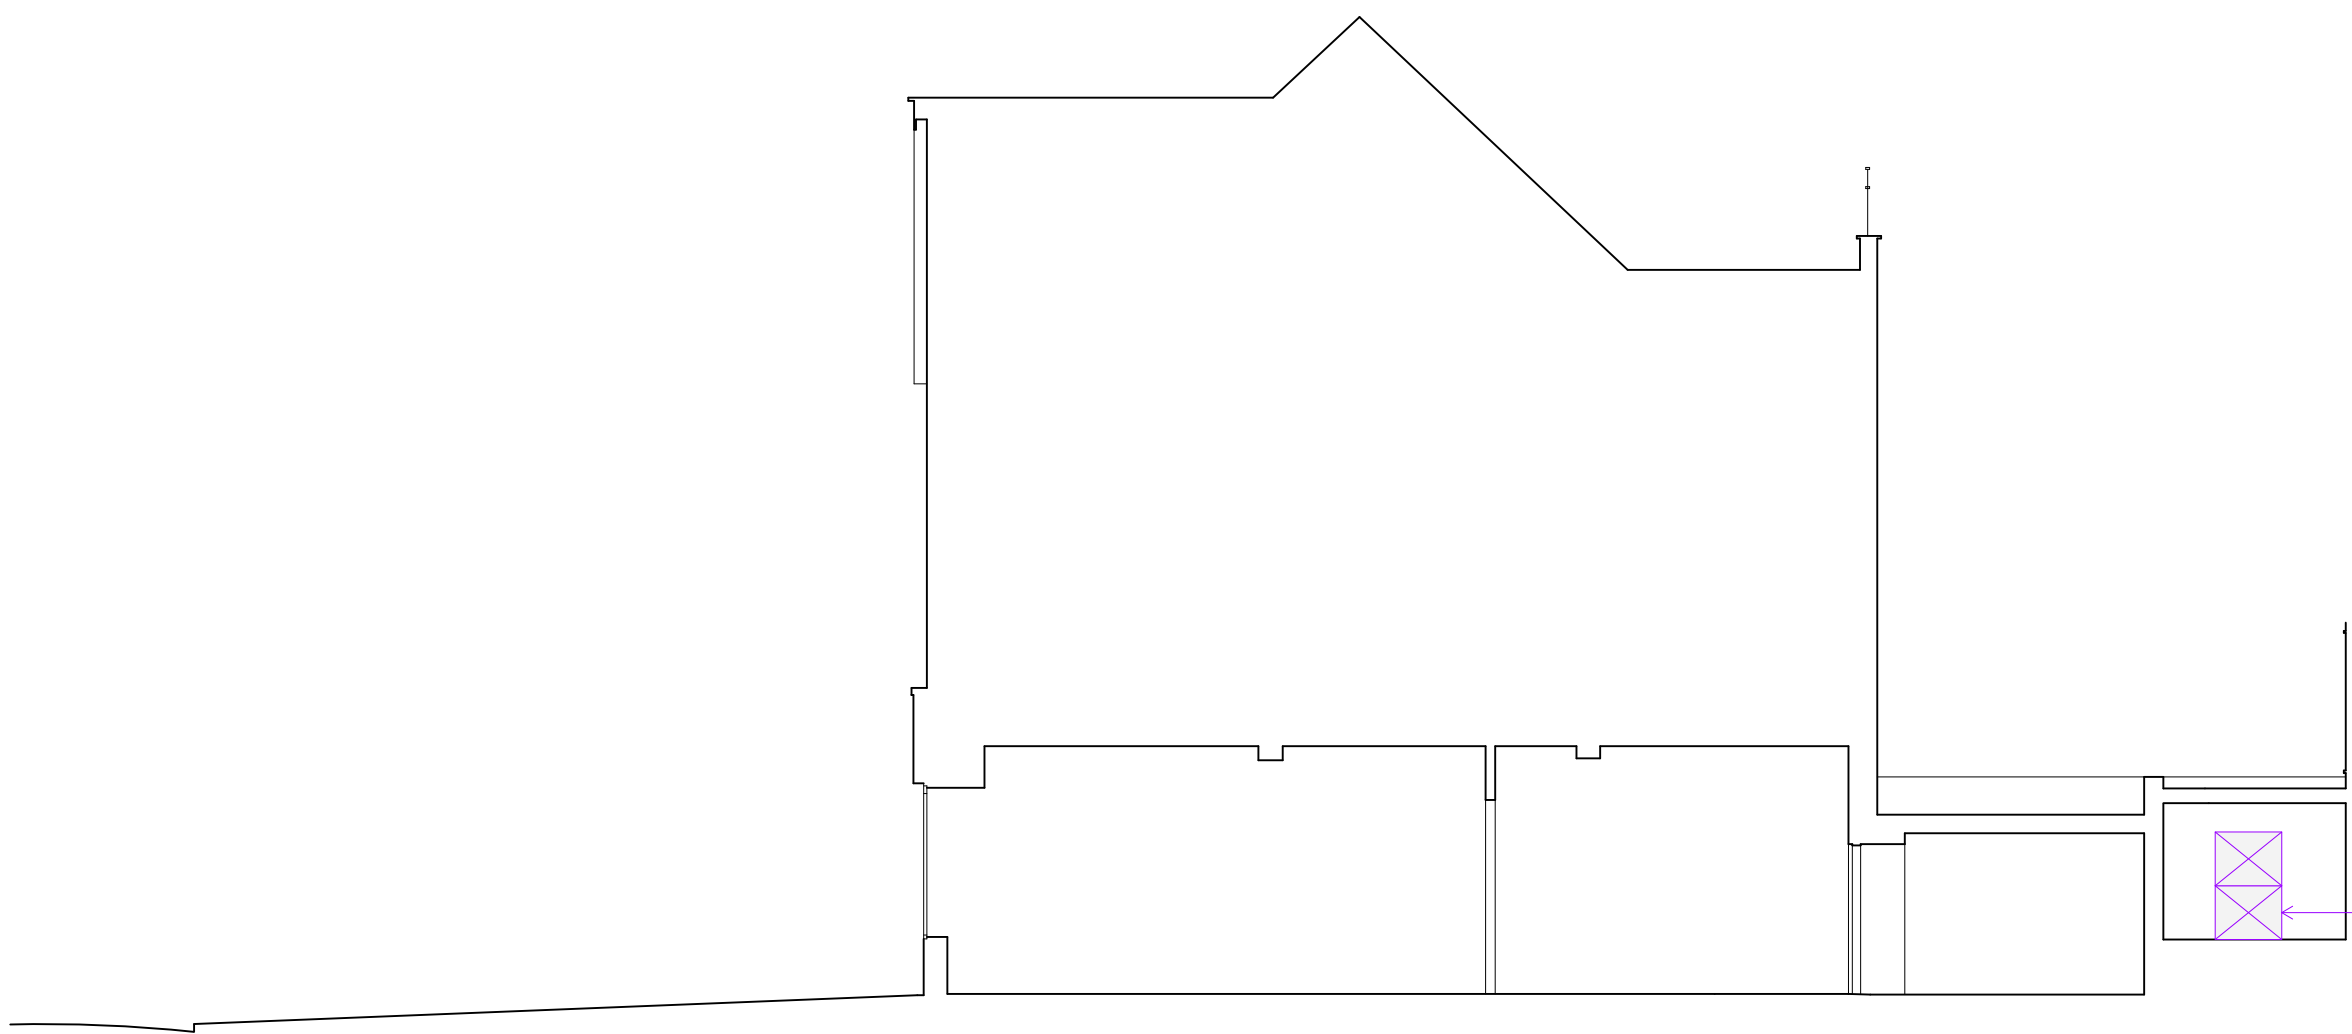


EXISTING A/C UNITS DO NOT REQUIRE PERMISSION AS THEY ARE LOCATED INTERNALLY

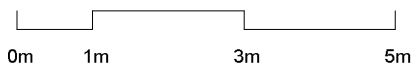

A/C - EXTRACT APPLICATION

Notes

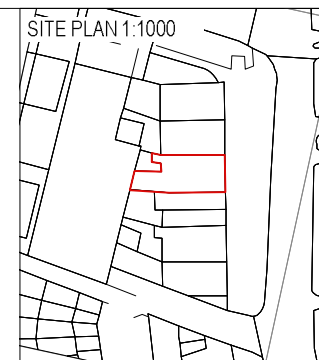

REV	DATE	DESCRIPTION	BY	CHK
01	10.03.16	ISSUED FOR PLANNING	MC	JH
-	29.06.15	ISSUED FOR PLANNING	MC	JH


Project 21 Swain's Lane			
Drawing GA Section 00 : Existing			
Job Number 15009	Drawing Number 0200	Rev 01	
Drawn MC	Date 18.05.15	Status Planning	Scale @ A3 1 : 100
Do not scale from this drawing. All dimensions are to be checked on site. This drawing is to be read in conjunction with all consultants information.			




Holland Harvey Architects
The Church
33a Wadeson street
London E2 9DR
hello@hollandharvey.com
+44 208 123 7454

Client

Gail's Bakery

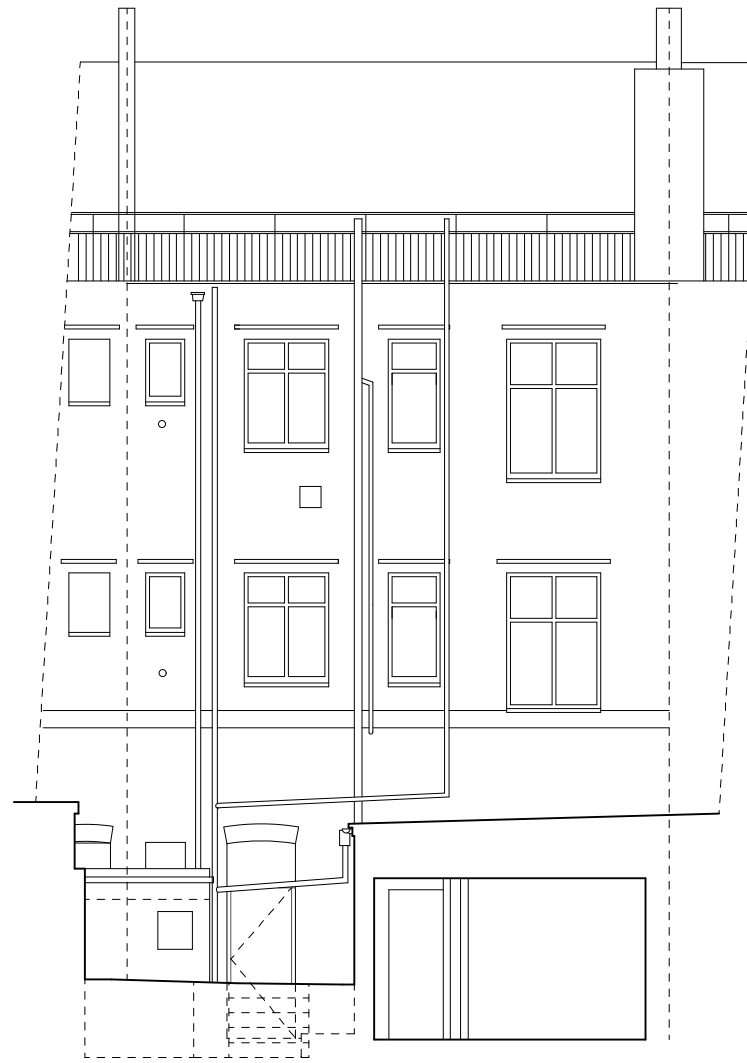


EXISTING REAR ELEVATION

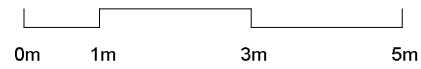

A/C - EXTRACT APPLICATION

Notes

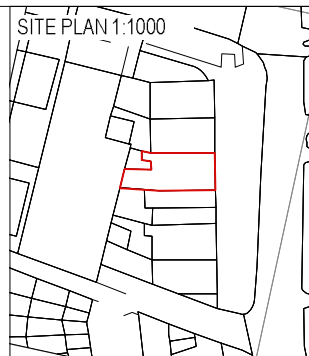

REV	DATE	DESCRIPTION	BY	CHK
01	10.03.16	ISSUED FOR PLANNING	MC	JH
-	29.06.15	ISSUED FOR PLANNING	MC	JH



Project 21 Swain's Lane			
Drawing GA Rear Elevation : Existing			
Job Number 15009	Drawing Number 0300	Rev 01	
Drawn MC	Date 18.05.15	Status Planning	Scale @ A3 1 : 100
Do not scale from this drawing. All dimensions are to be checked on site. This drawing is to be read in conjunction with all consultants information.			



Holland Harvey Architects
The Church
33a Wadeson street
London E2 9DR
hello@hollandharvey.com
+44 208 123 7454


Client

Gail's Bakery

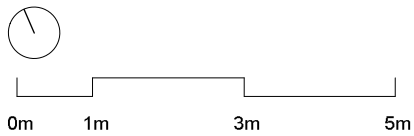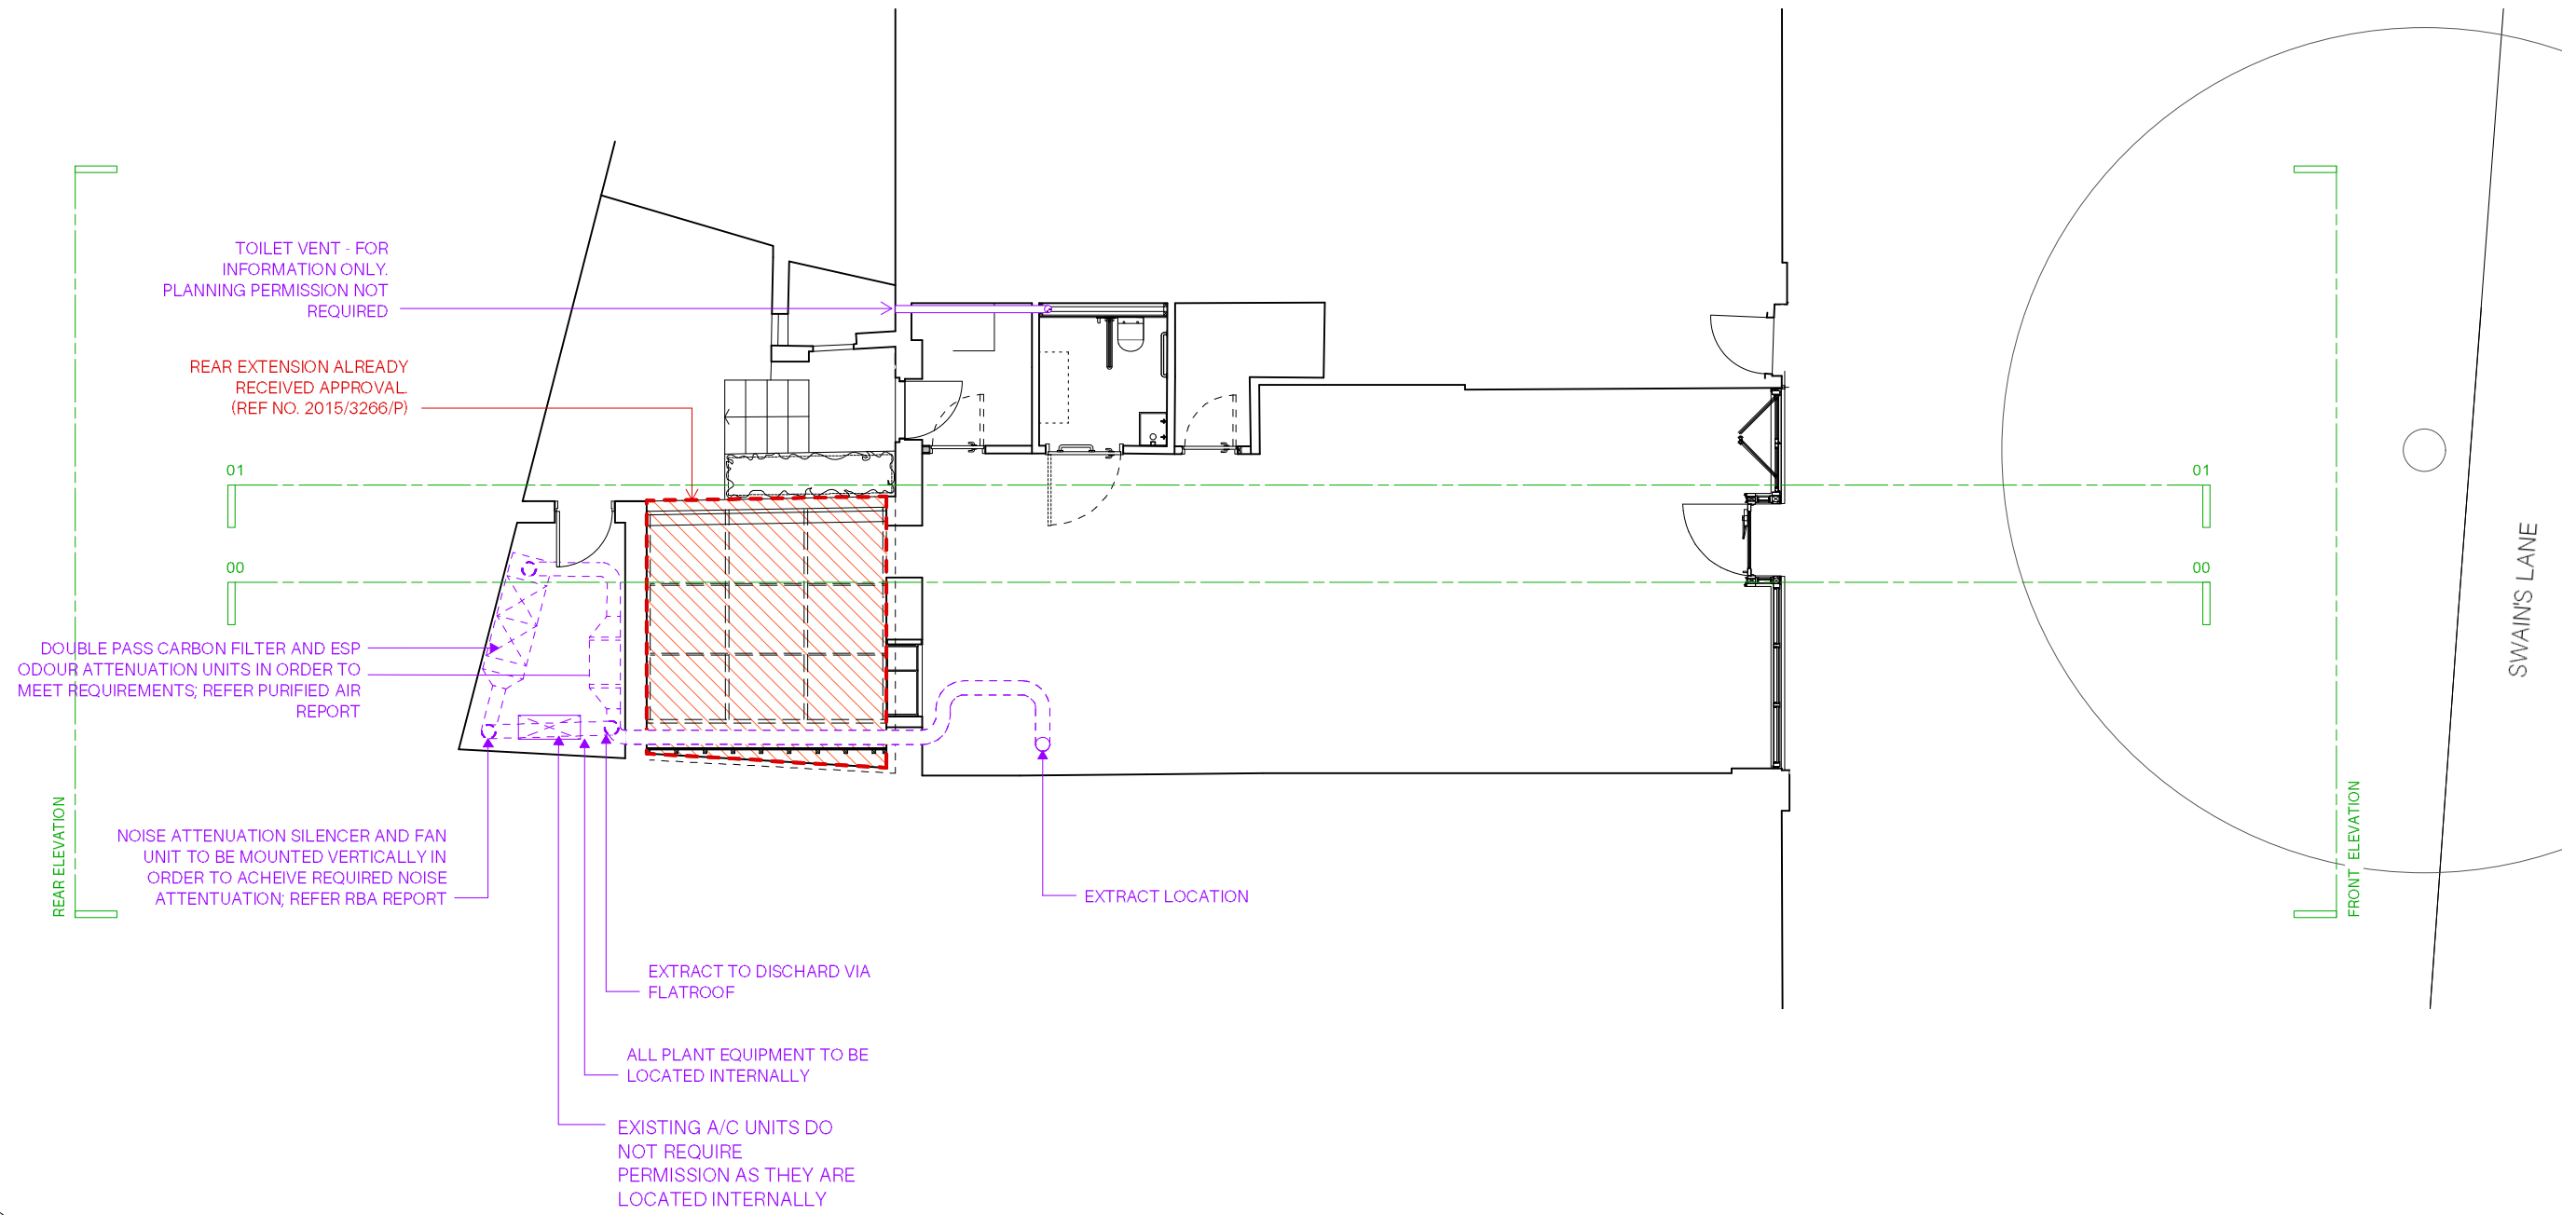

A/C - EXTRACT APPLICATION

Notes

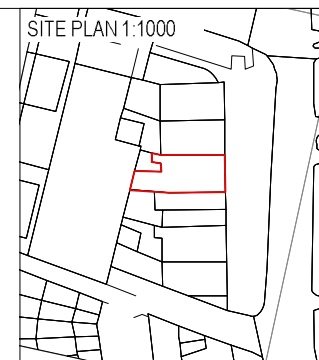



REV	DATE	DESCRIPTION	BY	CHK
06	18.10.17	ISSUED FOR PLANNING	JB	JH
05	05.04.16	ISSUED FOR PLANNING	MC	JH
04	31.03.16	ISSUED FOR PLANNING	MC	JH
03	17.03.16	ISSUED FOR PLANNING	MC	JH
02	10.03.16	ISSUED FOR PLANNING	MC	JH
01	07.07.15	ISSUED FOR PLANNING	MC	JH
-	29.06.15	ISSUED FOR PLANNING	MC	JH
			BY	CHK

Project 21 Swain's Lane			
Drawing GA Ground Floor Plan : As Built			
Job Number 15009	Drawing Number 1100	Rev 06	
Drawn MC	Date 18.05.15	Status Planning	Scale @ A3 1 : 100
Do not scale from this drawing. All dimensions are to be checked on site. This drawing is to be read in conjunction with all consultants information.			




Holland Harvey Architects
The Church
33a Wadeson street
London E2 9DR
hello@hollandharvey.com
+44 208 123 7454

Client
Gail's Bakery

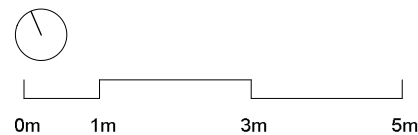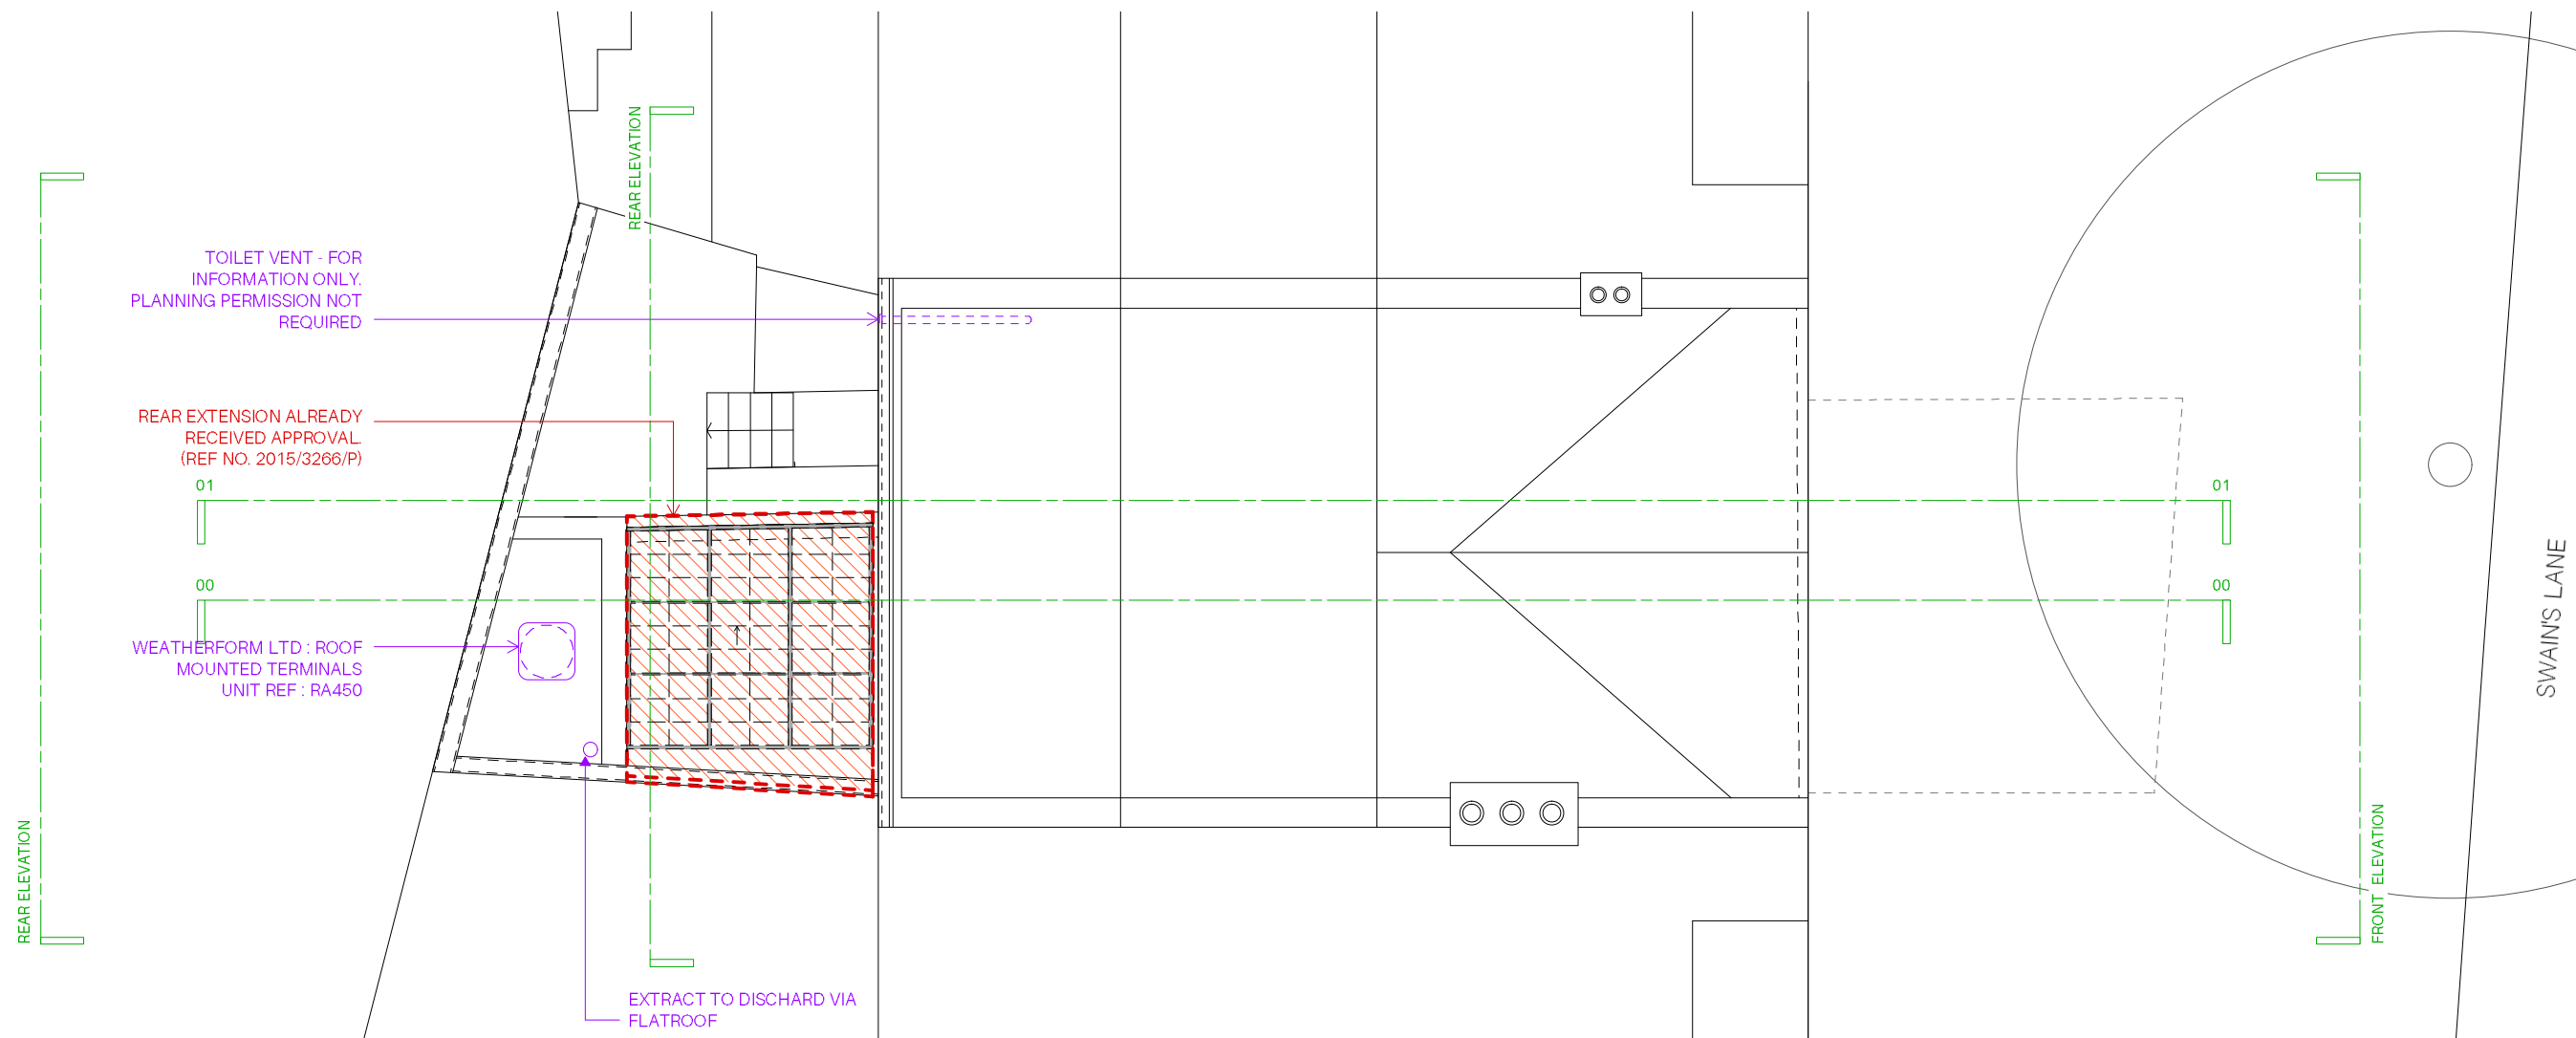

A/C - EXTRACT APPLICATION

Notes

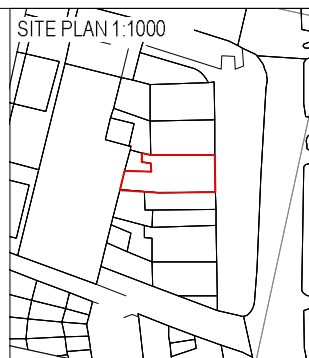

REV	DATE	DESCRIPTION	BY	CHK
06	18.10.17	ISSUED FOR PLANNING	JB	JH
05	05.04.16	ISSUED FOR PLANNING	MC	JH
04	31.03.16	ISSUED FOR PLANNING	MC	JH
03	17.03.16	ISSUED FOR PLANNING	MC	JH
02	10.03.16	ISSUED FOR PLANNING	MC	JH
01	07.07.15	ISSUED FOR PLANNING	MC	JH
-	29.06.15	ISSUED FOR PLANNING	MC	JH
			BY	CHK


Project 21 Swain's Lane			
Drawing GA Roof Plan : As Built			
Job Number 15009	Drawing Number 1101	Rev 06	
Drawn MC	Date 18.05.15	Status Planning	Scale @ A3 1 : 100
Do not scale from this drawing. All dimensions are to be checked on site. This drawing is to be read in conjunction with all consultants information.			



Holland Harvey Architects
The Church
33a Wadeson street
London E2 9DR
hello@hollandharvey.com
+44 208 123 7454


Client

Gail's Bakery

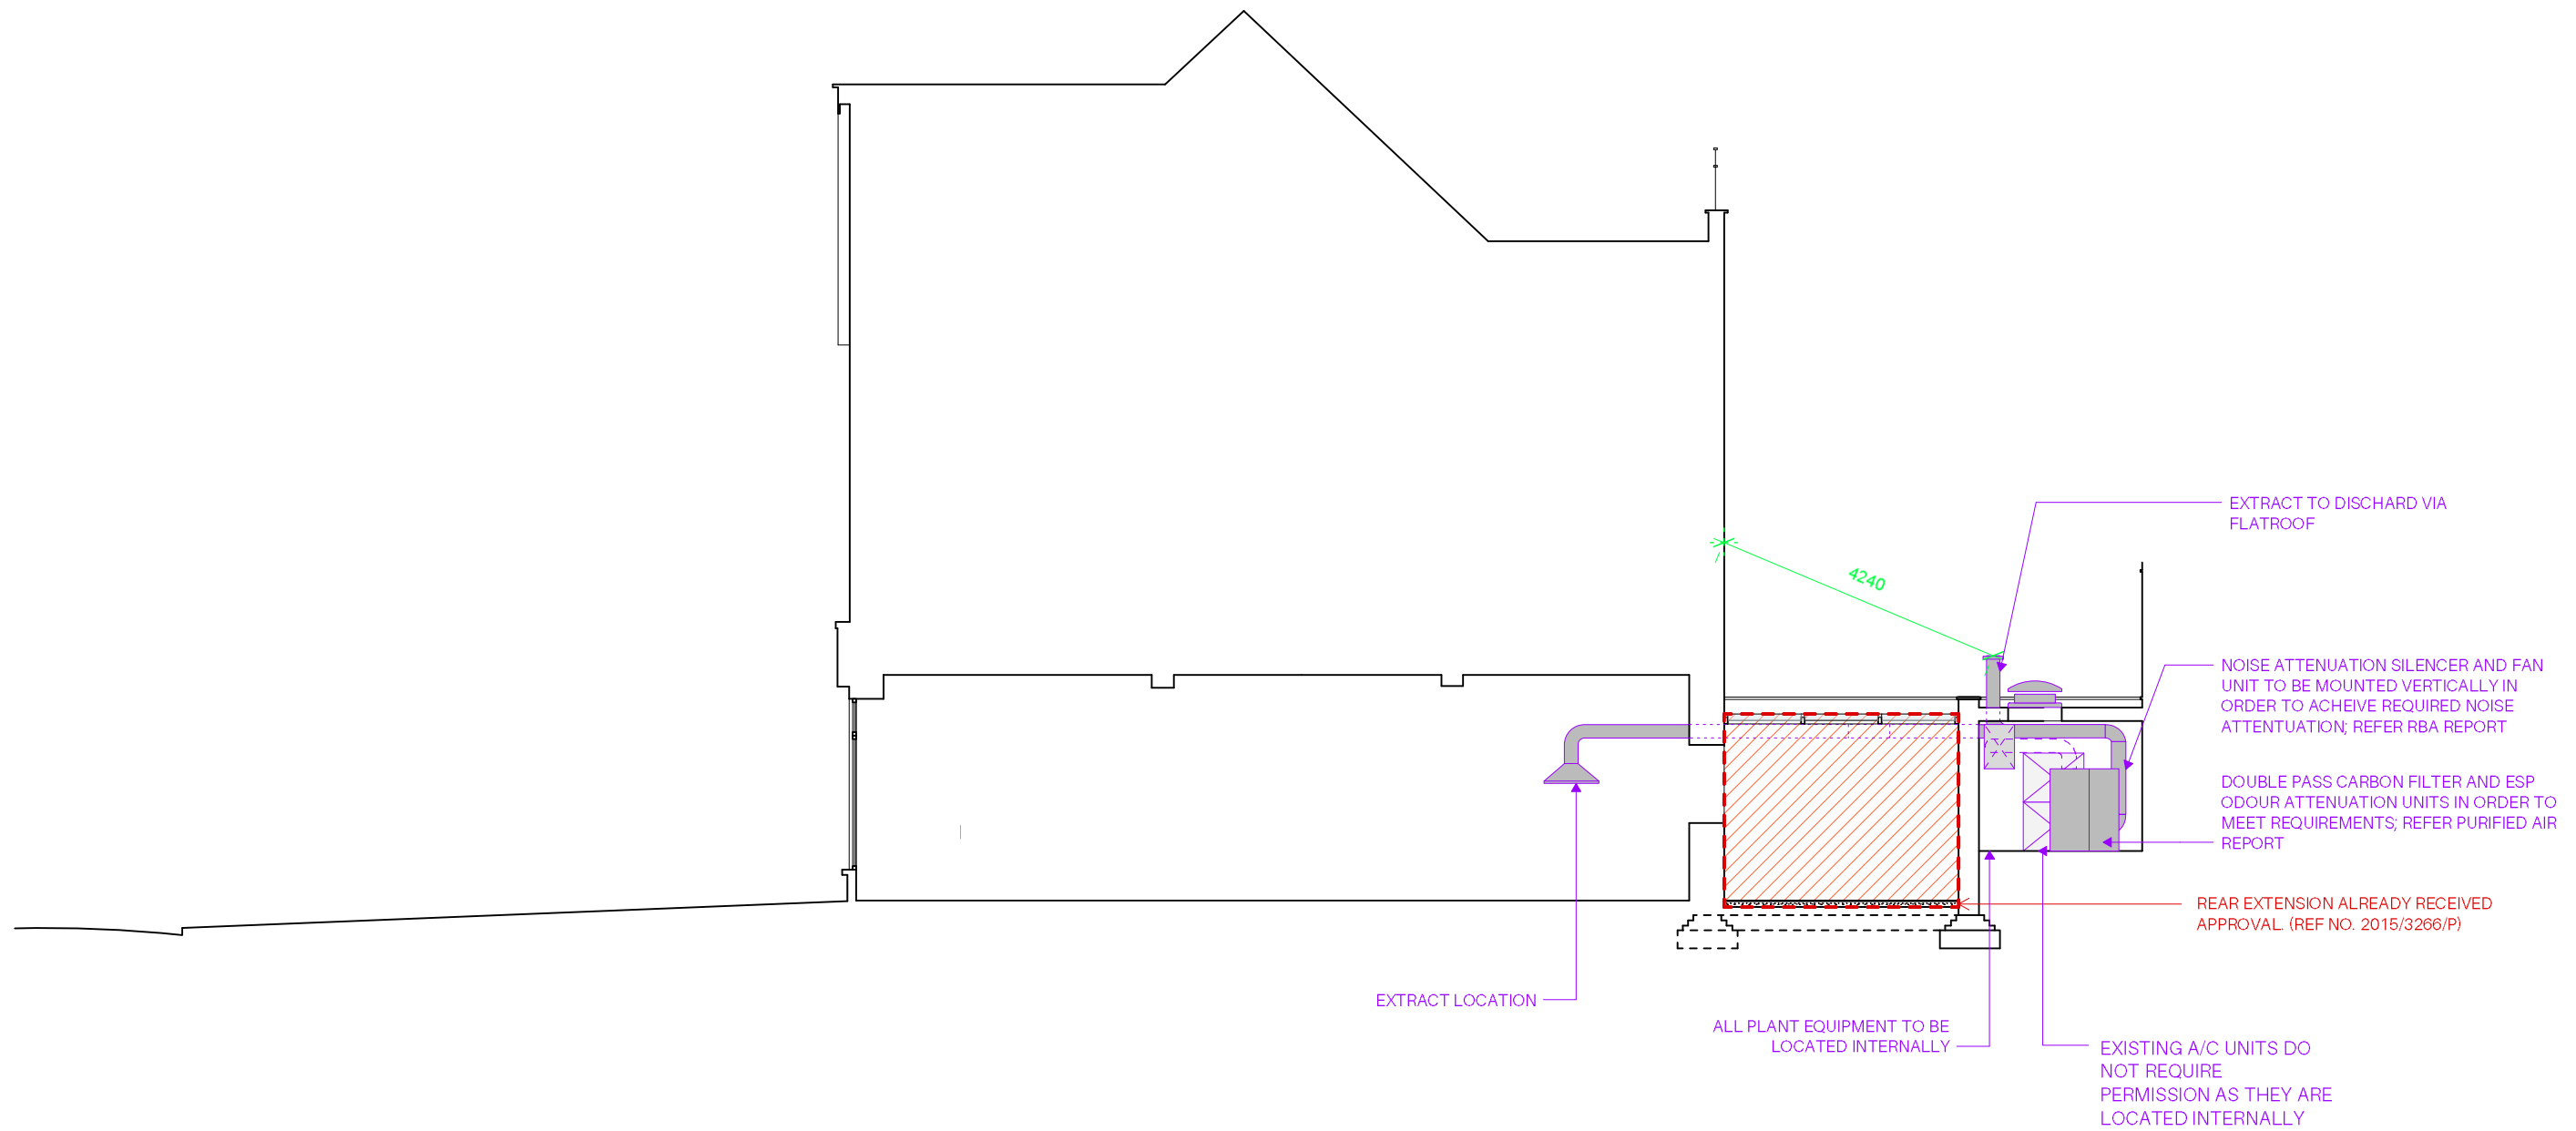

A/C - EXTRACT APPLICATION

Notes

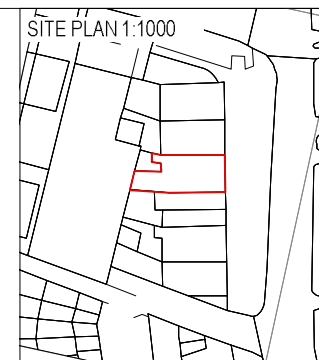


REV	DATE	DESCRIPTION	BY	CHK
06	18.10.17	ISSUED FOR PLANNING	JB	JH
05	05.04.16	ISSUED FOR PLANNING	MC	JH
04	31.03.16	ISSUED FOR PLANNING	MC	JH
03	17.03.16	ISSUED FOR PLANNING	MC	JH
02	10.03.16	ISSUED FOR PLANNING	MC	JH
01	27.08.15	ISSUED FOR PLANNING	ES	JH
-	07.07.15	ISSUED FOR PLANNING	MC	JH

Project 21 Swain's Lane			
Drawing GA Section 00 : As Built			
Job Number 15009	Drawing Number 1200	Rev 06	
Drawn MC	Date 18.05.15	Status Planning	Scale @ A3 1 : 100
Do not scale from this drawing. All dimensions are to be checked on site. This drawing is to be read in conjunction with all consultants information.			


Holland Harvey Architects
The Church
33a Wadeson street
London E2 9DR
hello@hollandharvey.com
+44 208 123 7454

Client
Gail's Bakery

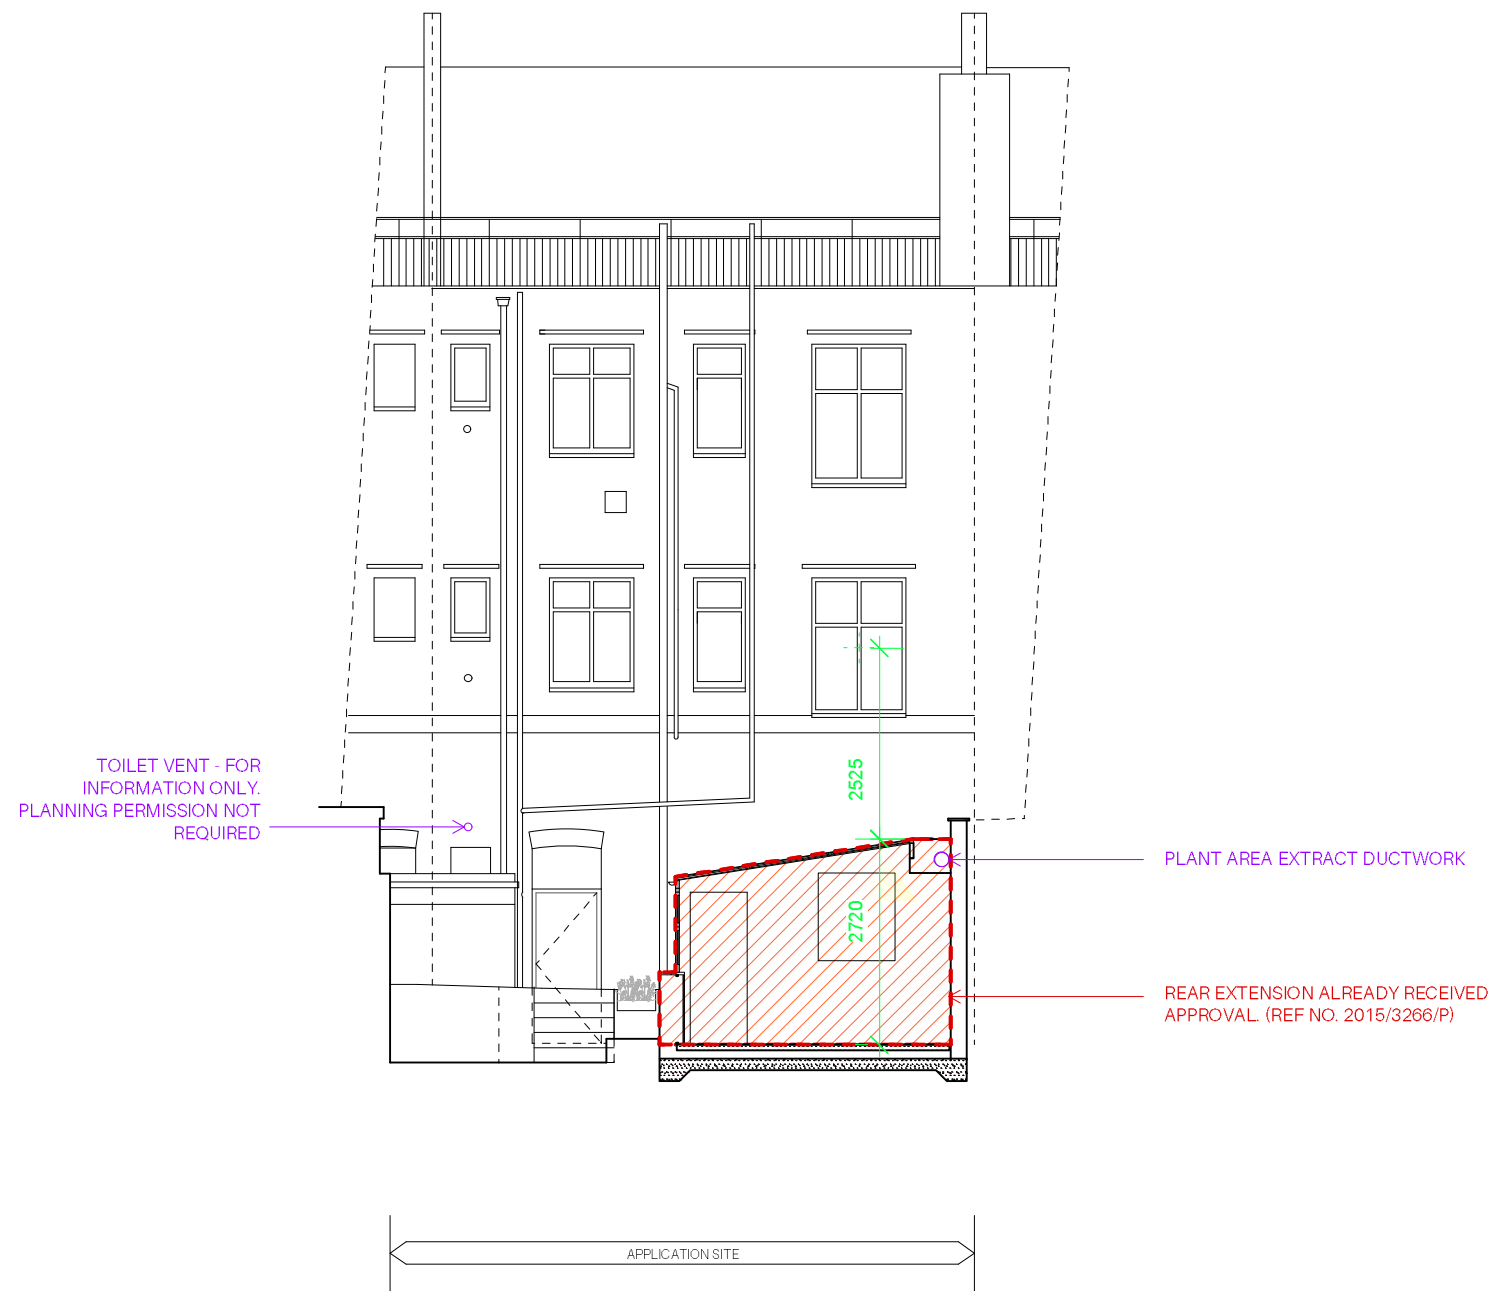

A/C - EXTRACT APPLICATION

Notes

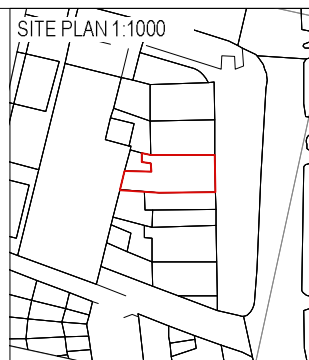

REV	DATE	DESCRIPTION	BY	CHK
06	18.10.17	ISSUED FOR PLANNING	JB	JH
05	05.04.16	ISSUED FOR PLANNING	MC	JH
04	31.03.16	ISSUED FOR PLANNING	MC	JH
03	17.03.16	ISSUED FOR PLANNING	MC	JH
02	10.03.16	ISSUED FOR PLANNING	MC	JH
01	07.07.15	ISSUED FOR PLANNING	MC	JH
-	29.06.15	ISSUED FOR PLANNING	MC	JH

Project 21 Swain's Lane			
Drawing GA Rear Elevation : As Built			
Job Number 15009	Drawing Number 1300	Rev 06	
Drawn MC	Date 18.05.15	Status Planning	Scale @ A3 1 : 100
Do not scale from this drawing. All dimensions are to be checked on site. This drawing is to be read in conjunction with all consultants information.			



Holland Harvey Architects
The Church
33a Wadeson street
London E2 9DR
hello@hollandharvey.com
+44 208 123 7454

Client

Gail's Bakery