



notes:
 Do not scale from this drawing
 All dimensions to be checked on site and any discrepancies reported to the Architect/Contract Administrator before proceeding with the works on site, or off-site fabrication
 Subject to site survey and inspection



LOCATION PLAN 1:1250

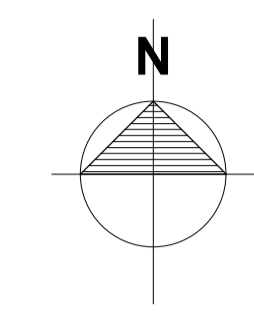

BLOCK PLAN 1:500

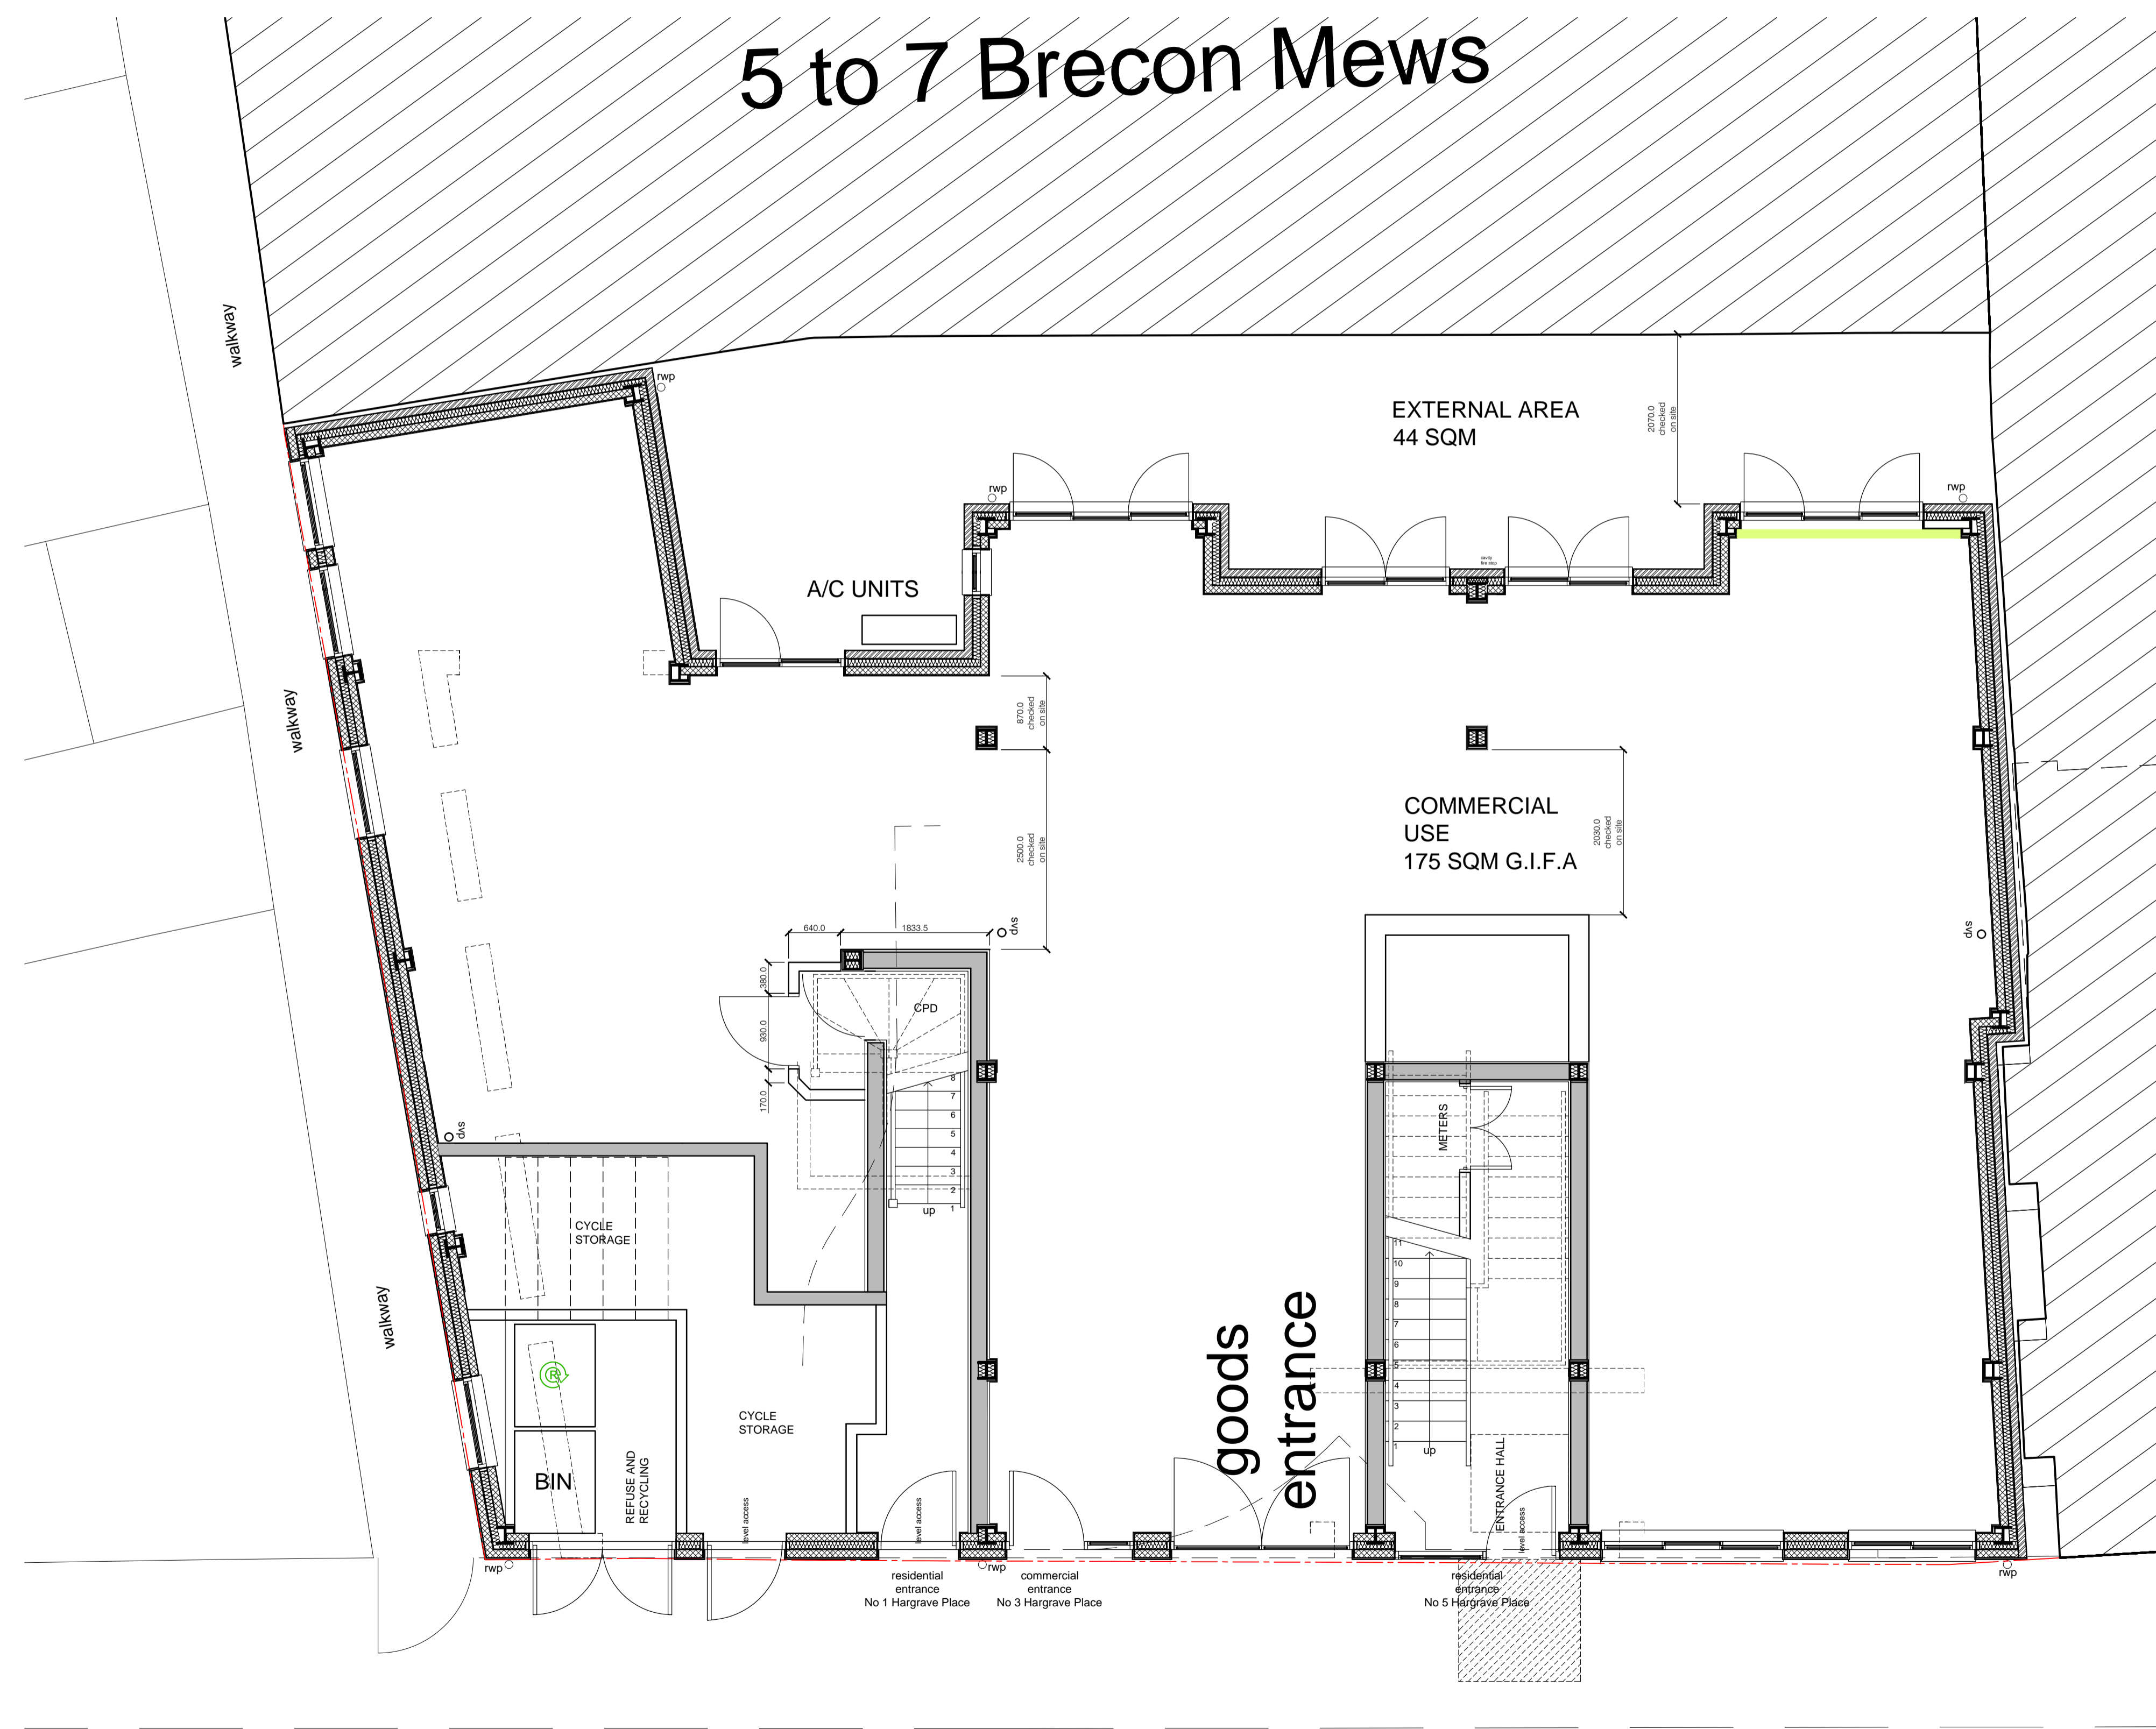

GROUND FLOOR PLAN 1:50

As-Built

revision	description	date
<p>GENESIS ARCHITECTS LTD 7 St Margarets Road, Stanstead Abbots Ware Hertfordshire SG12 8BP T: 01920 877998 F: 01920 877998 E: genesisarchitects@btconnect.com W: www.genesisarchitects.ltd.uk</p>		
<p>client Hargrave Developments Ltd</p>		
<p>project VARIATION OF CONDITION 3 HARGRAVE PLACE LONDON N7 0BP</p>		
<p>title SITE PLANS AS-BUILT GROUND FLOOR PLAN</p>		
date	scale	drawn
OCT 17	AS SHOWN	IRMB
drawing no	revision	
GAL 200 (PC) 300 /		