


<b>Module orientation</b> Various* from south
<b>Roof pitch</b> 0°
<b>Module pitch</b> 10°



<b>Notes</b> Building Height - 6 Floors	<b>Module length</b>	1650mm	<b>Module type &amp; qty</b>	47 x JA 290Wp - Mono	<b>Site address</b>	Herbal House 20 Back Hill Farringdon London EC1R 5EN
	<b>Module width</b>	991mm	<b>PV peak output</b>	13.865 kWp	<b>Drawing type</b>	As built Elevation
	<b>Module depth</b>	40mm	<b>Inverter type &amp; qty</b>	Fronius Symo 12.5kW	<b>Revision number</b>	01
					<b>Project reference</b>	HERB3149
					<b>Drawn by</b>	RB
					<b>Date</b>	05/11/2017

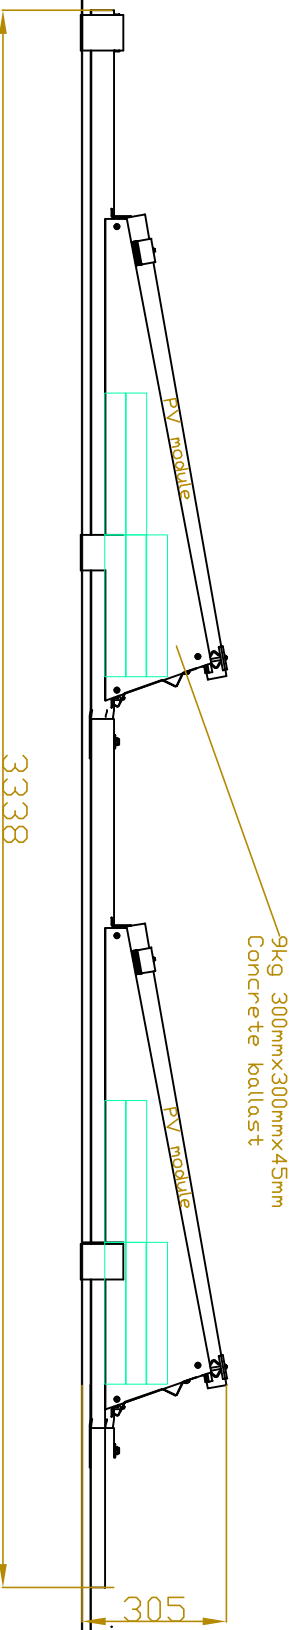

020 8789 4717  
www.solsticeenergy.co.uk  
Little Willow, Upper Anstey Lane GU34 4BP