





EXISTING REAR ELEVATION  
AS BUILT  
SCALE 1:100



EXISTING SIDE ELEVATION  
SCALE 1:100

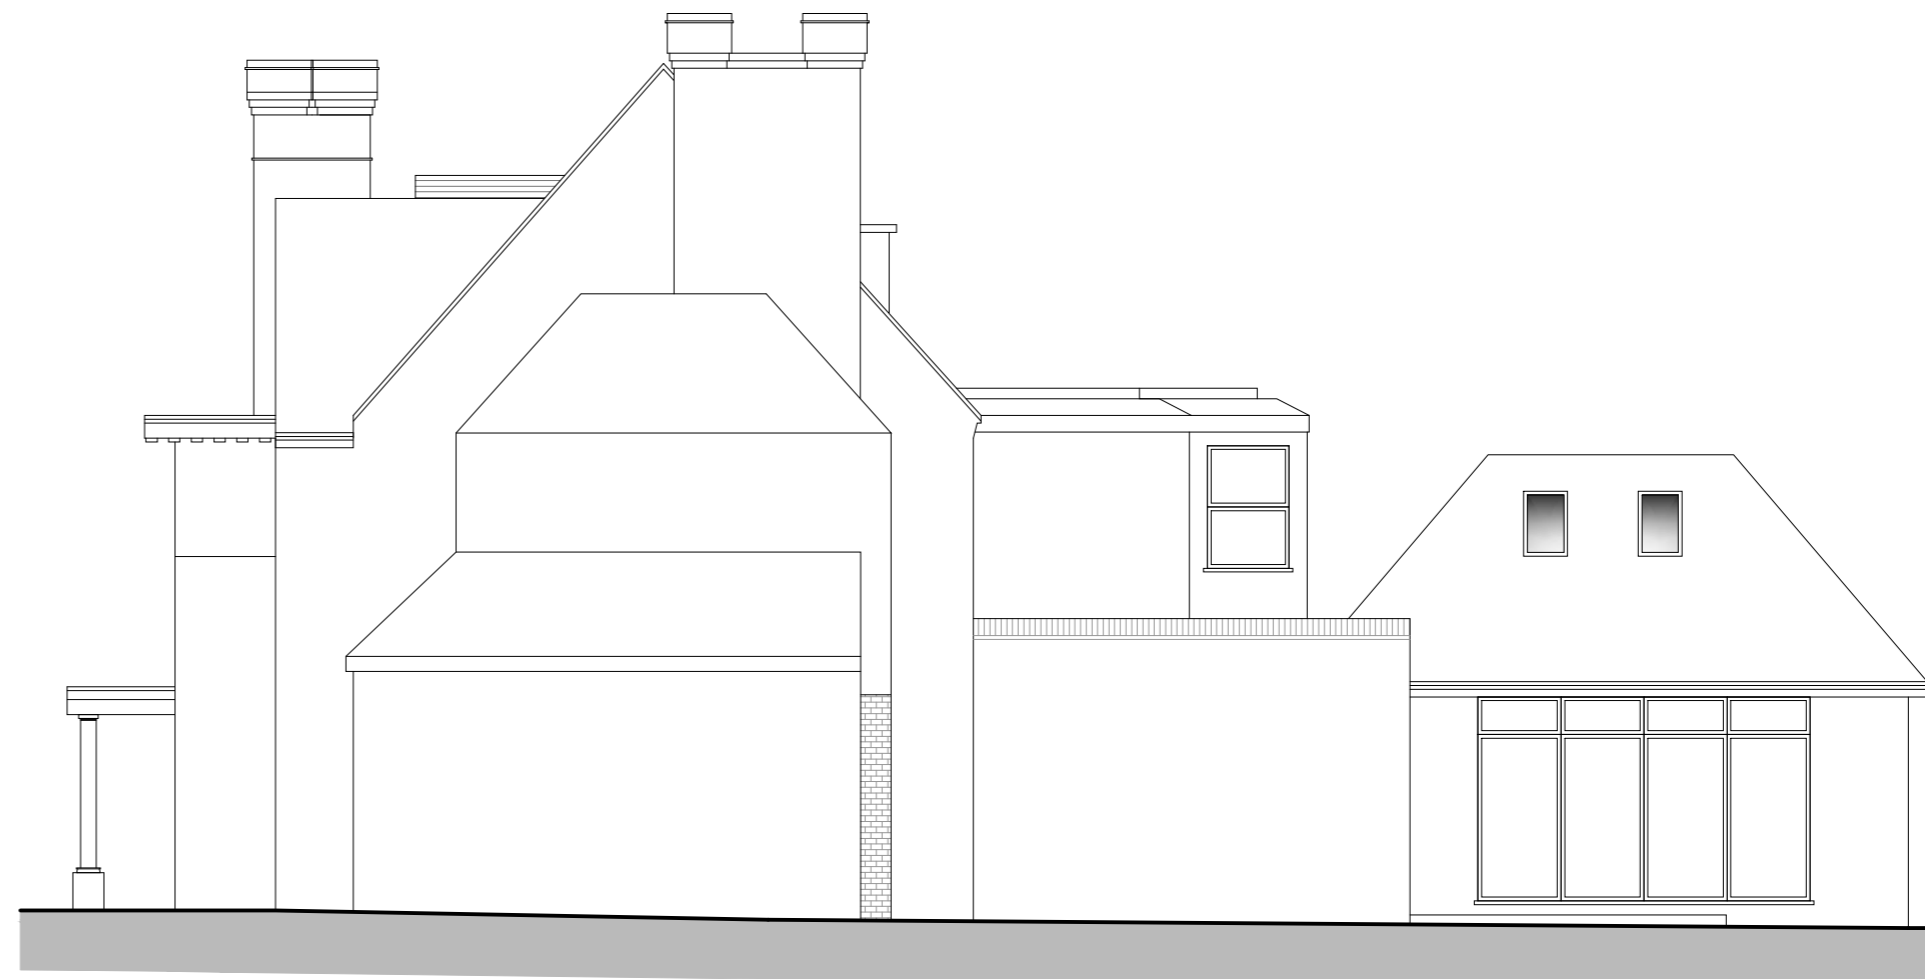


EXISTING SIDE ELEVATION  
AS BUILT  
SCALE 1:100

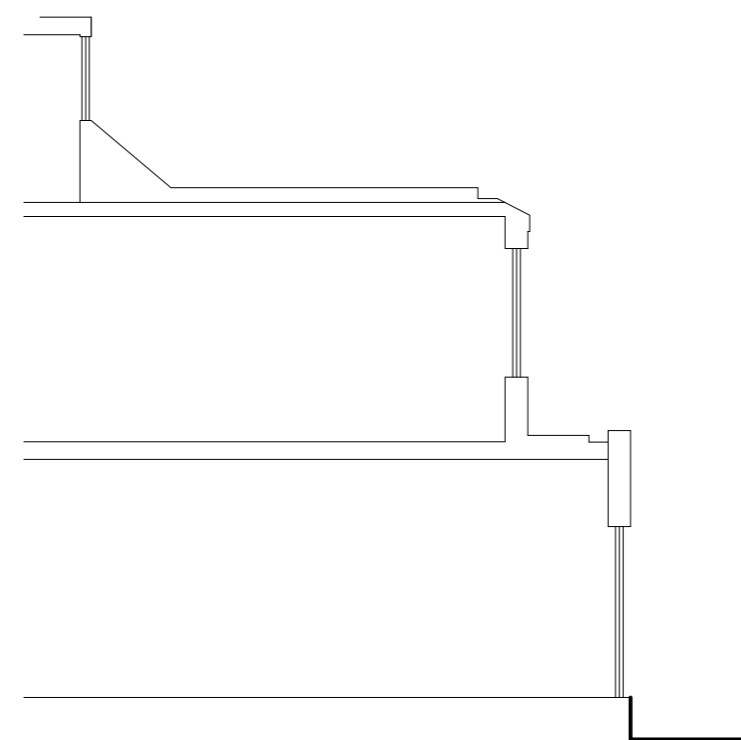

CROSS SECTION OF ROOF  
AS BUILT  
SCALE 1:100



Photo of no 28 Harley Road First floor  
As Built

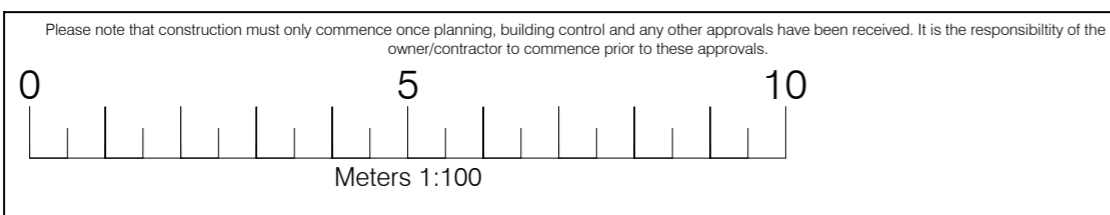

Legend	
Walls Removed	
New Walls	
Existing Walls to Remain	
Roof Structure	
Sound Separating Walls	
Boundary	

**IMPORTANT GENERAL NOTE**  
The specification is to be read in conjunction with the plans/section details, and other associated Structural details as may be provided.  
All work is to be carried out to the Local Authority Planning and Building Regulations Approval, and the Codes of Practice and British Standards as necessary.  
All dimensions, levels, sizes, positions and locations of particulars as indicated on drawings are to be verified by the appointed Contractor on site prior to engaging in work. Any discrepancies must be reported to the Architect/Surveyor/Engineer or responsible person's immediately.  
The Contractor is responsible for ensuring compliance with the CDM Regulations, and appropriate Health & Safety on site precautions.  
The Client/Building Owner must obtain any necessary PARTY WALL AGREEMENTS, prior to engaging in the works on site.

Revision	Date	Description

A2	Paper Size	A2
	Scale	1:100
	Revision	1st
	Drawn By/Checked By	AP/HW

Construct 360 Ltd. Trading as: DontMoveExtend.com Planning Permission Specialists info@DontMoveExtend.com Tel: 0208 206 0011 Site Address:		Existing Elevations As Built Drawing Number <b>HR28-3007</b>
28 Harley Road London NW3 3BN		DontMoveExtend.com and the Red Box are Registered Trade Marks Of Construct 360 Ltd

COPYRIGHT © 2017