




PROPOSED REAR ELEVATION  
SCALE 1:100



PROPOSED SIDE ELEVATION  
SCALE 1:100




Photo of no 26 Harley Road First floor

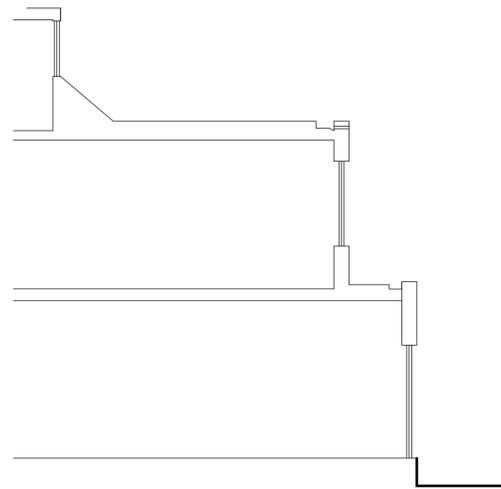

PROPOSED CROSS SECTION OF ROOF  
AS BUILT  
SCALE 1:100



PROPOSED SIDE ELEVATION  
SCALE 1:100

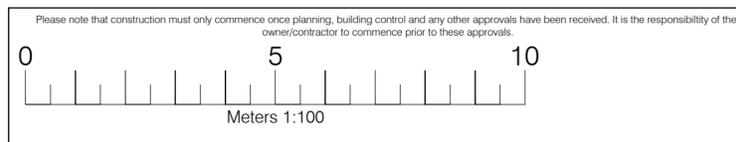

Legend	
Walls Removed	
New Walls	
Existing Walls to Remain	
Roof Structure	
Sound Separating Walls	
Boundary	

**IMPORTANT GENERAL NOTE**  
The specification is to be read in conjunction with the plans/section details, and other associated structural details as may be provided.  
All work is to be carried out to the Local Authority Planning and Building Regulations Approval, and the Codes of Practice and British Standards as necessary.  
All dimensions, levels, sizes, positions and locations of particulars as indicated on drawings are to be verified by the appointed Contractor on site prior to engaging in work. Any discrepancies must be reported to the Architect/Surveyor/Engineer or responsible person's immediately.  
The Contractor is responsible for ensuring compliance with the CDM Regulations, and appropriate Health & Safety on site precautions.  
The Client/Building Owner must obtain any necessary PARTY WALL AGREEMENTS, prior to engaging in the works on site.

Revision	Date	Description

Paper Size  
**A2**

Scale  
1:100  
Revision  
1st  
Nov-17  
Drawn By/Checked By  
AP/HW

Continued 360 Ltd. Trading as:  
**DontMoveExtend.com**  
info@DontMoveExtend.com  
Tel: 0208 206 0011  
Site Address  
28 Harley Road  
London  
NW3 3BN

Planning Permission Specialists  
Proposed Elevations  
With Changes  
Drawing Number  
HR28-3008

Copyright © 2017

DontMoveExtend.com and the Red Box are Registered Trade Marks Of Construct 360 Ltd