


GREEN LINE INDICATES NEW PARPET

BLUE LINE INDICATES WHAT HAS BEEN BUILT

RED LINE INDICATES WHAT WAS APPROVED

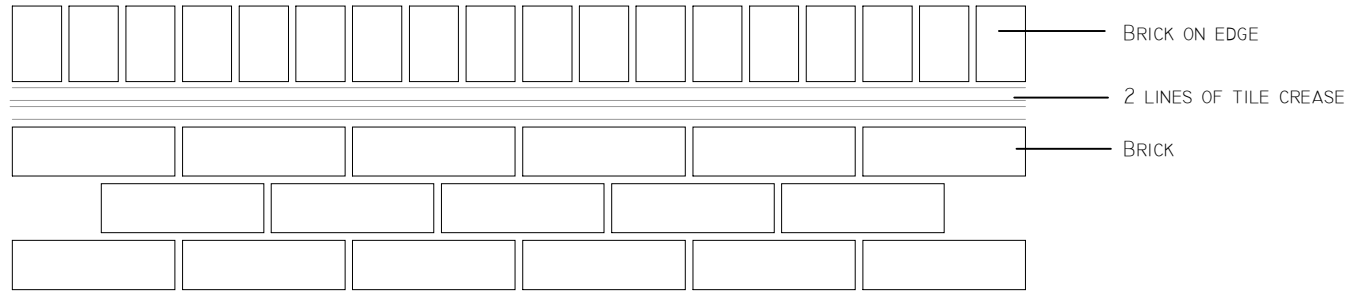


PROPOSED PARAPET TO FIRST FLOOR EXTNSION

SCALE 1:10




Photo of Brick on edge detail

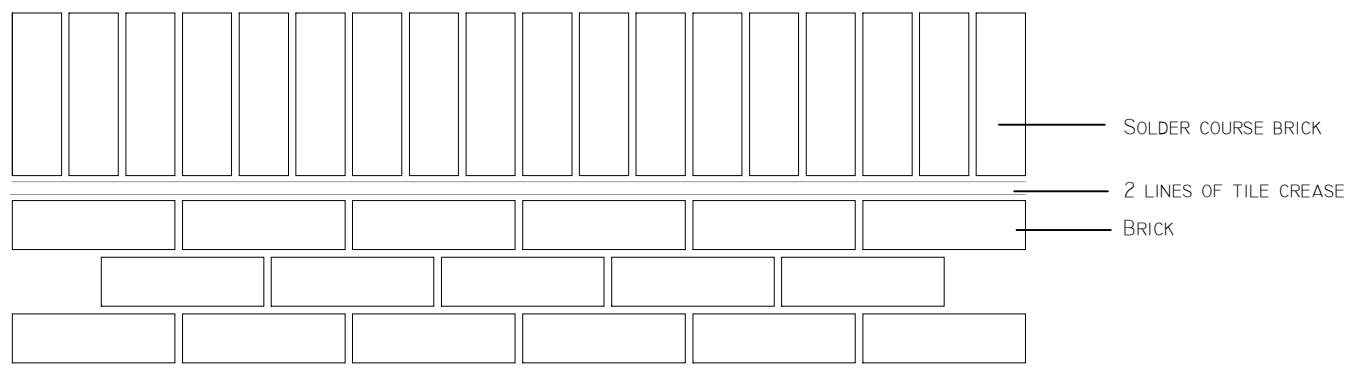

PROPOSED PARAPET TO GROUND FLOOR EXTENSION

SCALE 1:10

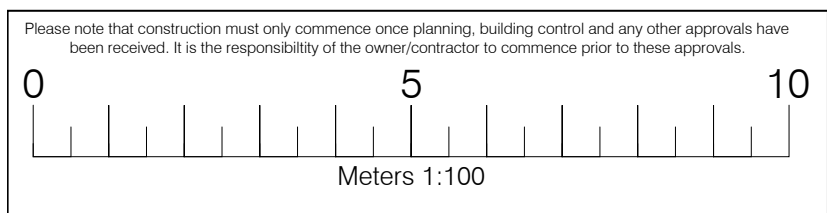

Legend	
Walls Removed	
New Walls	
Existing Walls to Remian	
Roof Structure	
Sound Seperating Walls	
Boundary	

**IMPORTANT GENERAL NOTE**  
 The specification is to be read in conjunction with the plans/section details, and other associated Structural details as may be provided.  
 All work is to be carried out to the Local Authority Planning and Building Regulations Approval, and the Codes of Practice and British Standards as necessary.  
 All dimensions, levels, sizes, positions and locations of particulars as indicated on drawings are to be verified by the appointed Contractor on site prior to engaging in works. Any discrepancies must be reported to the Architect/Surveyor/Engineer or responsible person/s immediately.  
 The Contractor is responsible for ensuring compliance with the CDM Regulations, and appropriate Health & Safety on site precautions.  
 The Client/Building Owner must obtain any necessary PARTY WALL AGREEMENTS, prior to engaging in the works on site.

Revision	Date	Description

Paper Size  
**A3**

Scale  
1:10

Revision  
1st

Nov-17

Drawn By/Checked By  
AP/HW

Construct 360 Ltd, Trading as:

**DontMoveExtend.com**  
 info@DontMoveExtend.com  
 Tel: 0208 206 0011  
 Site Address

28 Harley Road  
 London  
 NW3 3BN

Parapet Details

Drawing Number  
HR28-3010

DontMoveExtend.com and the Red Box are Registered Trade Marks Of Construct 360 Ltd

COPYRIGHT © 2017